




Application No. 279537
Permit No.

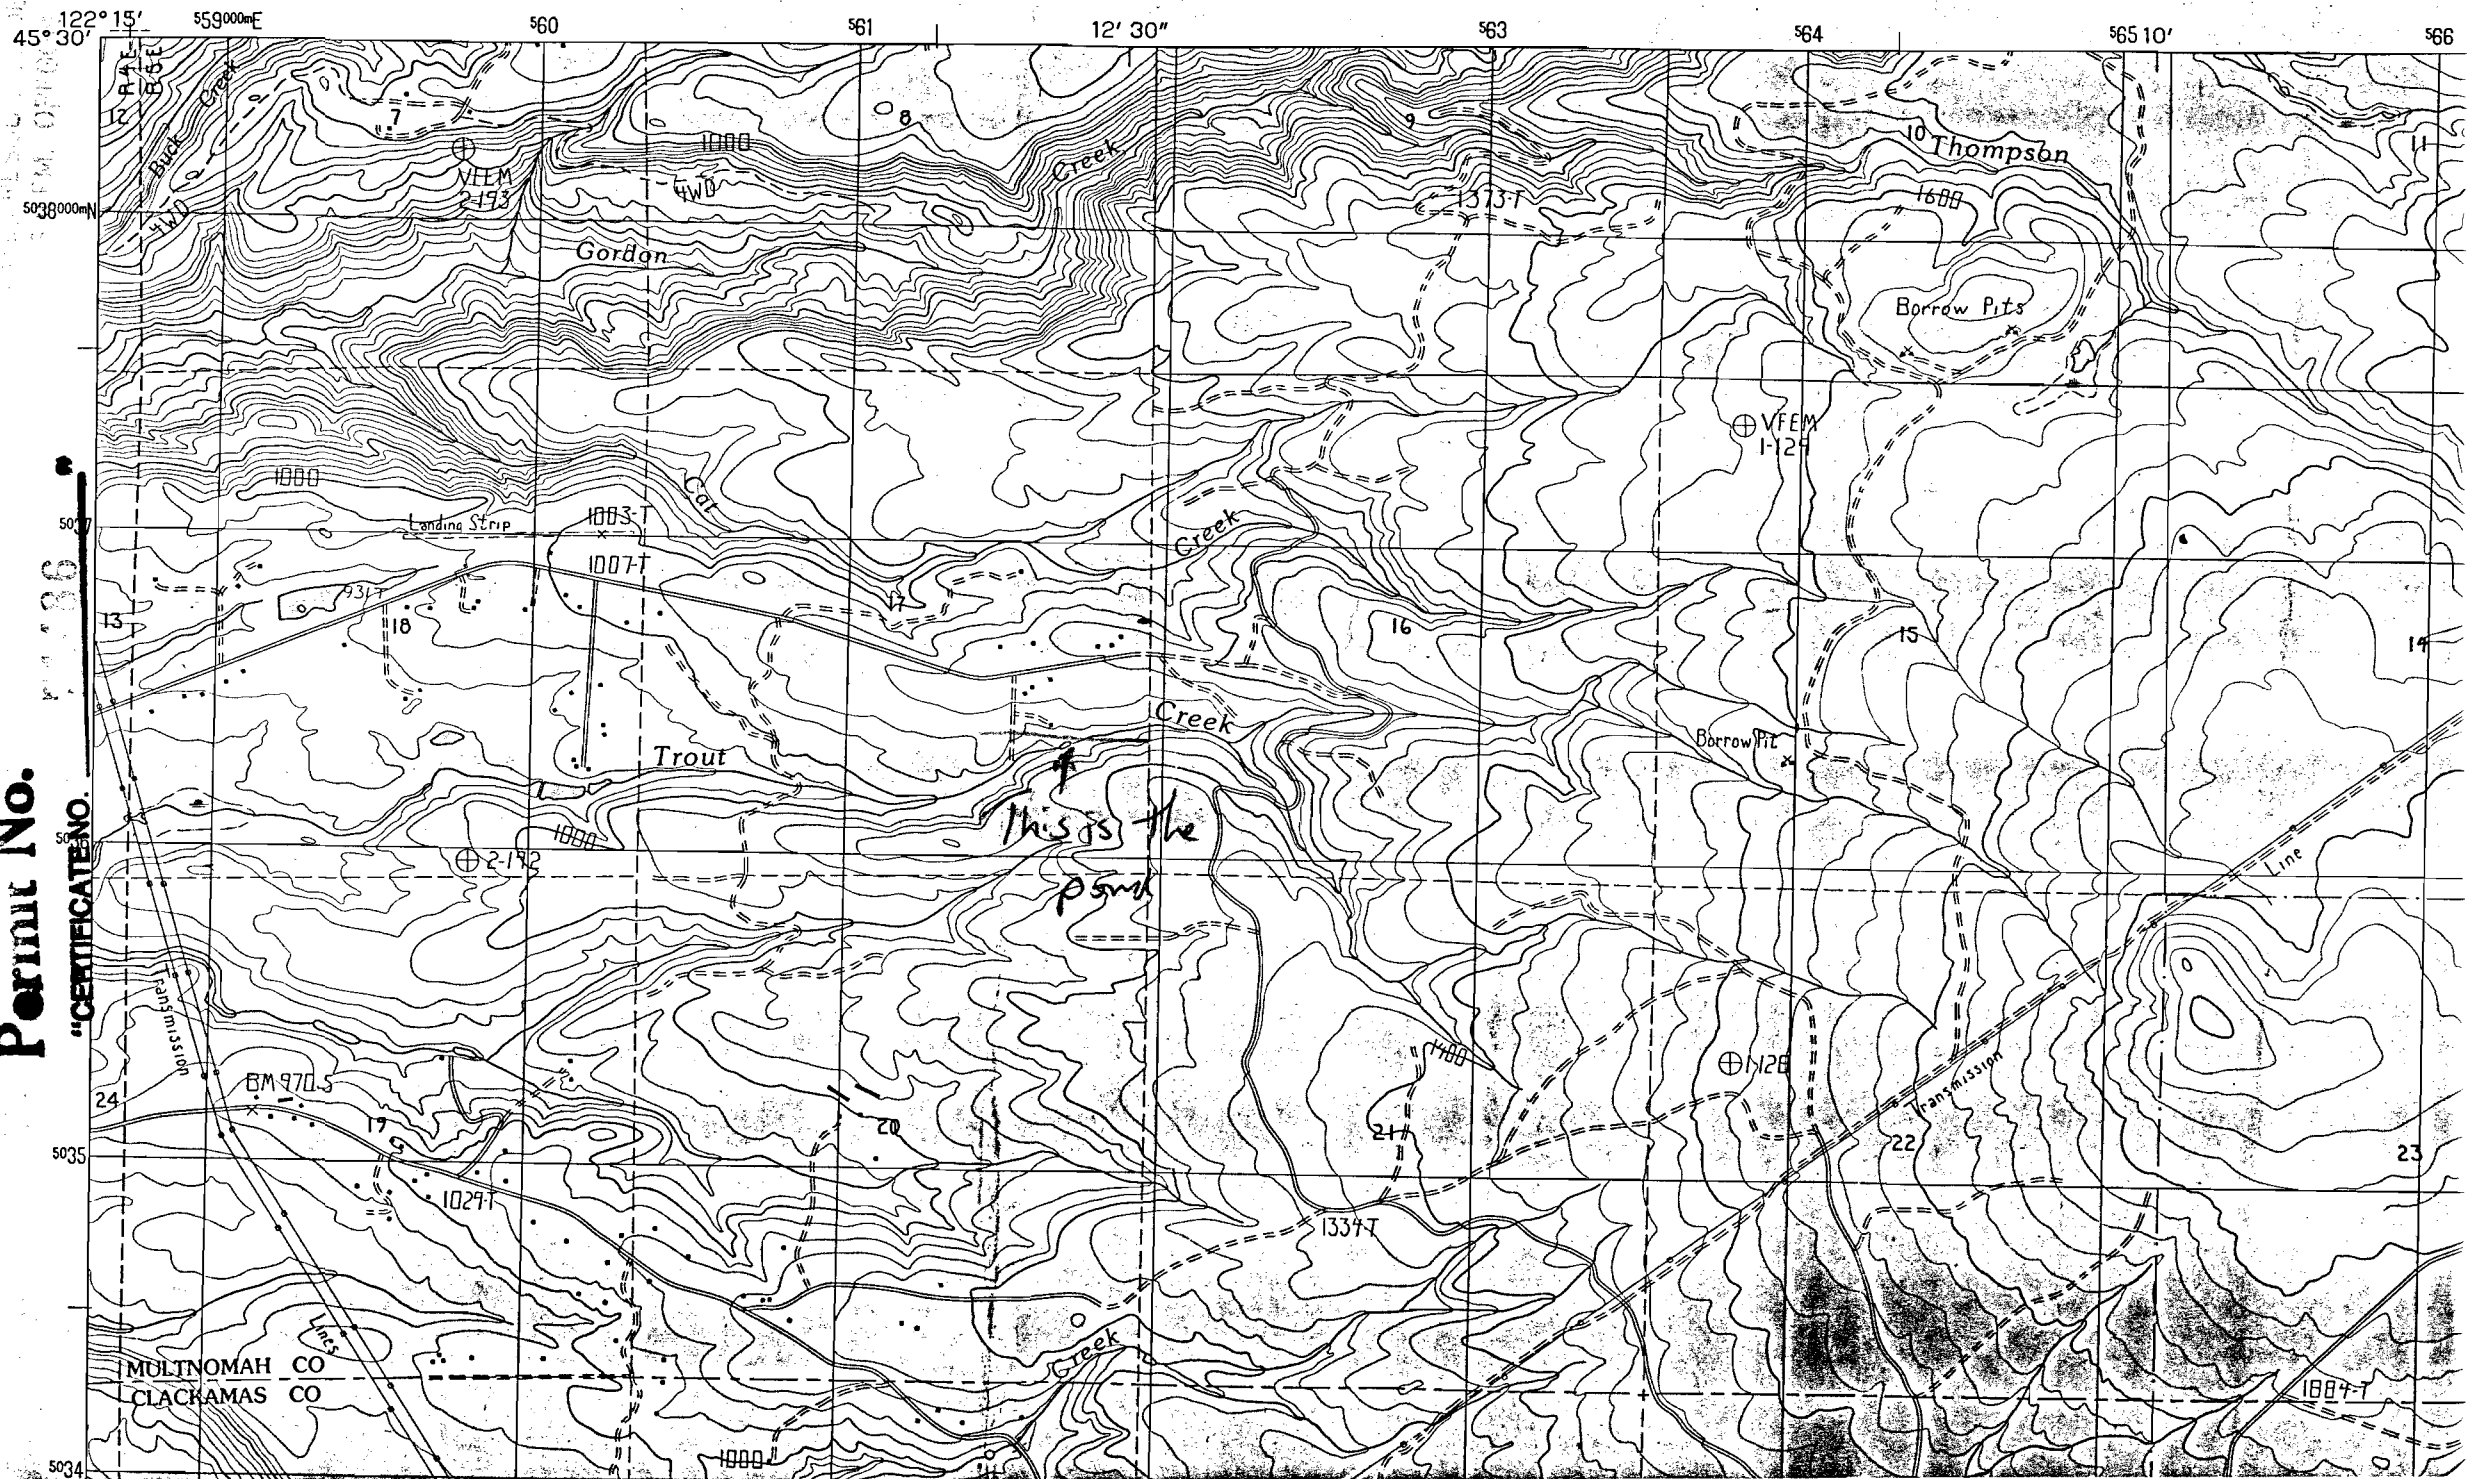

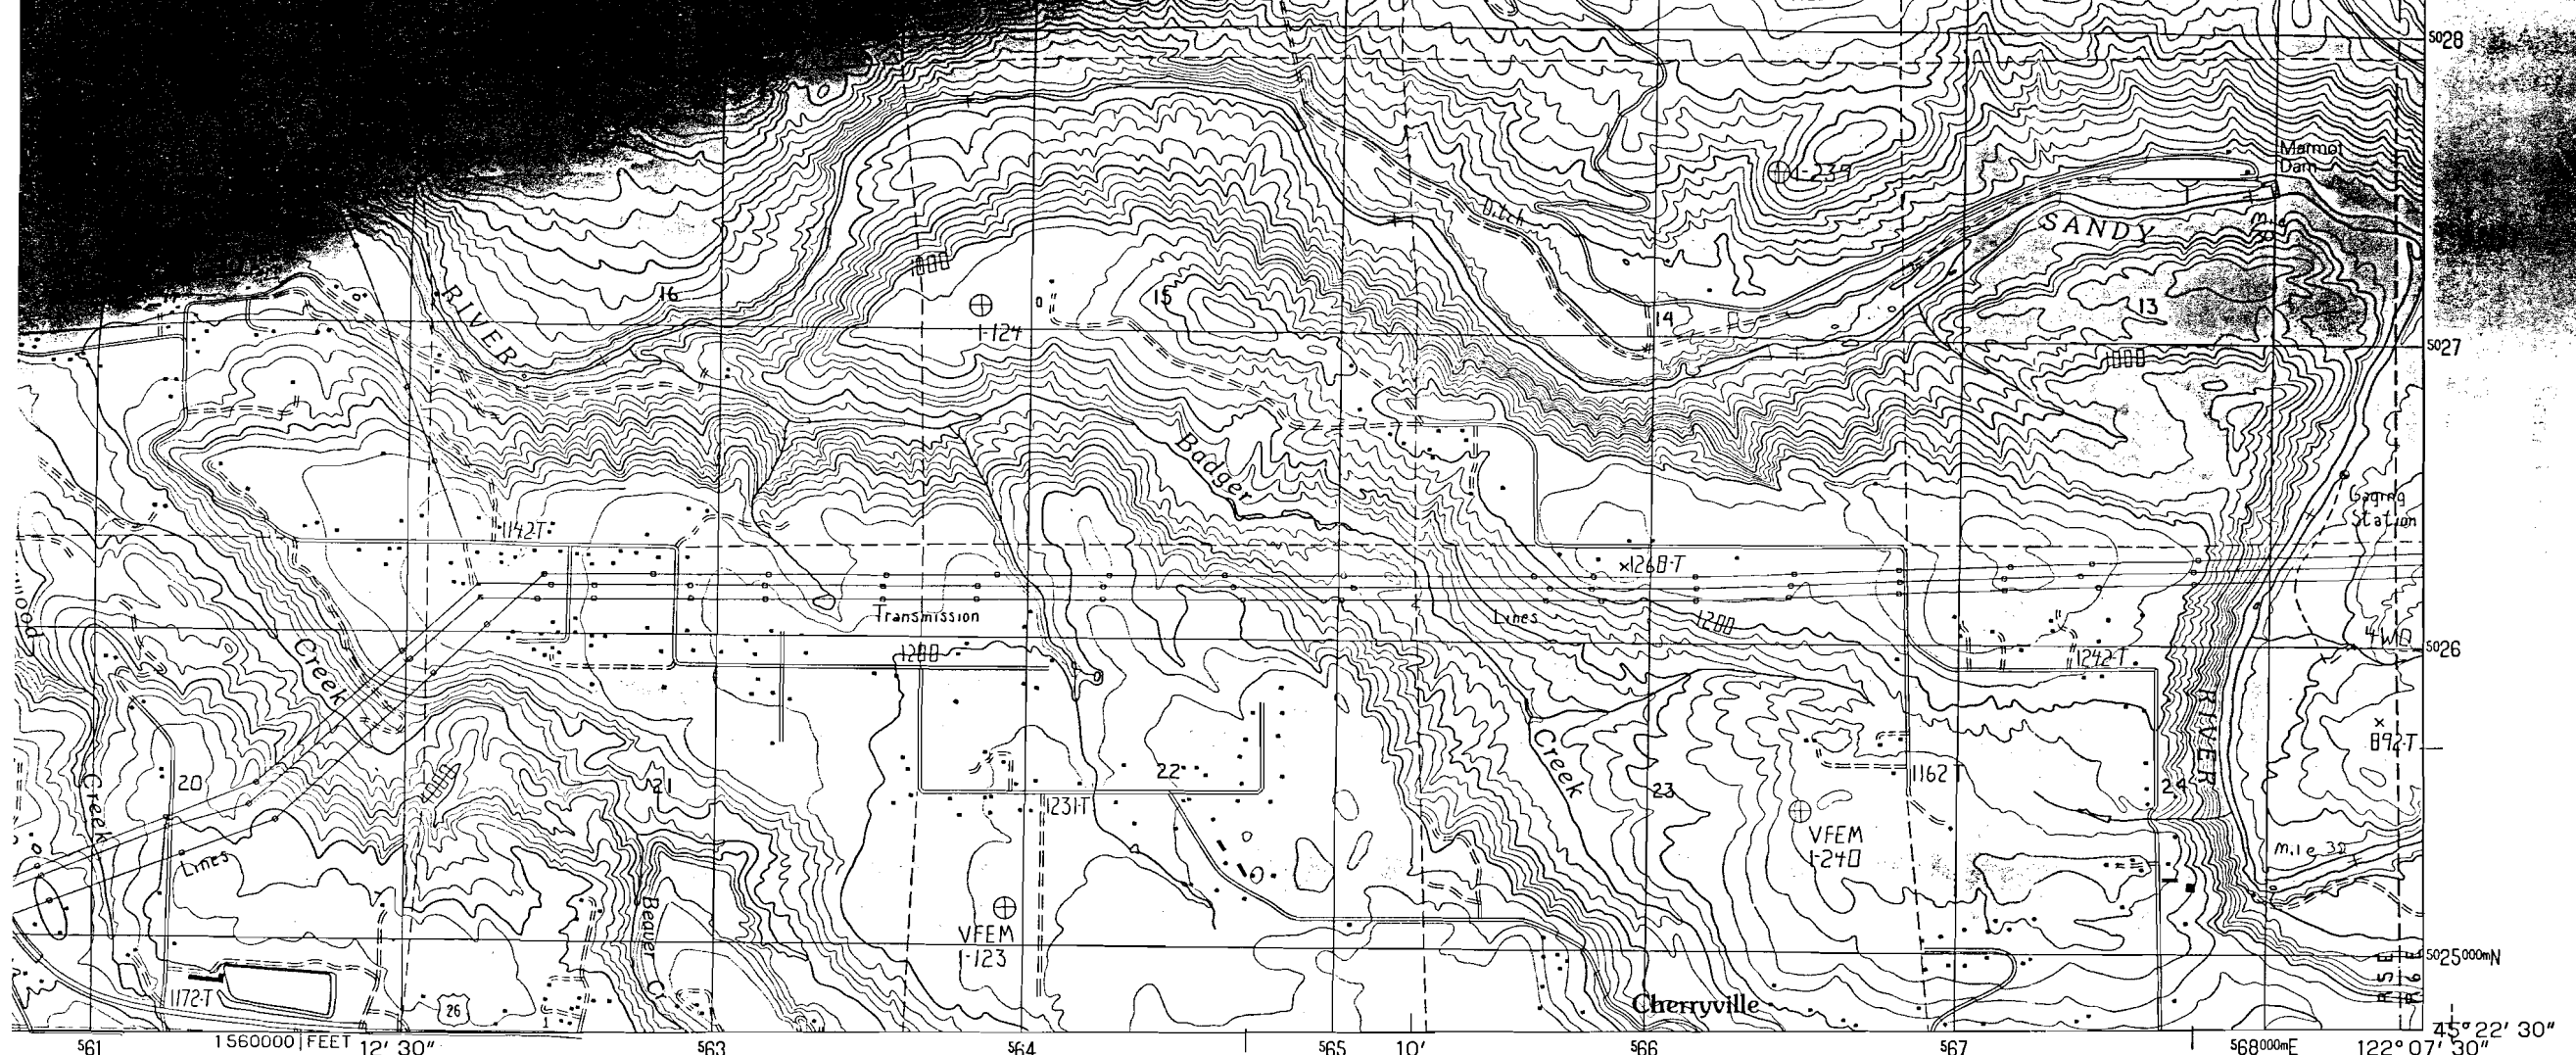

SCALE 1:24 000

INTERIOR—GEOLOGICAL SURVEY, RESTON, VIRGINIA—1988

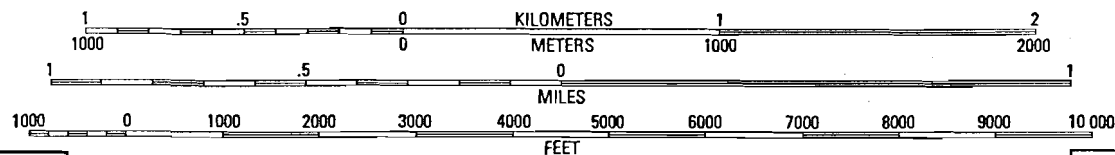

QUADRANGLE LOCATION

"CERTIFICATE NO. 5036"
ROAD LEGEND

Improved Road.....
Unimproved Road.....
Trail.....
○ Interstate Route ○ U.S. Route ○ State Route

PROVISIONAL MAP
Produced from original
manuscript drawings. Infor-
mation shown as of date of
photography. 1

CONTOUR INTERVAL 40 FEET
SUPPLEMENTARY CONTOUR INTERVAL 20 FEET
CONTROL ELEVATIONS SHOWN TO THE NEAREST 0.1 FOOT
OTHER ELEVATION SHOWN TO THE NEAREST FOOT

To convert meters to feet multiply by 3.2808
To convert feet to meters multiply by 0.3048

Application No. R-79537
Permit No.

1	2	3	1 Washougal
			2 Bridal Vail
4		5	3 Multnomah Falls
			4 Sandy
6	7	8	5 Brightwood
			6 Estacada
			7 Cherryville
			8 Wildcat Mtn.

ADJOINING 7.5' QUADRANGLE NAMES

FOR SALE BY U.S. GOVERNMENT DENVER, COLORADO 80225, OR RESTON, VIRGINIA 22092

BULL RUN, OREG.
PROVISIONAL EDITION 1985

45122-D2-TF-024