


# Application No. R-79590

## Permit No.

"CERTIFICATE NO. 71487"


| TRANSPORTATION<br>SYSTEM UPDATE |                         |
|---------------------------------|-------------------------|
|                                 | PRIMARY HWY             |
|                                 | SECONDARY HWY           |
|                                 | IMPROVED ROAD<br>PAVED  |
|                                 | IMPROVED ROAD<br>GRAVEL |

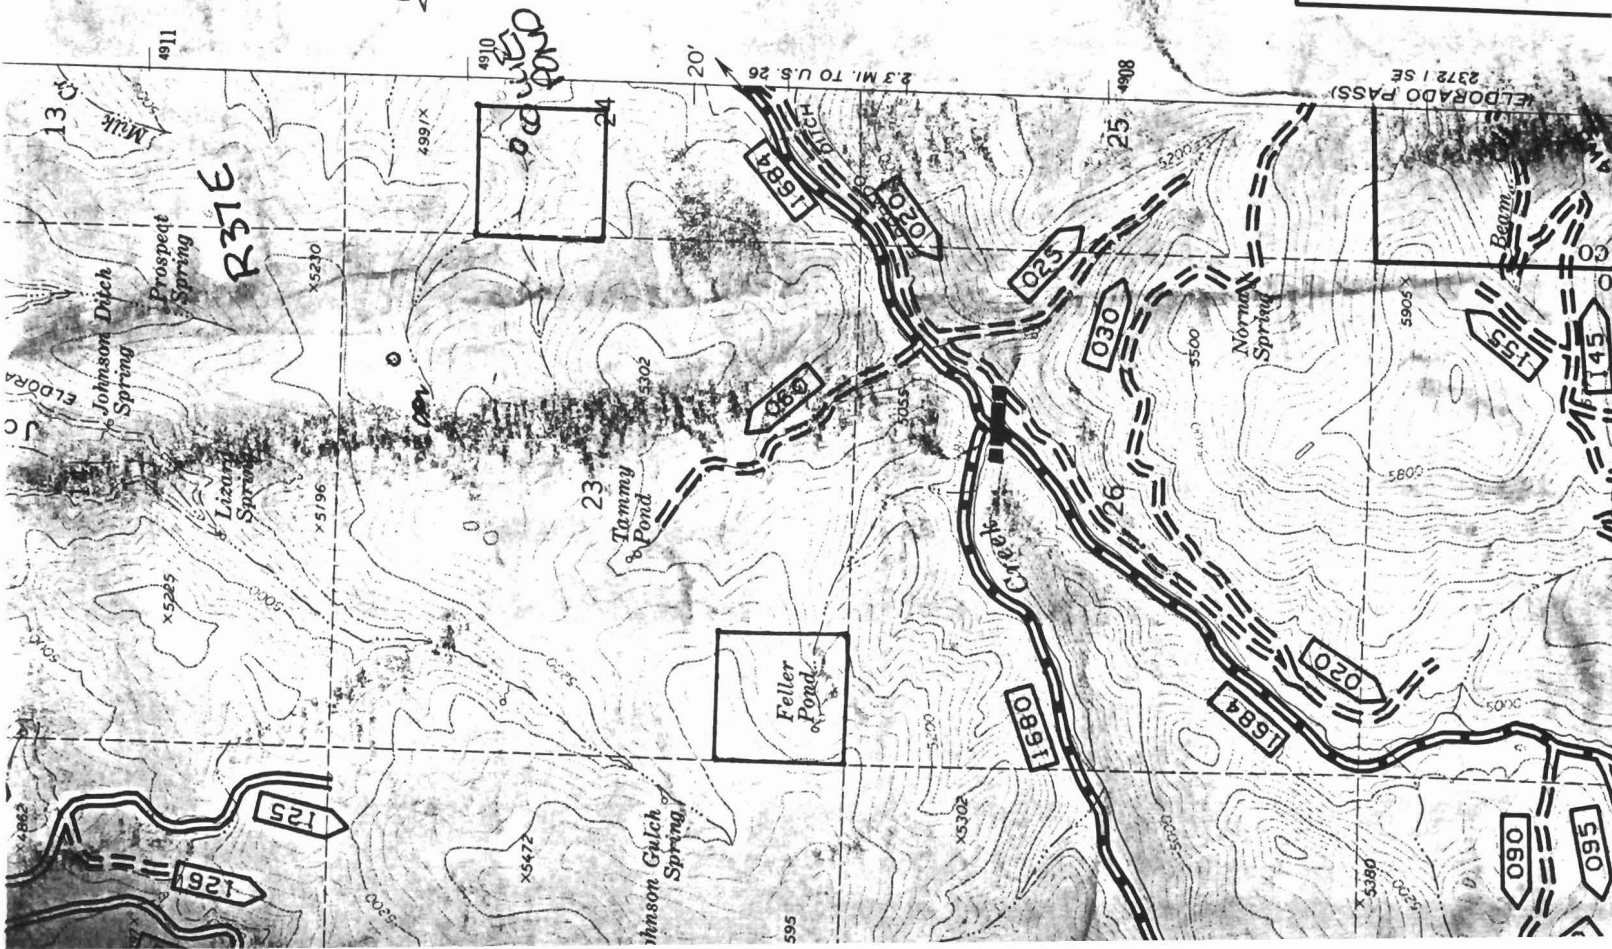


RASTUS MNT QUAD 1972

Application No. R-79590  
Permit No.

R37E "CERTIFICATE NO. 71487"

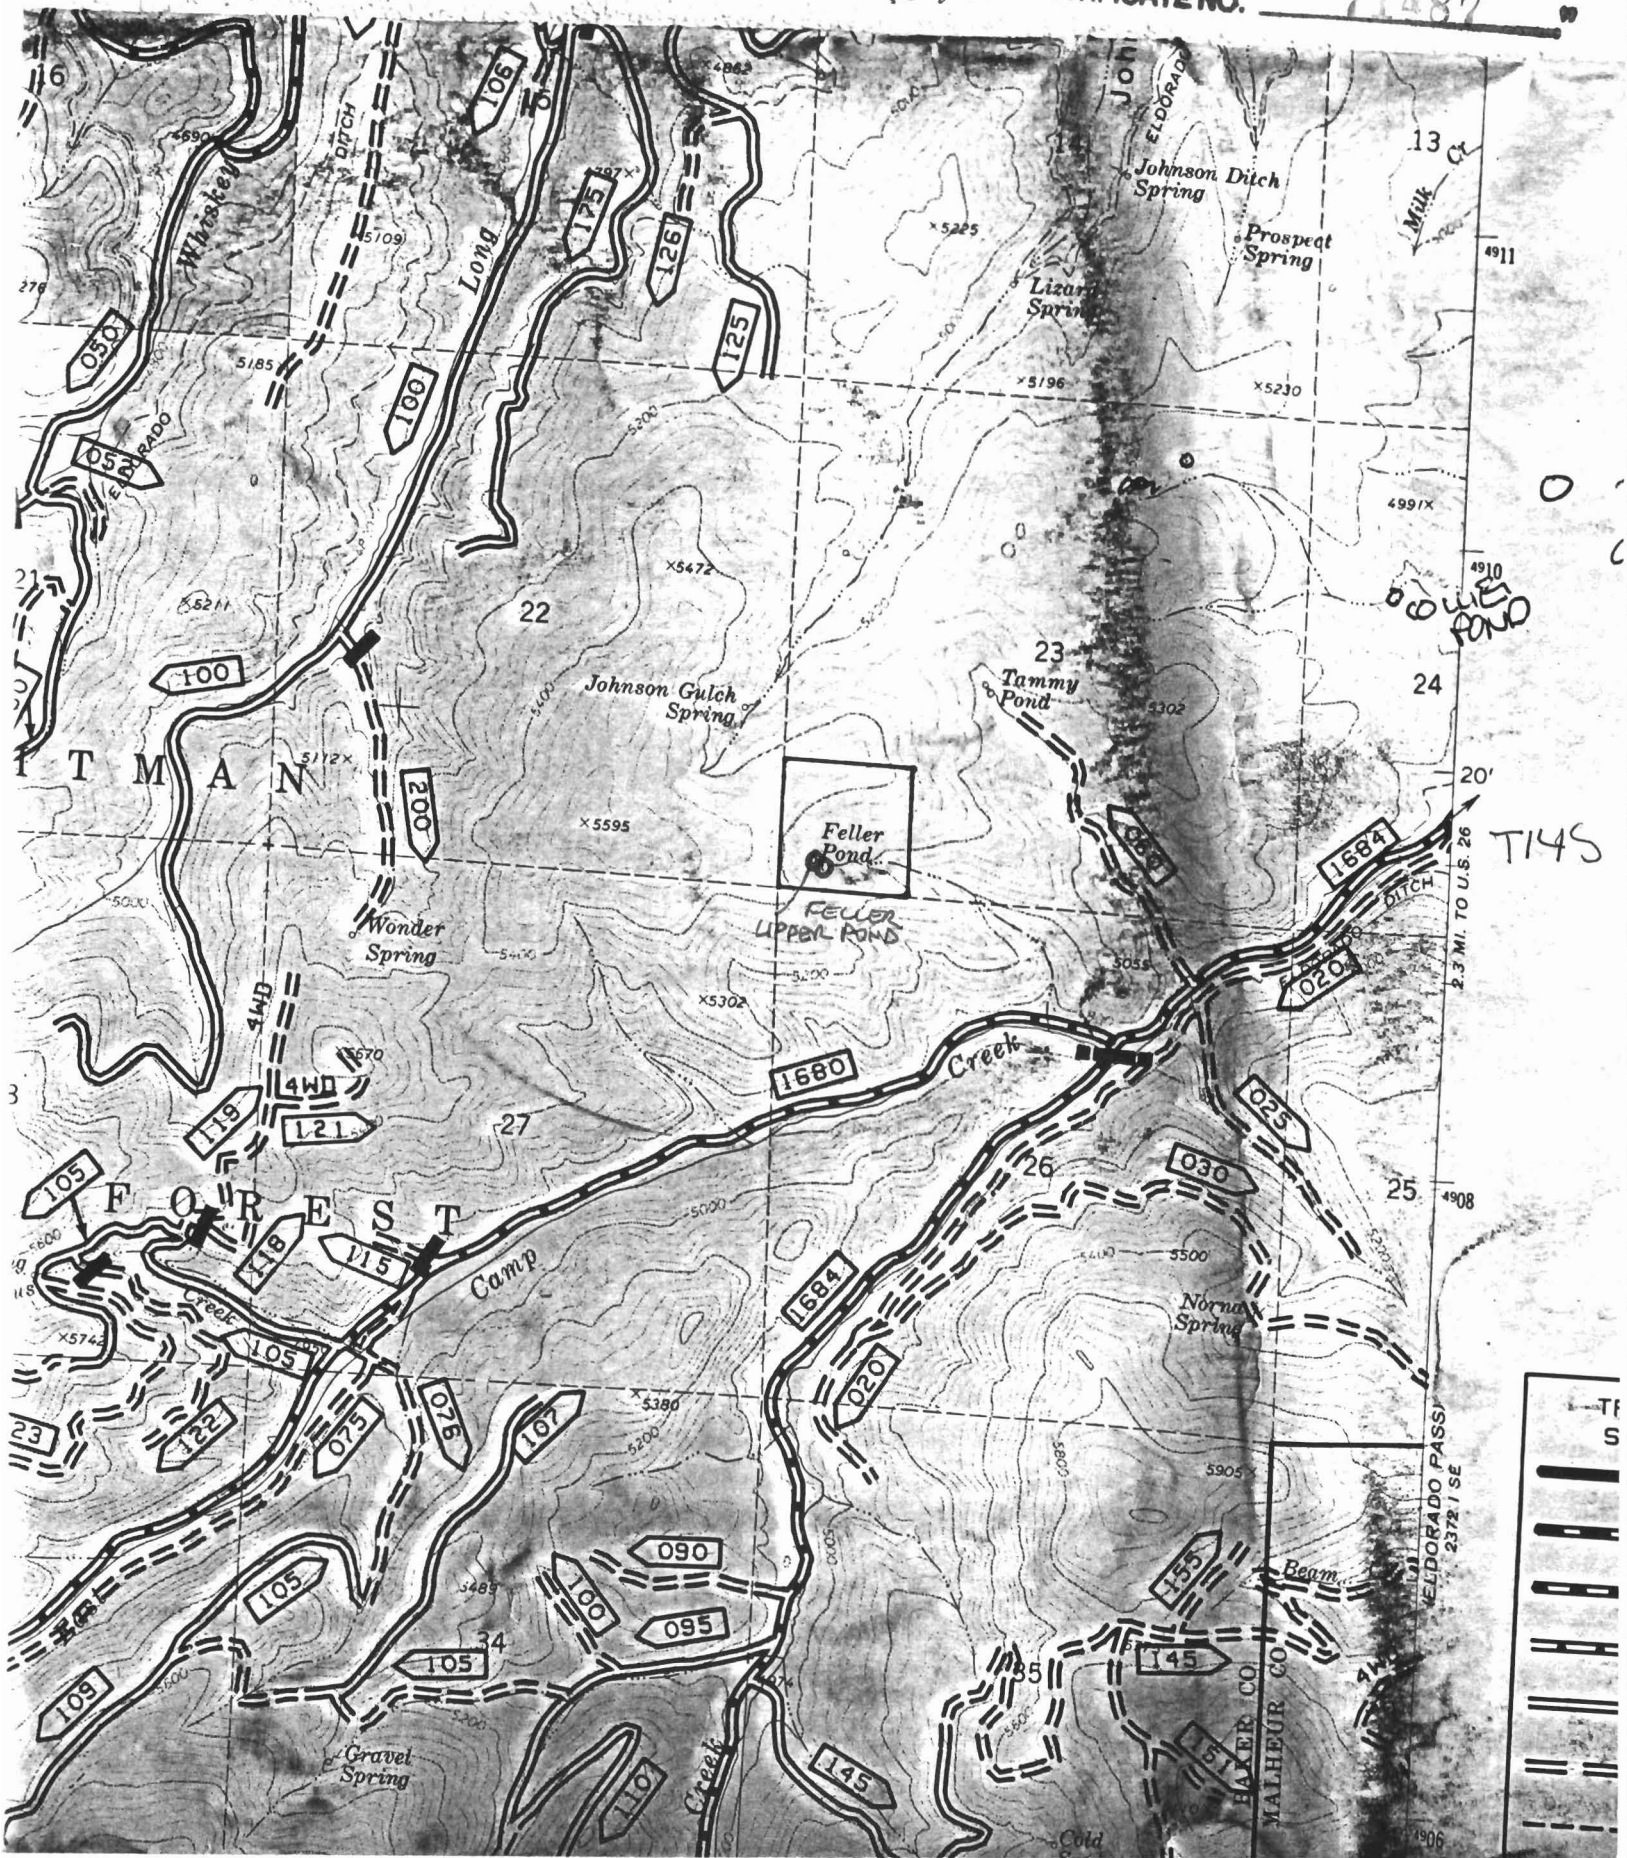

R37E

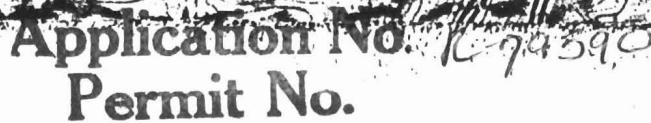

"CERTIFICATE NO.


RASTUS MNT QUAD 1972


Application No. R 79590

Permit No.

"CERTIFICATE NO.

71487

R37E

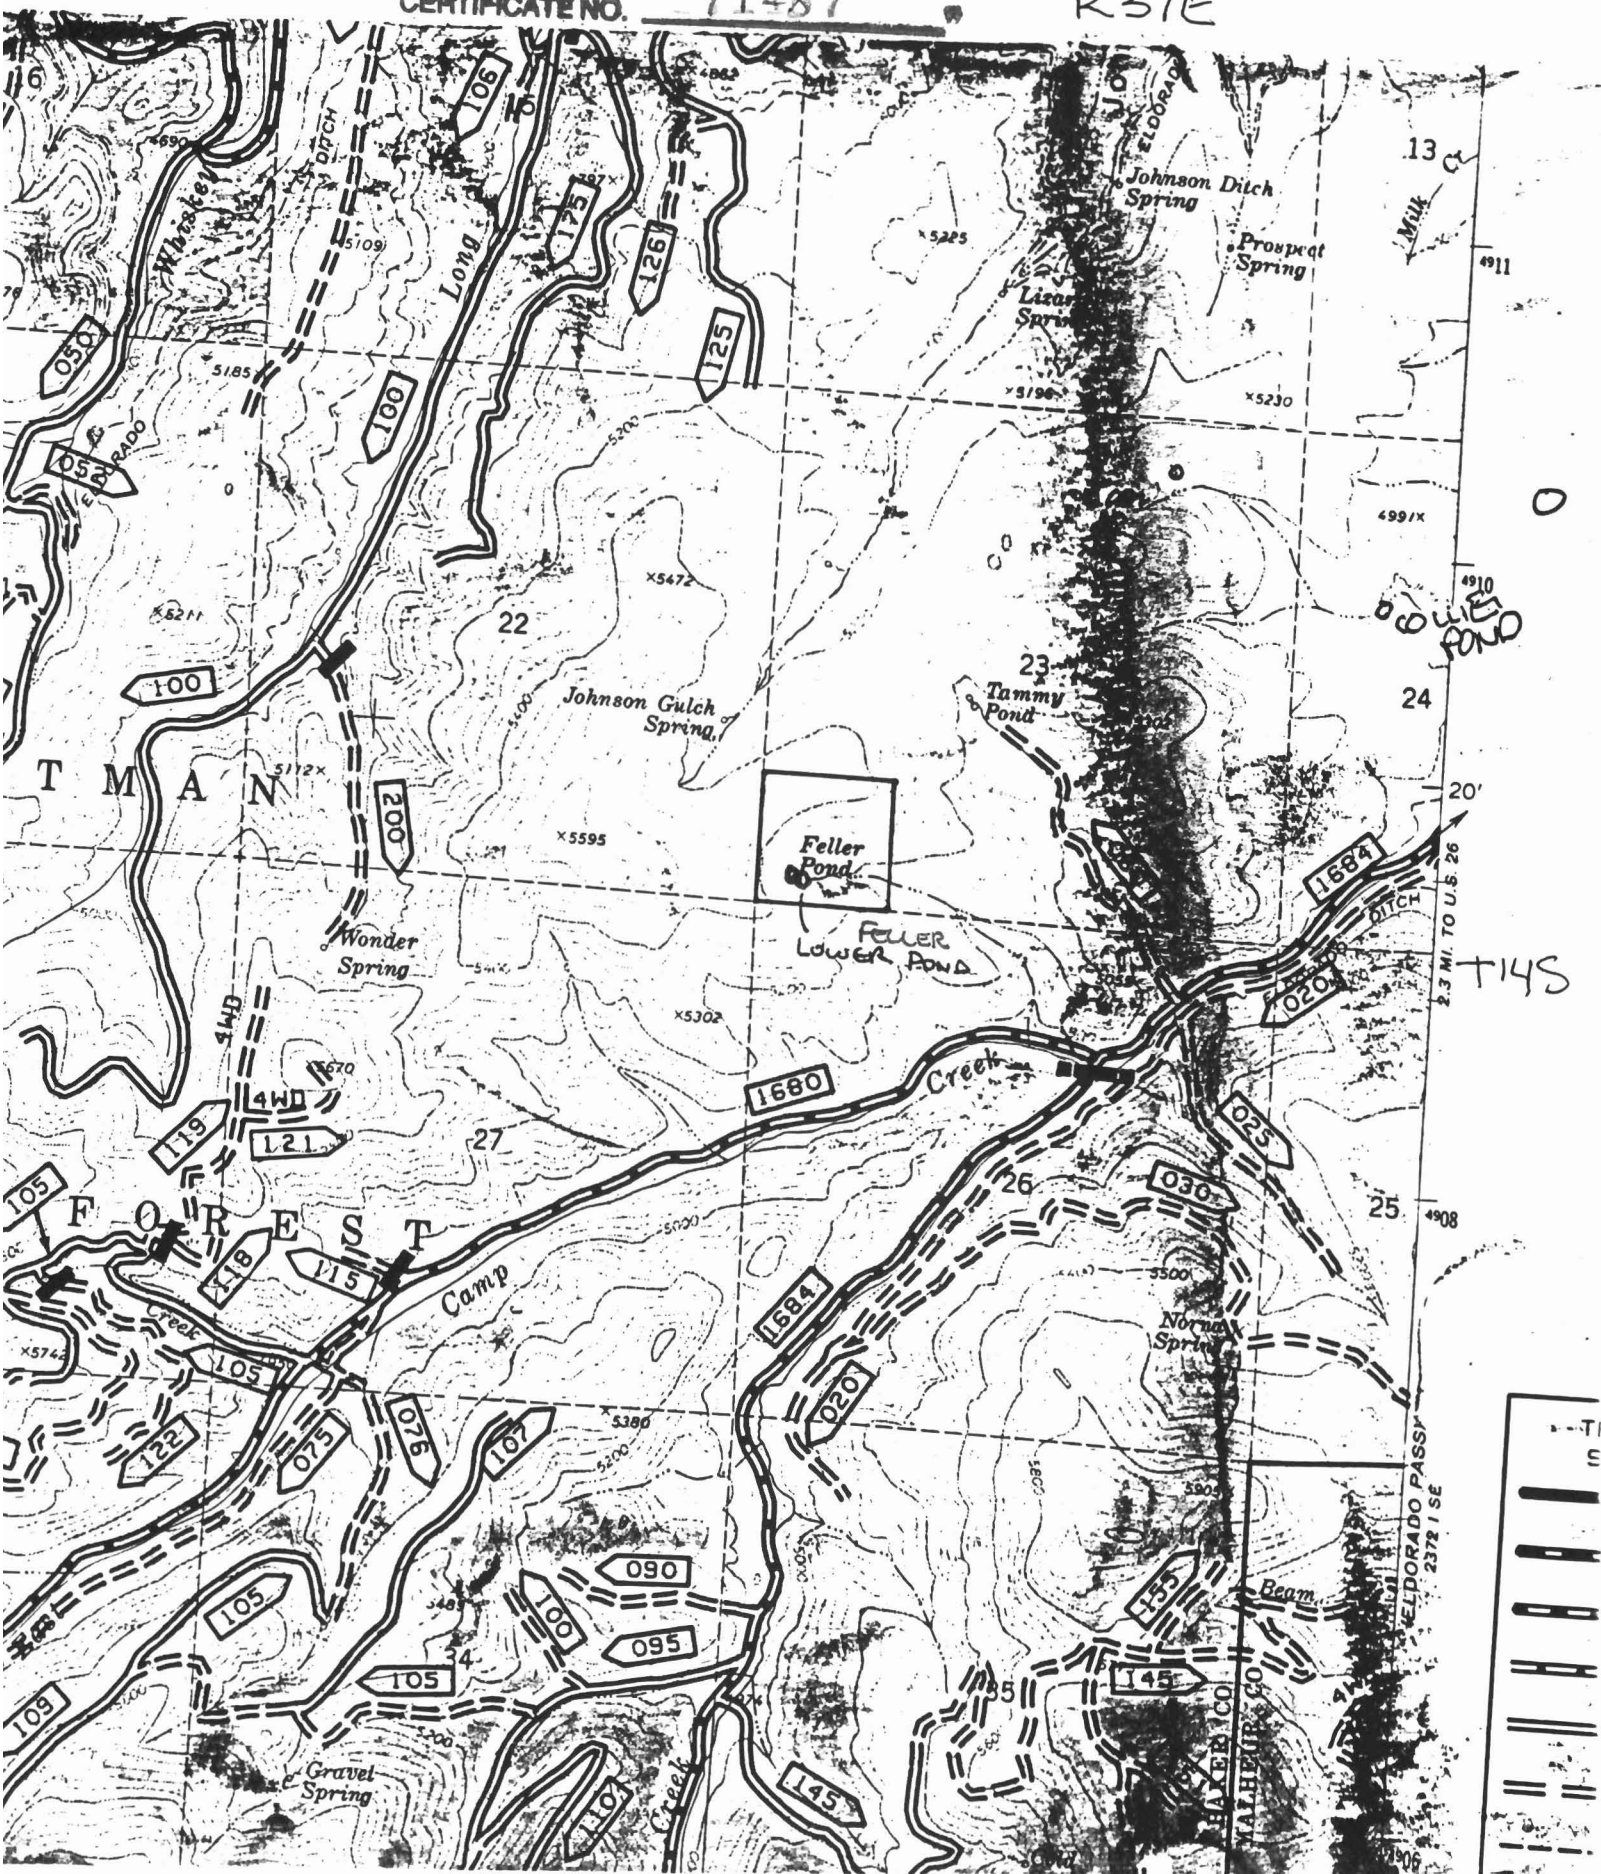



R 79590


71487

PRIMARY HWY

## SECONDARY HWY

IMPROVED ROAD  
PAVED

## IMPROVED ROAD

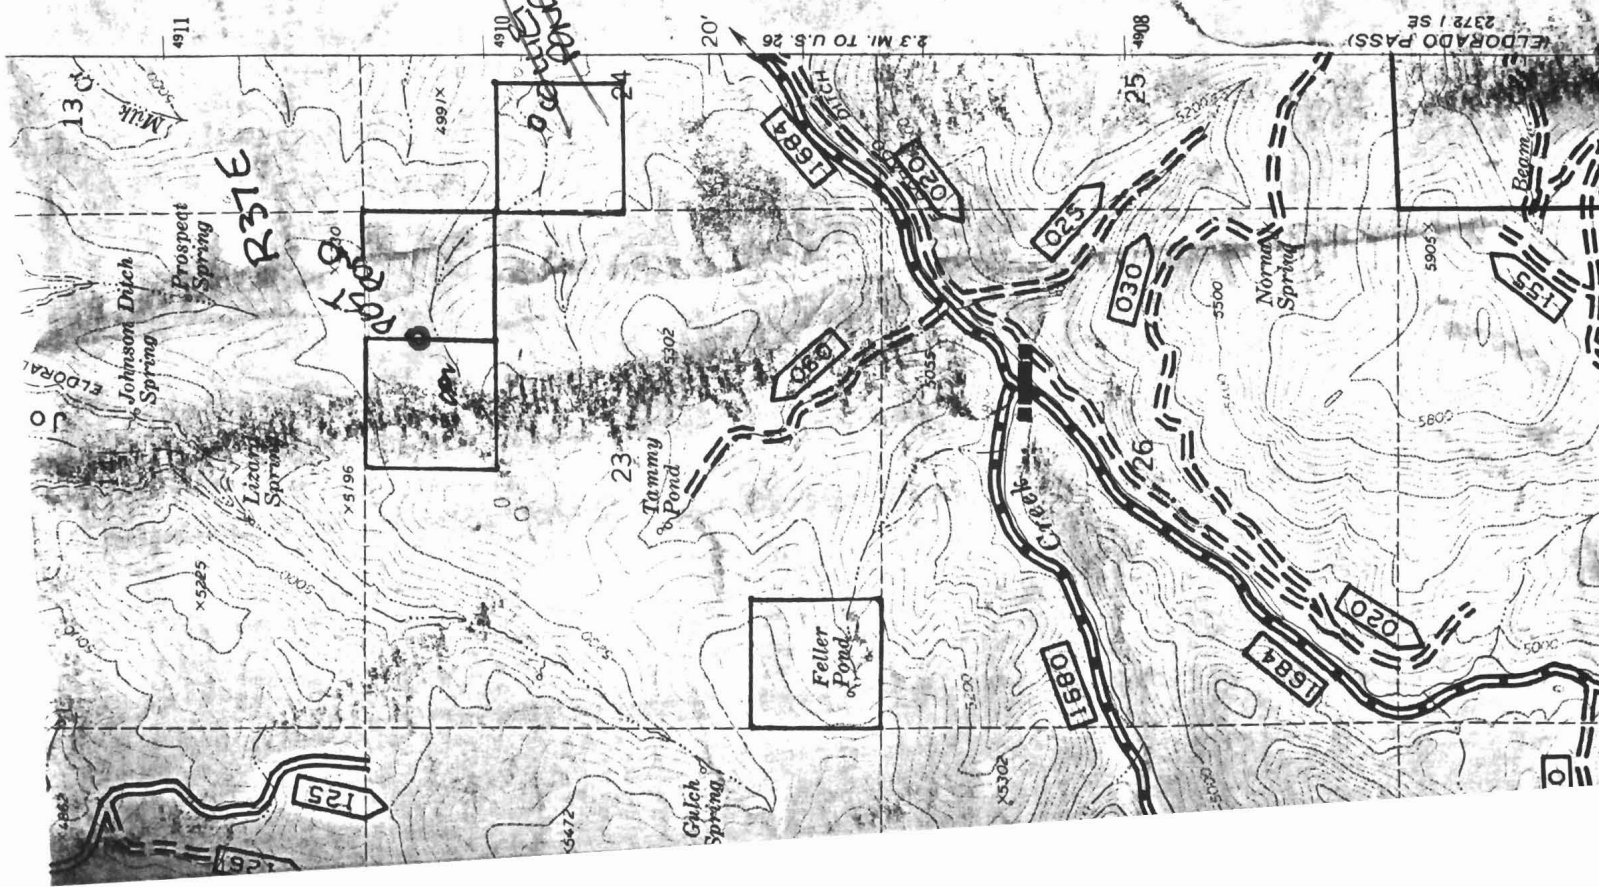

"CERTIFICATE NO. 71487"

**"CERTIFICATE NO.**

RASTUS MTN. QUADRANGLE  
OREGON 1984  
7.5 MINUTE SERIES (TOPOGRAPHIC)

7.5 MINUTE SERIES (TOPOGRAPHIC)

2 620 000 FEET  
(NORTH) | 118° 07' 30" 44° 22' 30"

T14S

