


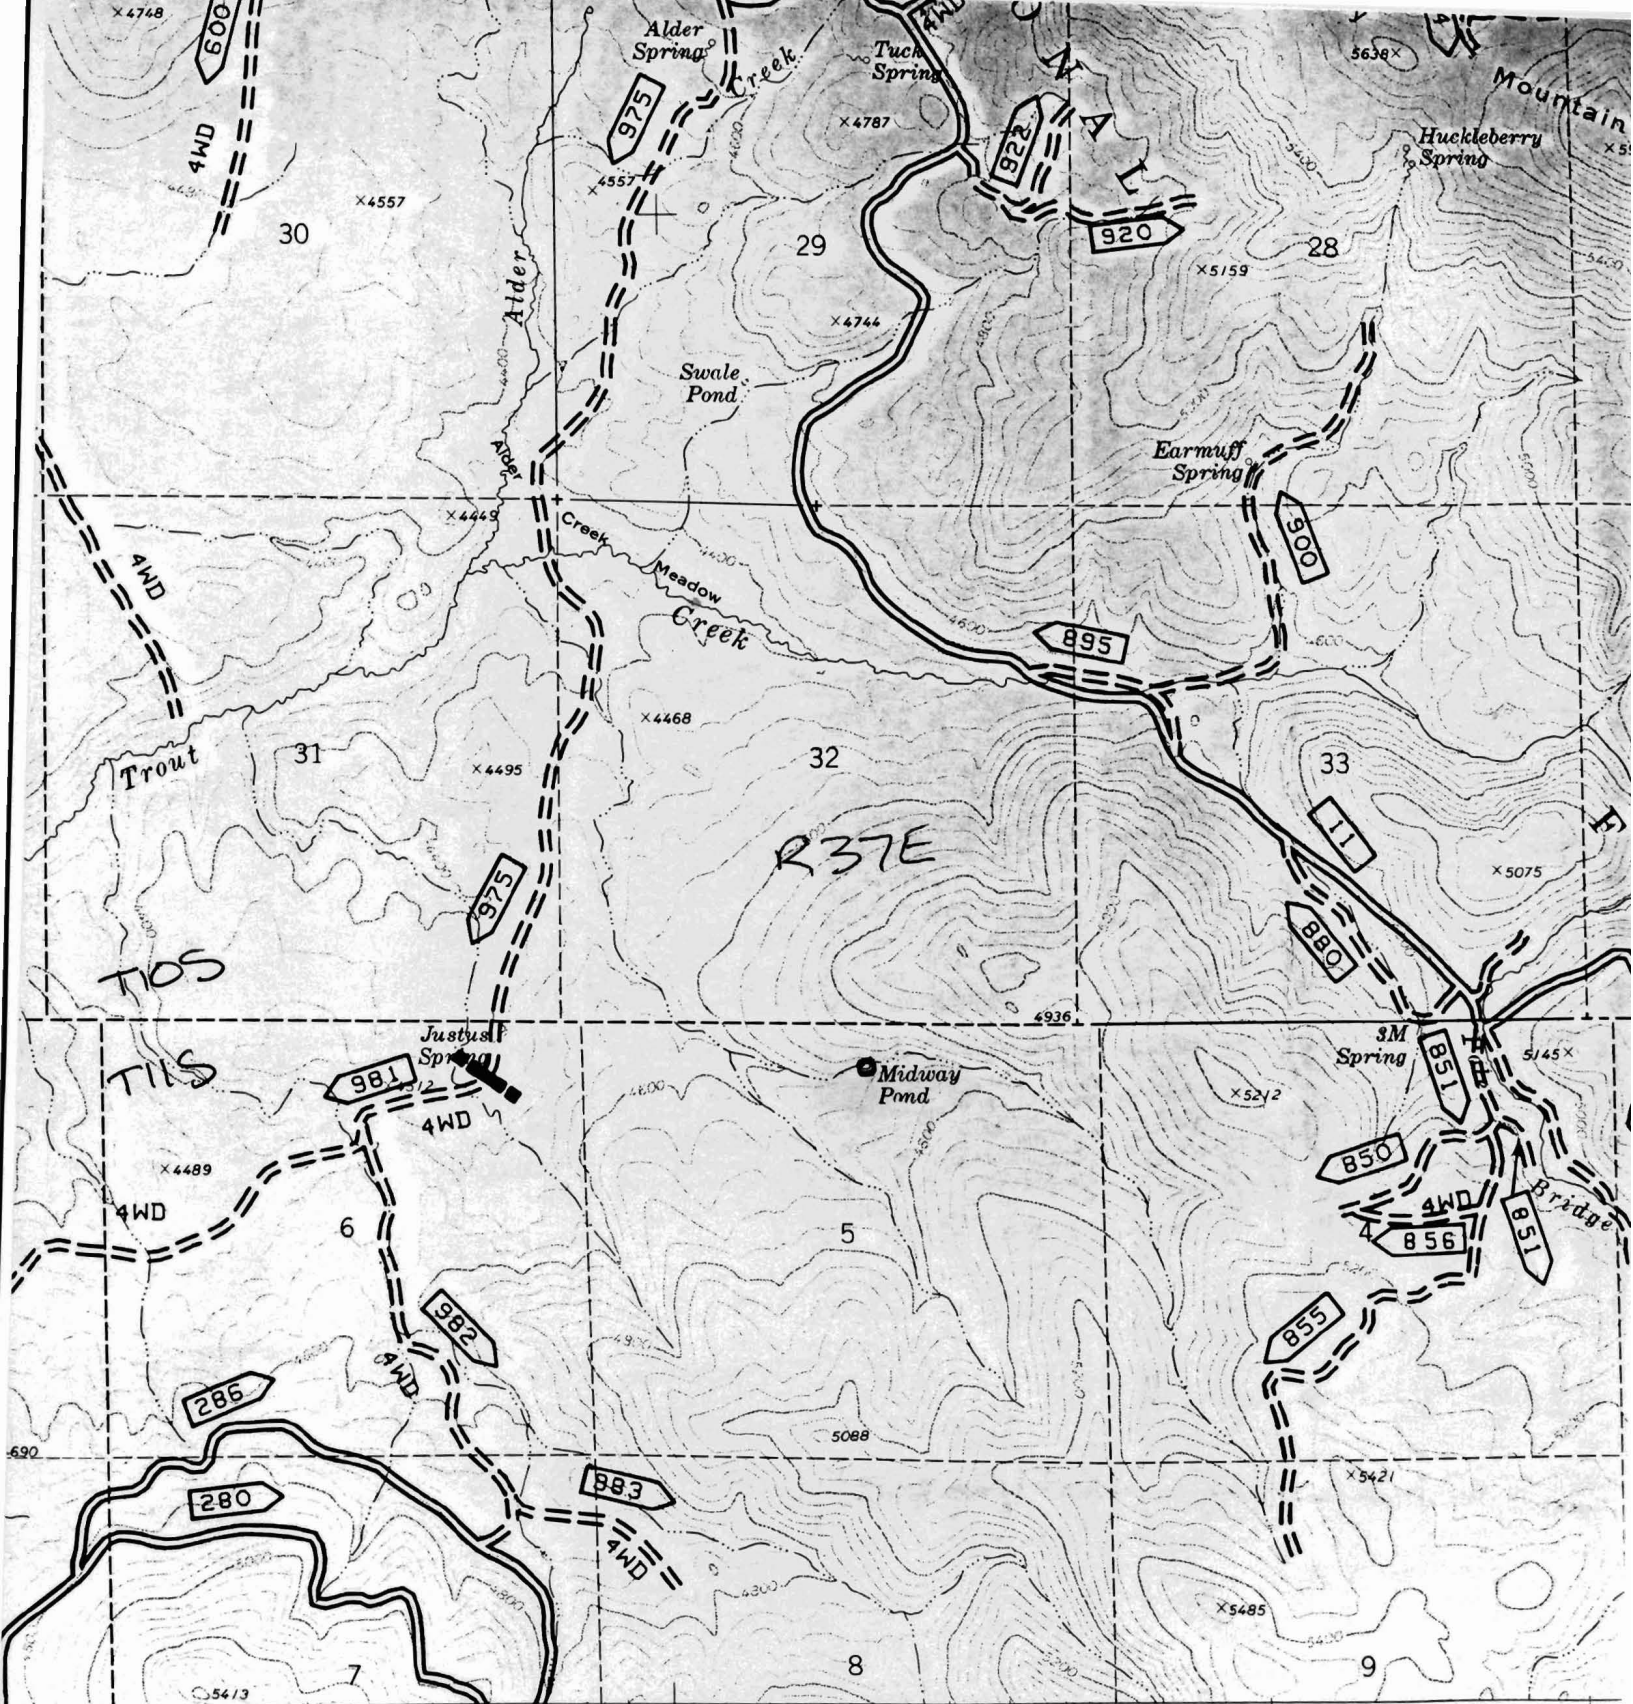


2590 000 FEET R 37 E 403 404 12'30" 405 (UNITY RESERVOIR) 2373 II SW 407
 Geological Survey SCALE 1:24 000

Methods from aerial
 dated 1972
 Oregon coordinate
 (al conic)
 arcator grid ticks,
 American datum
 can Datum 1983

GN
 MN
 0°50' 15 MILS.
 18 1/2° 329 MILS.

Application No K-79591
 Permit No. LEGEND
 National Forest Boundary
 Alienated Land within the National
 "CERTIFICATE NO. 71488

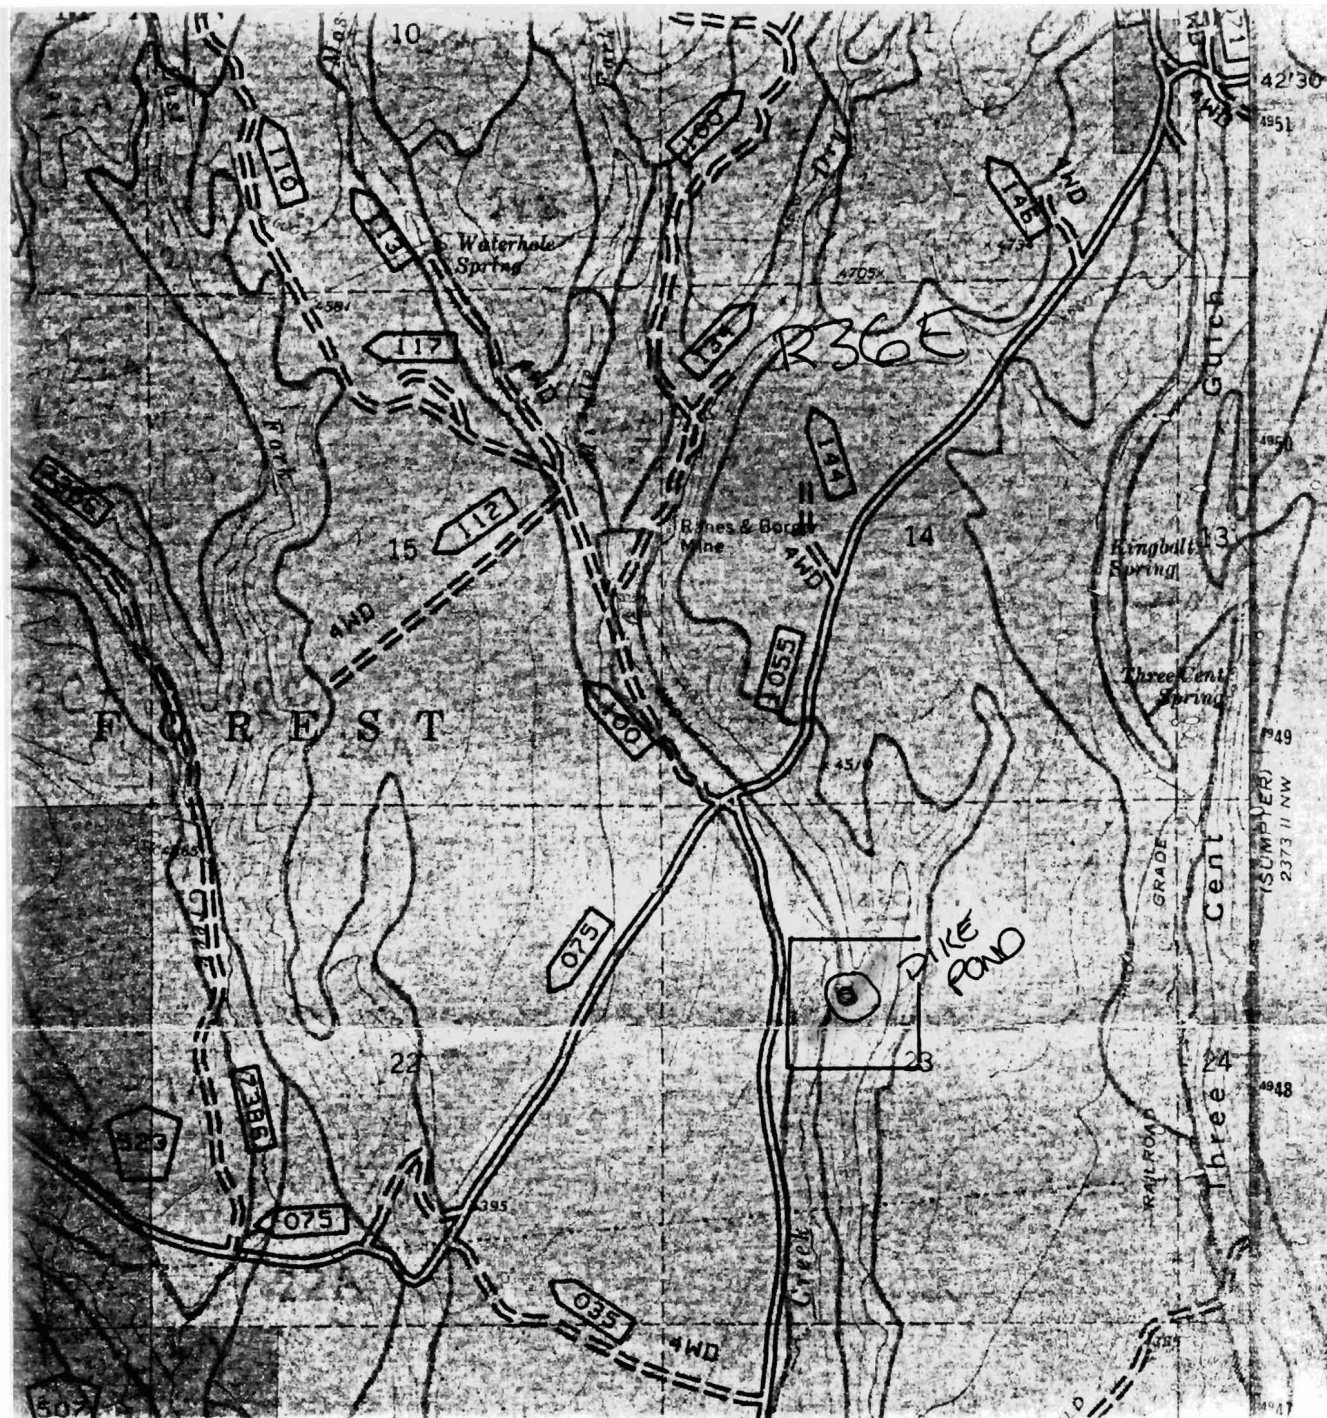

WHITNEY QUAD
1984
T10S


TRANSPORTATION SYSTEM UPDATE	
	PRIMARY HWY
	SECONDARY HWY
	IMPROVED ROAD PAVED
	IMPROVED ROAD GRAVEL
	IMPROVED ROAD DIRT
	UNIMPROVED RD
	TRAIL
	INTERSTATE HIGHWAY
	U.S. HIGHWAY
	OREGON

"CERTIFICATE NO. 71488"
Application No. R-79591
Permit No.



T10S
SUMMIT QUAD
1984


"CERTIFICATE NO. 711488"
Application No. K 795911
Permit No.


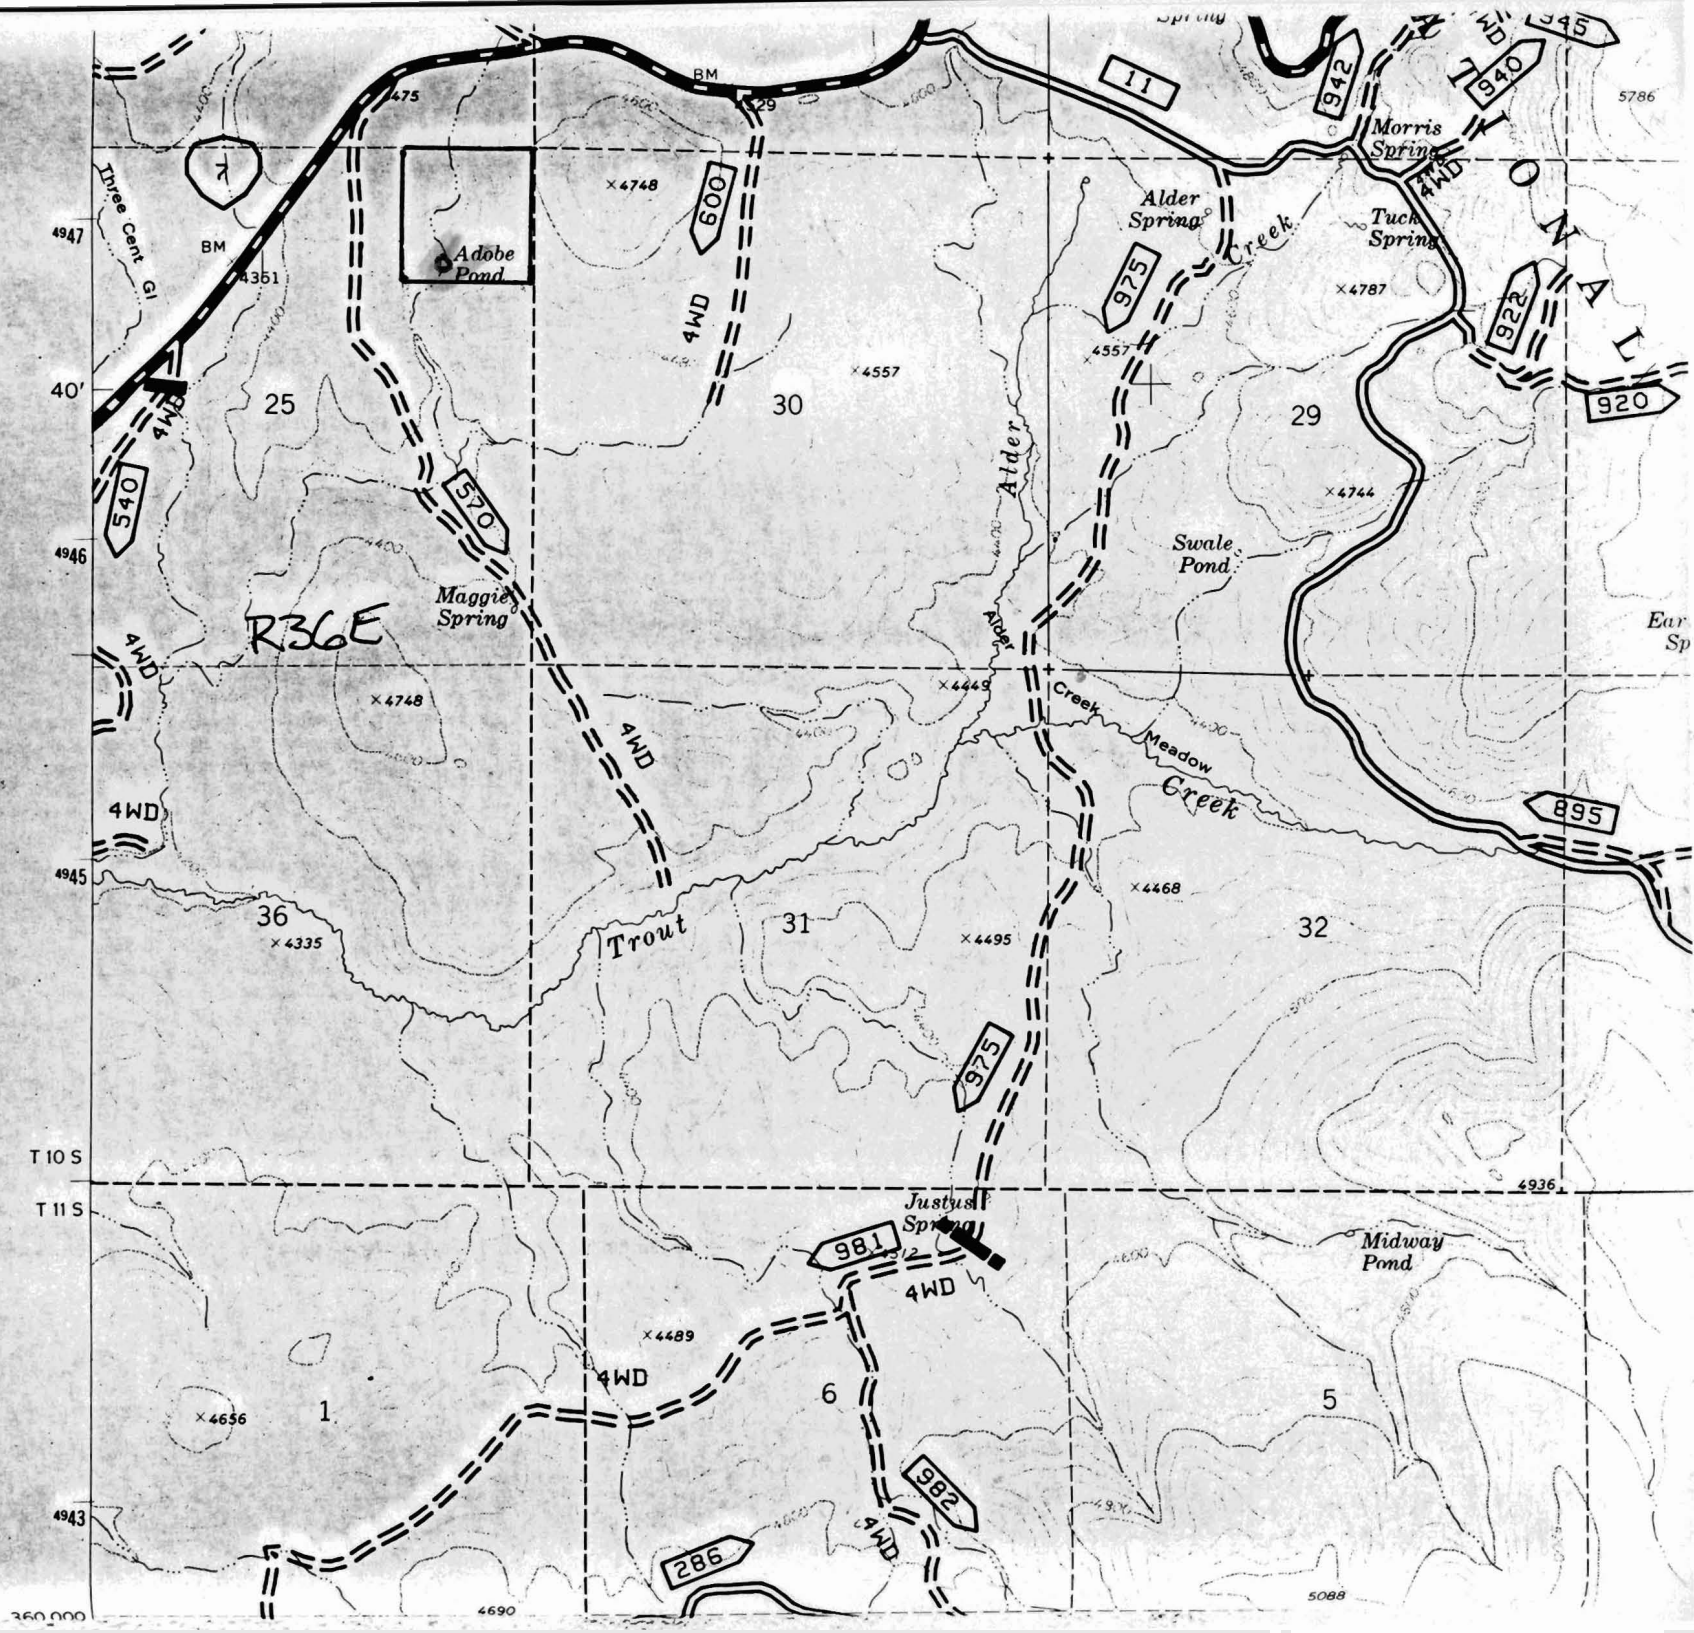


T 115

"CERTIFICATE NO.

71788

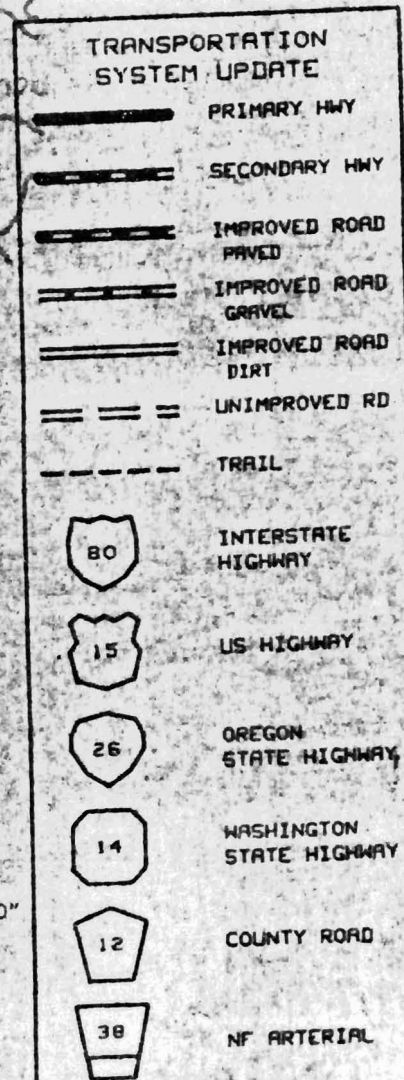


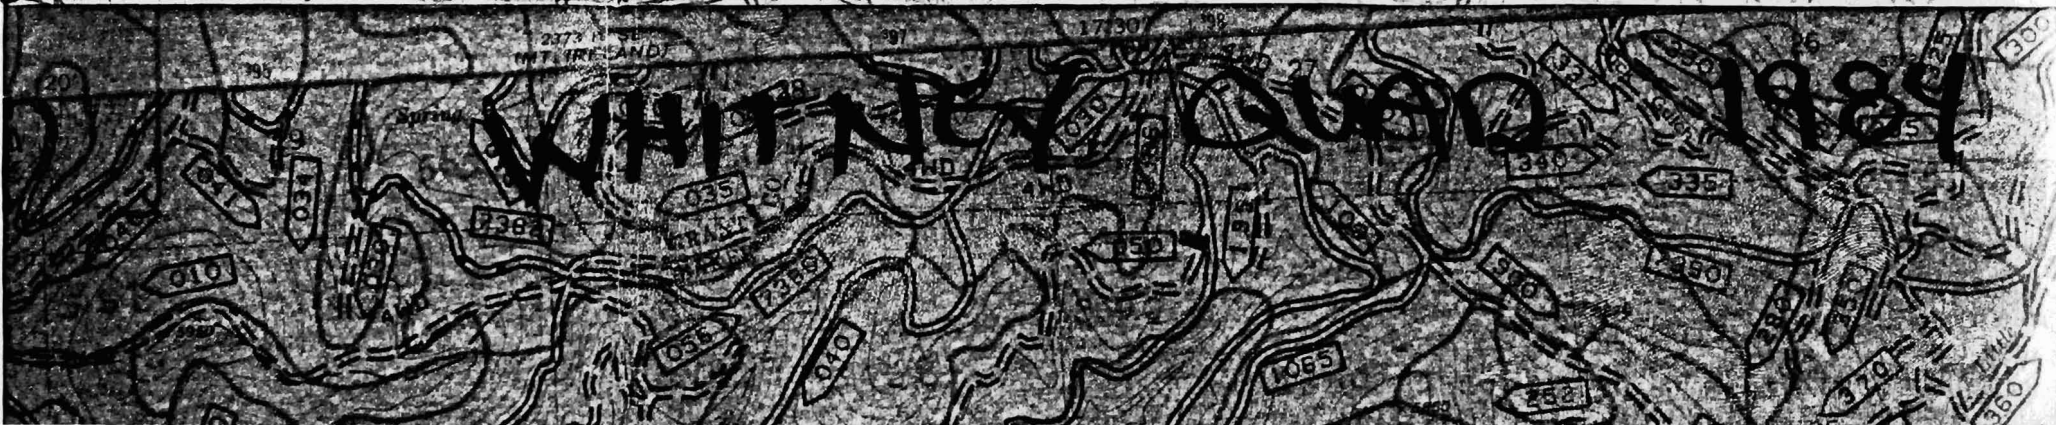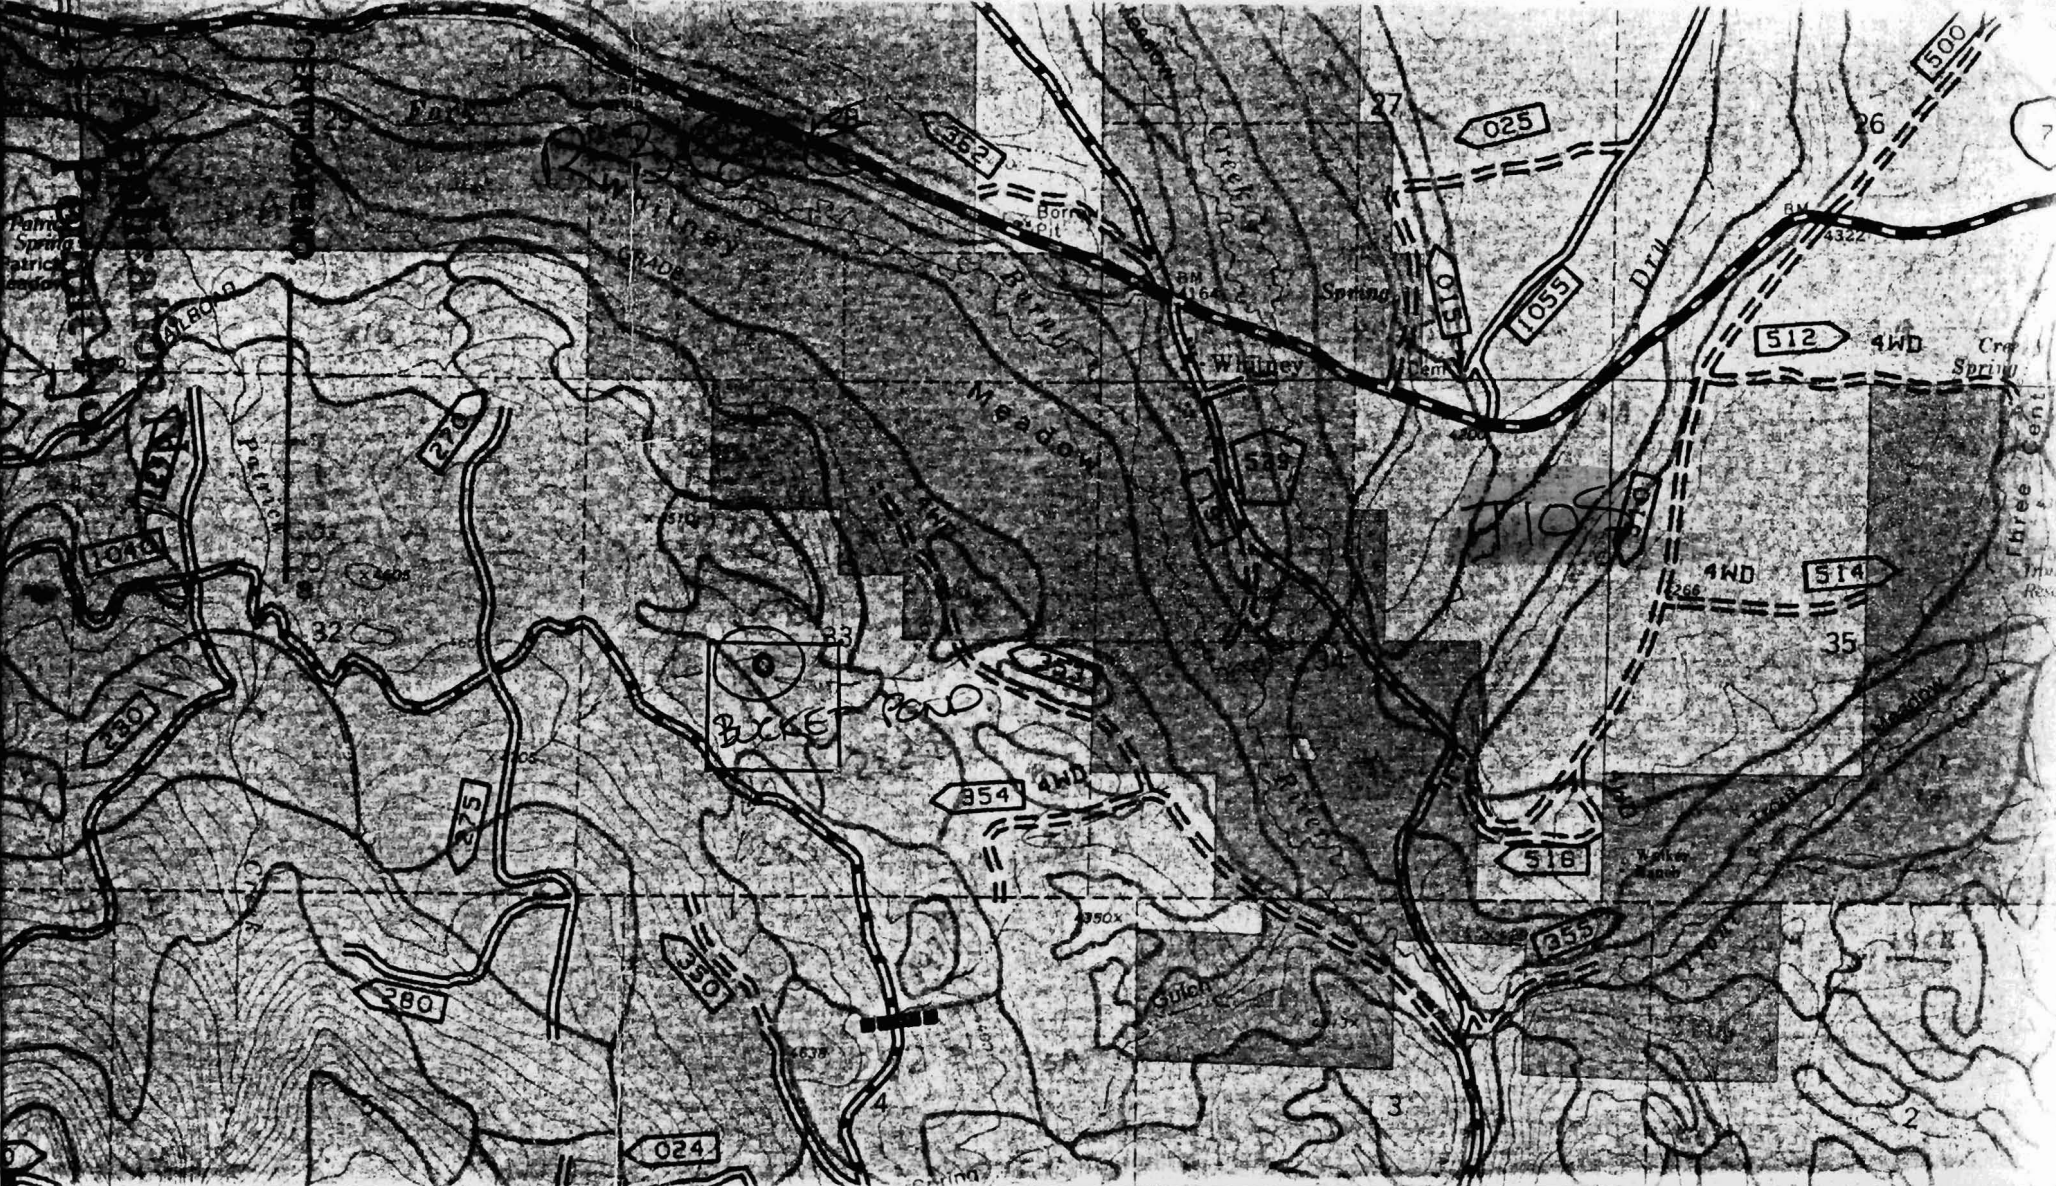




(UNITY RESERVOIR)
2373 II SW

SCALE 1:24 000

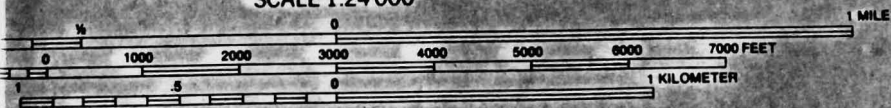

LEGEND

SUMPTER QUAD
1984

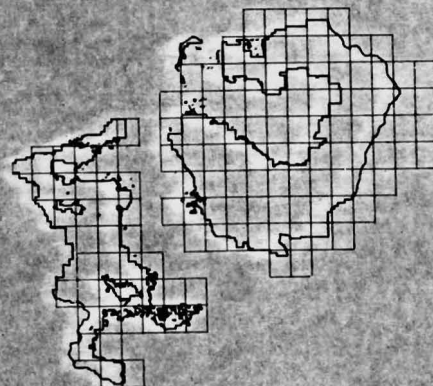

QUADRANGLE LOCATION DIAGRAM

"CERTIFICATE NO. 71188"

Application No. R-79591

Permit No.