

Application No. *L-79594*

420000-5

423


57'30"

425

2473 E HW
(BLUE CANYON)

426

57304

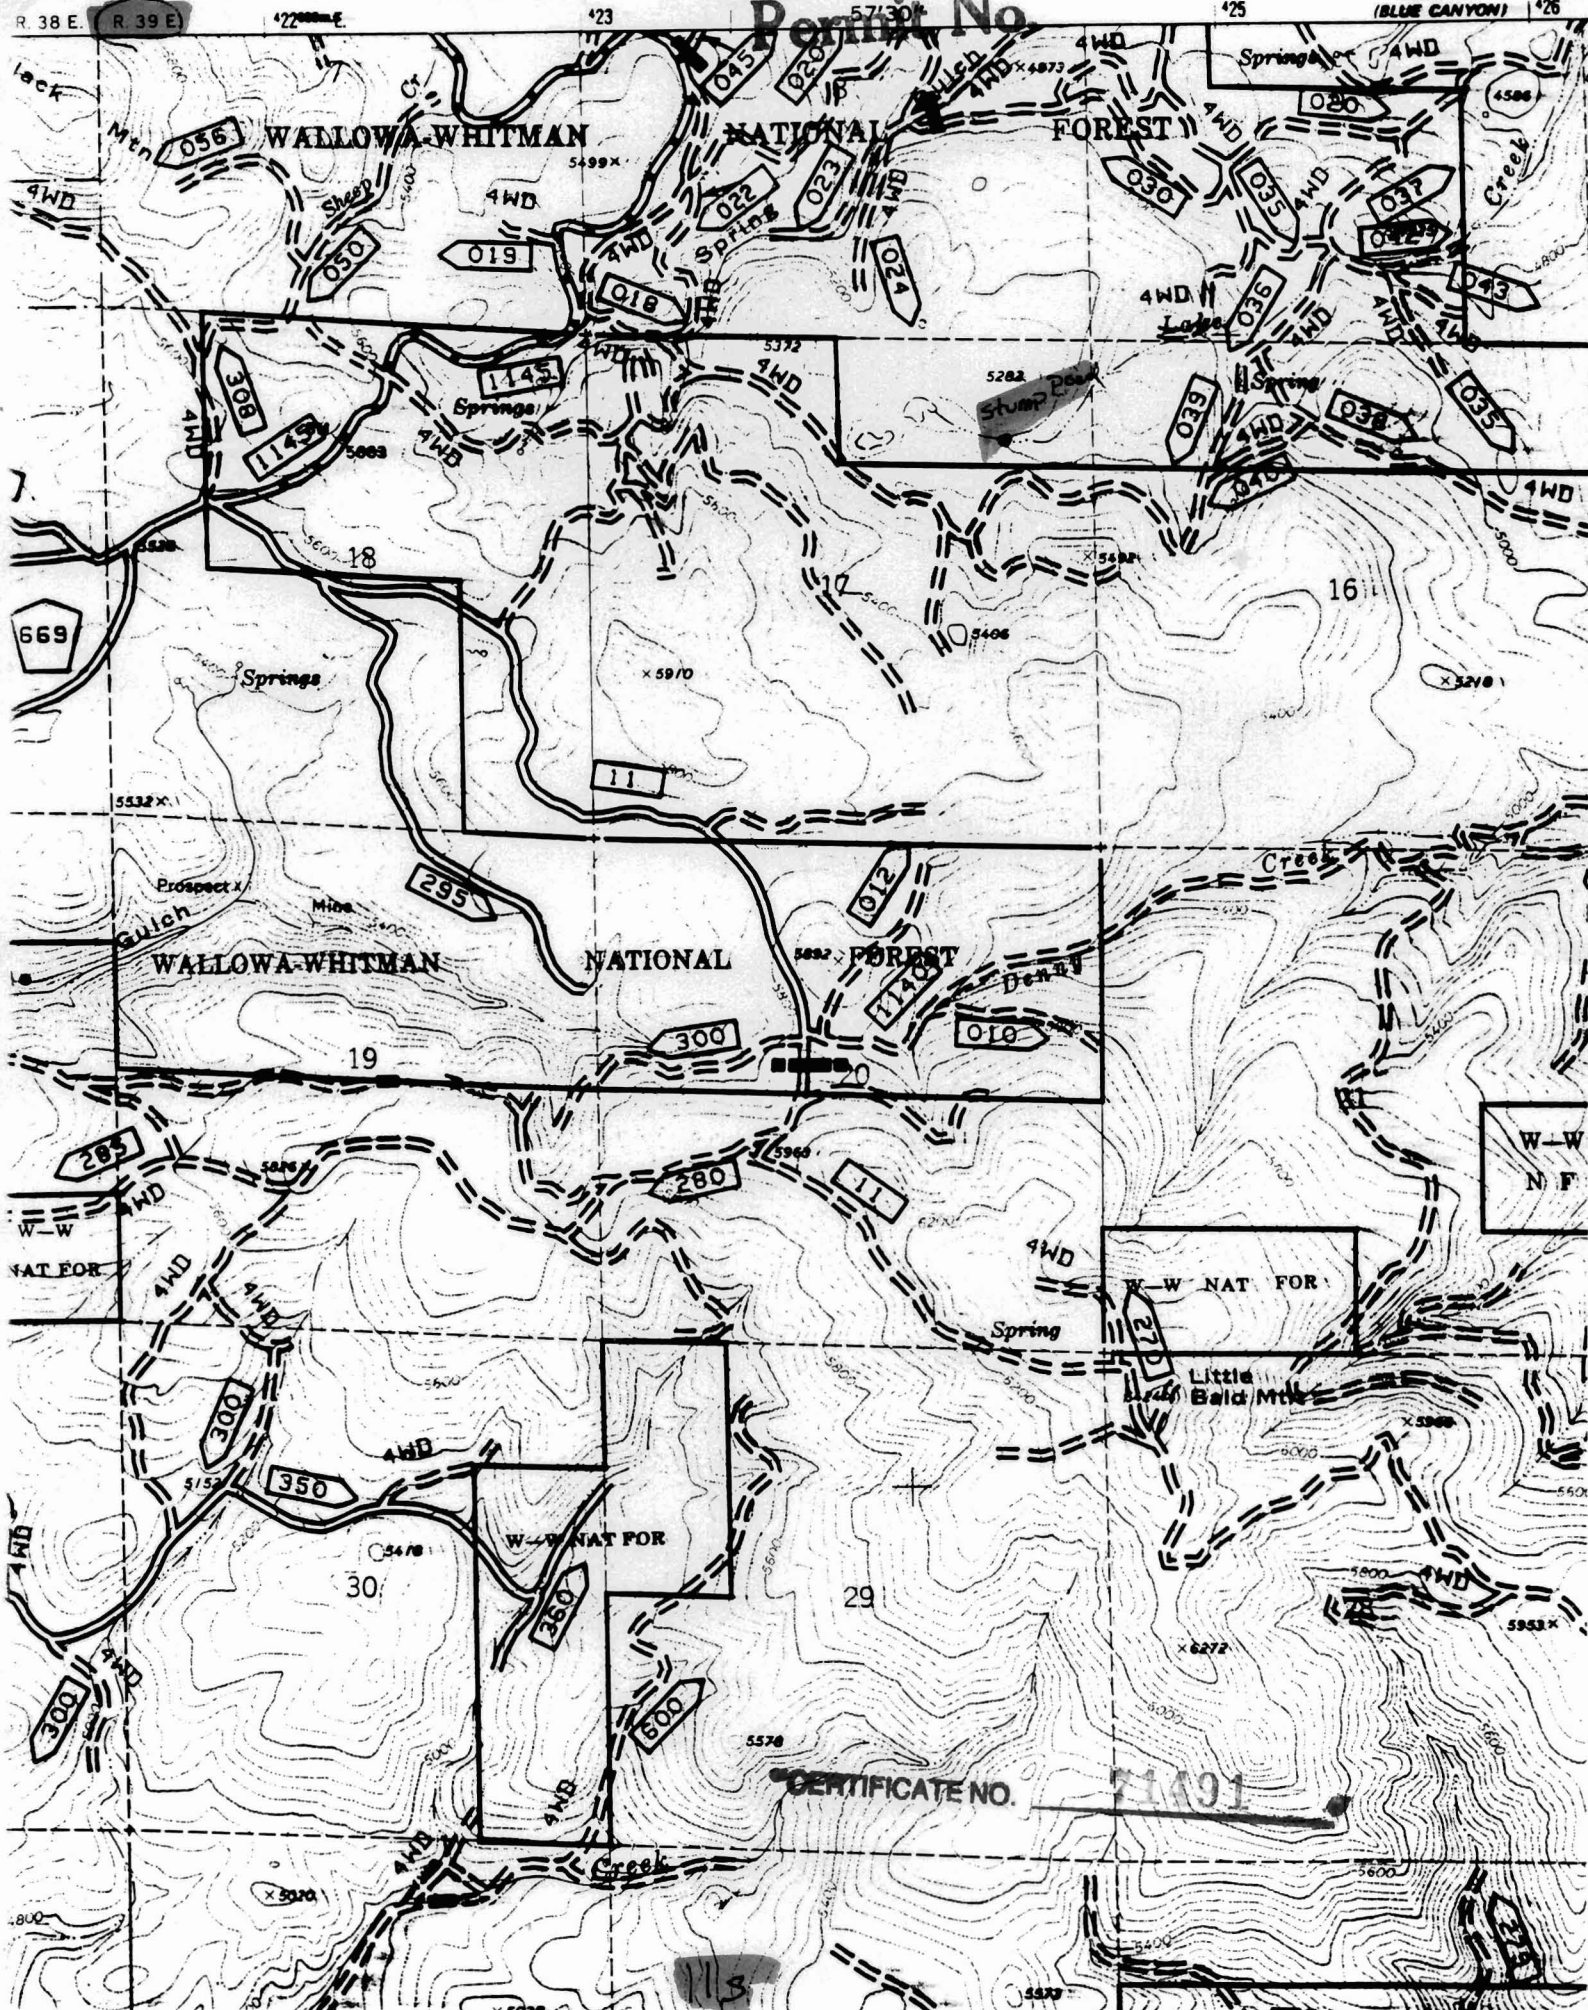


Application No. R-79594
Permit No.



T95 R36E

UNITED STATES
DEPARTMENT OF THE INTERIOR
GEOLOGICAL SURVEY
MODIFIED FOR USDA FOREST SERVICE USE


2373 IV SE
(MT. IRELAND)

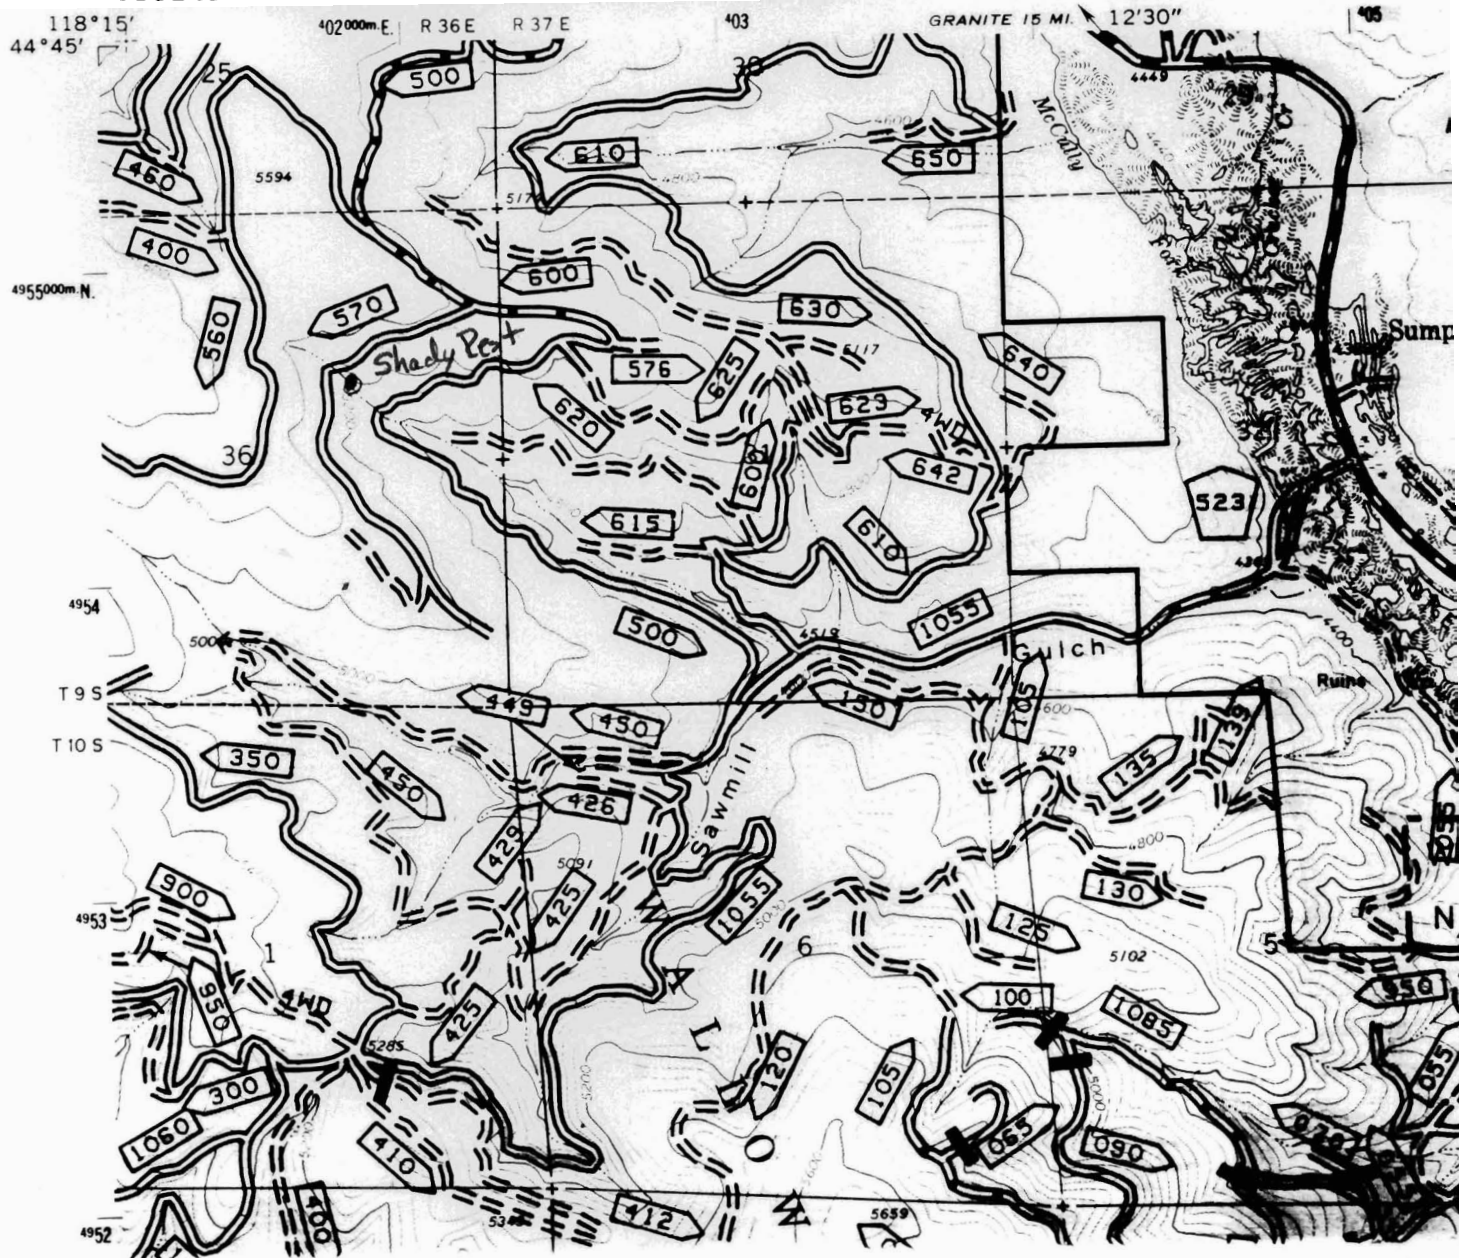


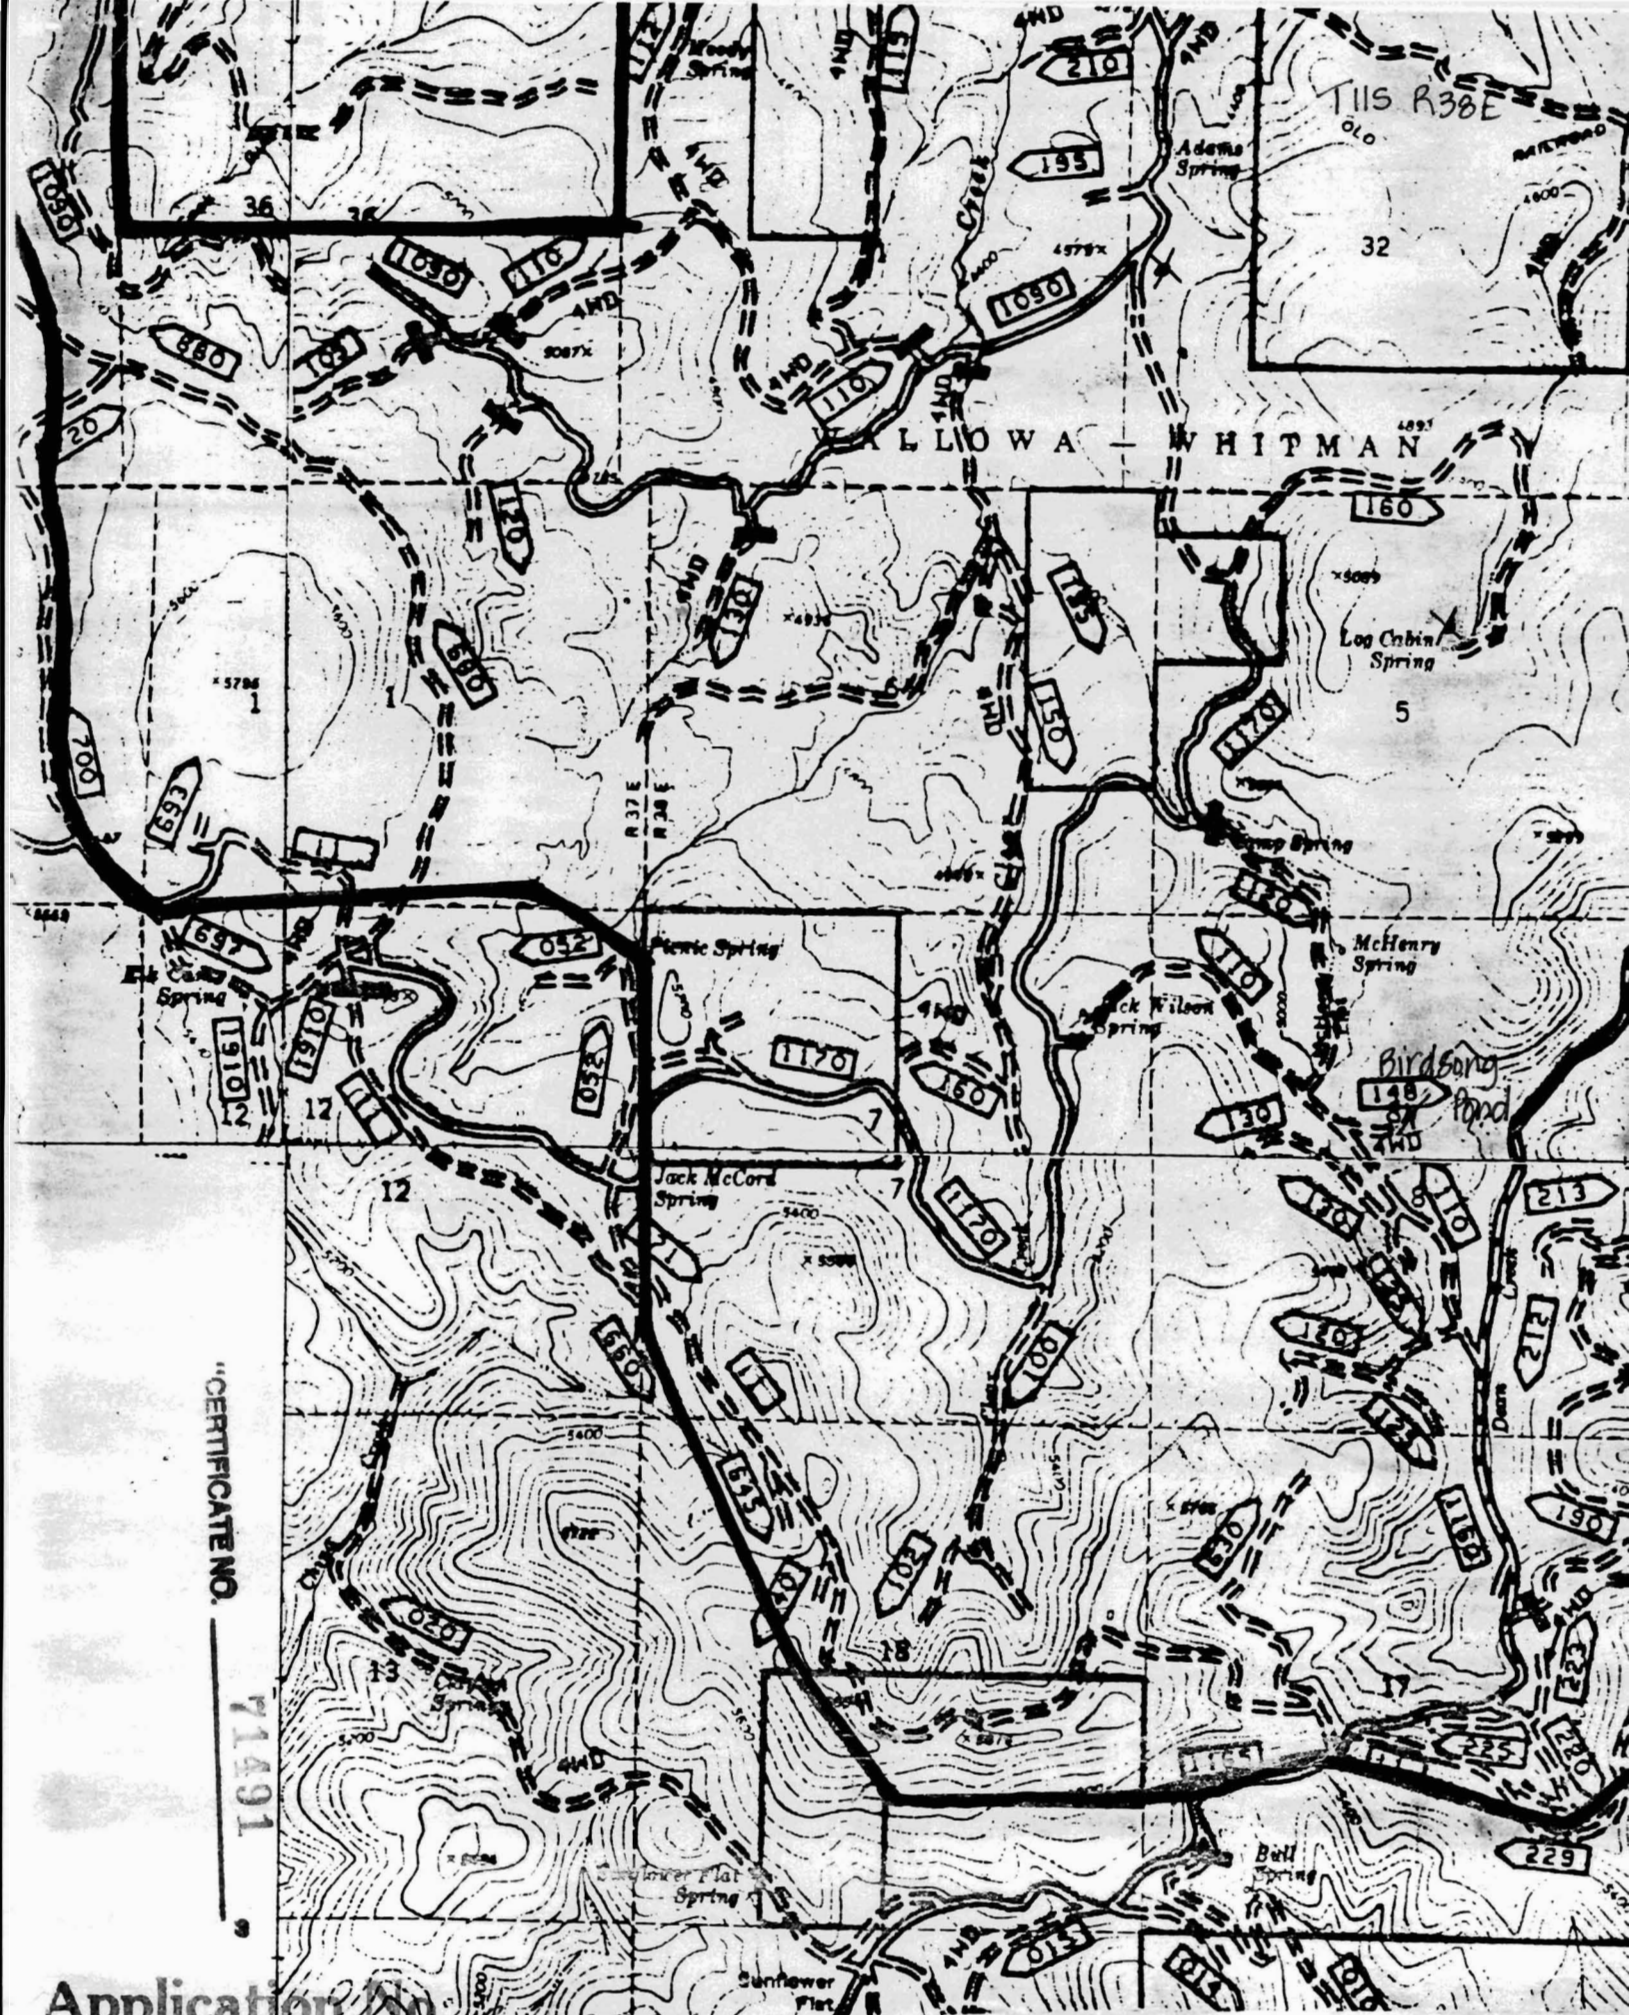


"CERTIFICATE NO. 71491"

Application No. Permit No.

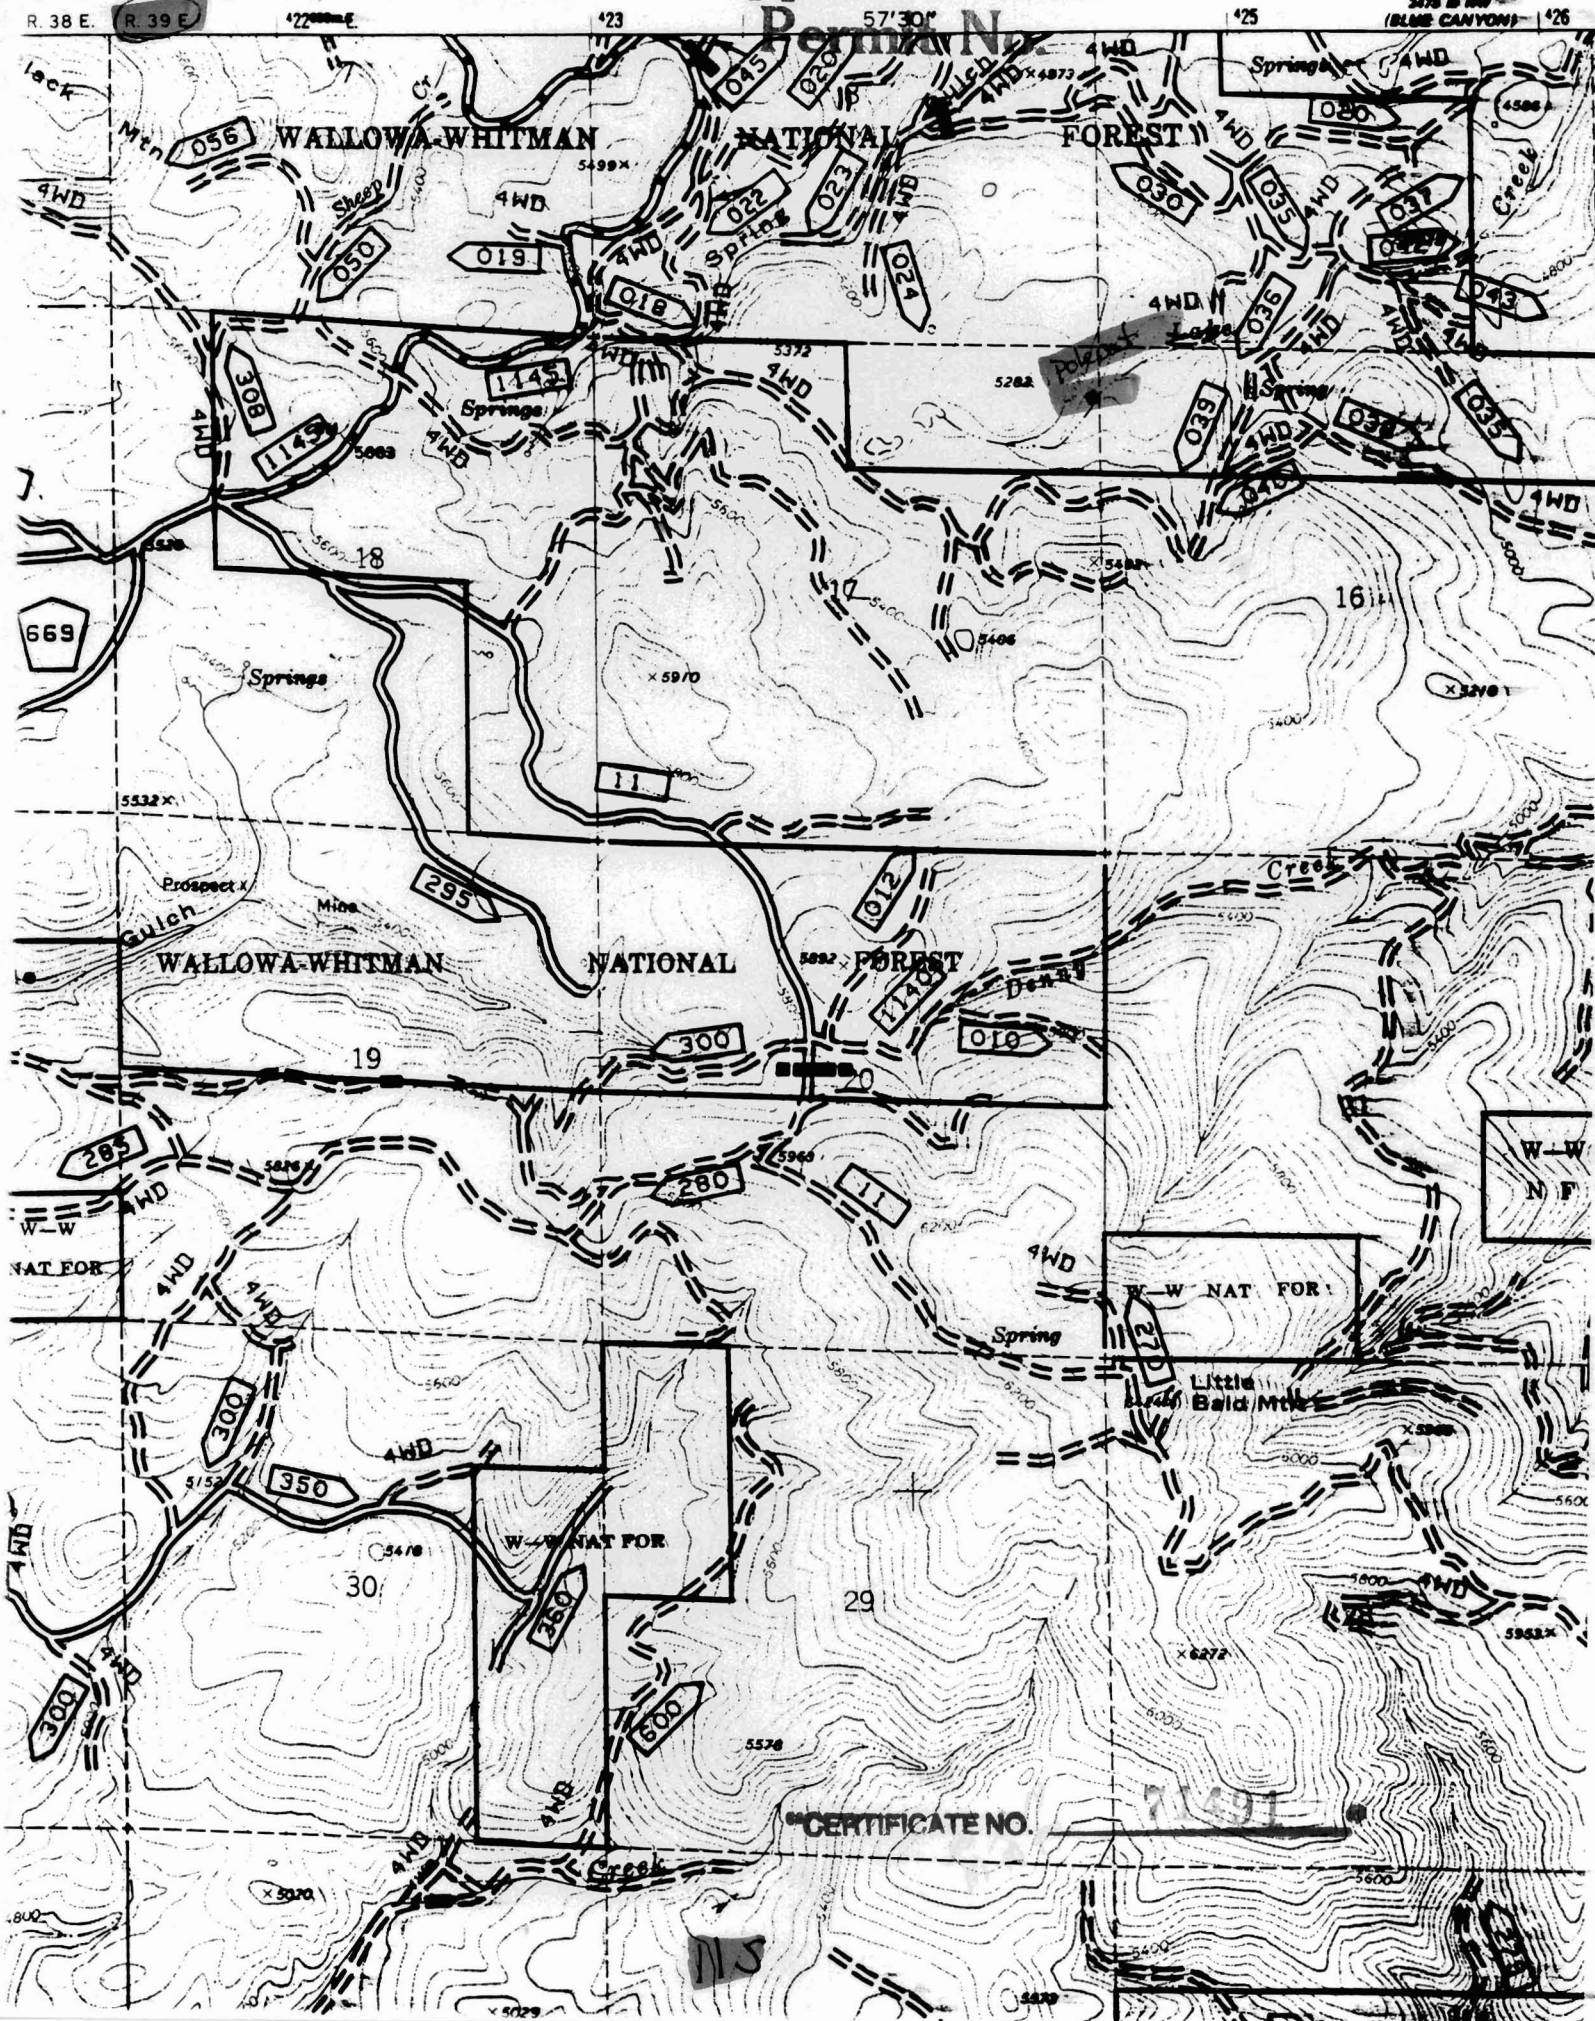

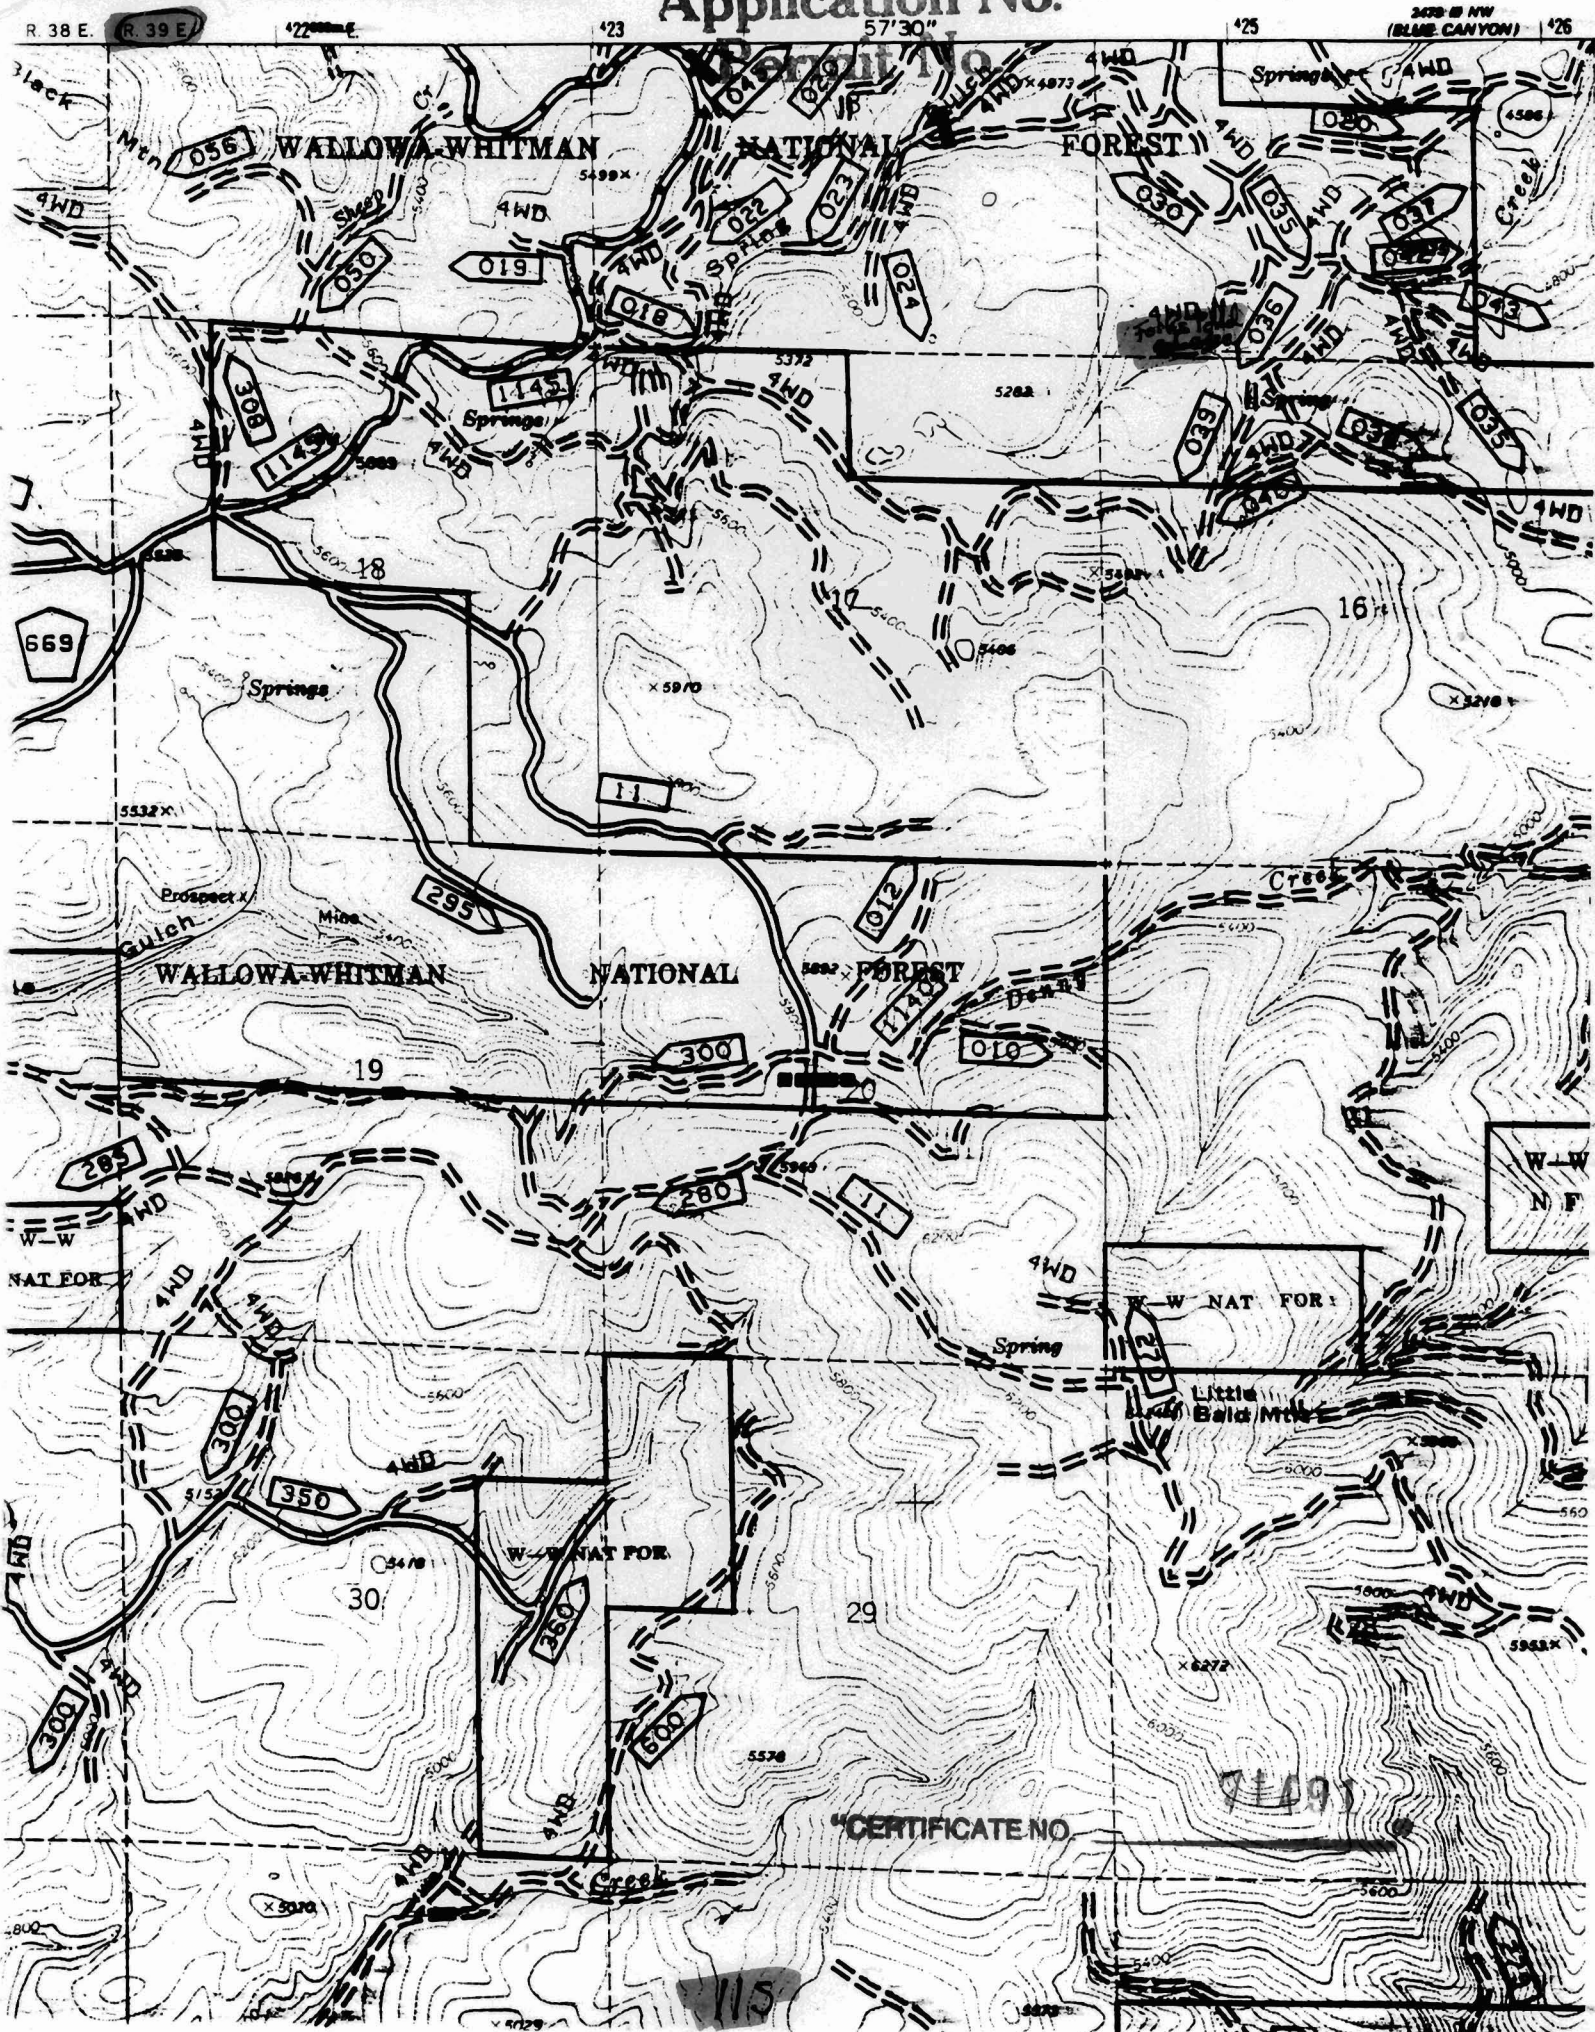

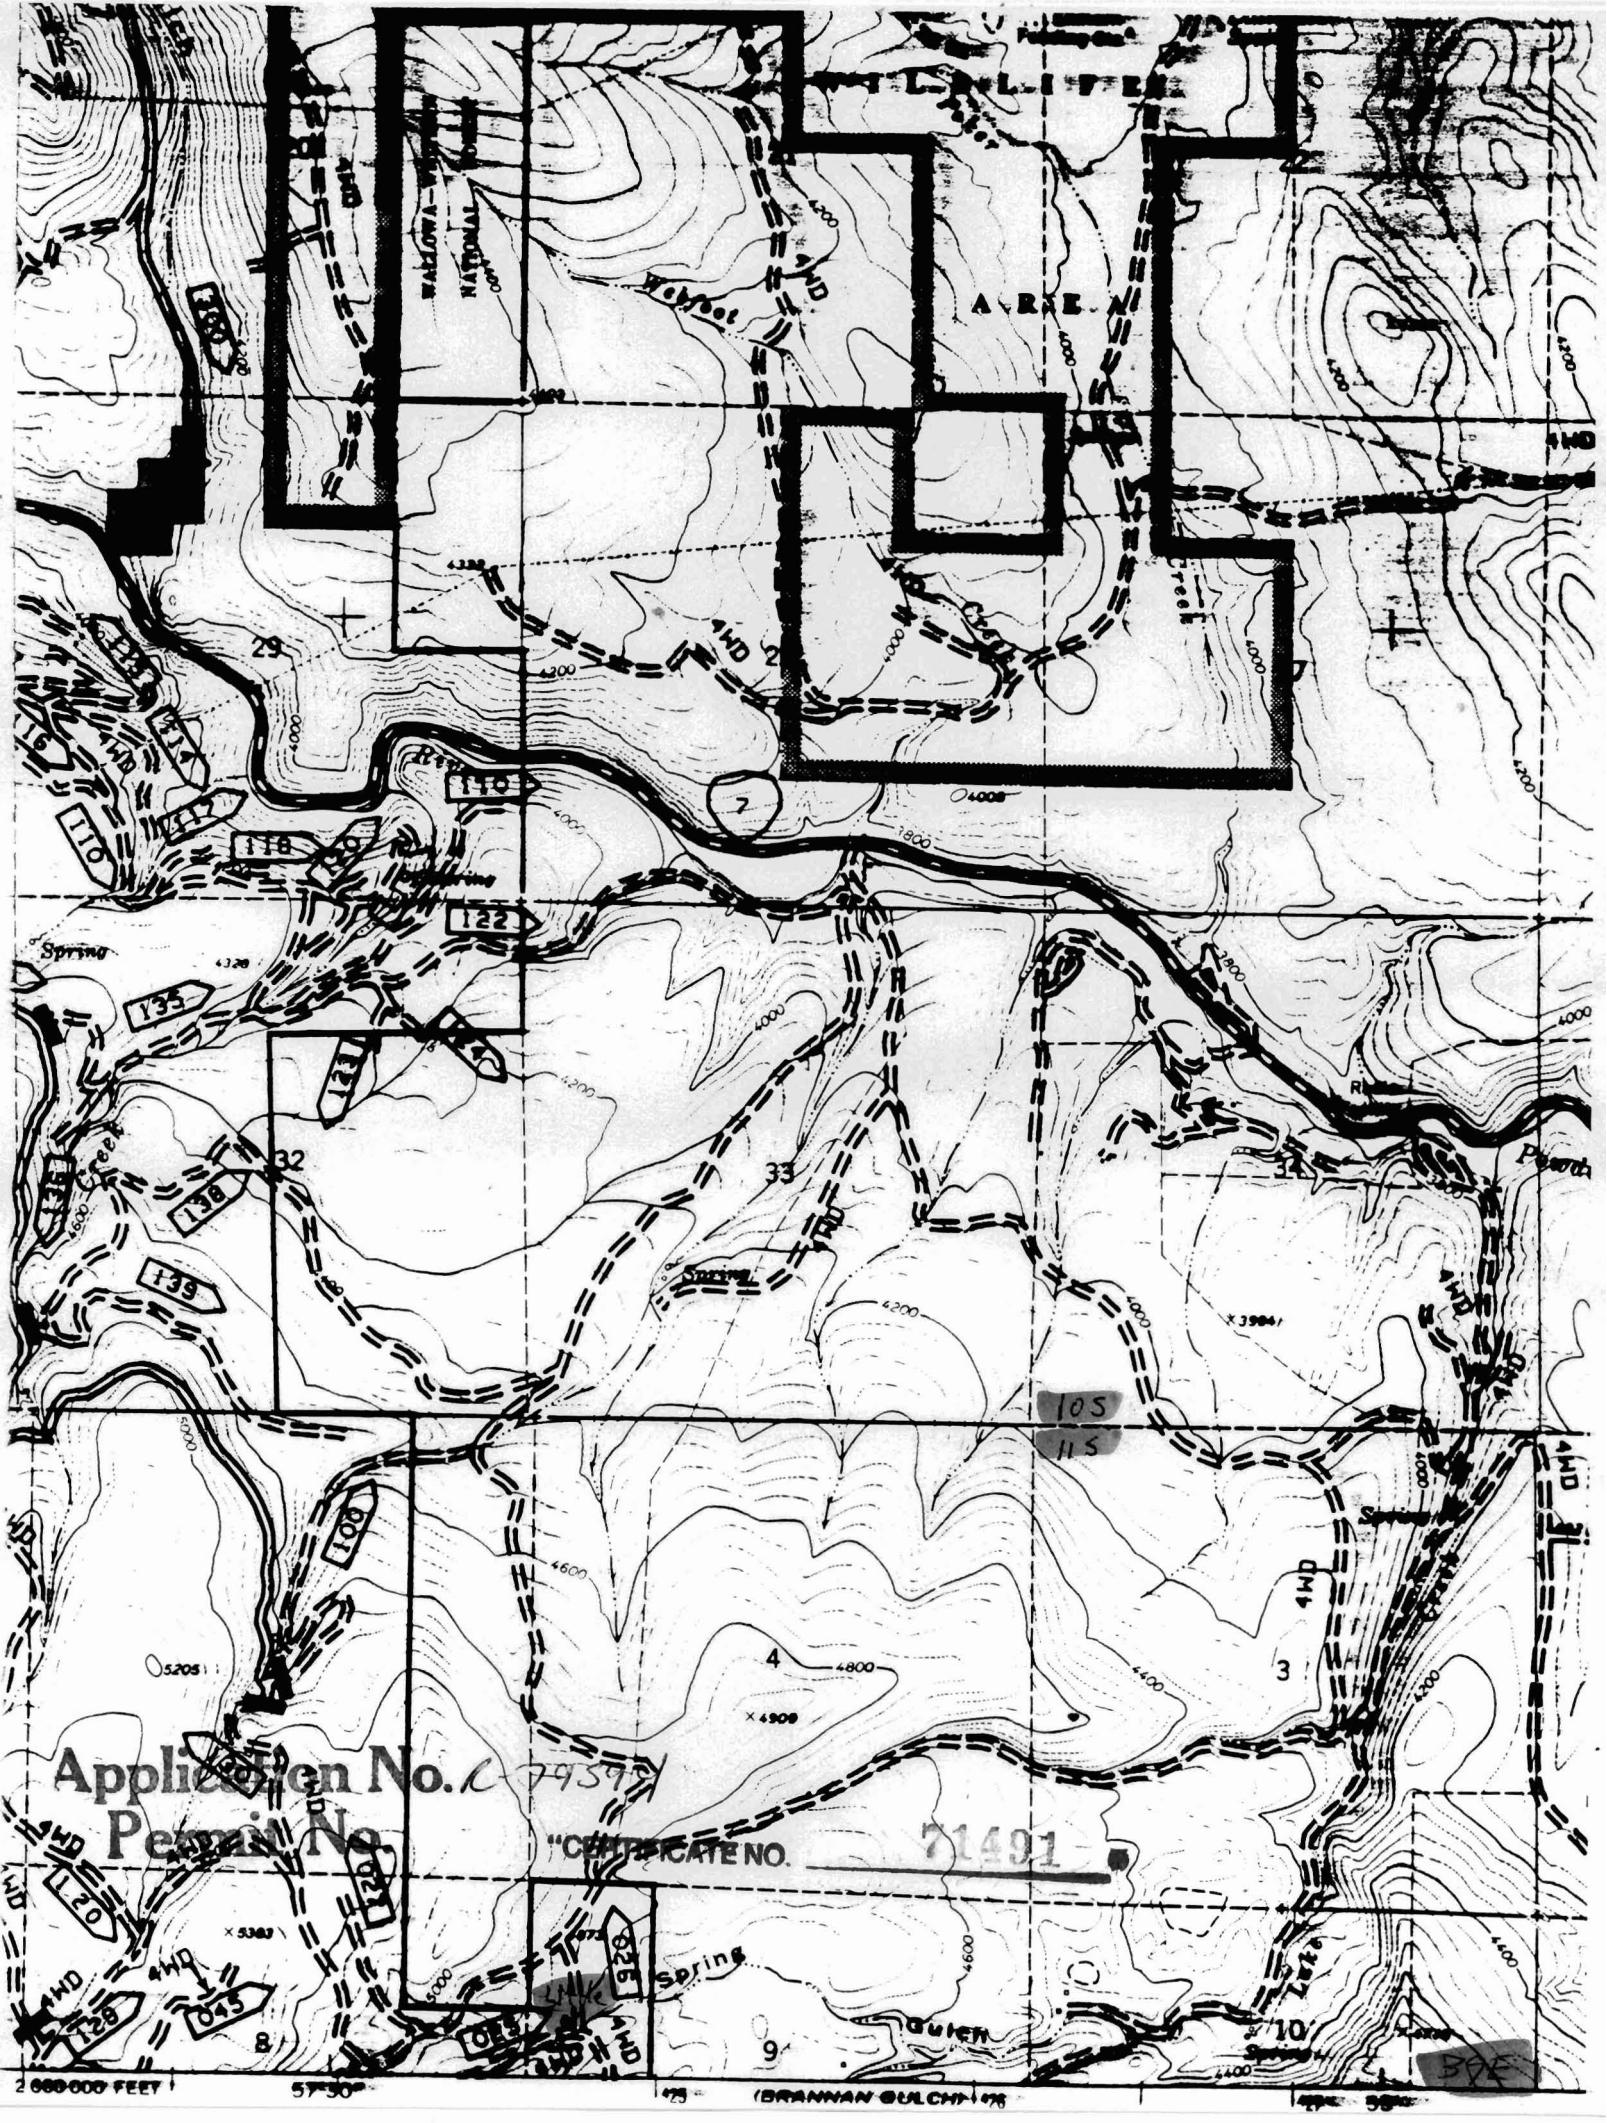

Application No. 7459

Permit No.

CERTIFICATE NO. 71491

T95 R37E

Application No. K-79594
Permit No. 21491

CERTIFICATE NO.

