

T10S R38E

147


PHILLIPS LAKE, OREG.

44118-F1-TF-024

1972
PHOTOREVISED 1984
DMA 2373 II NE-SERIES V892

KG24

BRIDGE CREEK POND #1

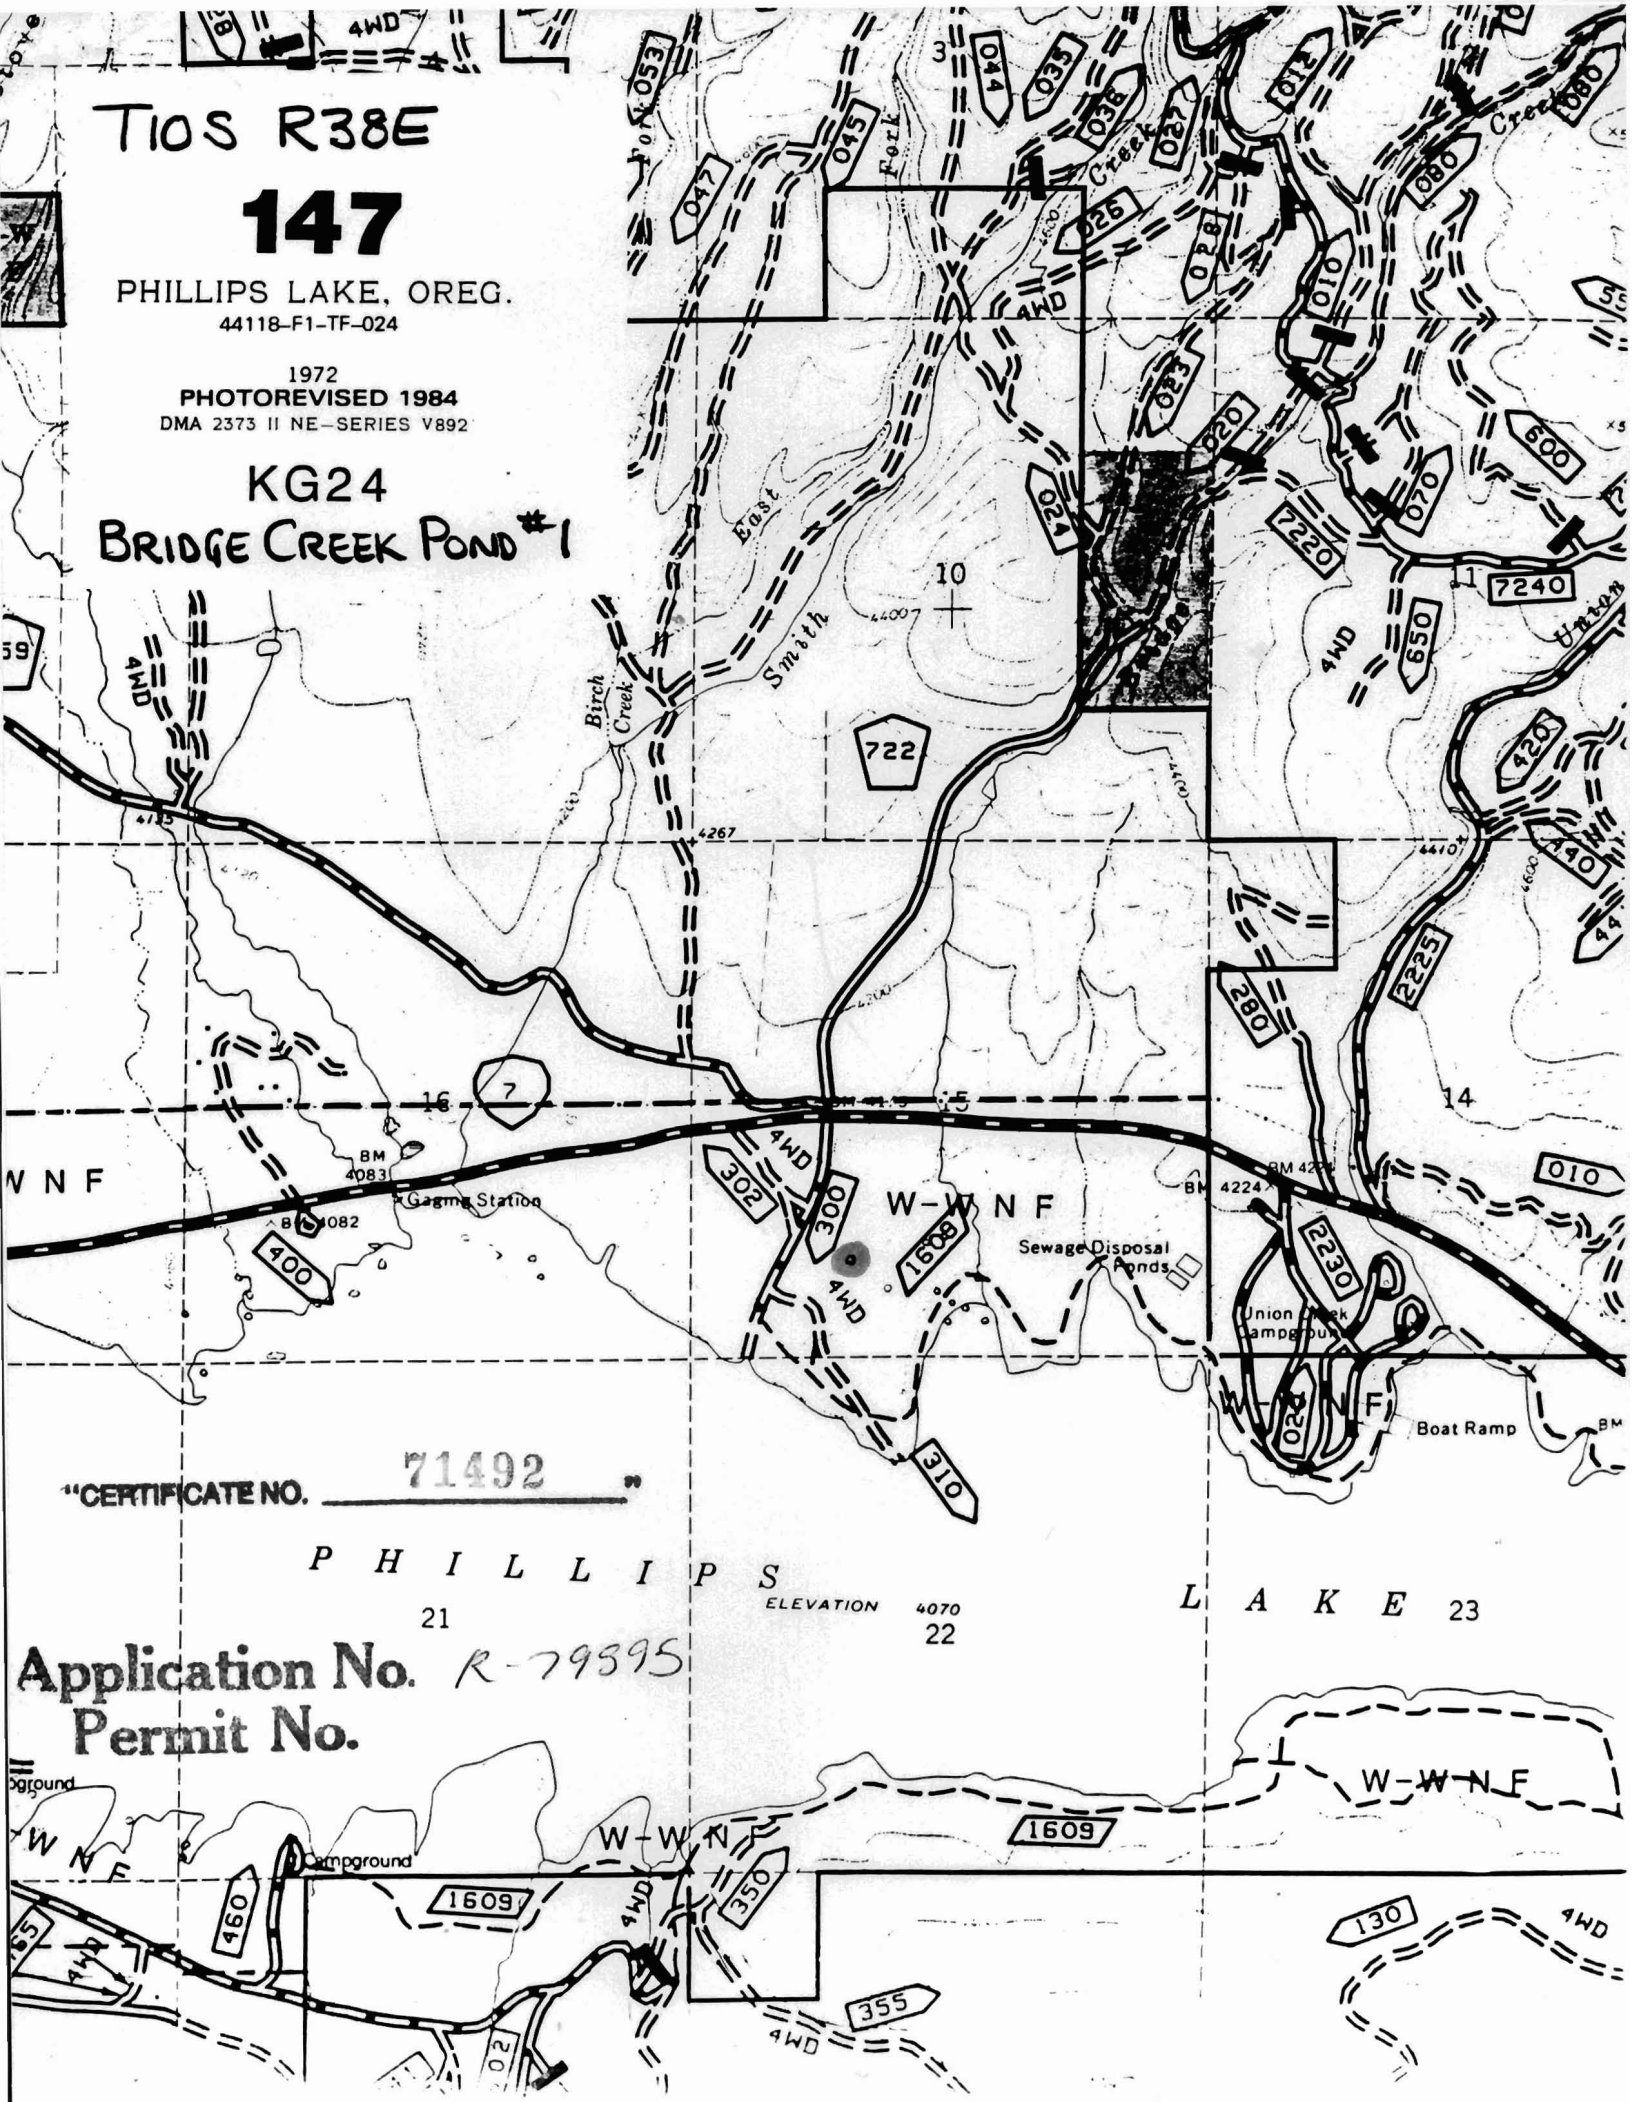

"CERTIFICATE NO. 71492"

P H I L L I P S


21

ELEVATION 4070
22

L A K E 23


Permit No.

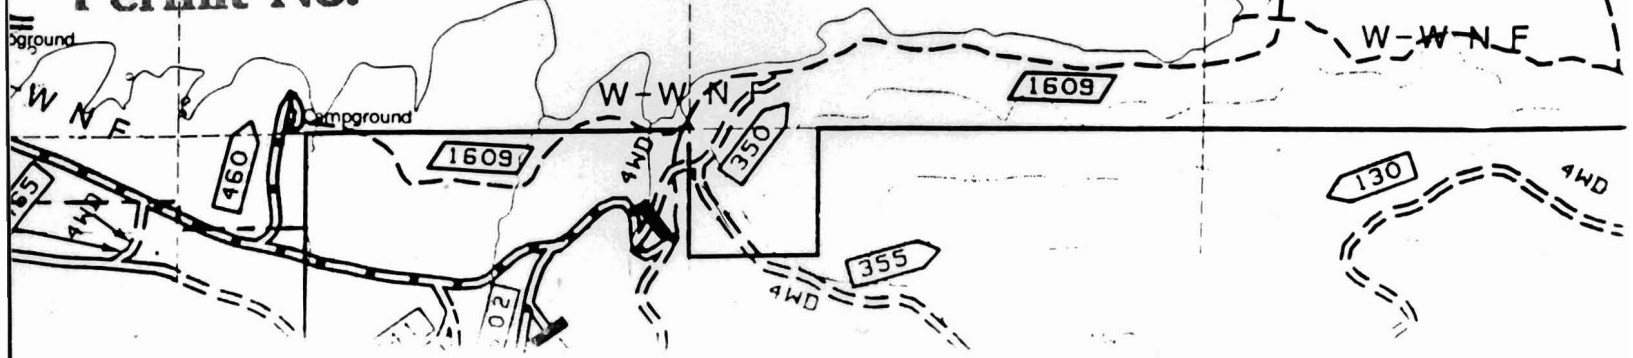


T10 S R38E

147

PHILLIPS LAKE, OREG.
44118-F1-TF-024

1972
PHOTOREVISED 1984
DMA 2373 II NE-SERIES V892

KG24
BRIDGE CREEK POND #2

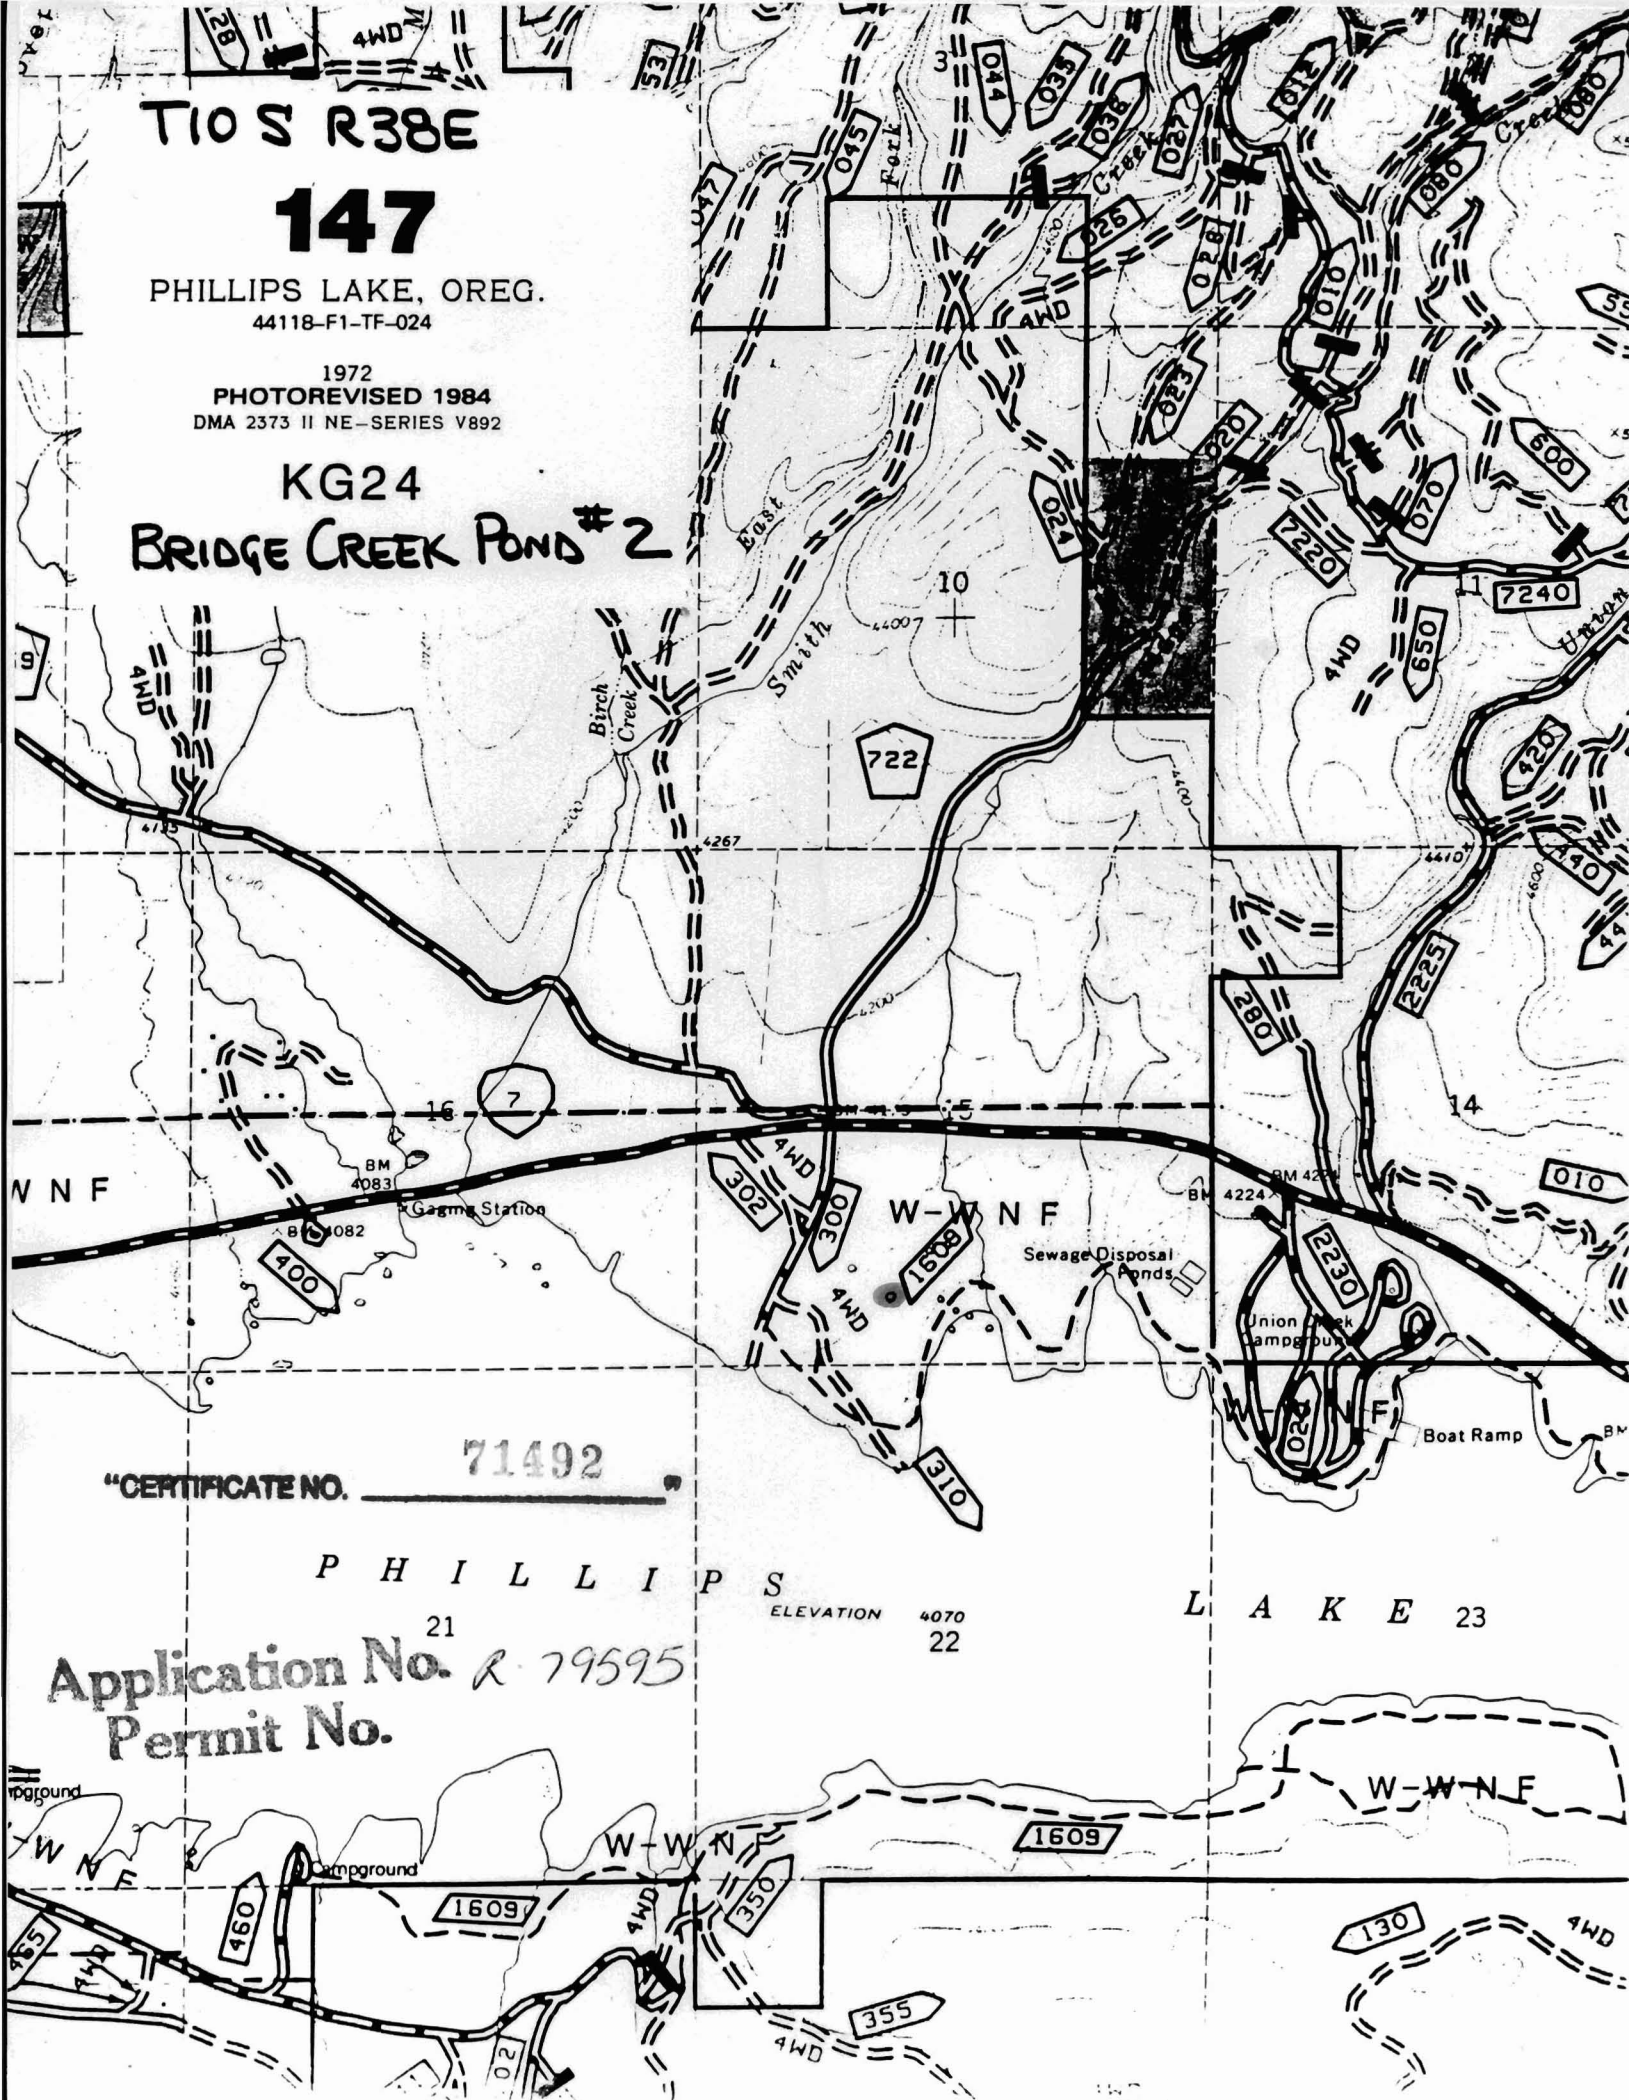

N N F

W-W-N-F

Sewage Disposal Ponds

Union Creek Campground

Boat Ramp

"CERTIFICATE NO. 71492"

P H I L L I P S

ELEVATION 4070
22

L A K E 23

Application No. R 79595
Permit No.

W-W-N-F

W-N-F

W-W-N-F

1609

130

355

460

1609

350

4WD

4WD

20

T10 S R38E


147

PHILLIPS LAKE, OREG.
44118-F1-TF-024

1972
PHOTOREVISED 1984
DMA 2373 II NE-SERIES V892

KG24

BRIDGE CREEK POND #3

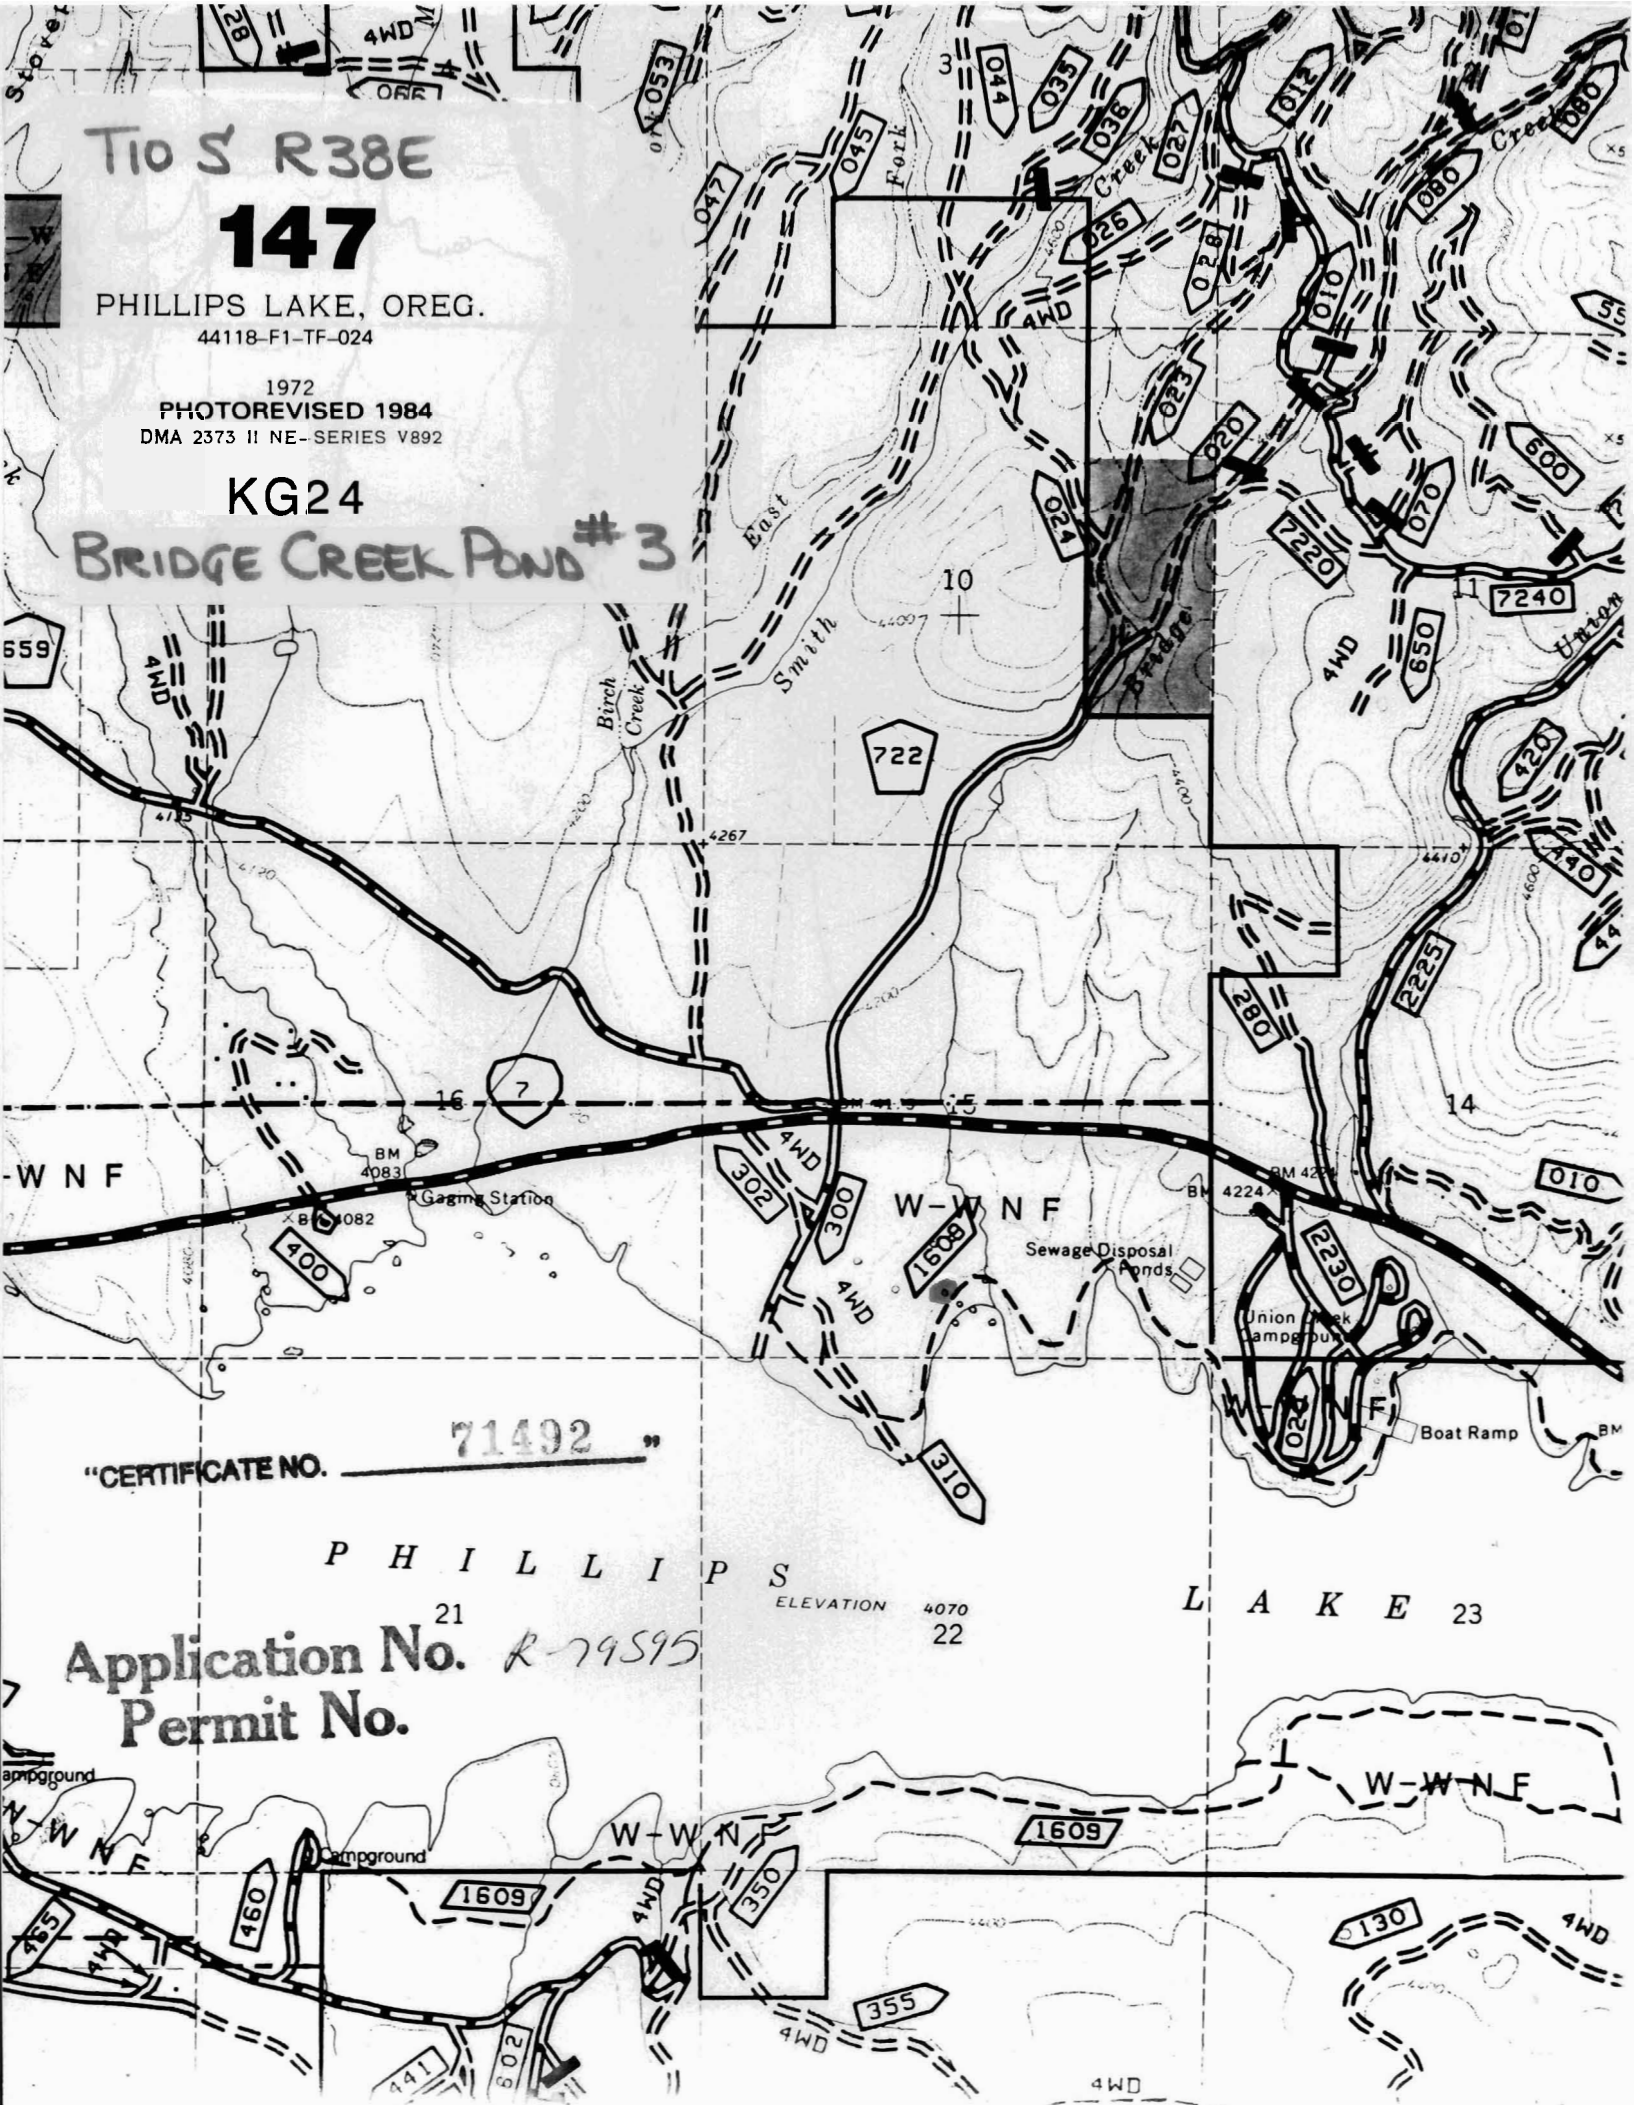

"CERTIFICATE NO. 71492"

P H I L L I P S


21

ELEVATION 4070
22

L A K E 23

Application No. *R-79595*

Permit No.

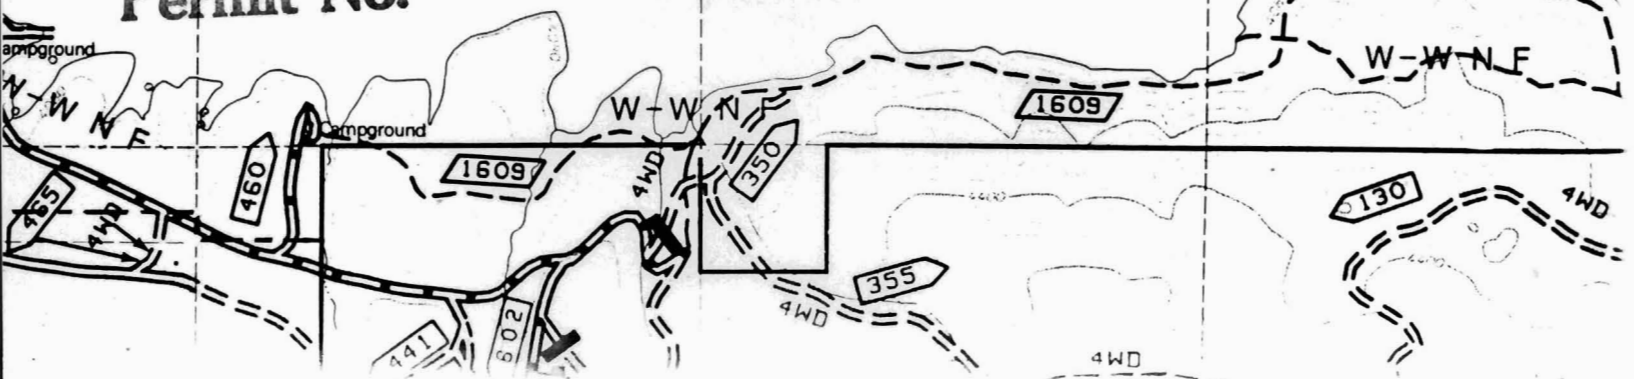

T10S R38E


147

PHILLIPS LAKE, OREG.
44118-F1-TF-024

1972
PHOTOREVISED 1984
DMA 2373 II NE-SERIES V892

KG24

BRIDGE CREEK POND #4

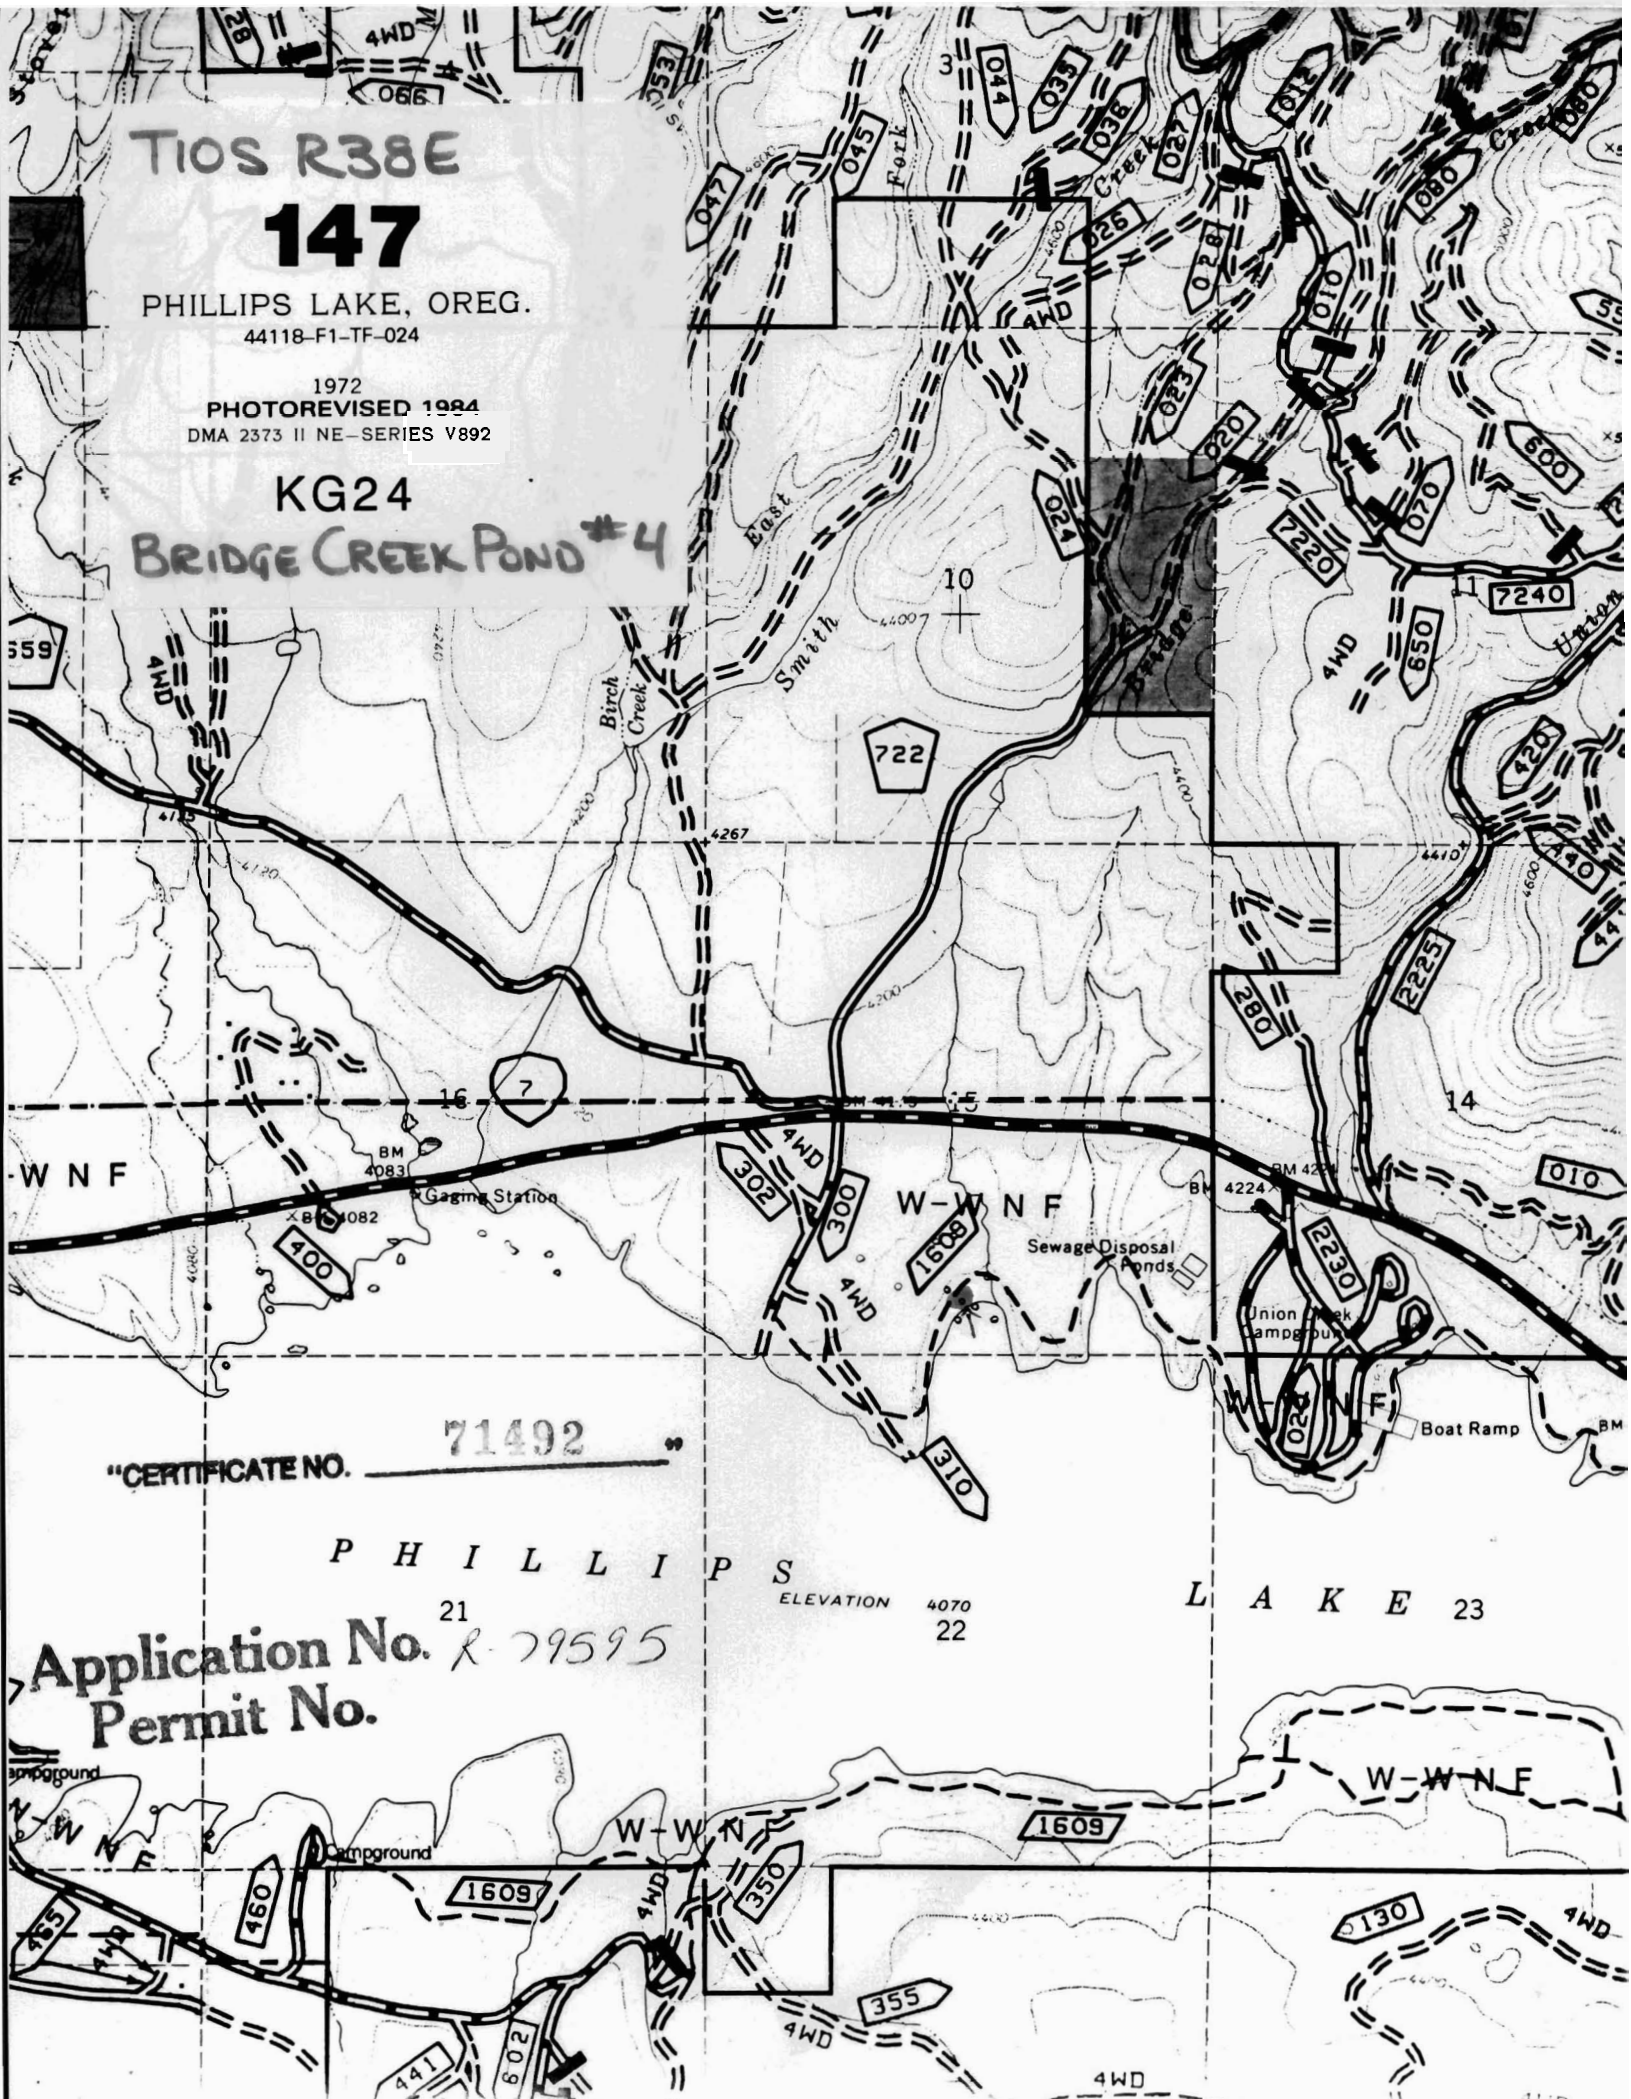

"CERTIFICATE NO. 71492"


P H I L L I P S

21

ELEVATION 4070
22

L A K E 23

Application No. R-79595
Permit No.

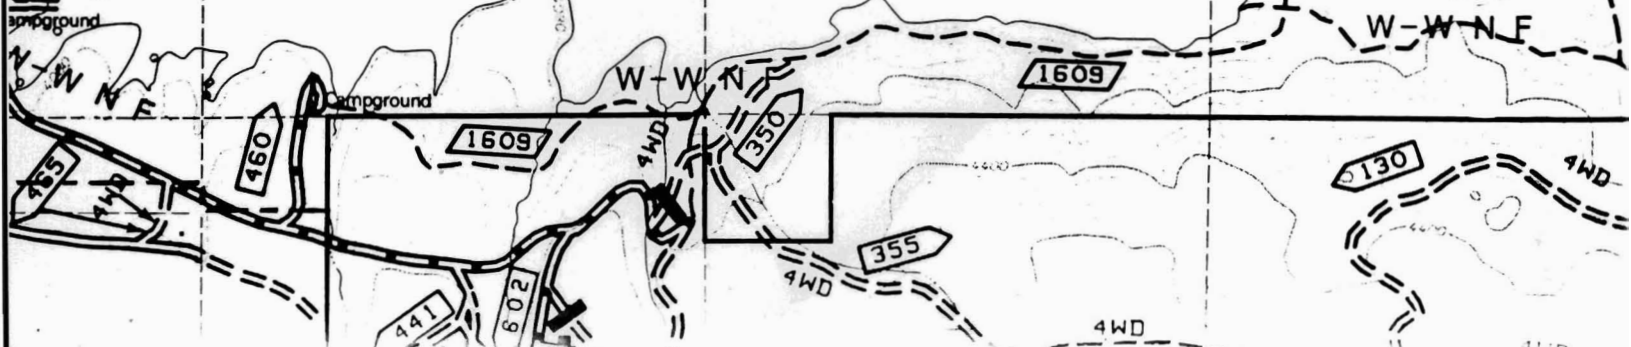

T10S R38E

147

PHILLIPS LAKE, OREG.

44118-F1-TF-024


1972

PHOTOREVISED 1984

DMA 2373 II NE-SERIES V892

KG24

BRIDGE CREEK POND # 5

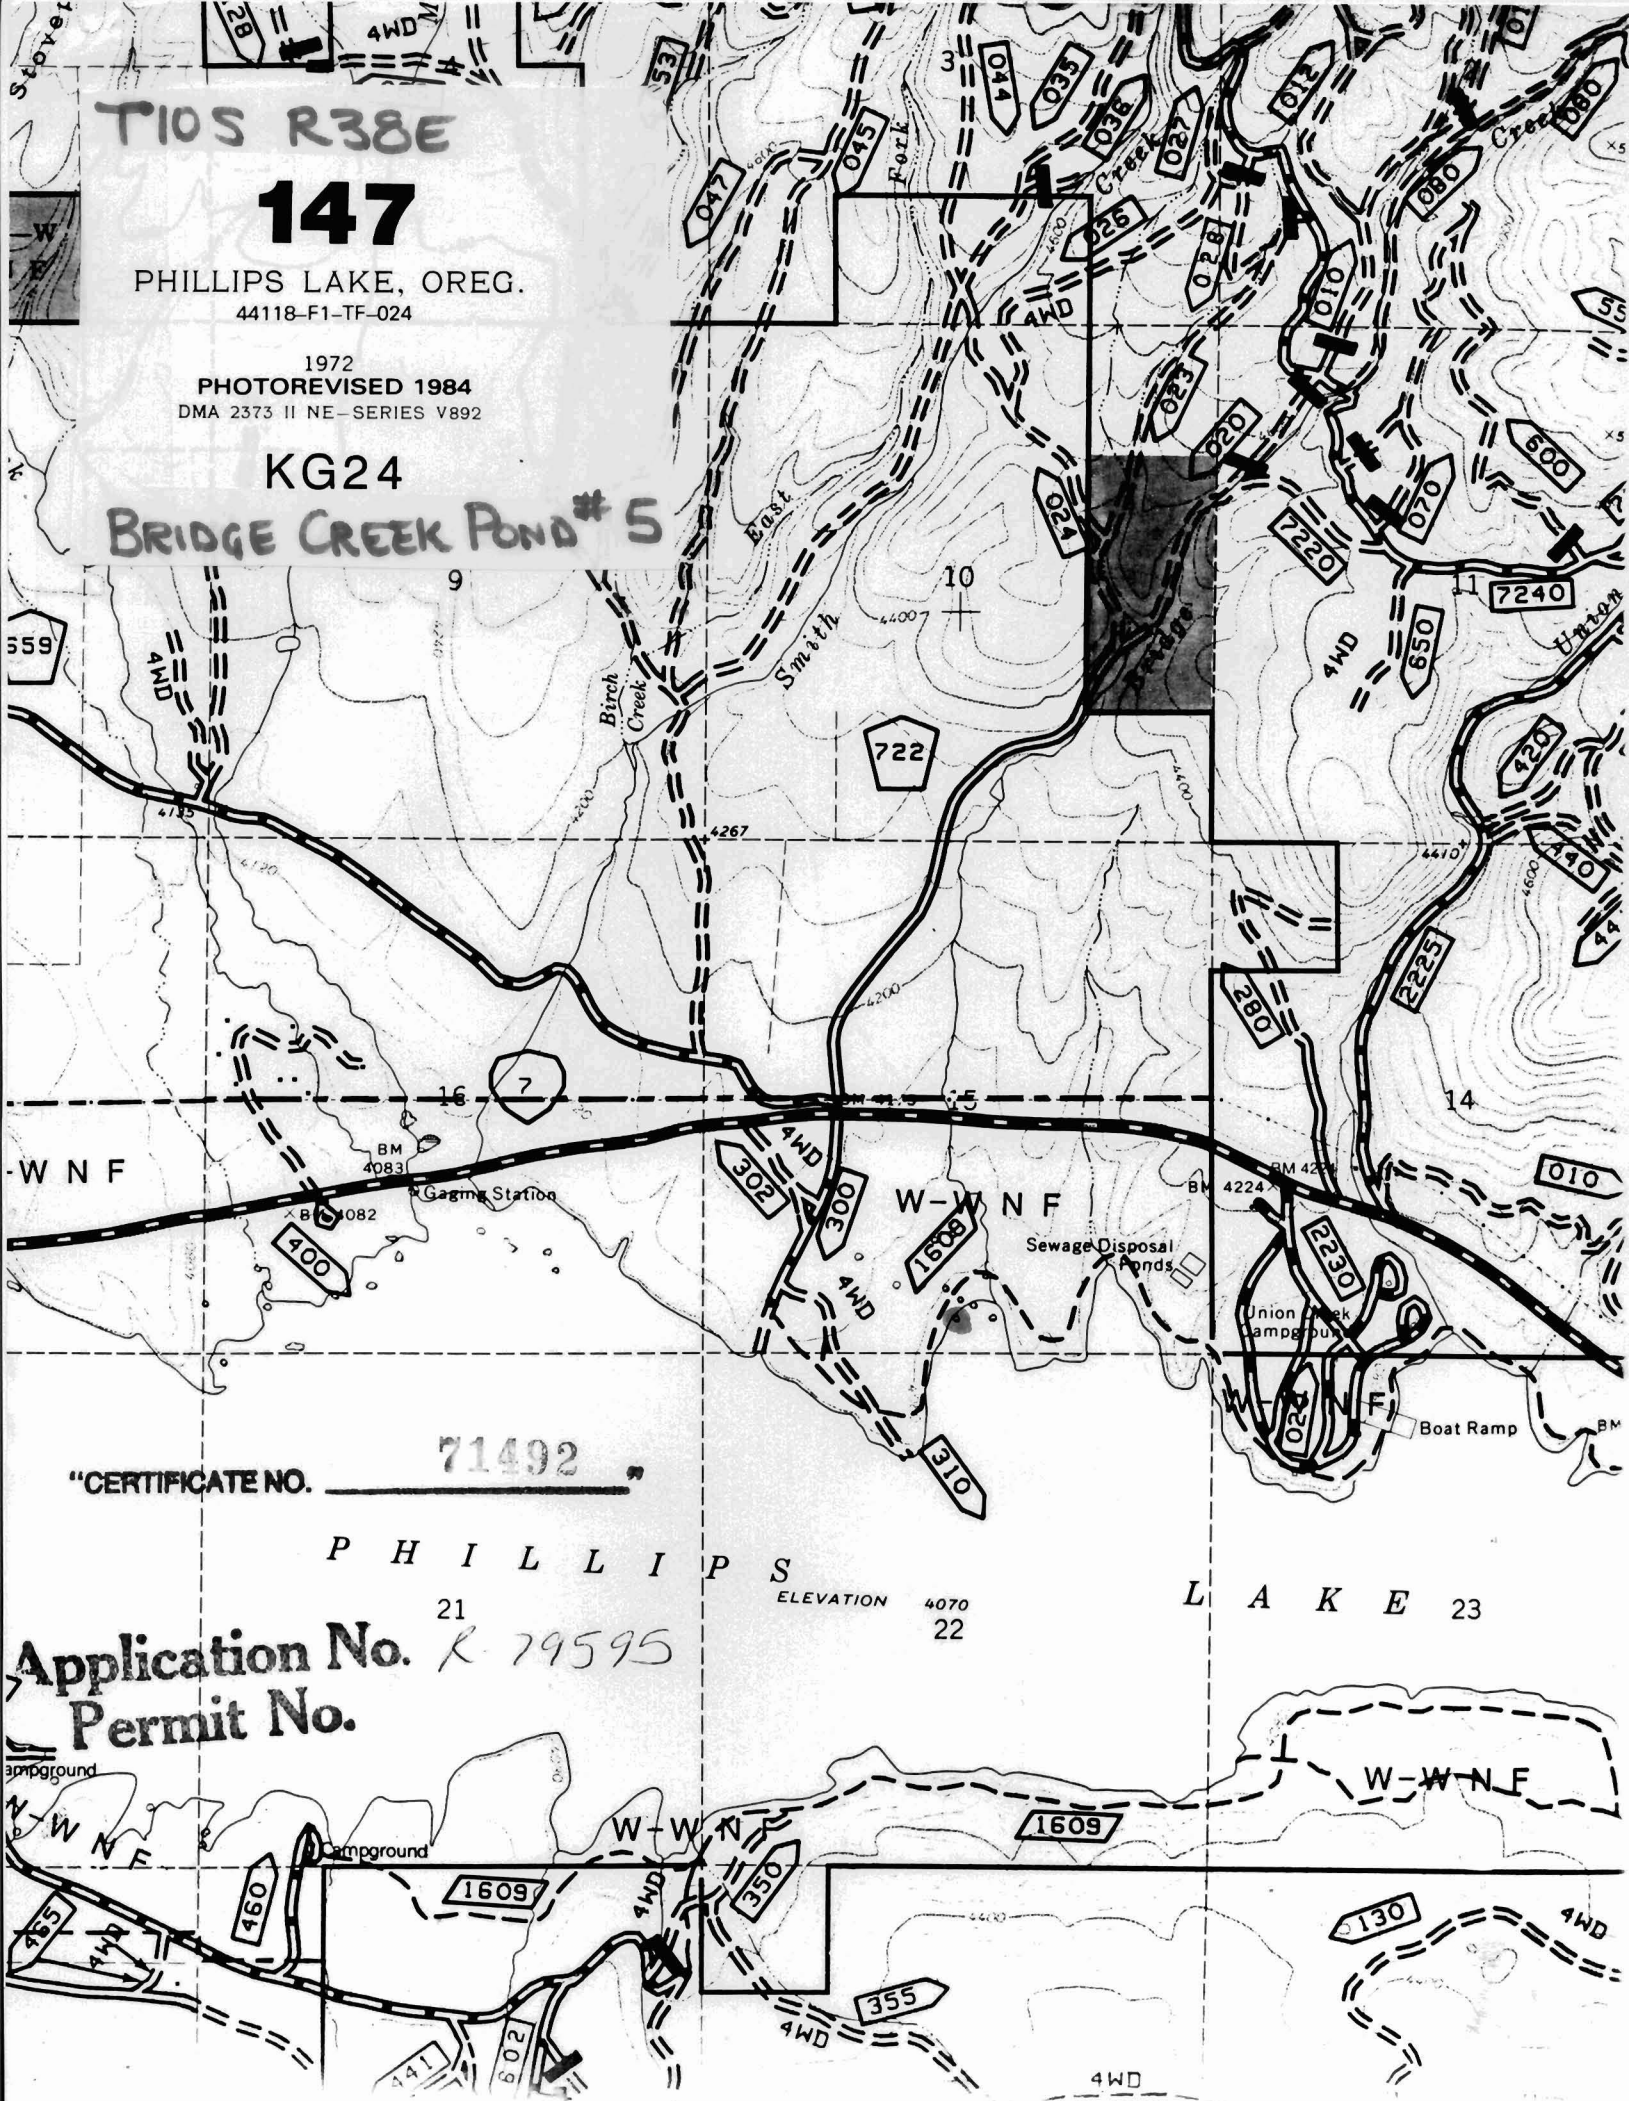

"CERTIFICATE NO. 71492"

P H I L L I P S


21

ELEVATION 4070
22

L A K E 23

Application No. R 79595

Permit No.

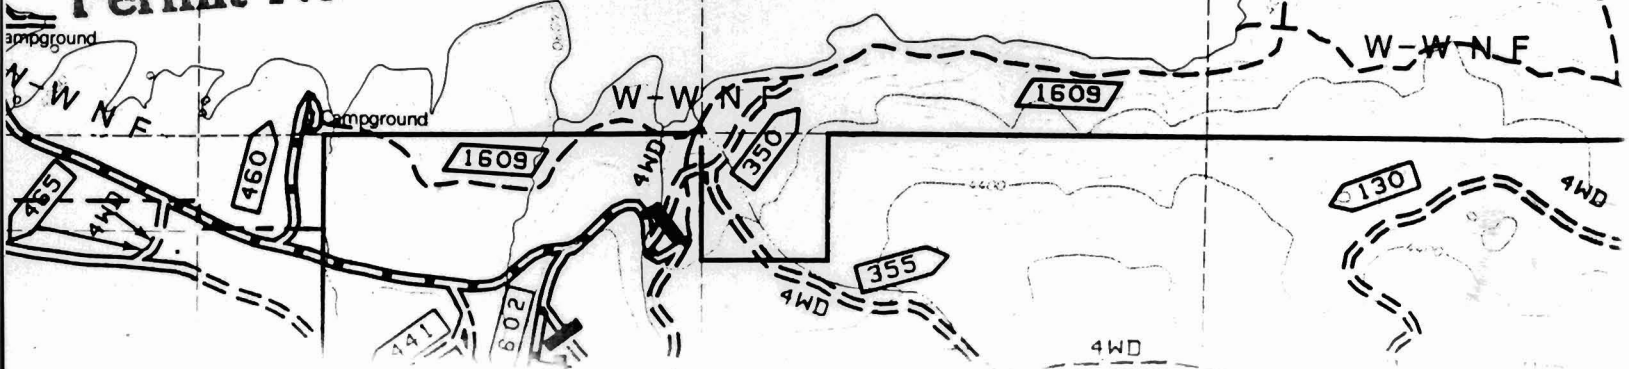

TIOS R38E


147

PHILLIPS LAKE, OREG.
44118-F1-TF-024

1972
PHOTOREVISED 1984
DMA 2373 II NE-SERIES V892

KG24


BRIDGE CREEK FOND #6

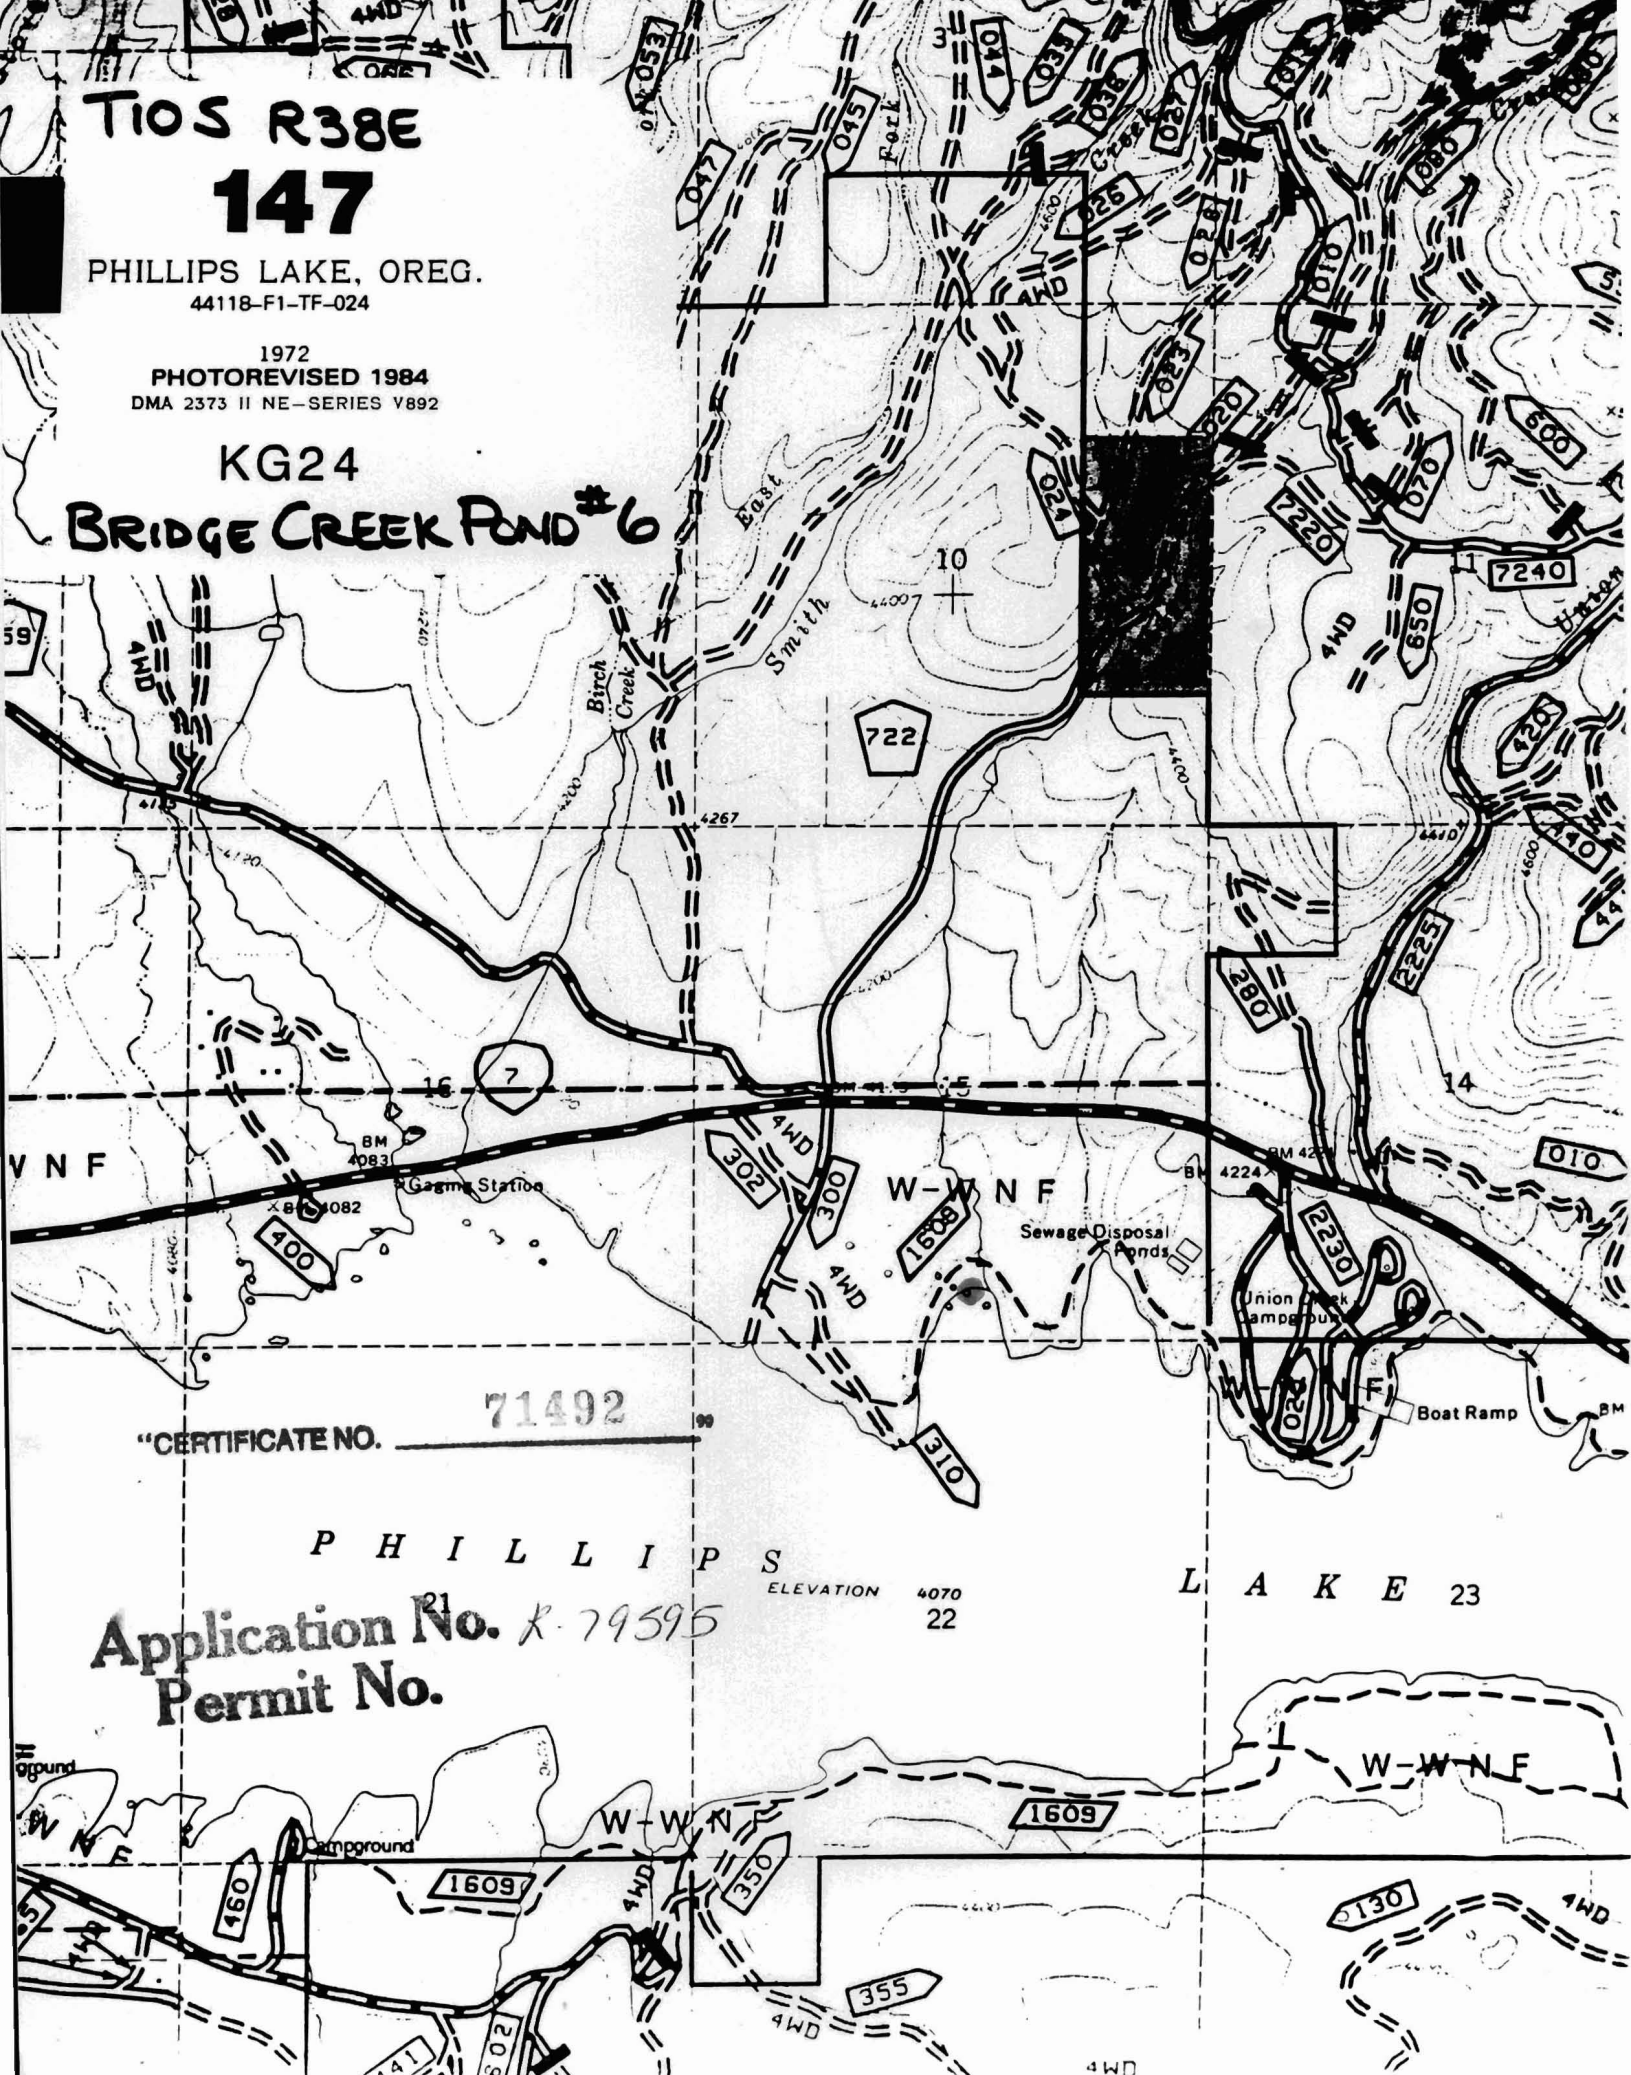

"CERTIFICATE NO. 71492"

P H I L L I P S E L E V A T I O N 4 0 7 0
L A K E 2 2 L A K E 2 3

Application No. *R-79595*
Permit No.

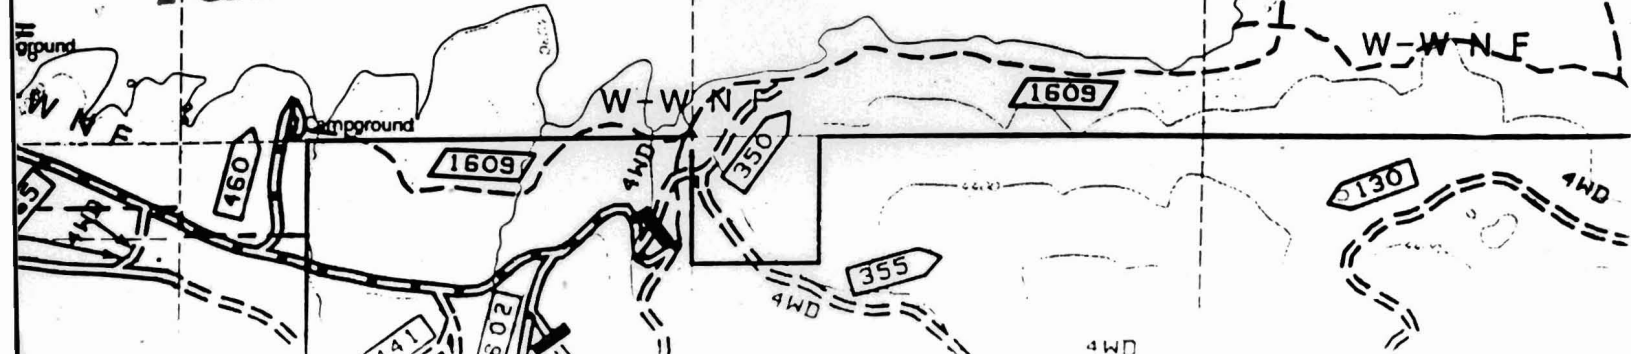

T10S R38E

147


PHILLIPS LAKE, OREG.

44118-F1-TF-024

1972
PHOTOREVISED 1984
DMA 2373 II NE-SERIES V892

KG24

BRIDGE CREEK POND # 7

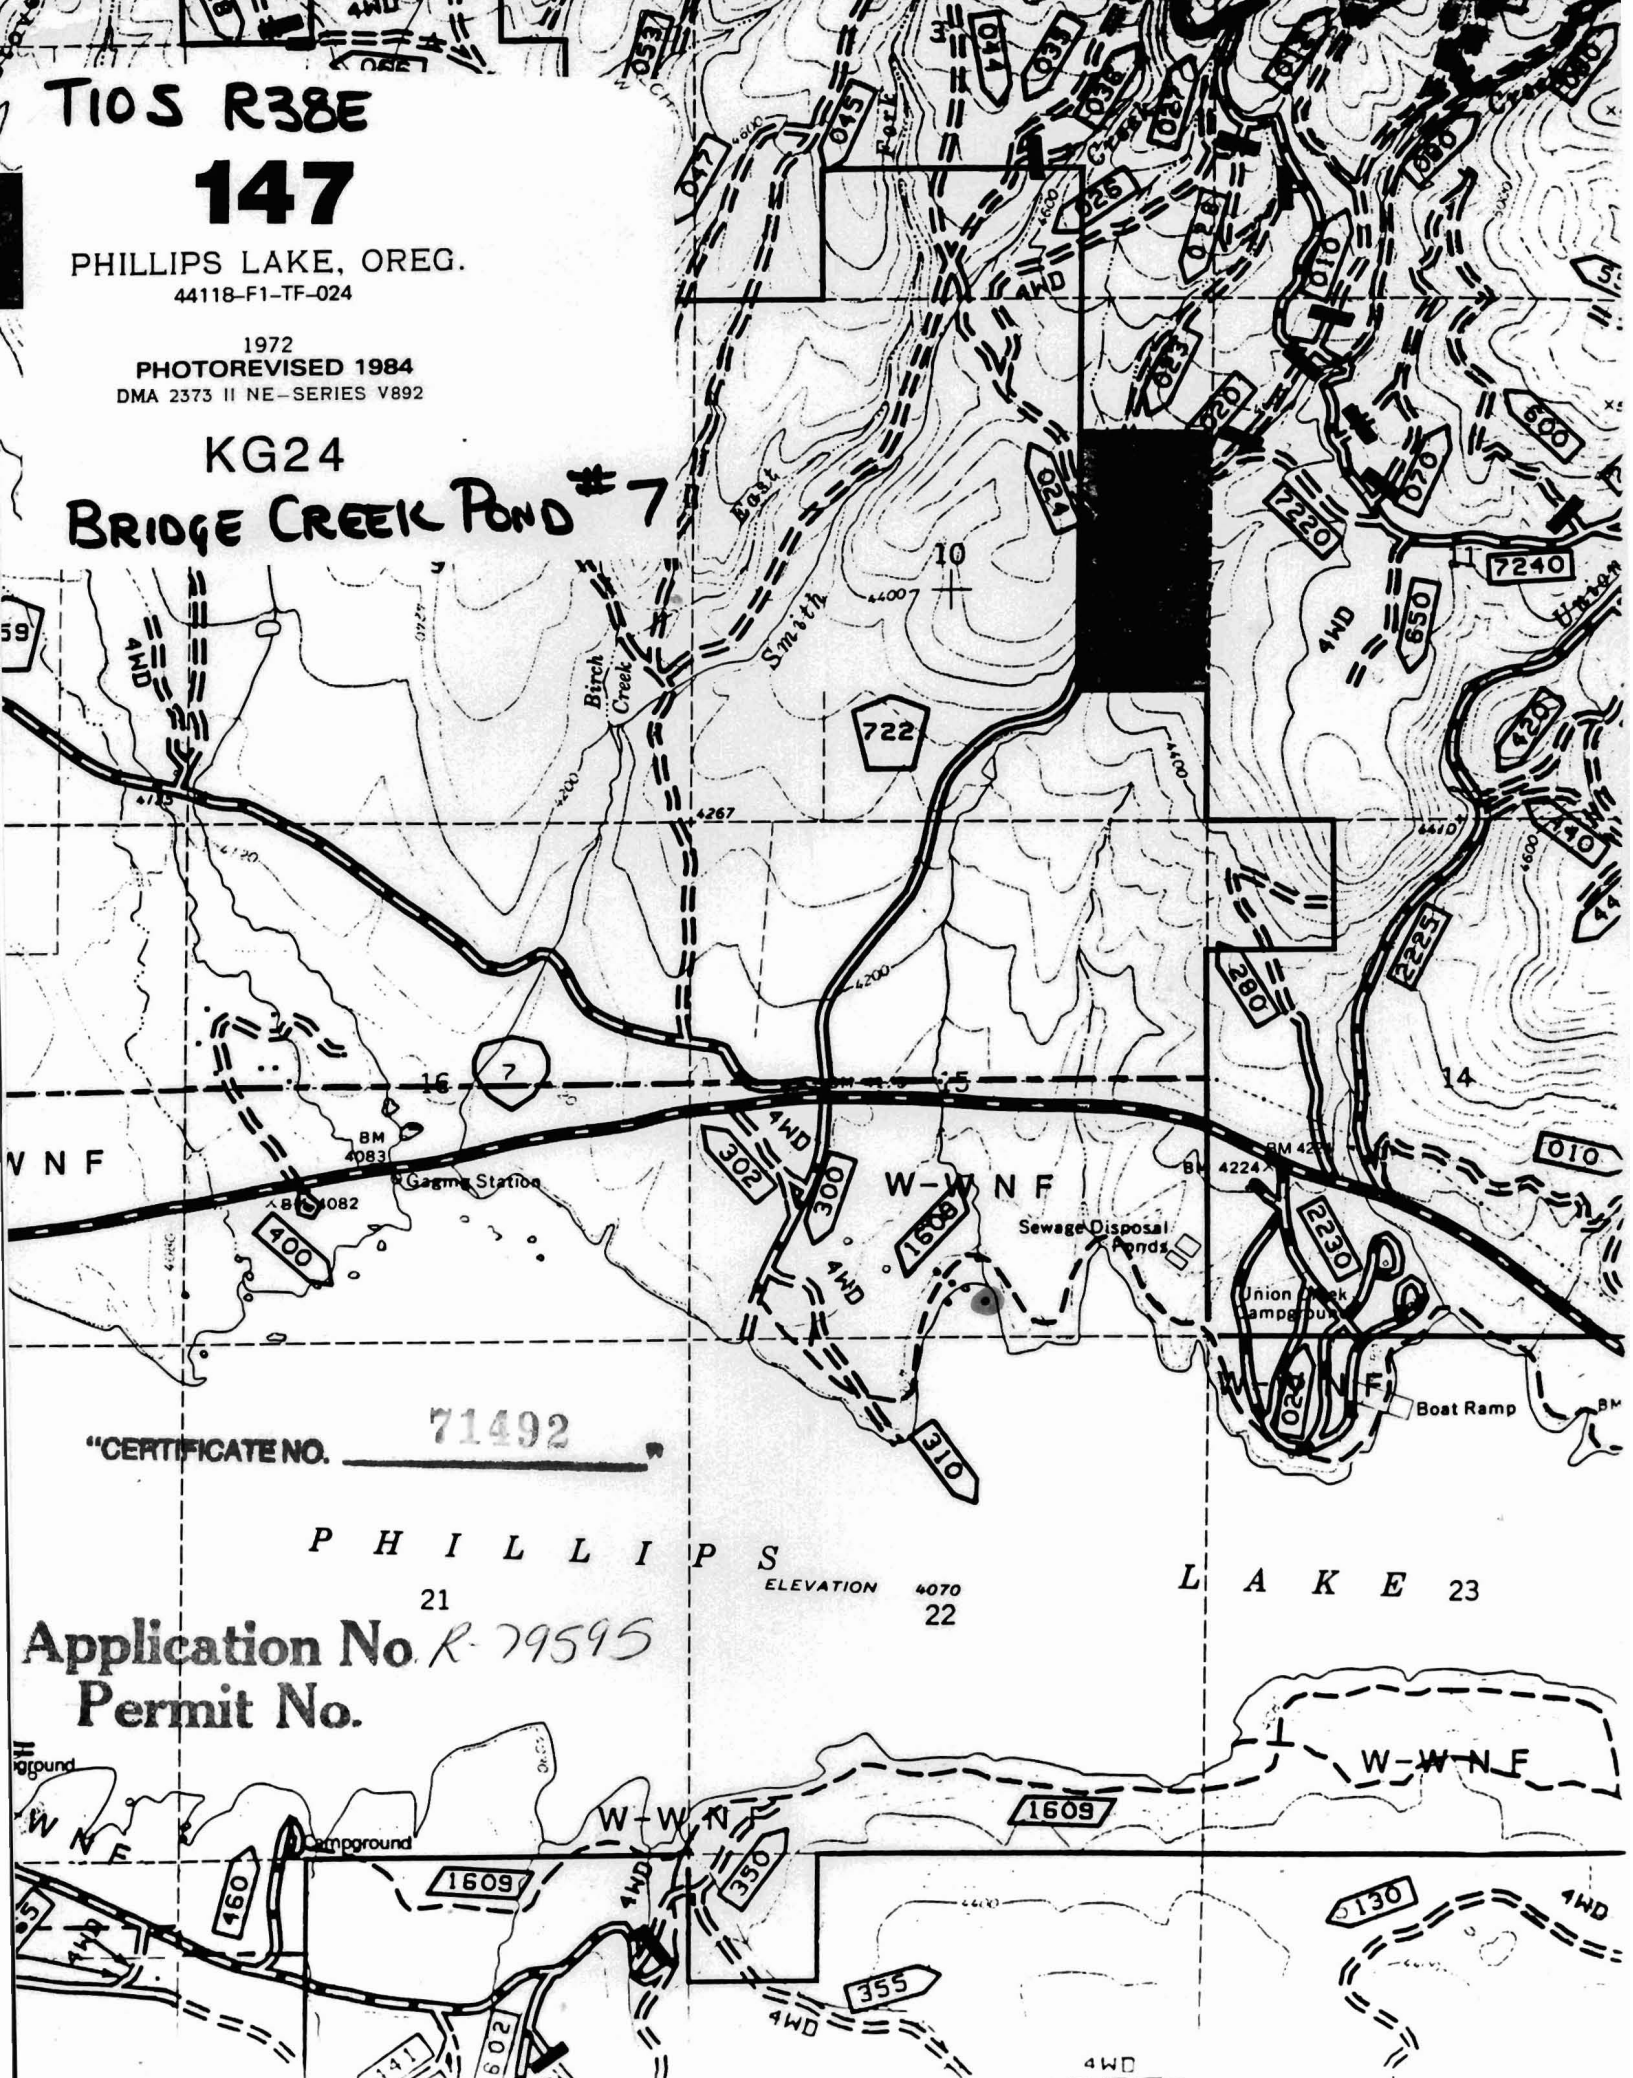

V N F

BM 4083
BM 4082

W-VNF

Sewage Disposal Ponds

Union Creek Campground

Boat Ramp

"CERTIFICATE NO. 71492"

P H I L L I P S

21

ELEVATION 4070
22

L A K E 23

Application No. R-79595

Permit No.

Highground

Campground

W-WNF

W-NF

W-WNF

1609

130

1ND

355


4WD

T10S R38E 147

PHILLIPS LAKE, OREG.
44118-F1-TF-024


1972
PHOTOREVISED 1984
DMA 2373 II NE-SERIES V892

KG24 BRIDGE CREEK POND # 8

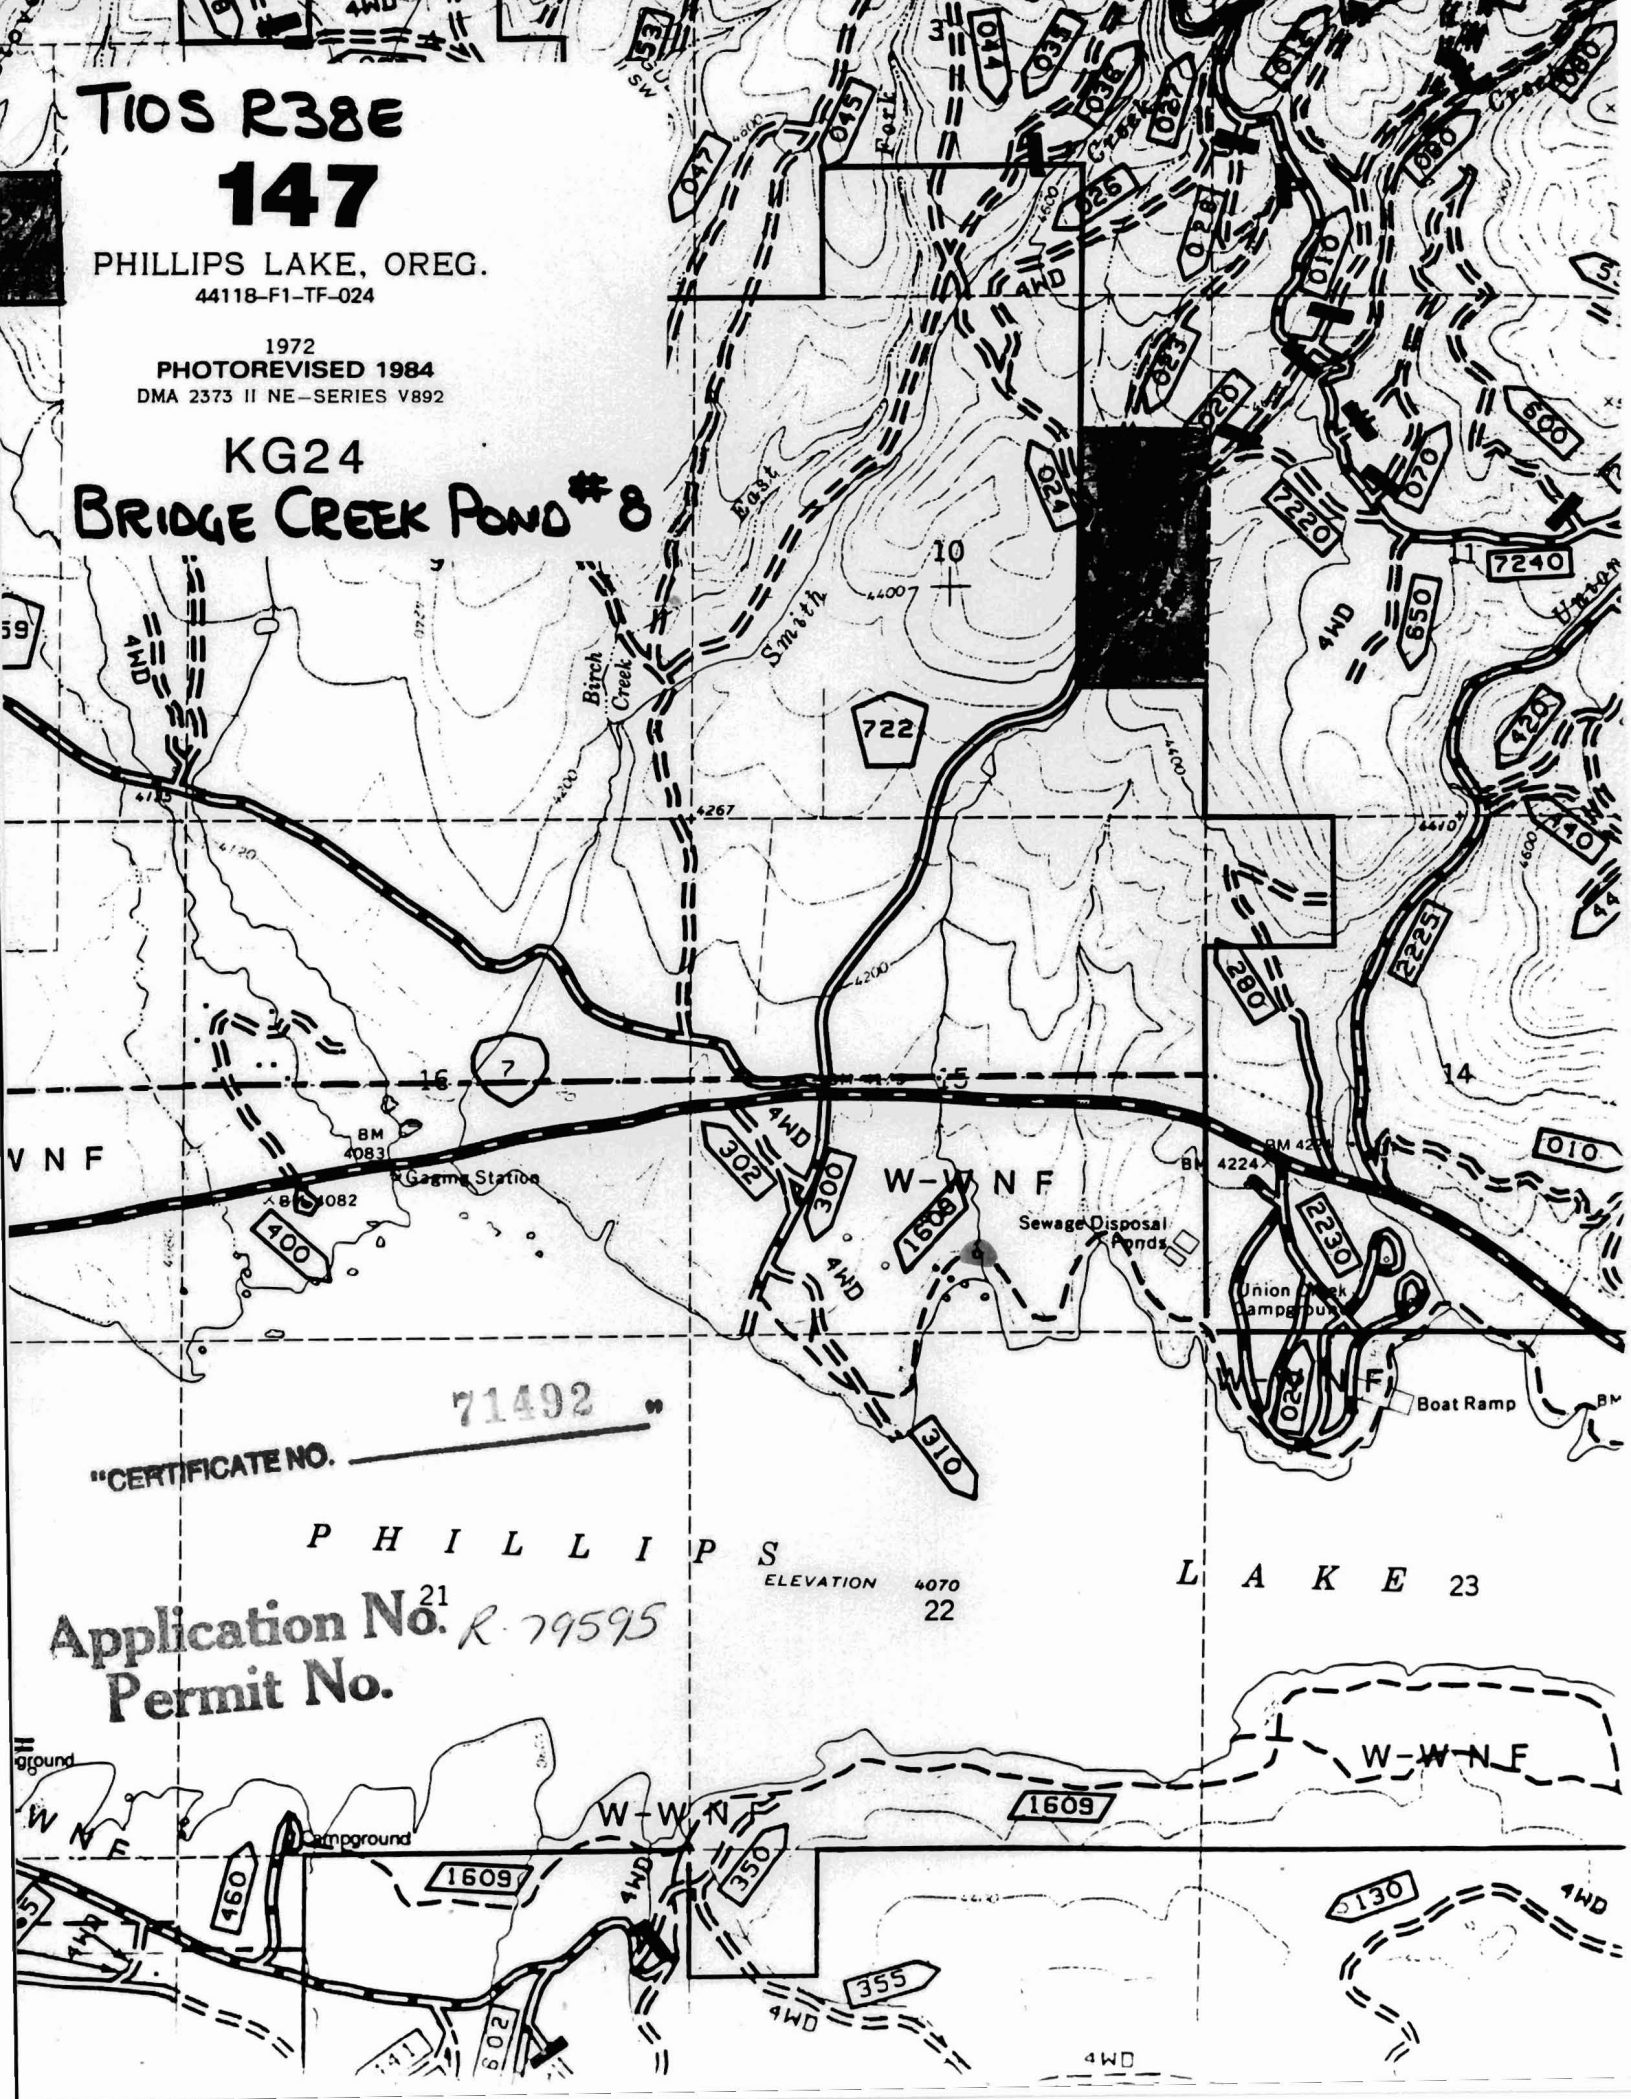

"CERTIFICATE NO. 71492"

PHILLIPS LAKE 23
Application No. ²¹ R-79595
Permit No. ELEVATION 4070 22

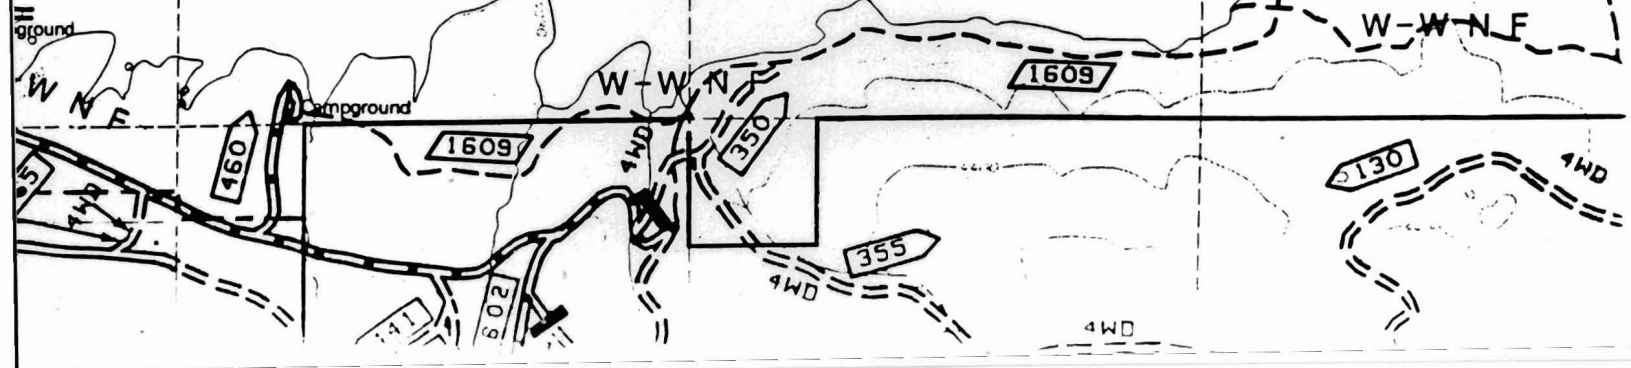


T10S R38E 147

PHILLIPS LAKE, OREG.
44118-F1-TF-024

1972
PHOTOREVISED 1984
DMA 2373 II NE-SERIES V892

KG24 BRIDGE CREEK POND # 9

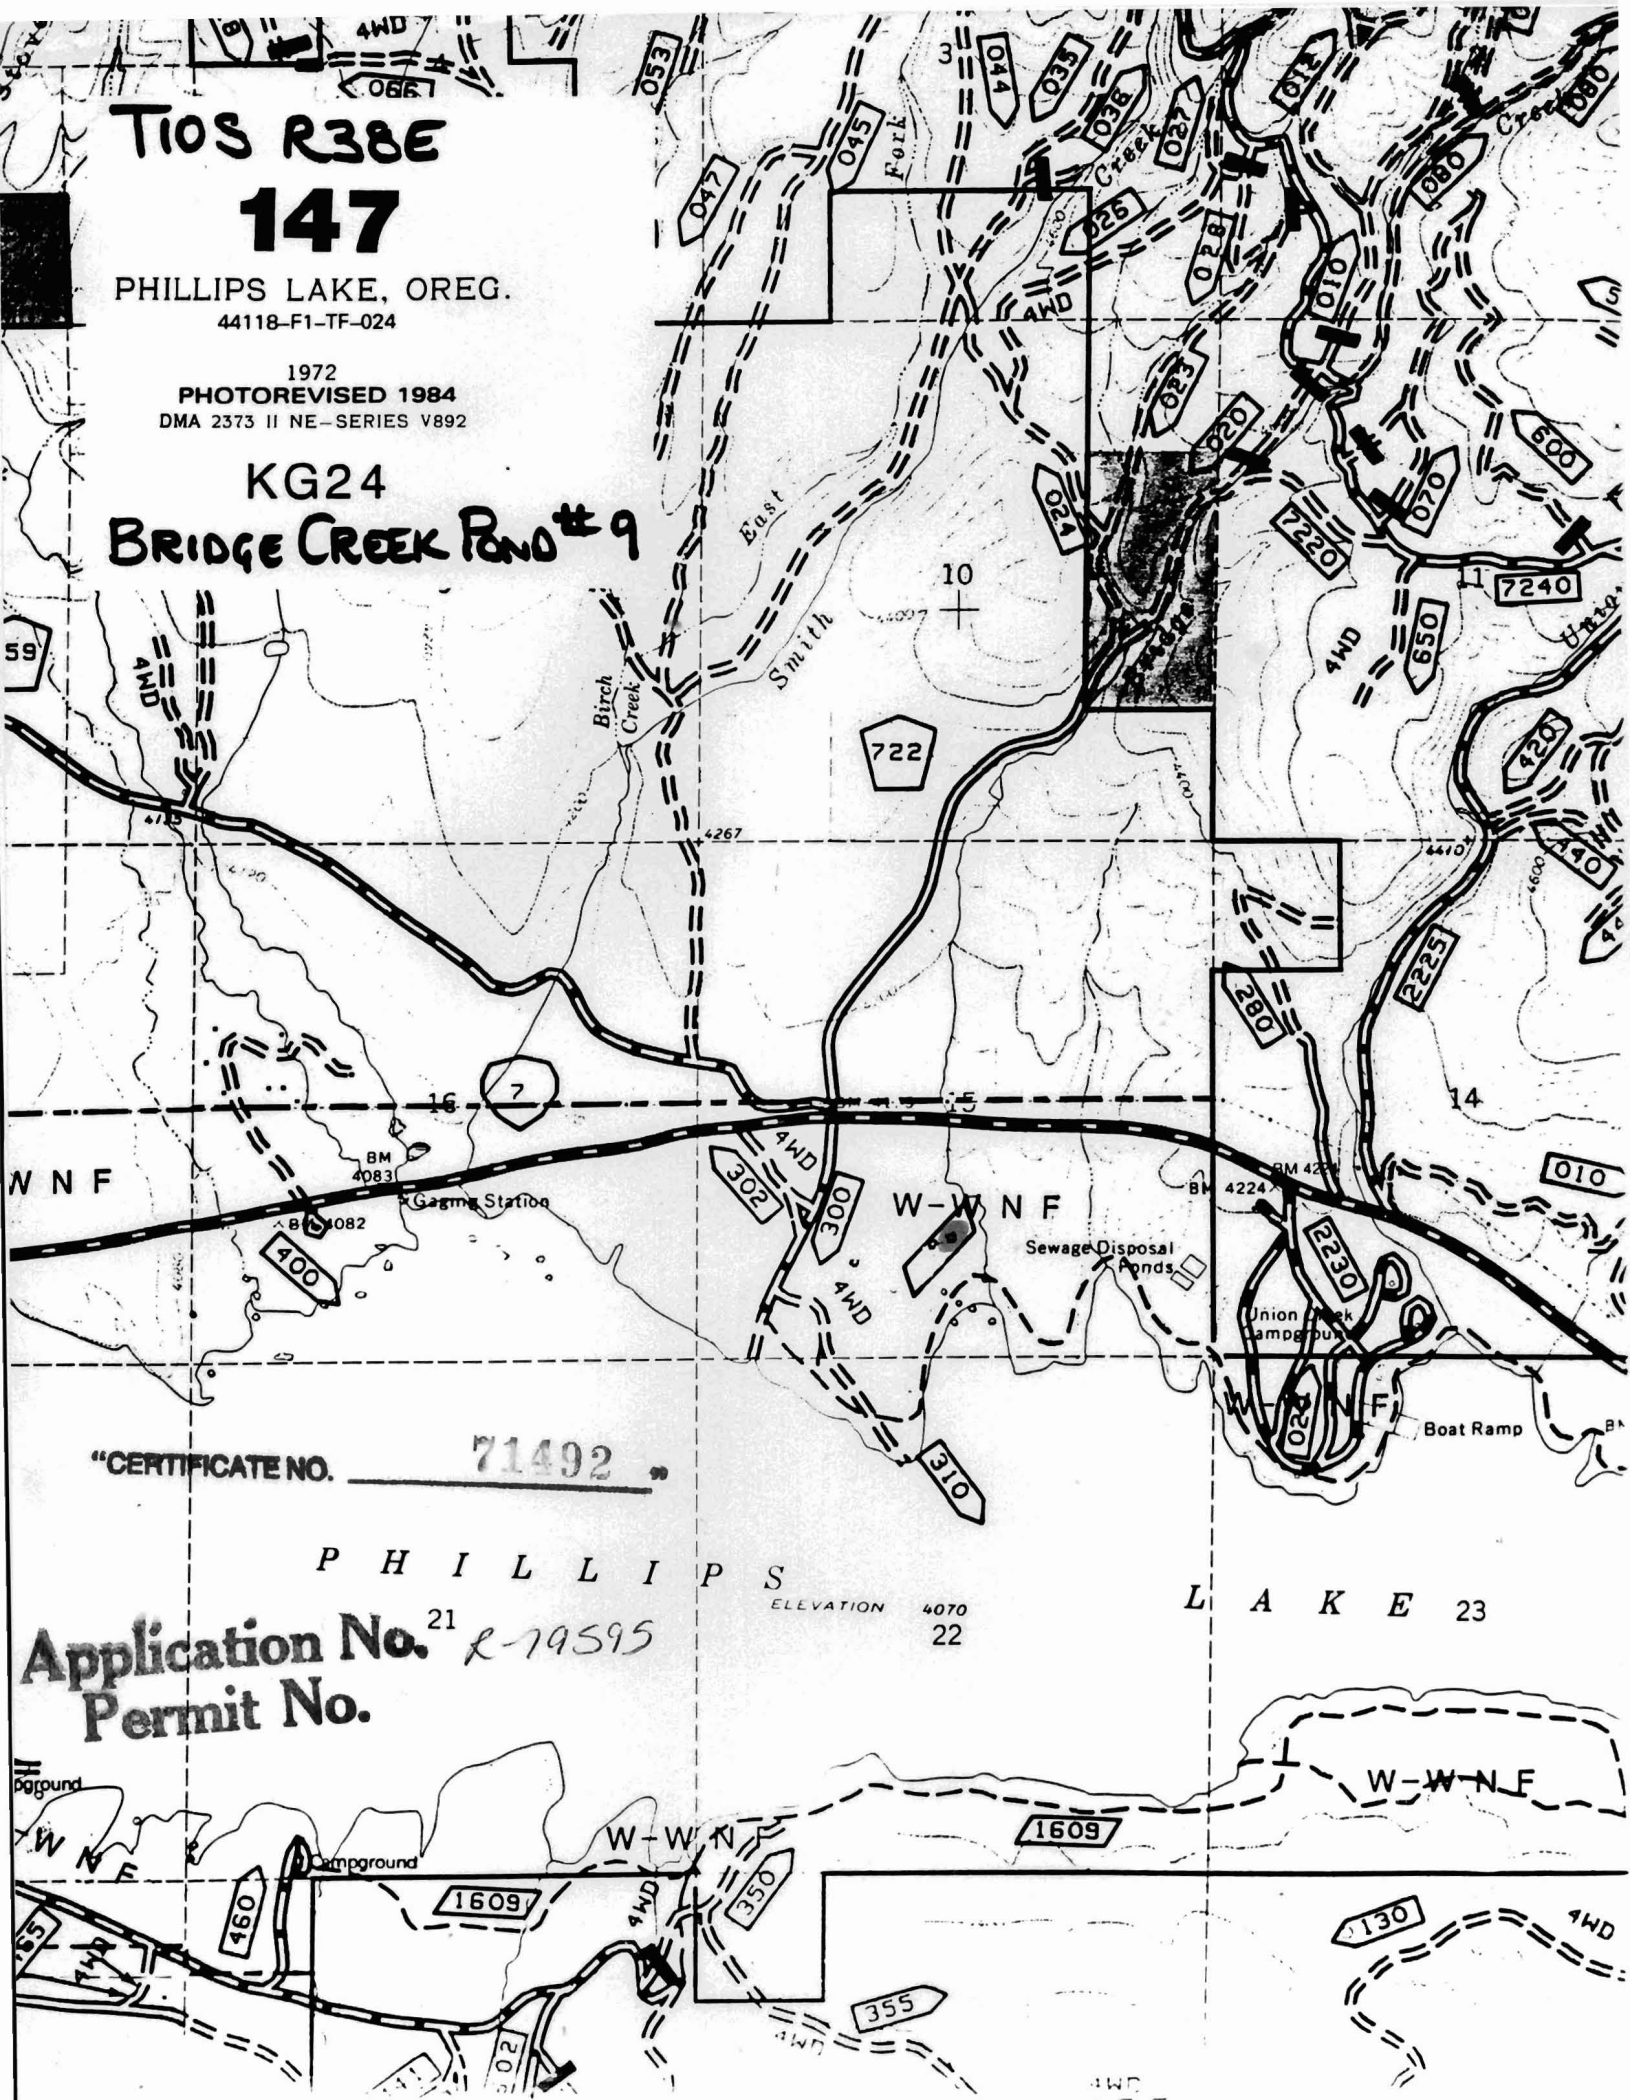


"CERTIFICATE NO. 71492"

P H I L L I P S

ELEVATION 4070
22

L A K E 23

Application No. ²¹ R-79595
Permit No.

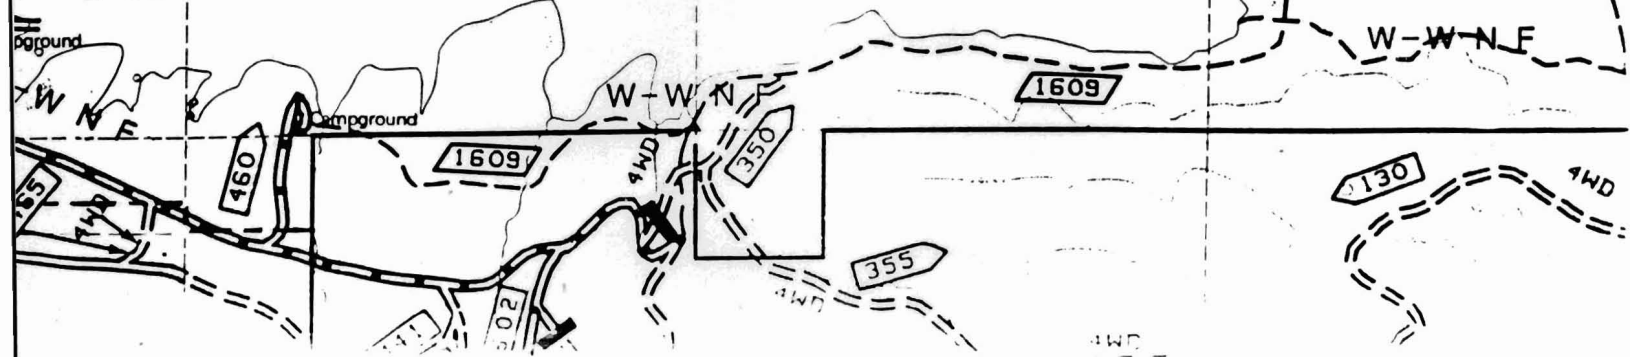


T10S R38E

147

PHILLIPS LAKE, OREG.
44118-F1-TF-024

1972
PHOTOREVISED 1984
DMA 2373 II NE-SERIES V892

KG24
BRIDGE CREEK POND #10

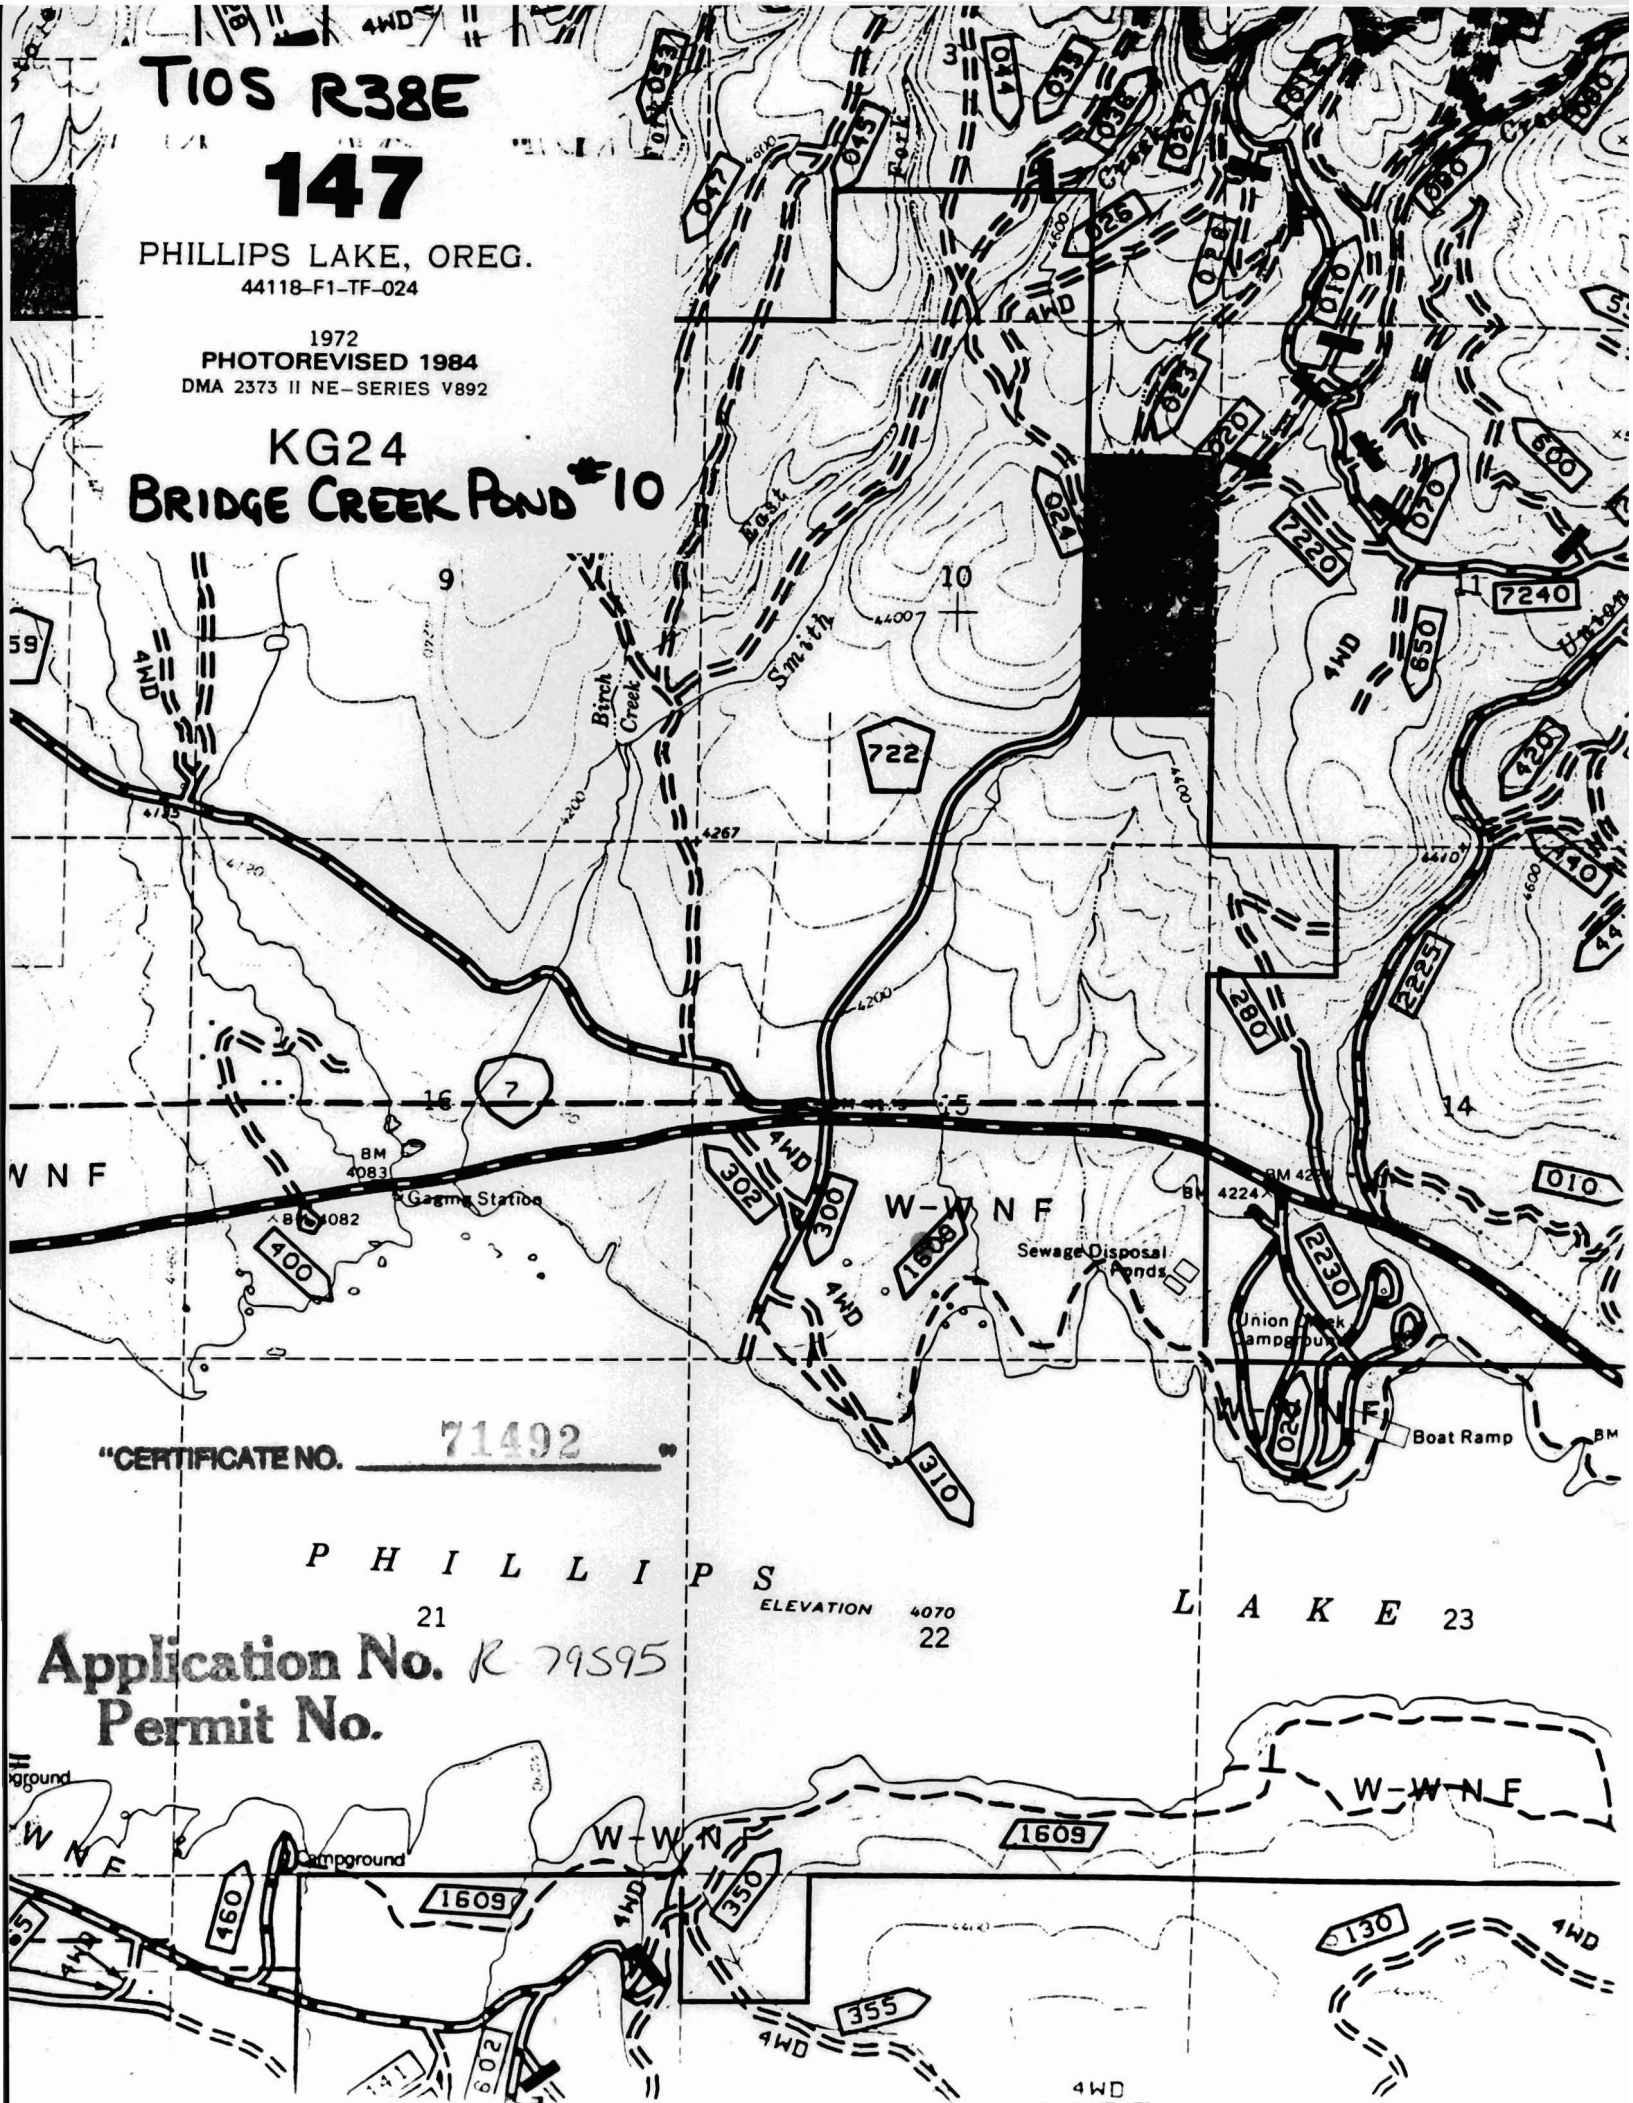

"CERTIFICATE NO. 71492"

P H I L L I P S

21

ELEVATION 4070
22

L A K E 23

Application No. R-79595
Permit No.

