


T10S R38E 147

PHILLIPS LAKE, OREG.
44118-F1-TF-024

1972
PHOTOREVISED 1984
DMA 2373 II NE-SERIES V892

KG24 DEER CREEK POND #1

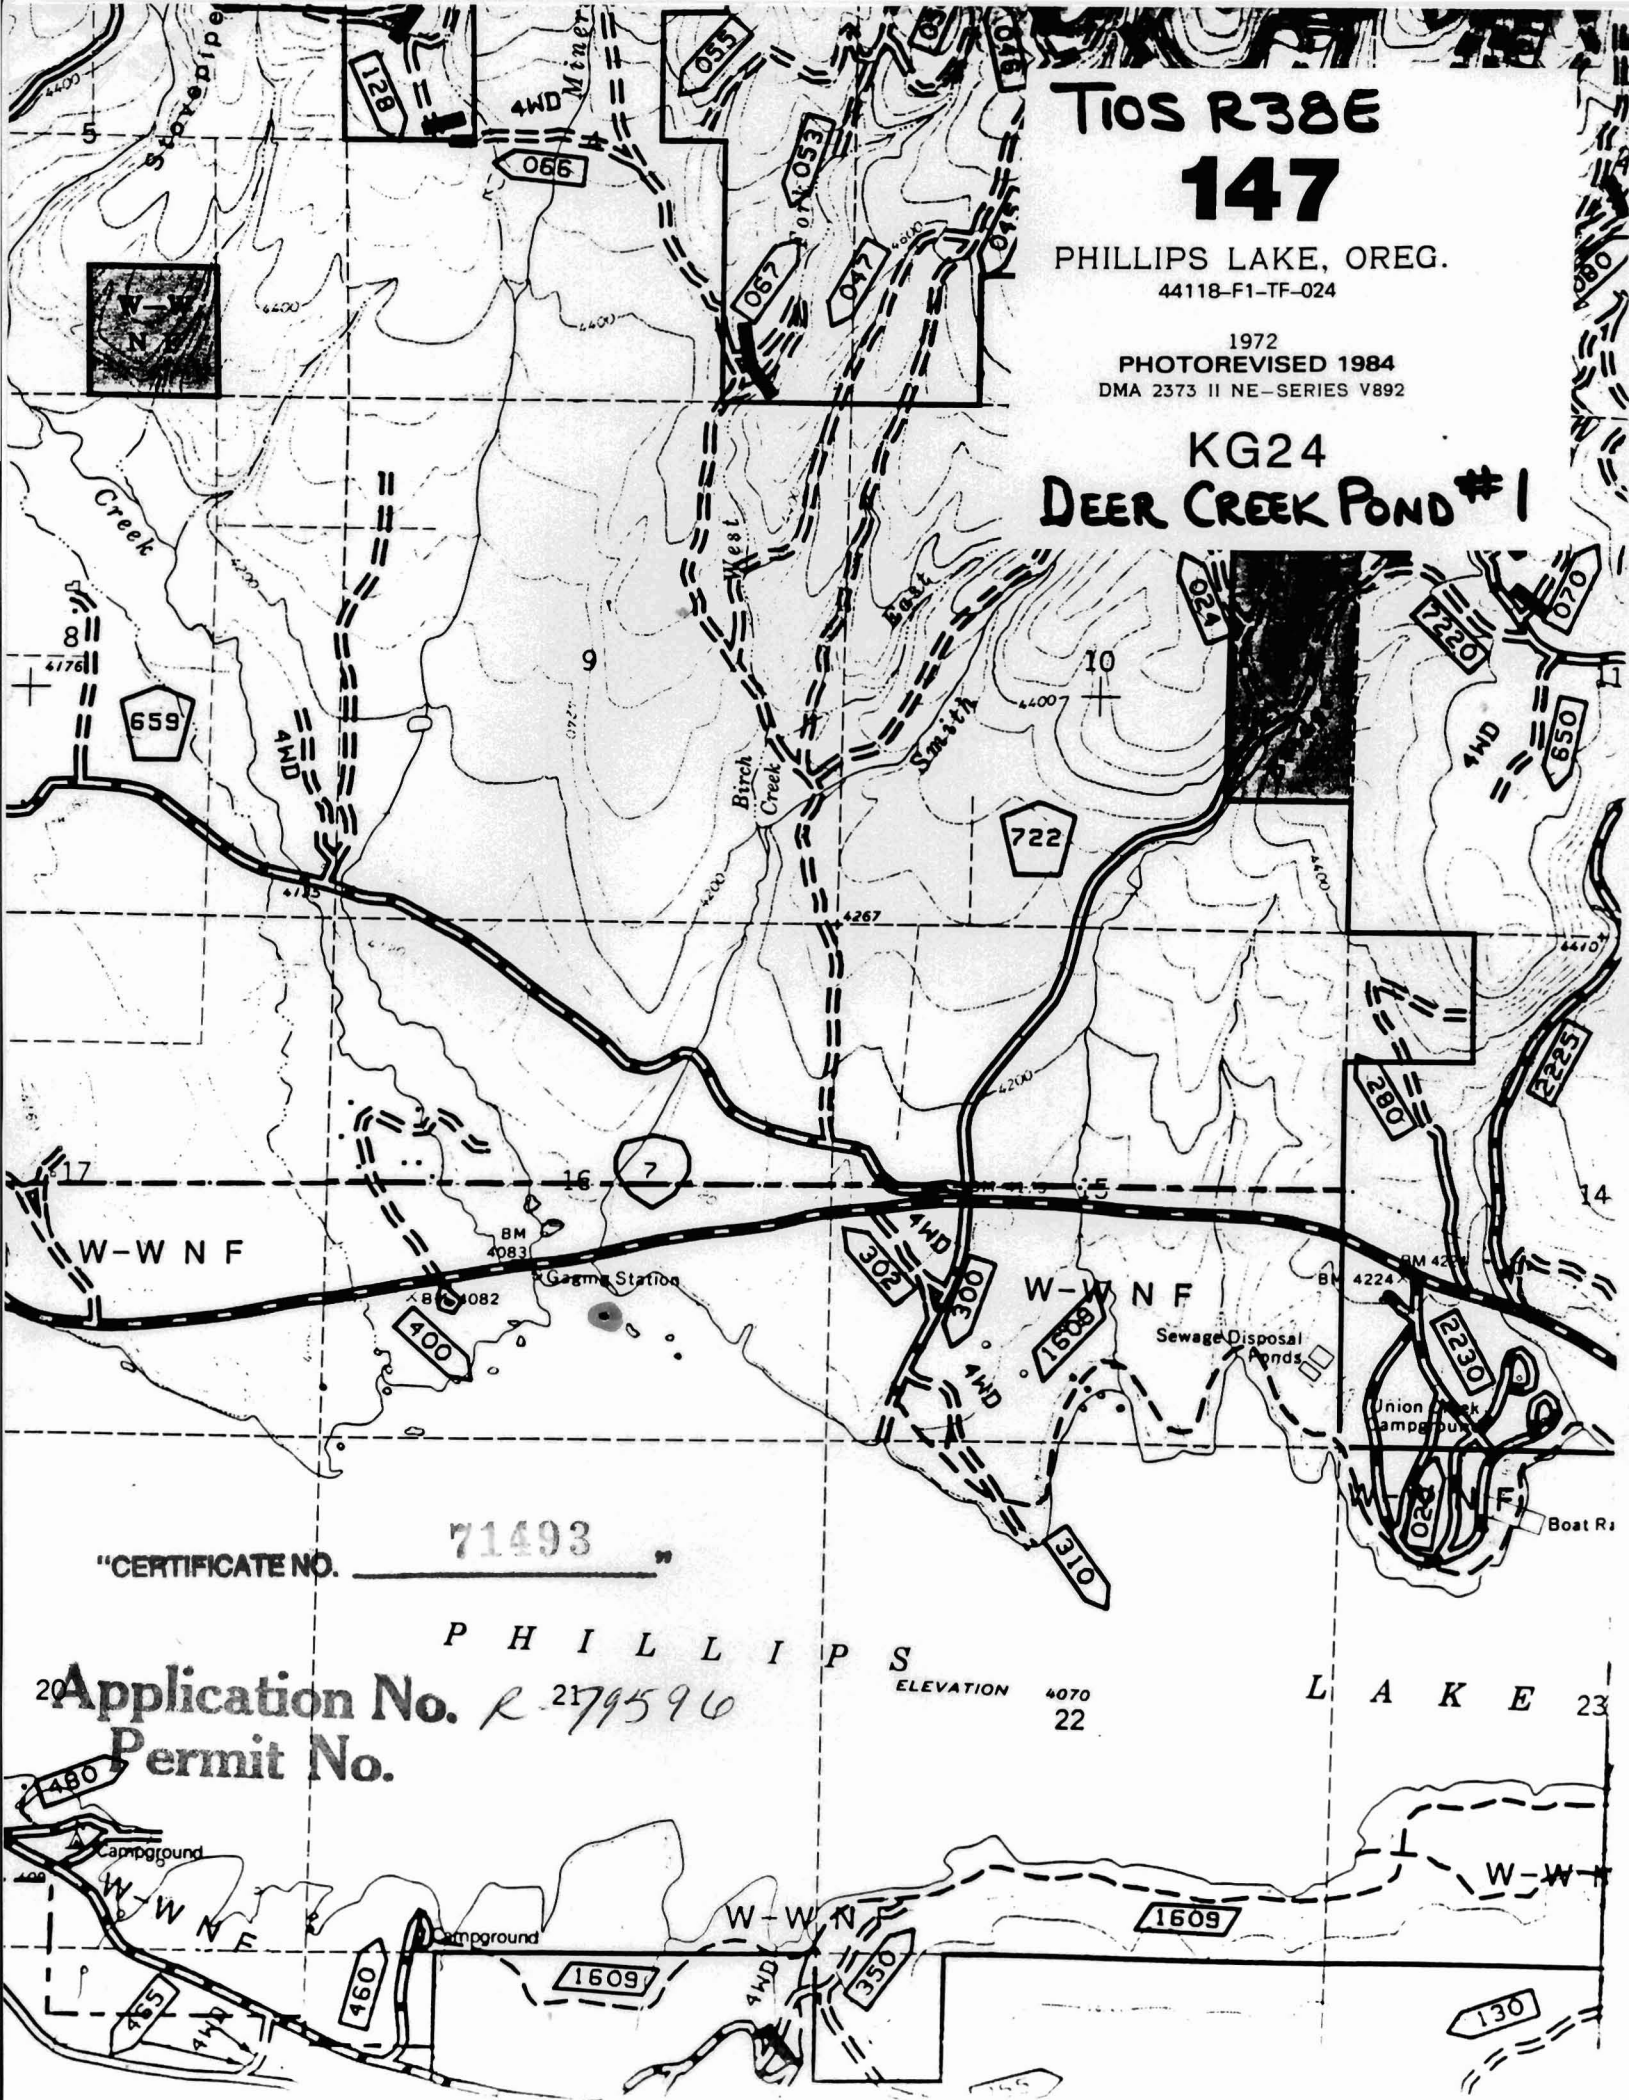


"CERTIFICATE NO. 71493"

P H I L L I P S

ELEVATION 4070
22

L A K E 23

Permit No.

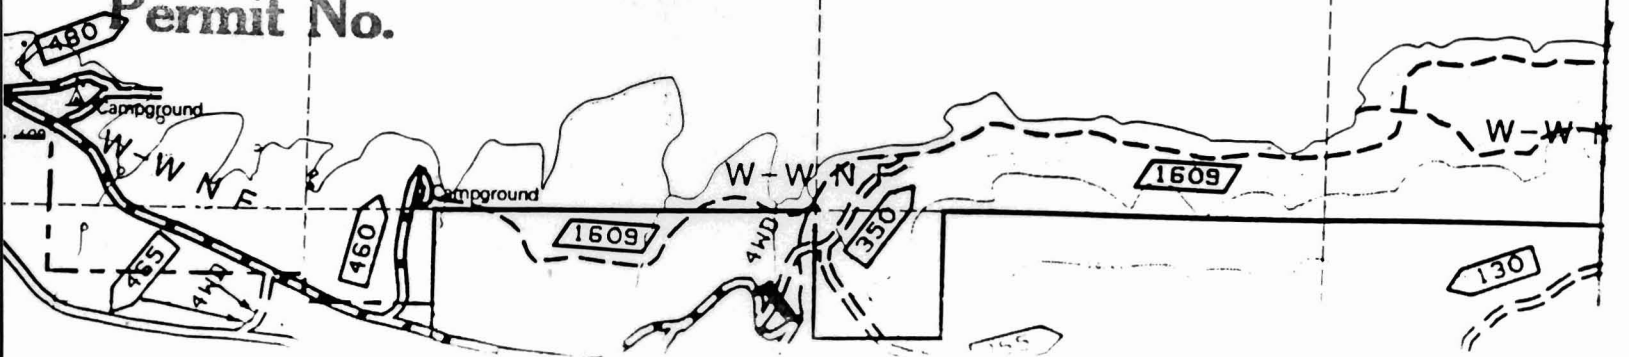


T10S R38E 147

PHILLIPS LAKE, OREG.
44118-F1-TF-024

1972
PHOTOREVISED 1984
DMA 2373 II NE-SERIES V892

KG24 DEER CREEK POND #2

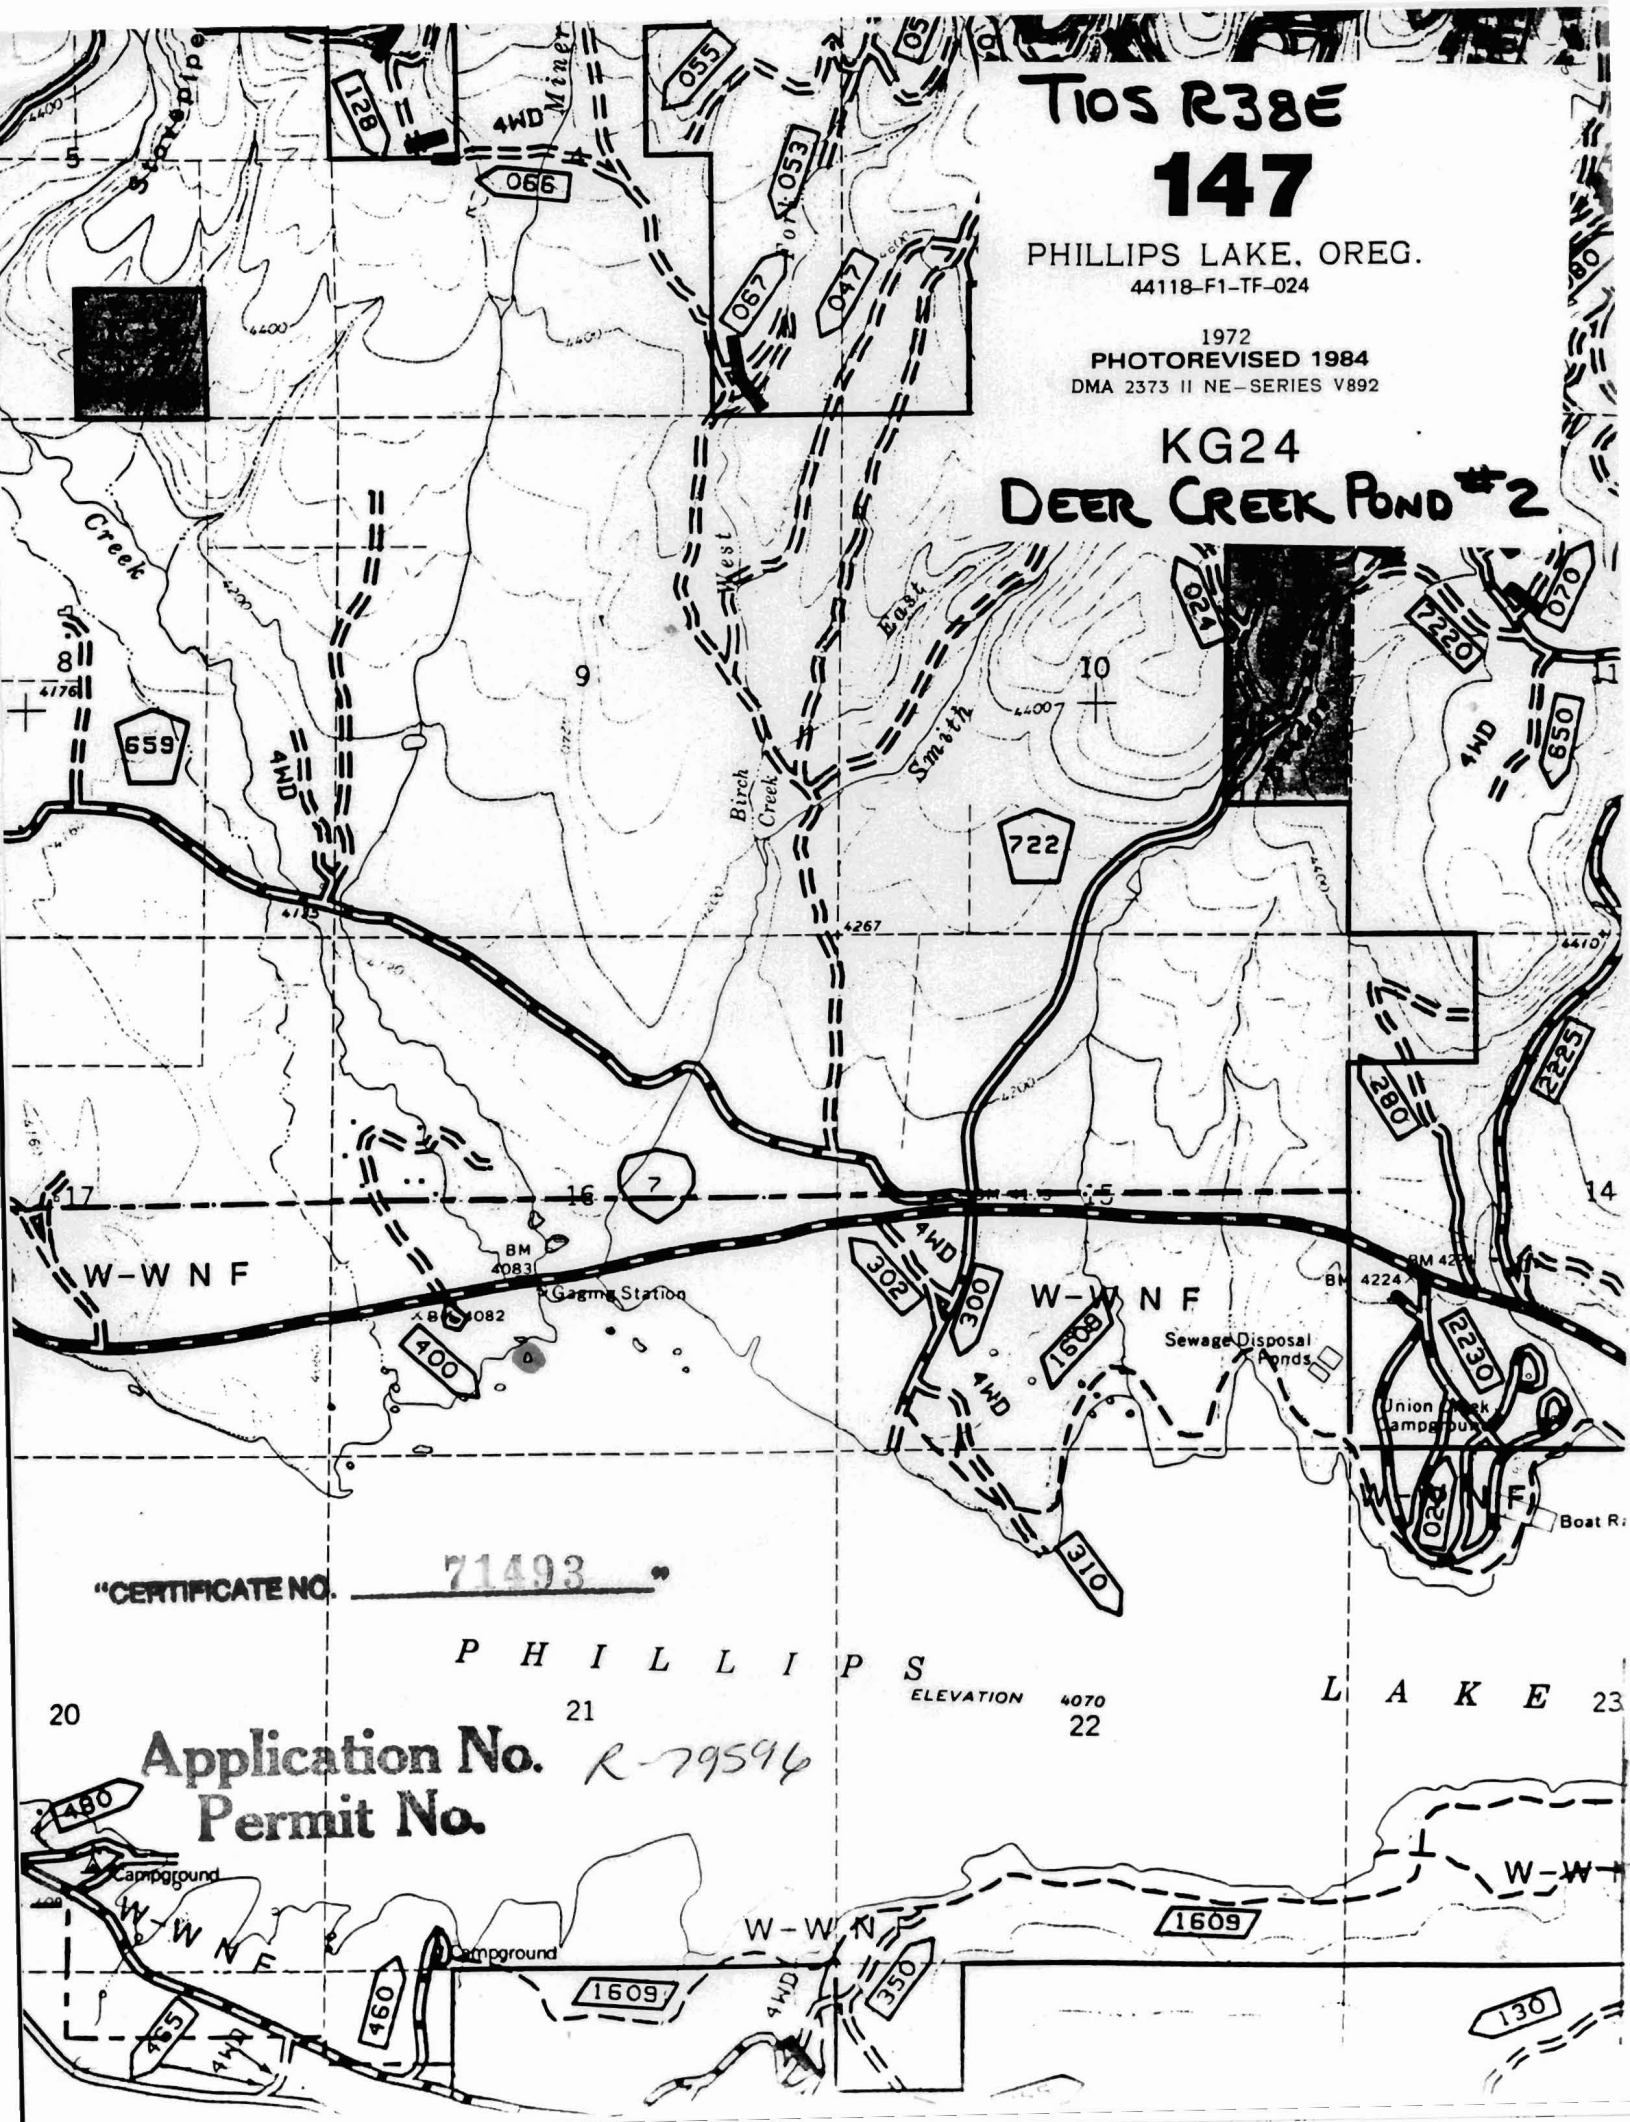

"CERTIFICATE NO. 71493"

P H I L L I P S


ELEVATION 4070
22

L A K E 23

20

21

Application No. *R-79596*
Permit No.

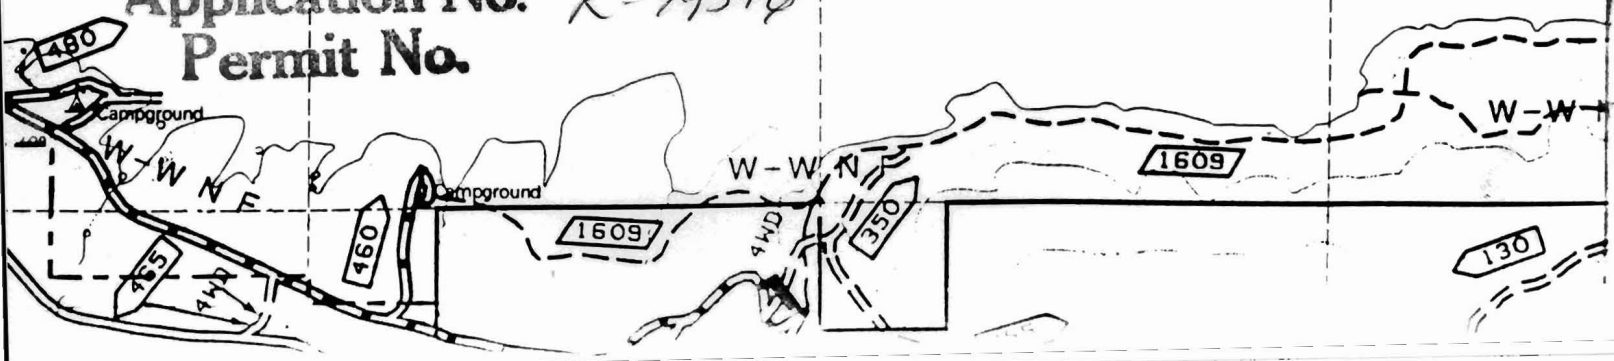


T10S R38E 147

PHILLIPS LAKE, OREG.
44118-F1-TF-024

1972
PHOTOREVISED 1984
DMA 2373 II NE-SERIES V892

KG24 DEER CREEK POND #3

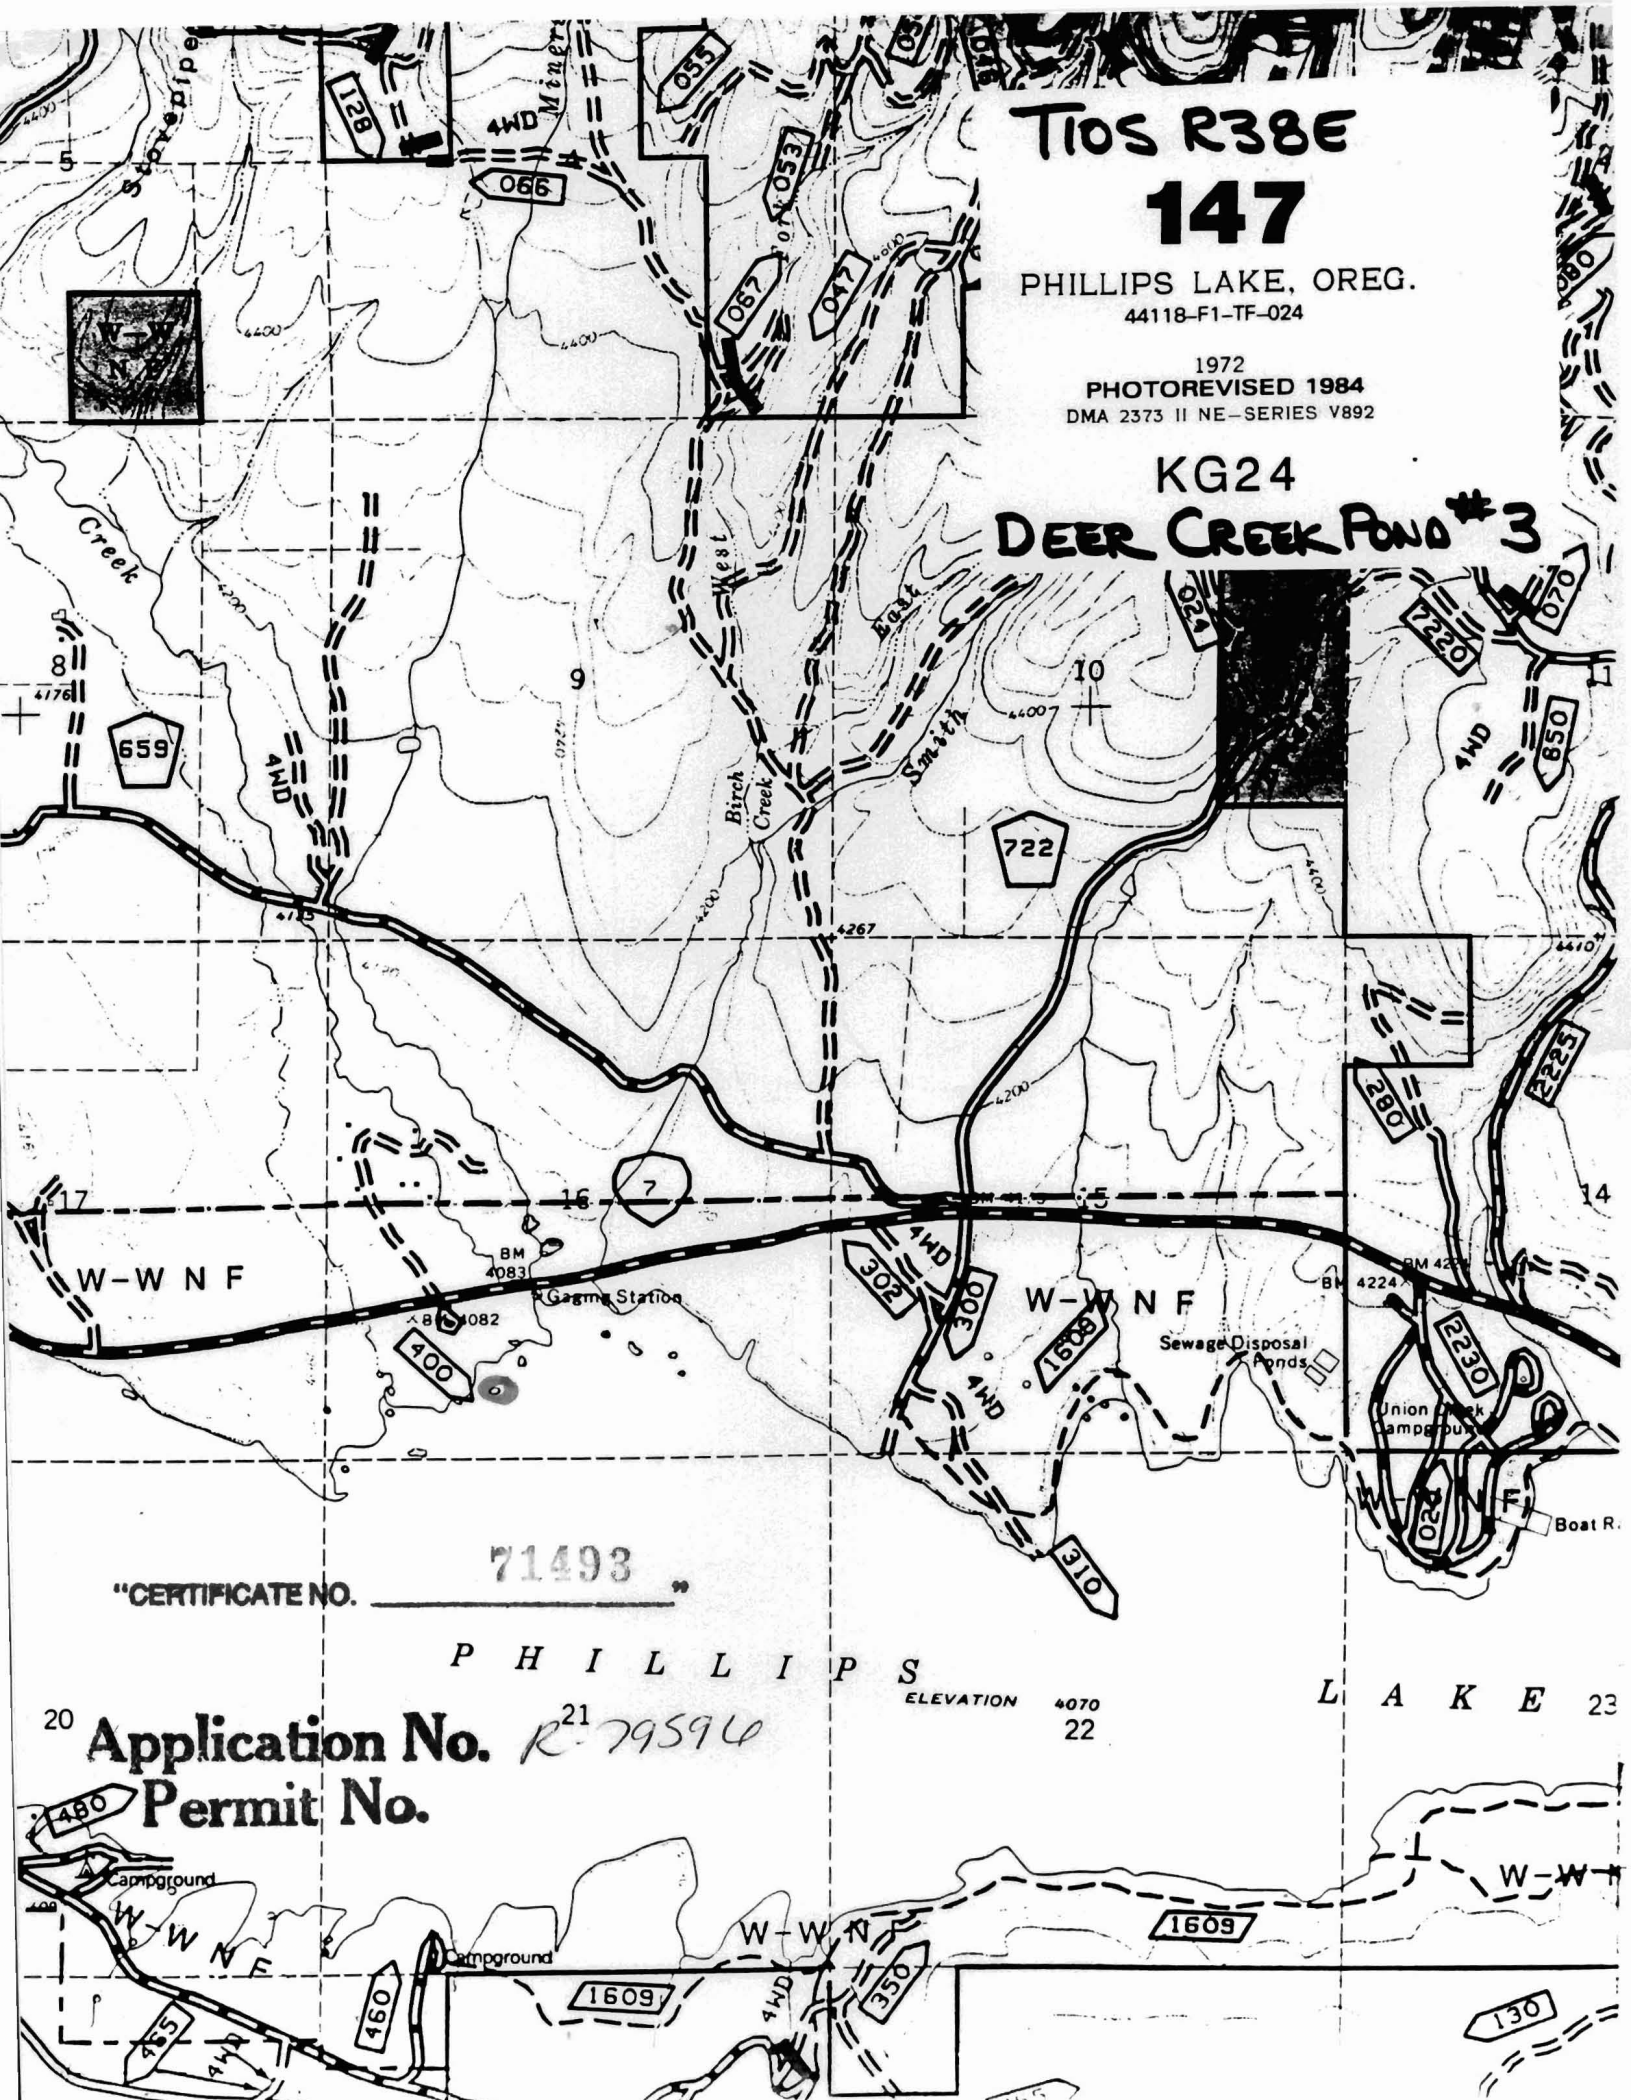


"CERTIFICATE NO. 71493"

PHILLIPS
ELEVATION 4070
22

L A K E 23

20 Application No. *R-79594*
Permit No.

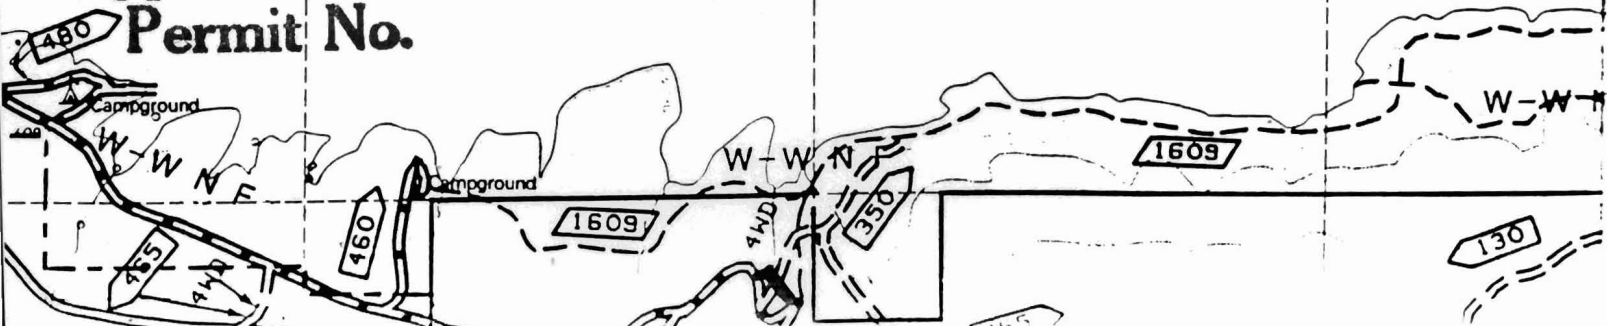


T10S R38E 147

PHILLIPS LAKE, OREG.
44118-F1-TF-024

1972
PHOTOREVISED 1984
DMA 2373 II NE-SERIES V892


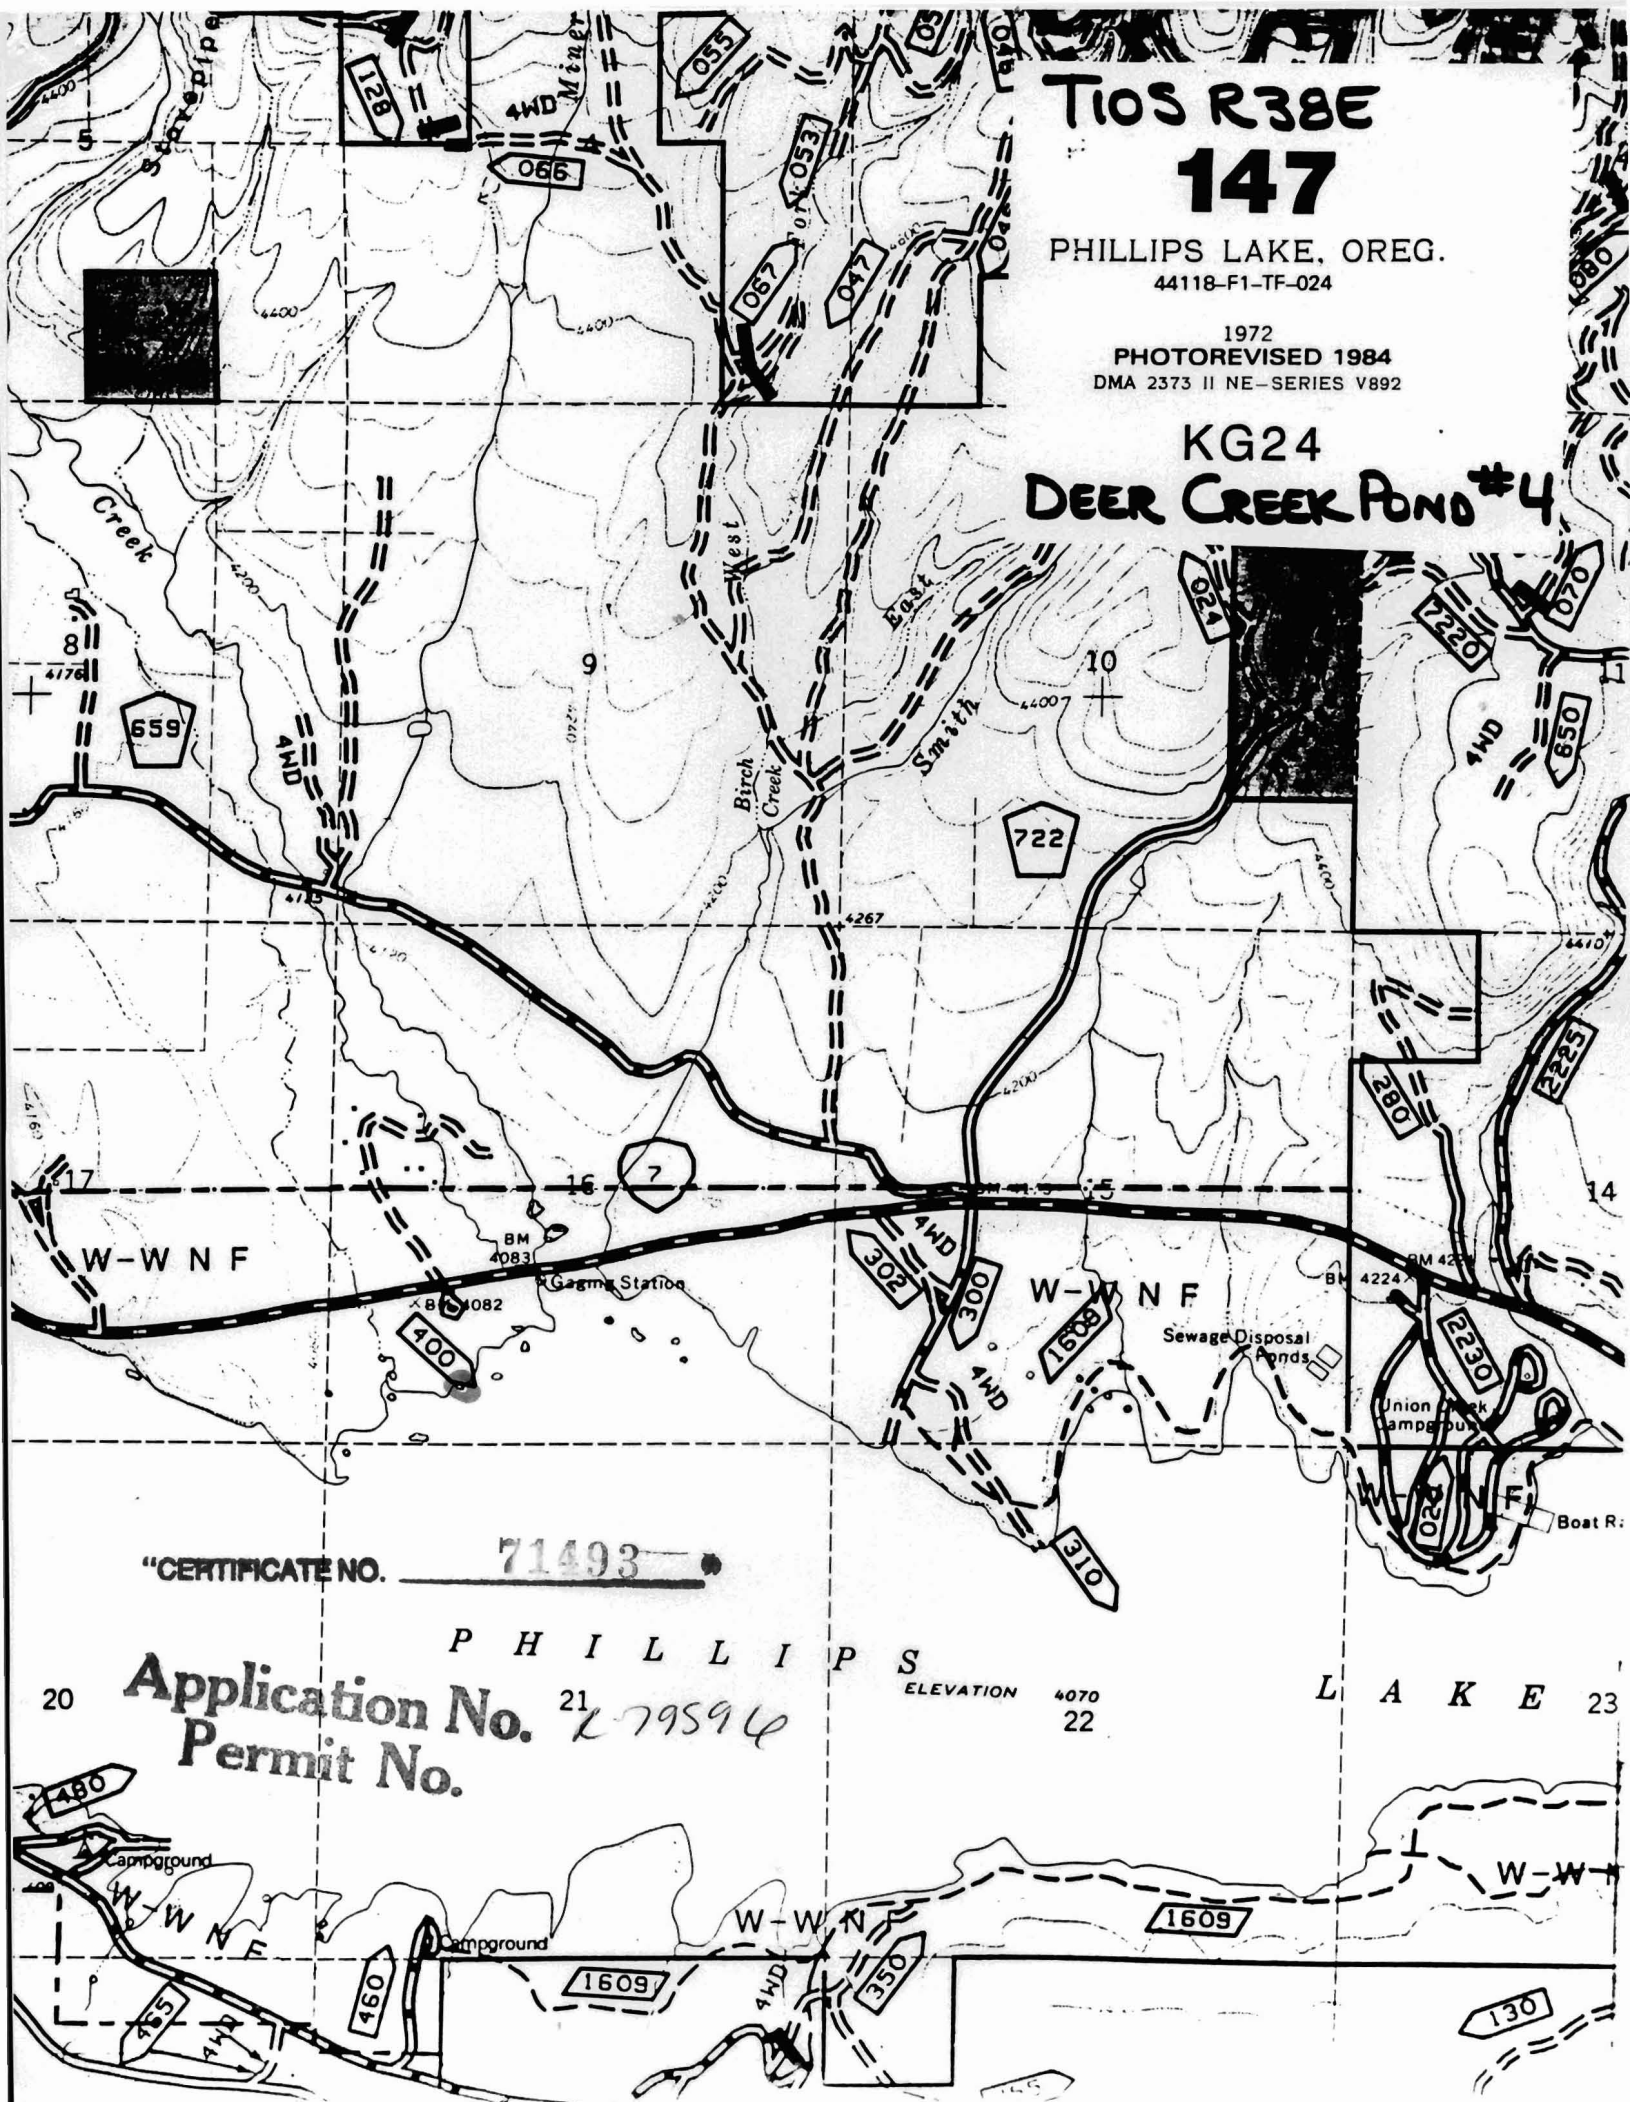


"CERTIFICATE NO. 71493"

P H I L L I P S

20 Application No. 21 279594
Permit No.

ELEVATION 4070
22

L A K E 23

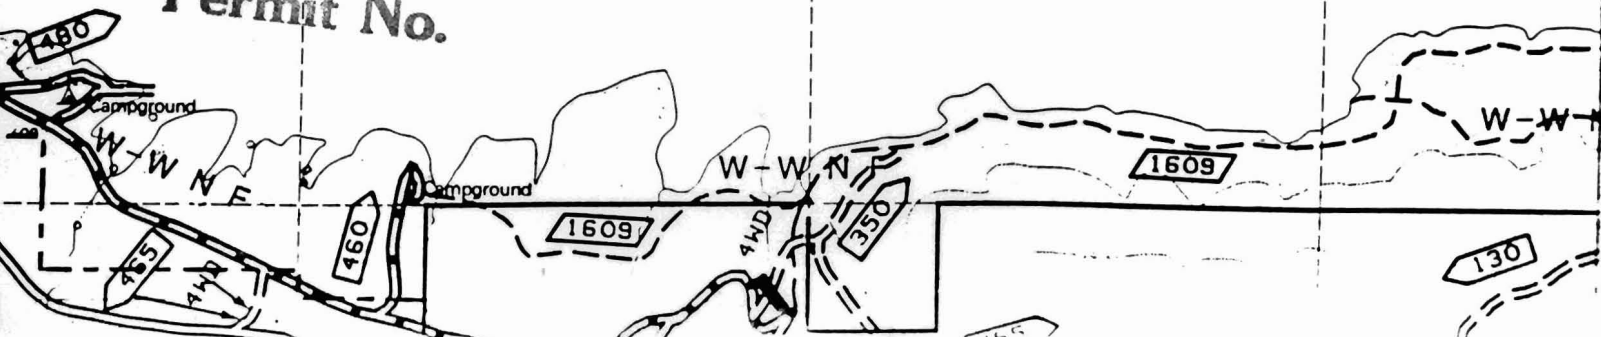


T10S R38E 147

PHILLIPS LAKE, OREG.
44118-F1-TF-024

1972
PHOTOREVISED 1984
DMA 2373 II NE-SERIES V892


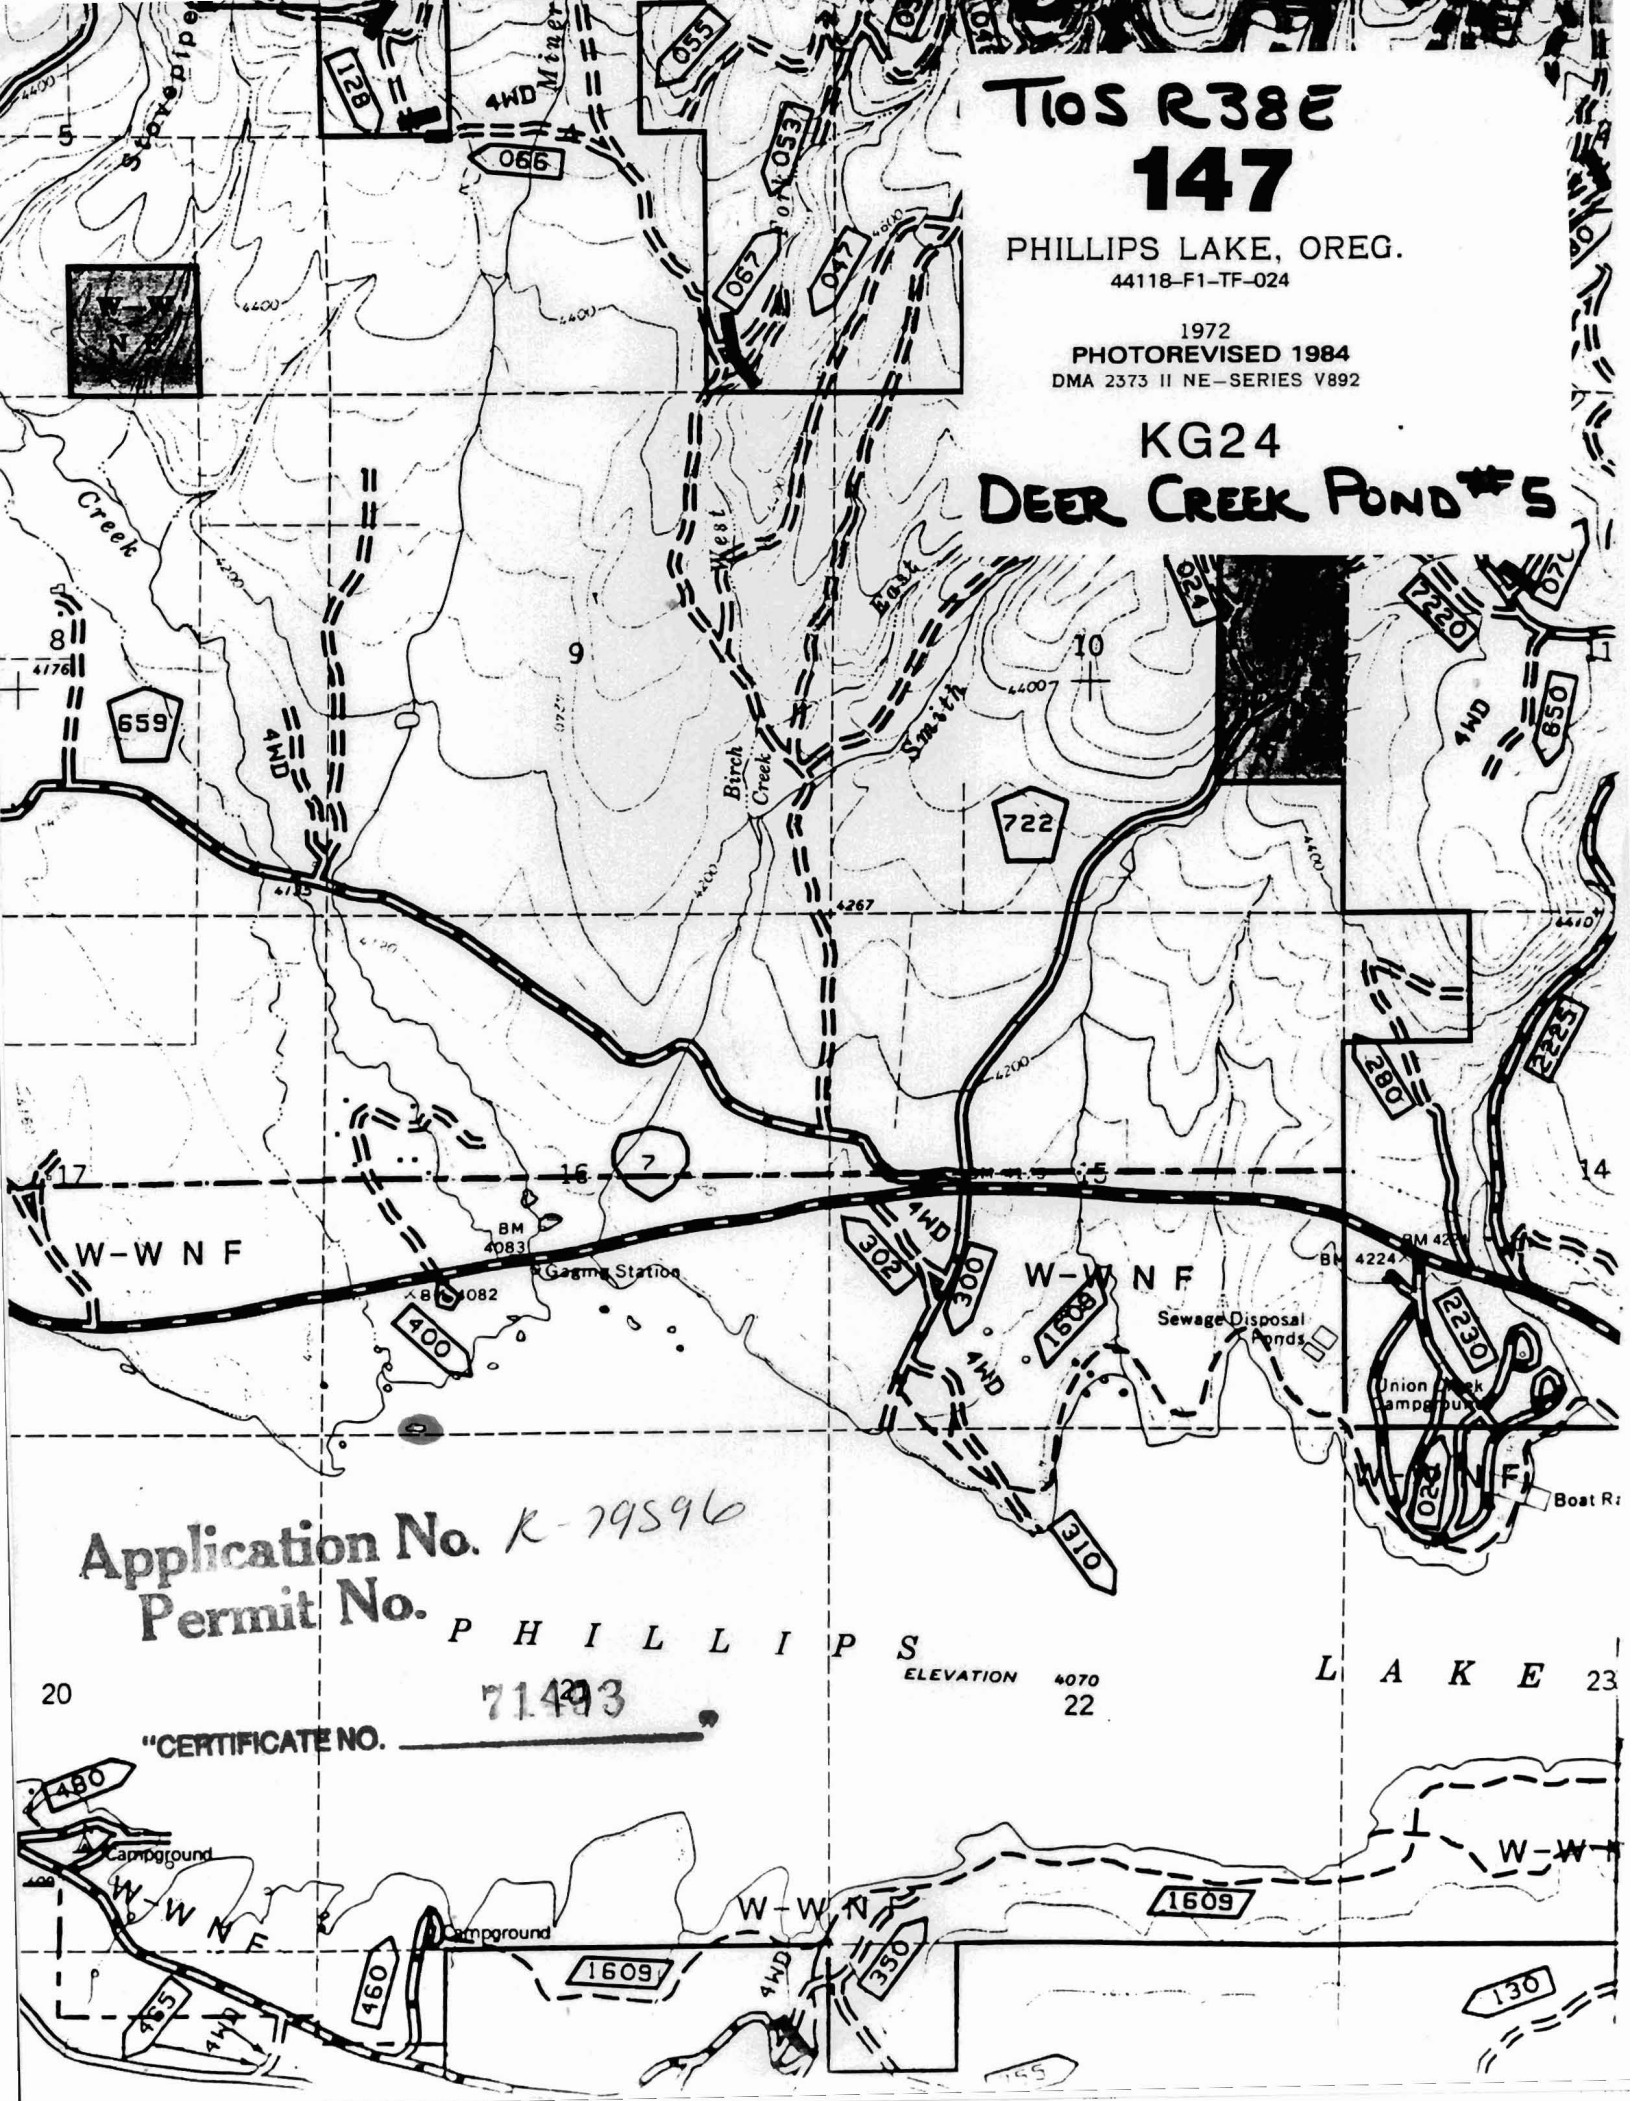


Application No. *R-79596*
Permit No. _____

PHILLIPS
ELEVATION 4070
22

L A K E 23

"CERTIFICATE NO. _____"

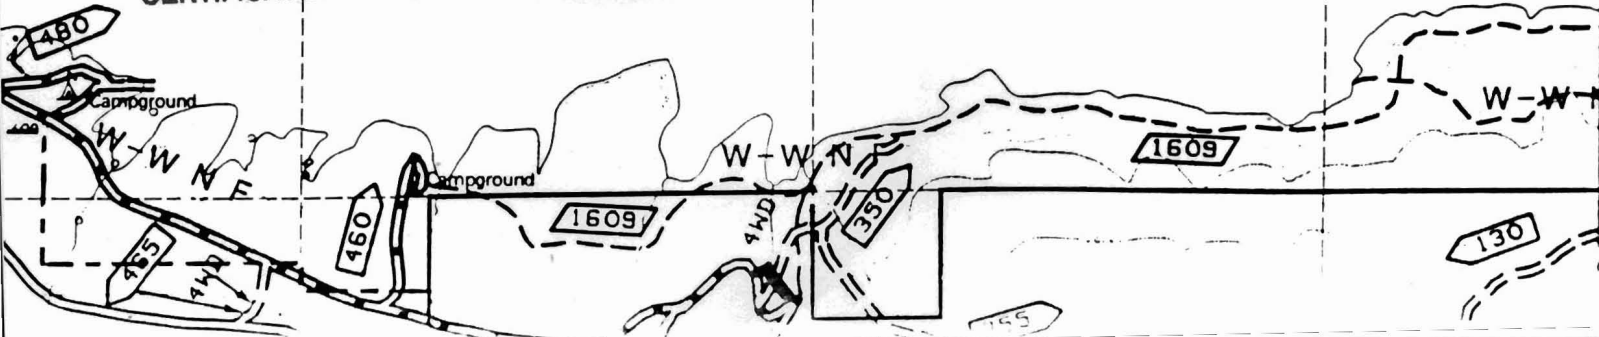

T10S R38E

147


PHILLIPS LAKE, OREG.

44118-F1-TF-024

1972
PHOTOREVISED 1984
DMA 2373 II NE-SERIES V892


KG24


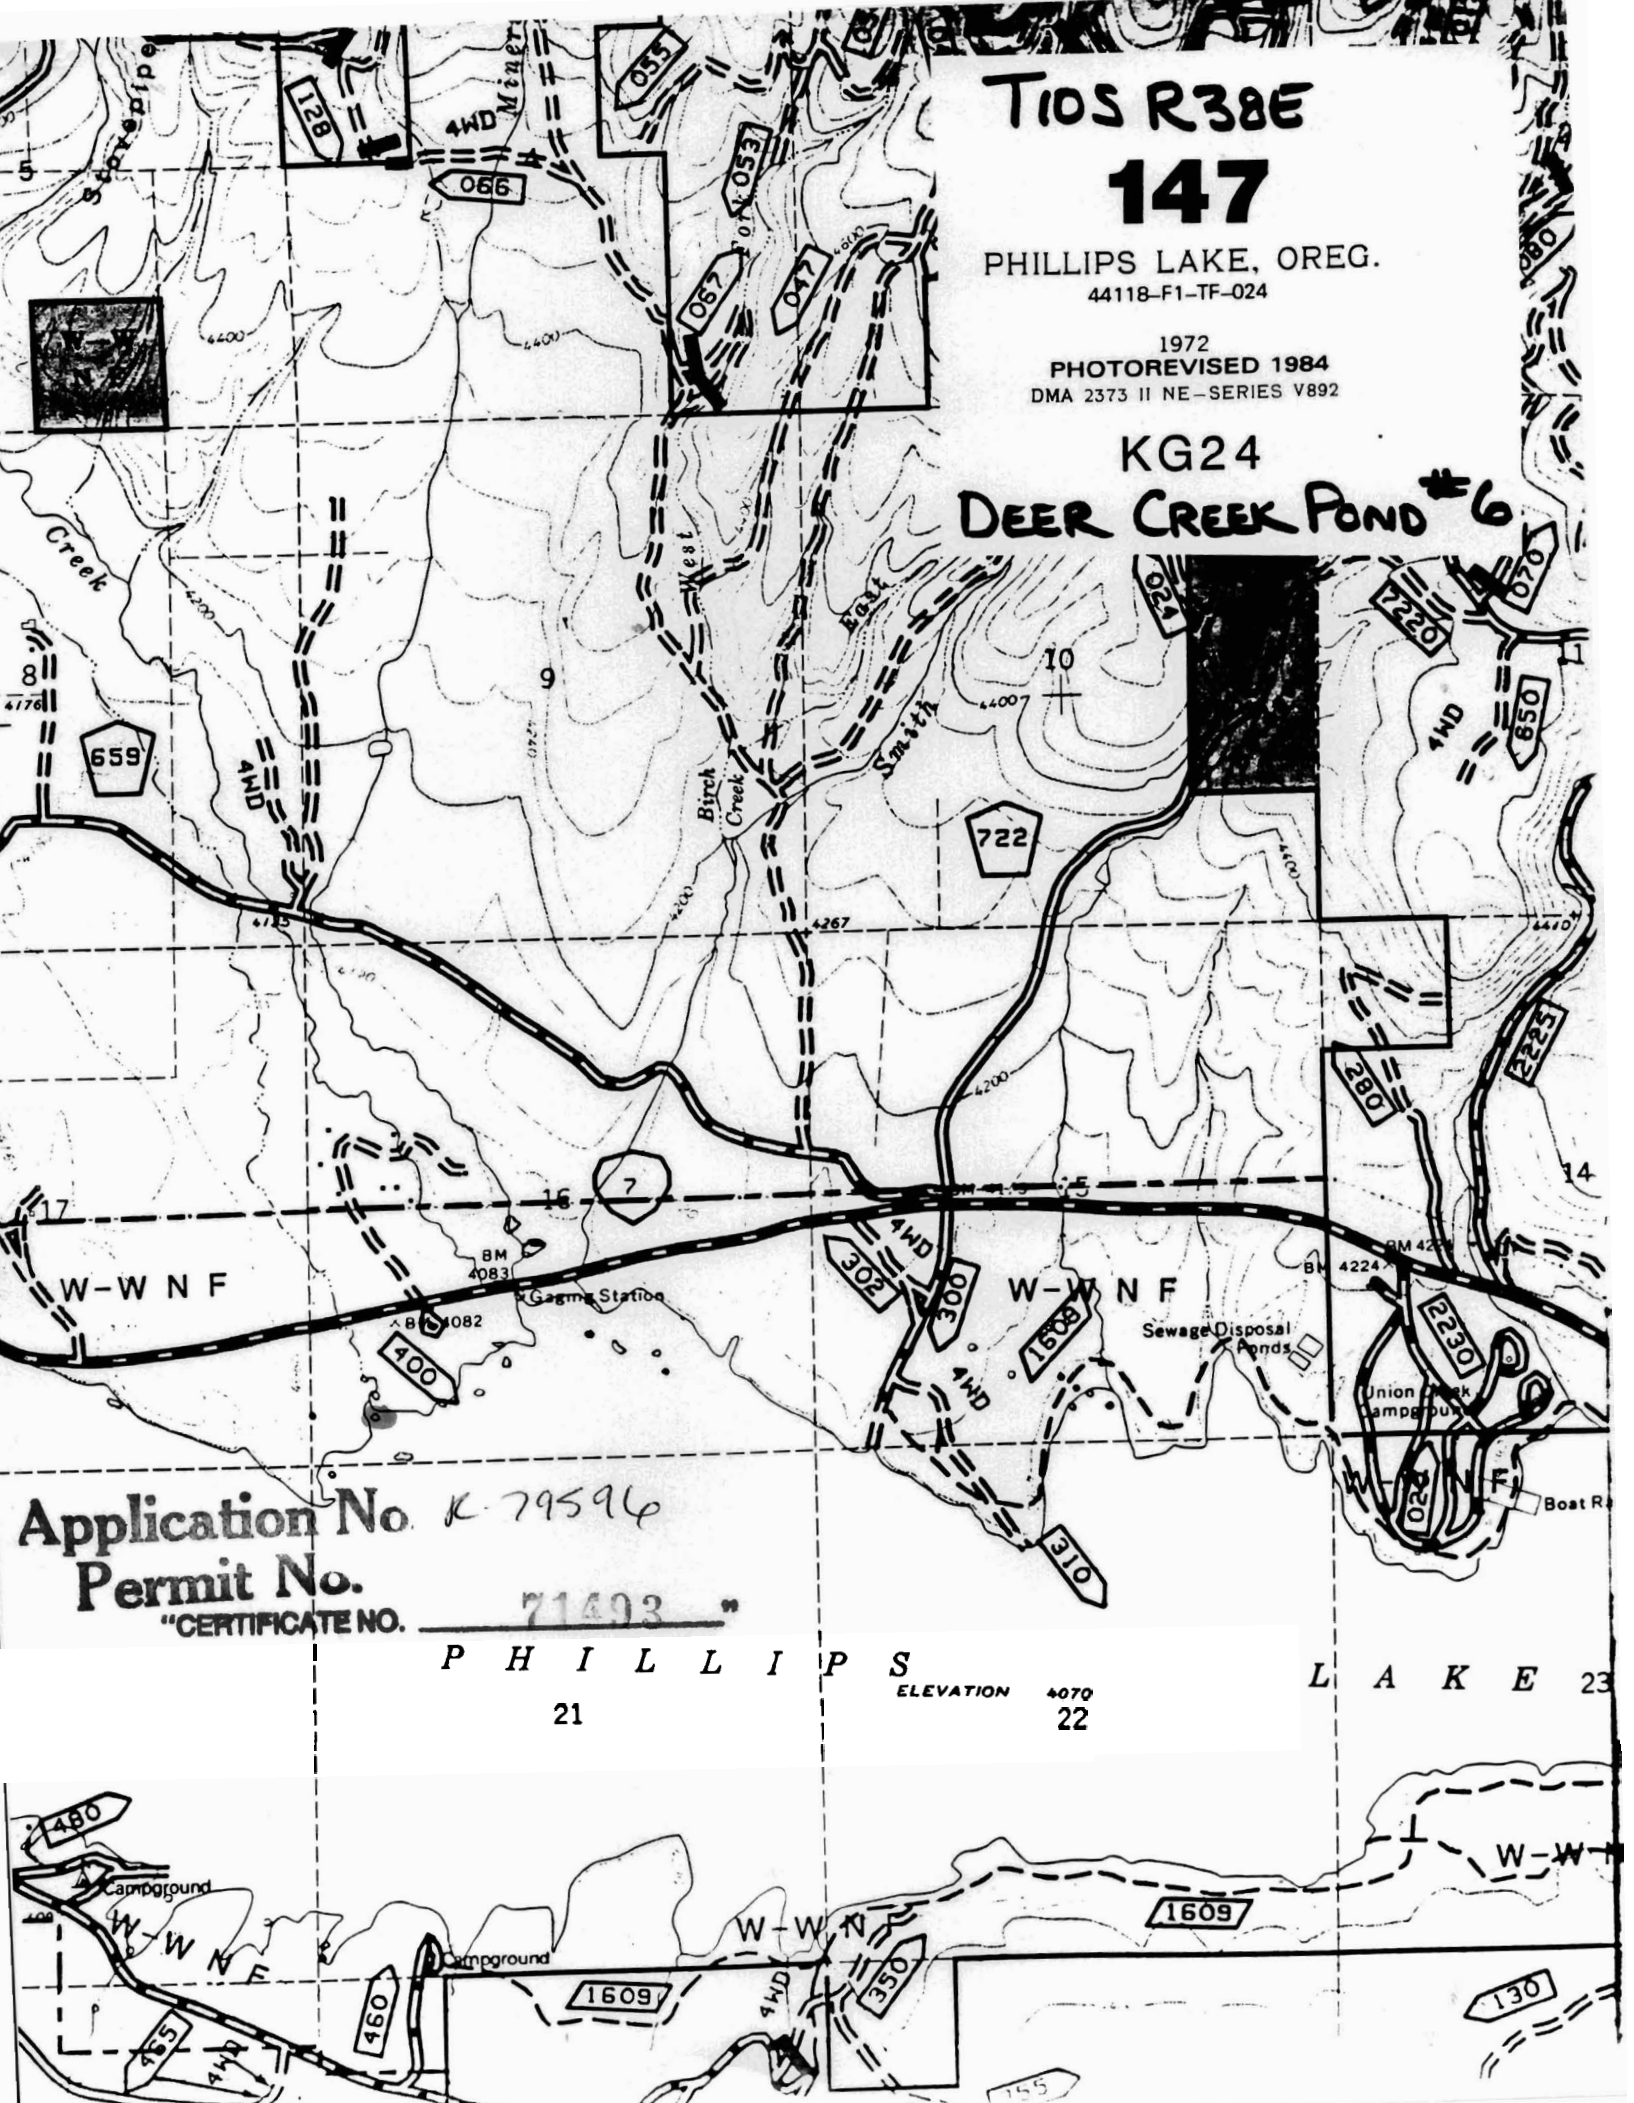

Application No. K-79596
 Permit No. _____
 "CERTIFICATE NO. 71493"

PHILLIPS LAKE 23
 ELEVATION 4070
 22

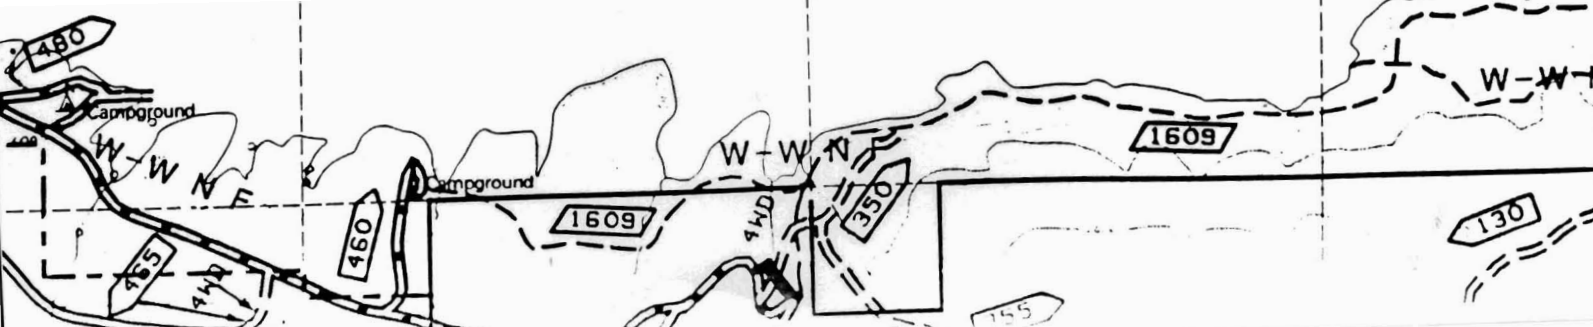


T10S R38E 147

PHILLIPS LAKE, OREG.
44118-F1-TF-024

1972
PHOTOREVISED 1984
DMA 2373 II NE-SERIES V892

KG24 DEER CREEK POND #7

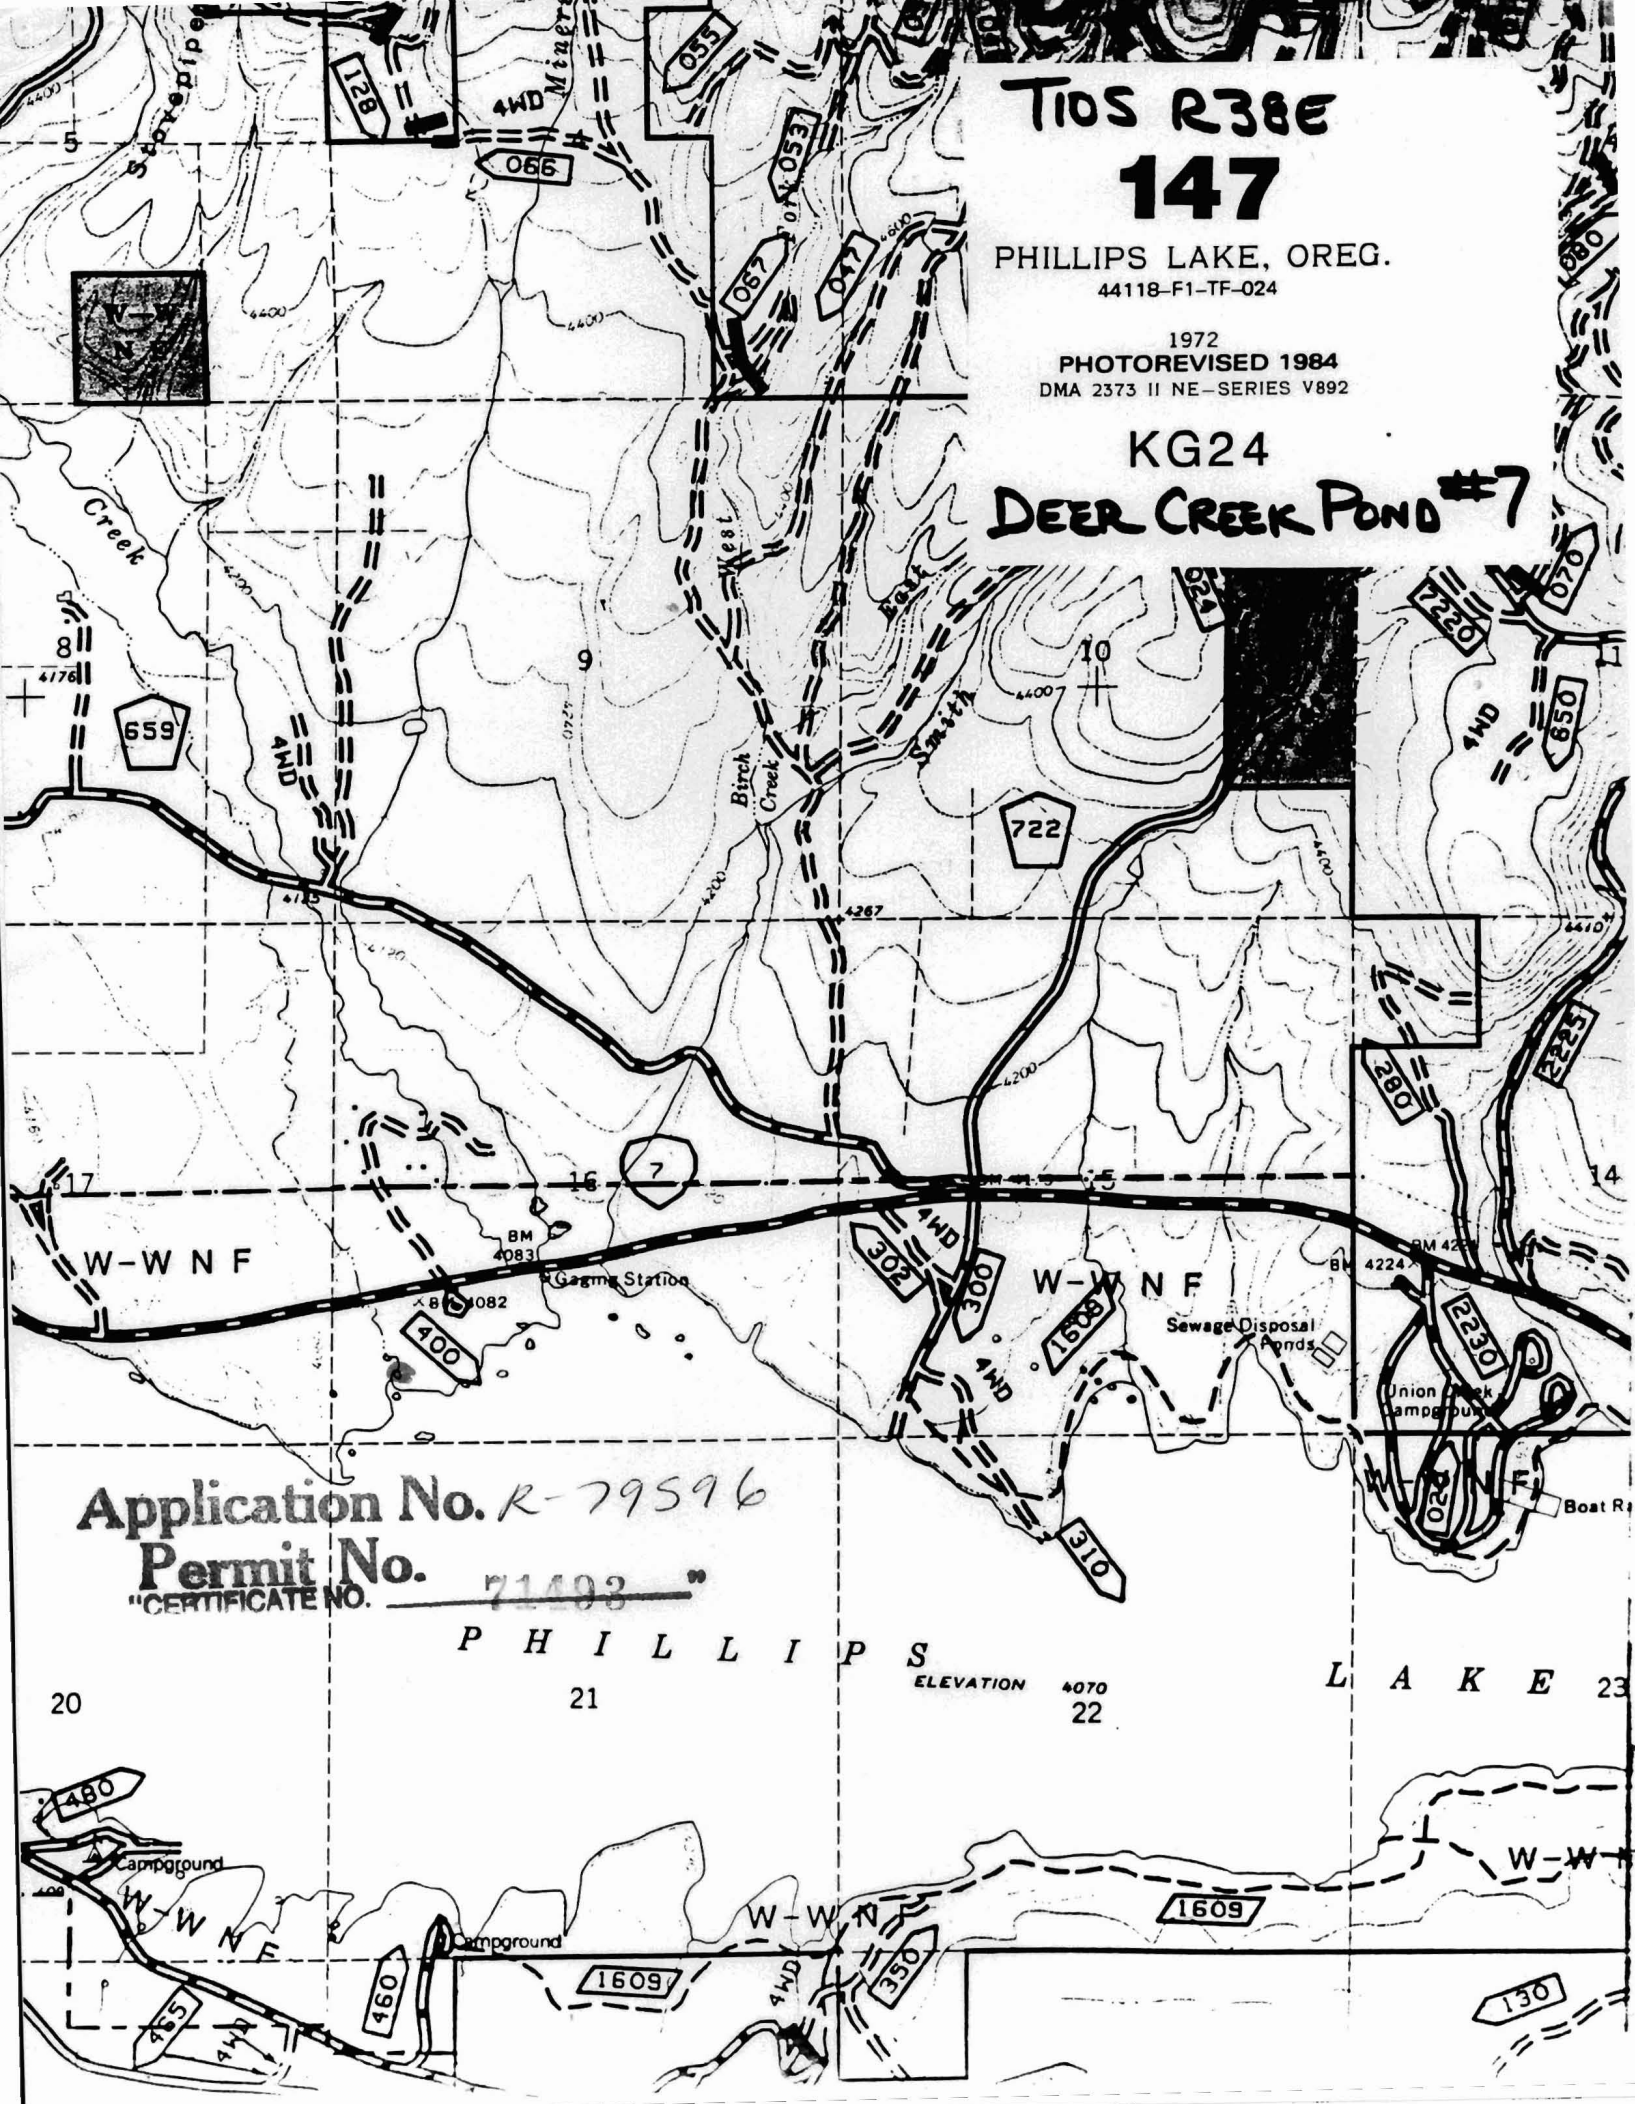

Application No. R-79596
Permit No. 71493
"CERTIFICATE NO. 71493"

P H I L L I P S

ELEVATION 4070
22

L A K E 23

20

21


23

T10S R38E 147

PHILLIPS LAKE, OREG.
44118-F1-TF-024

1972
PHOTOREVISED 1984
DMA 2373 II NE-SERIES V892

KG24 DEER CREEK POND #8

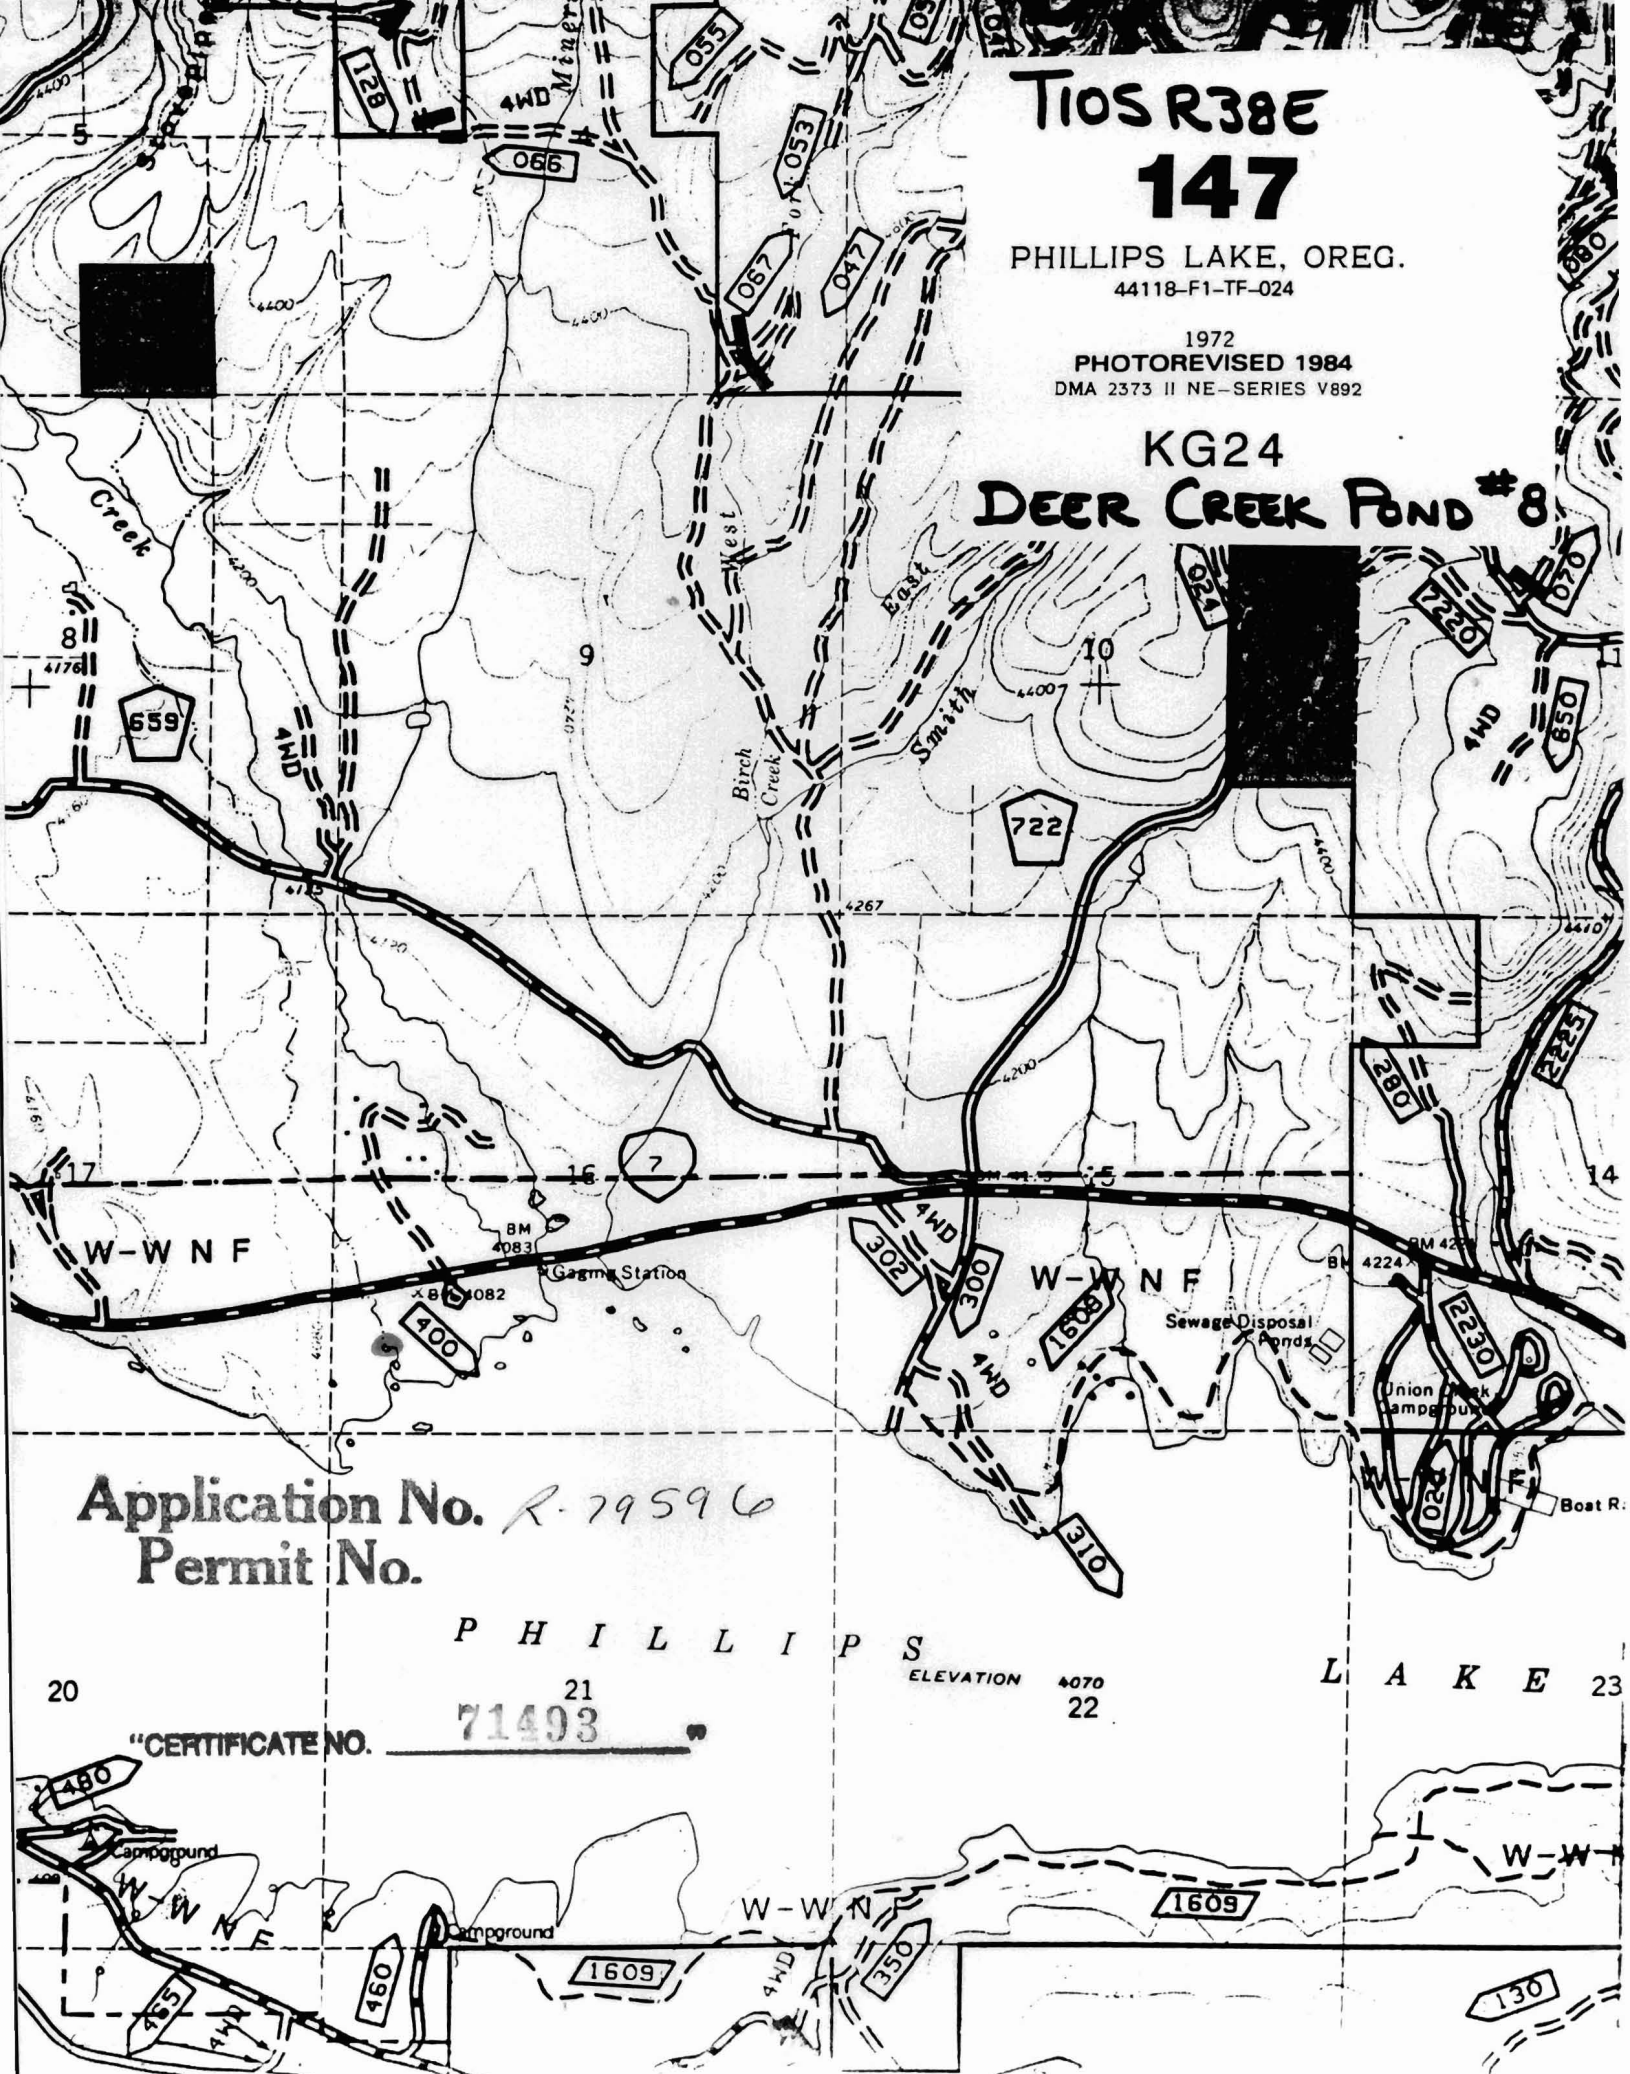


Application No. *R-79596*
Permit No.

P H I L L I P S
ELEVATION 4070
22

L A K E 23

"CERTIFICATE NO. 71493"

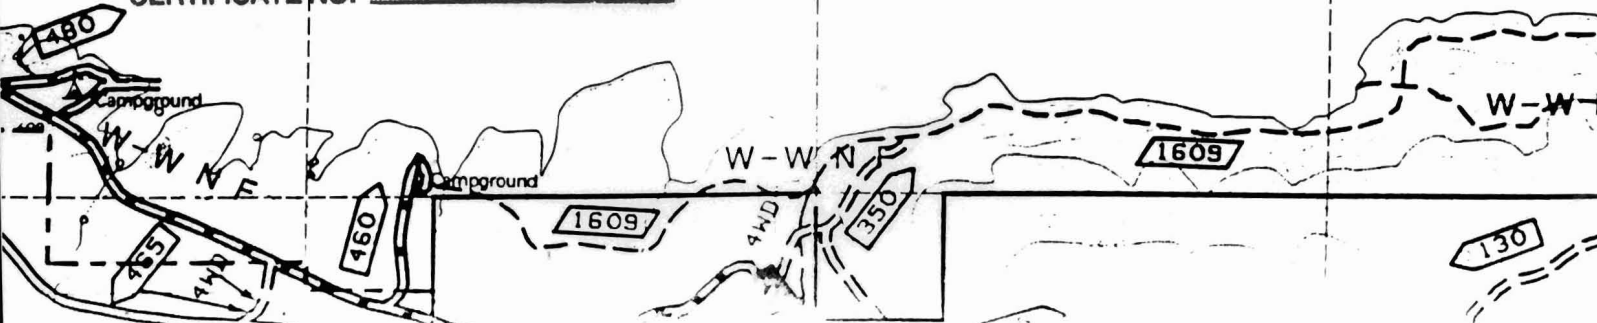

T10S R38E

147


PHILLIPS LAKE, OREG.

44118-F1-TF-024

1972
PHOTOREVISED 1984
DMA 2373 II NE-SERIES V892

KG24

DEER CREEK POND #10

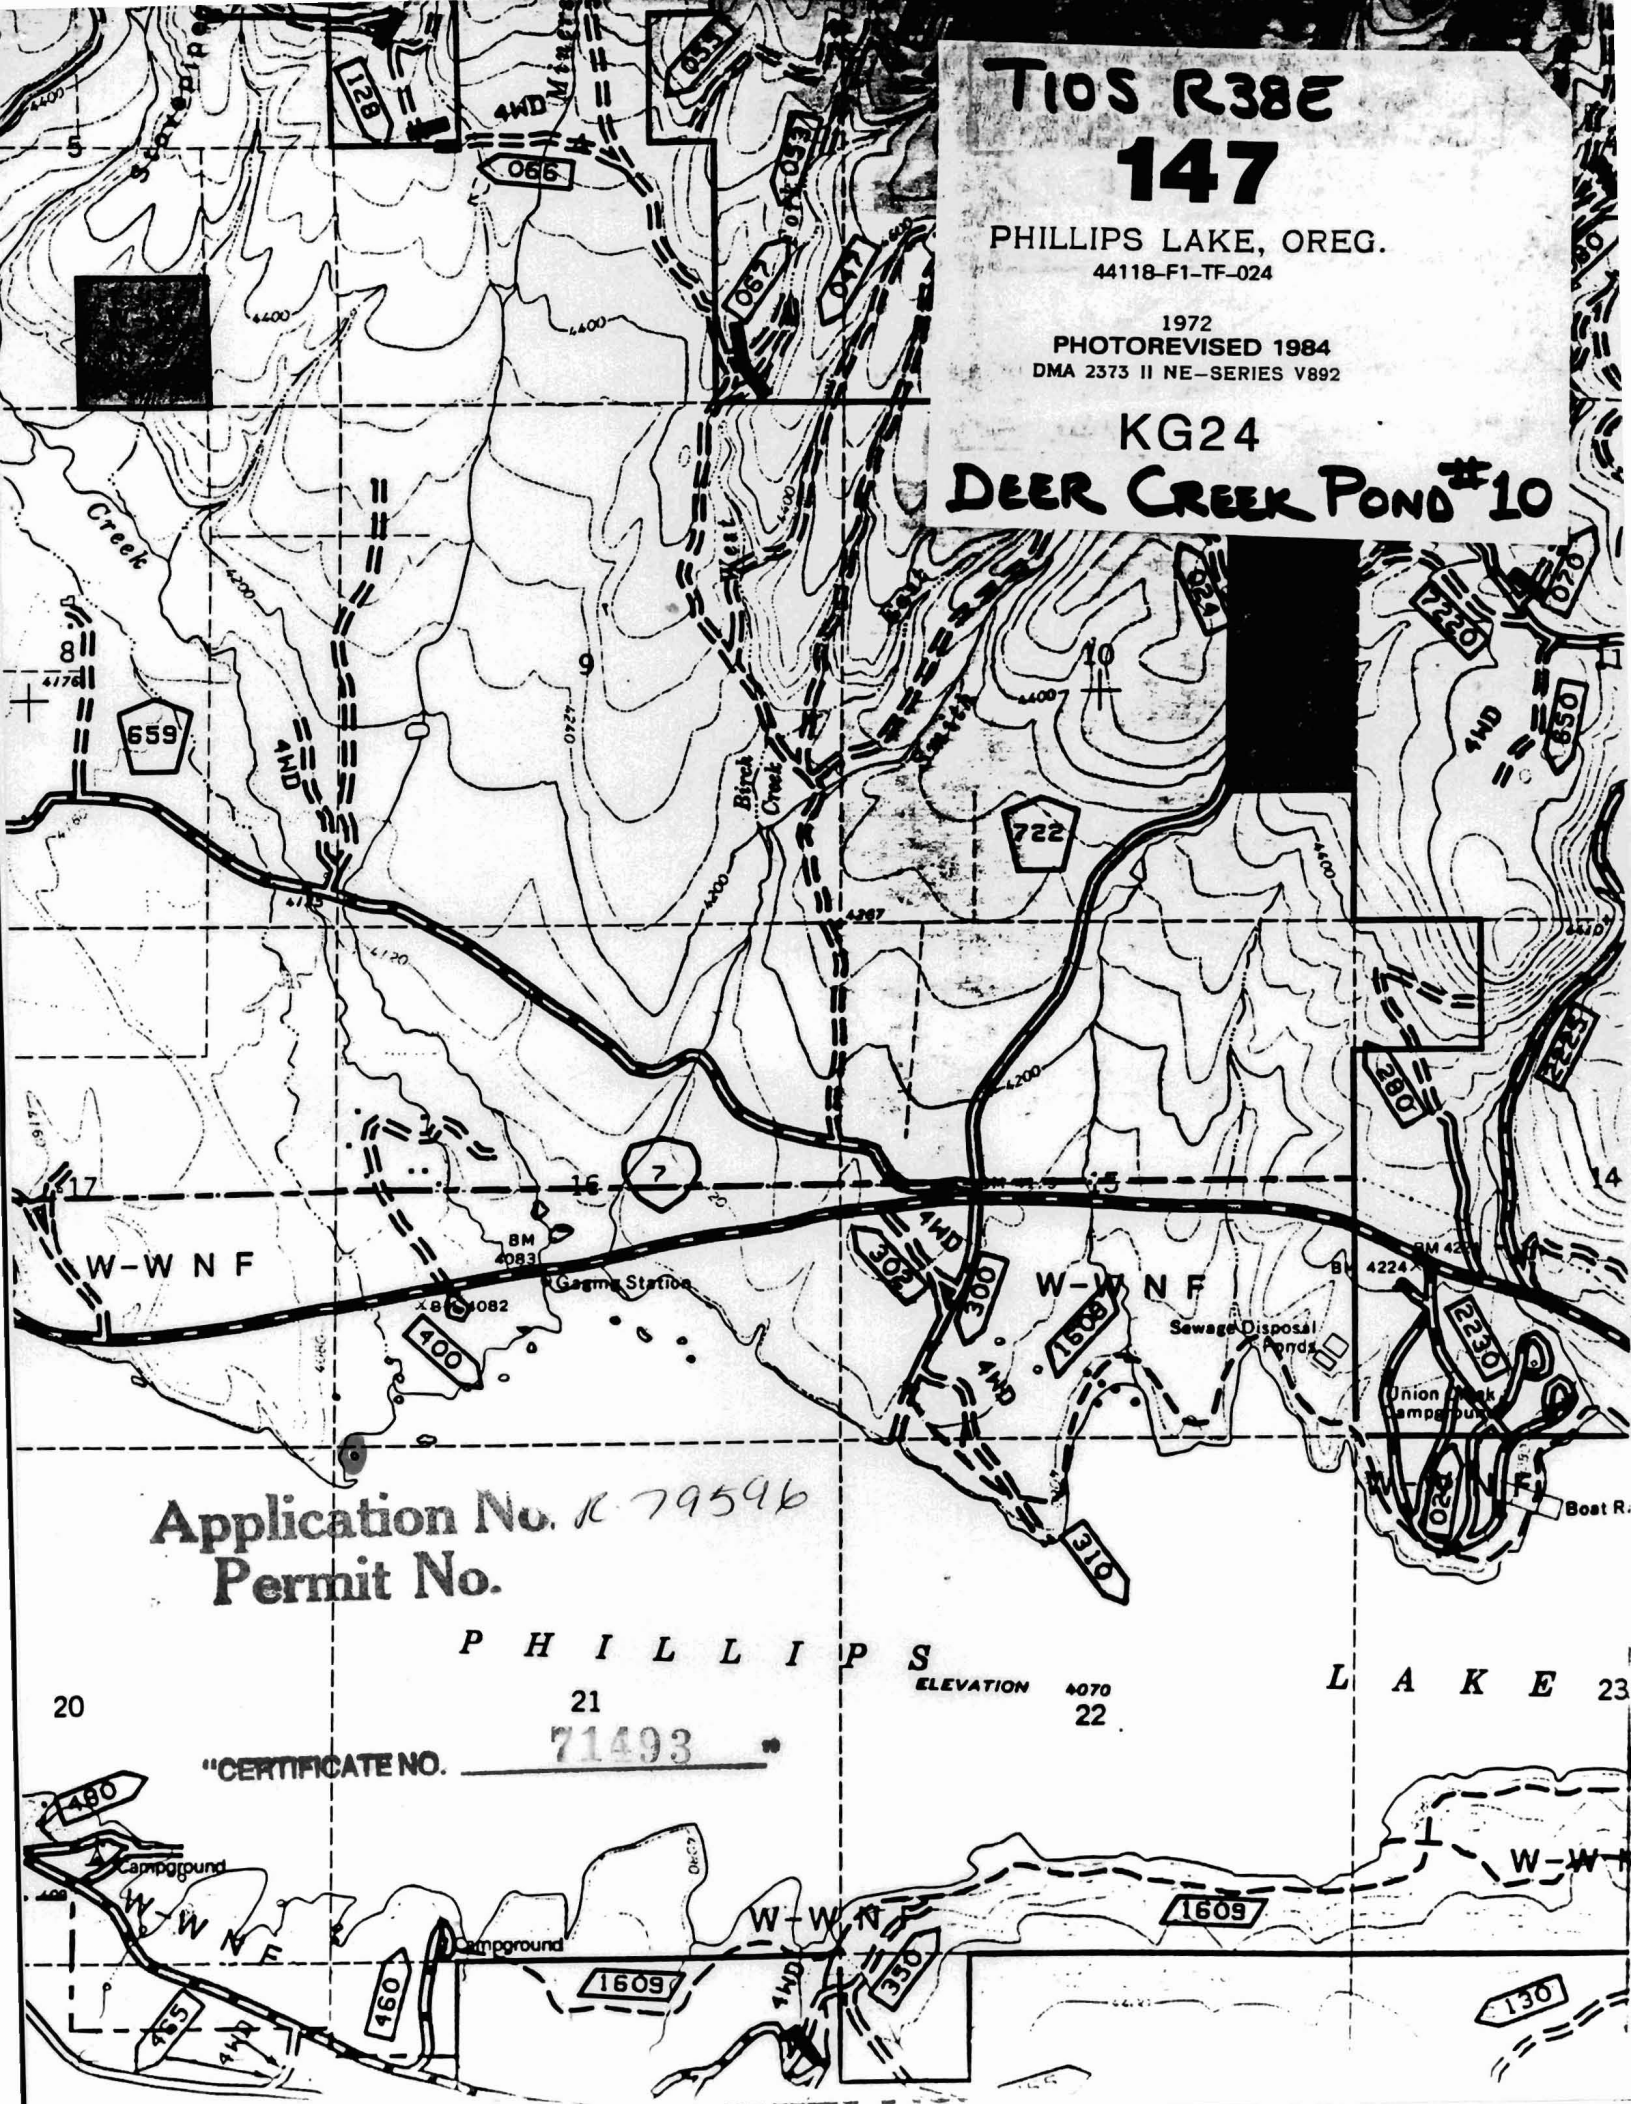

Application No. K 79596
Permit No.

P H I L L I P S

ELEVATION 4070
22

L A K E 23

"CERTIFICATE NO. 71493"

