

CANCELLED TAX LOTS
1409, 706, 707, 710, 711,
1421, 1415, 1704, 200, 1907,
1407, 1790, 1701, 713,
700, 1800, 2500, 2600, 2700,

BEG. C.R. 632
LARGE FLAT ROCK

SEE MAP
2 S 1 30B

SEE MAP
2 S 1 30C

WASHINGTON COUNTY
DEPARTMENT OF
ASSESSMENT & TAXATION

JUL 21 1994

FOR ASSESSMENT PURPOSES
ONLY - DO NOT RELY ON

BEG. C.R. 317

88-2

R-25-06

W.F. Chicken Cr
-3000 270020

SEE MAP
2S 2 36

9


UNITED STATES
DEPARTMENT OF THE INTERIOR
GEOLOGICAL SURVEY

79600
CERTIFICATE NO.

1961
Photo revised 1985

SHERWOOD QUADRANGLE
OREGON
7.5 MINUTE SERIES (TOPOGRAPHIC)
SE 1/4 BEAVERTON 15' QUADRANGLE

20

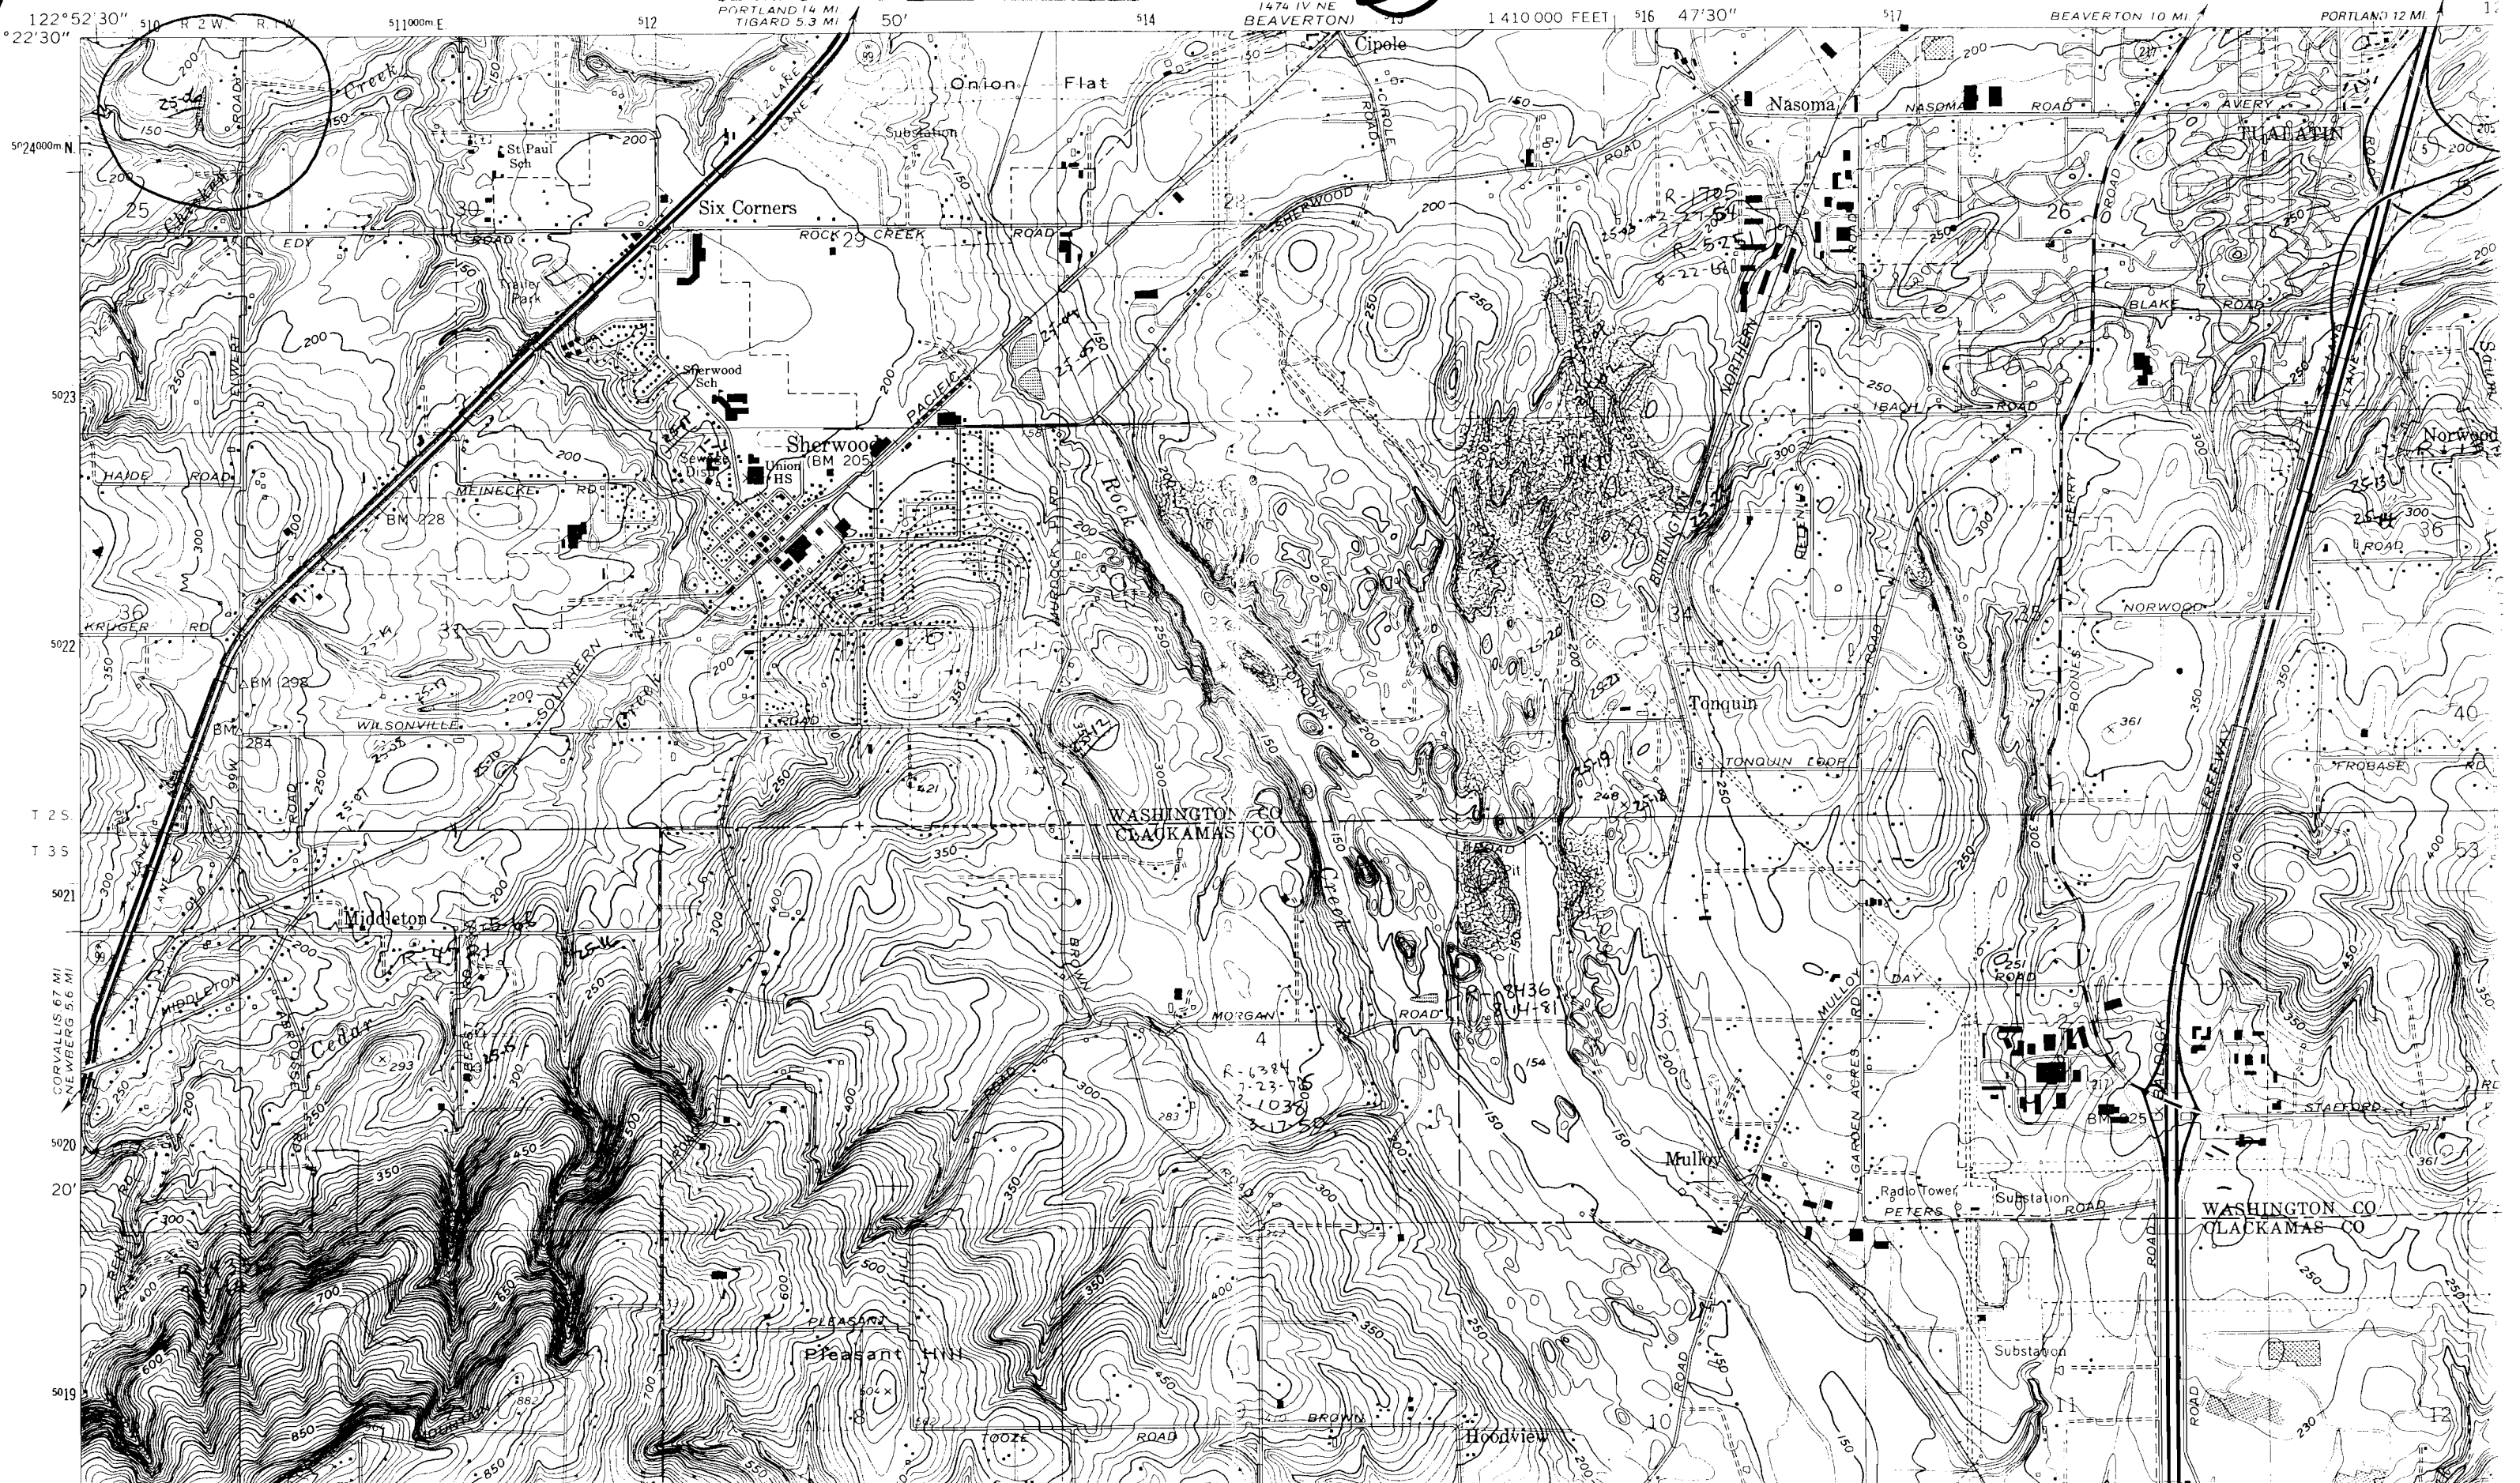

122°52'30" 510 R 2 W R 1 W 511000m E 512 PORTLAND 14 MI TIGARD 5.3 MI 50' 514 1474 IV NE BEAVERTON 15 1 410 000 FEET 516 47'30" 517 BEAVERTON 10 MI PORTLAND 12 MI 17

5024000m N
5023
5022
T 25
T 35
5021
CORVALLIS 6.7 MI NEWBERG 5.6 MI
5020
20
5019

St Paul Sch
Six Corners
Sherwood Sch
Union HS
Sherwood (BM 205)
St Paul Sch
Nasoma
Avery
Thalain
Blake Road
Norwood
Tonquin
Mulloxy
Pleasant Hill
Hoodview
Radio Tower
Substation
Substation

Rock Creek
Cedar
Morgan Road
Mulloxy Road
Nasoma Road
Blake Road
Frobase Rd
Stadford
Peters
Brown

Washington Co
Clackamas Co