


Range 40 E

RECEIVED

DEC 27 1994

WATER RESOURCES DEP
SALEM, OREGON

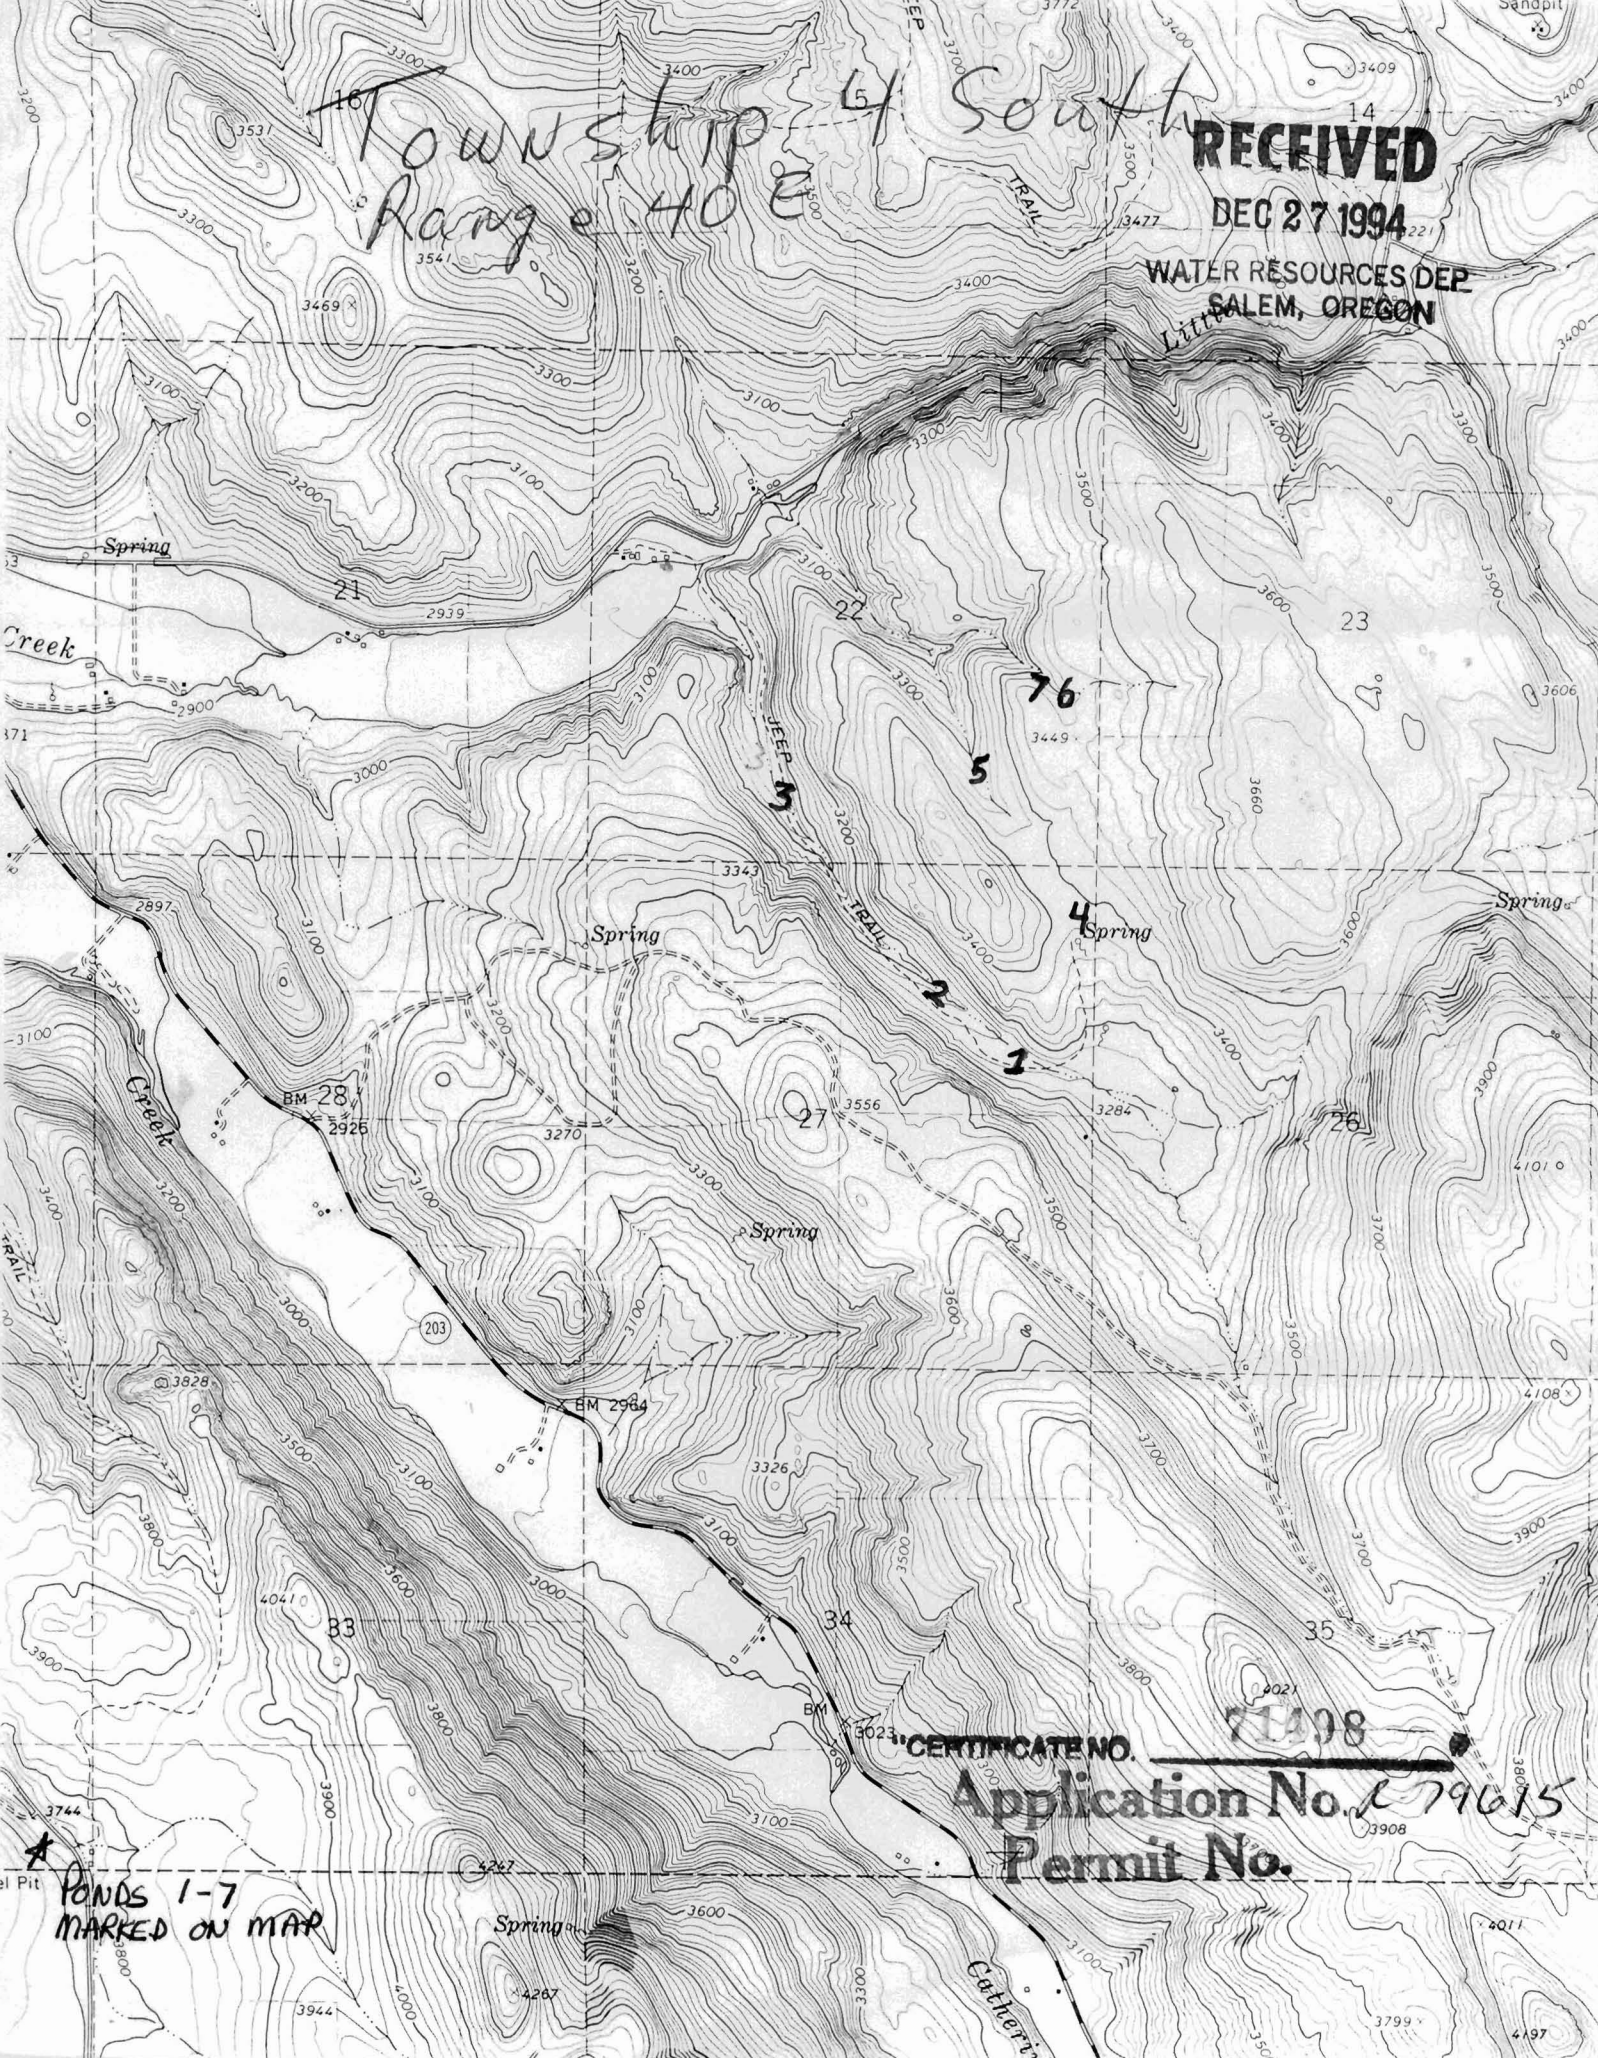

CERTIFICATE NO. 71498
Application No. 179615
Permit No.

* Ponds 1-7
MARKED ON MAP

1 Pit