



Application No **R-29617**
Permit No.

COLEMAN JOINT QUADRANGLE
OREGON-LAKE CO.
7.5 MINUTE SERIES (TOPOGRAPHIC)

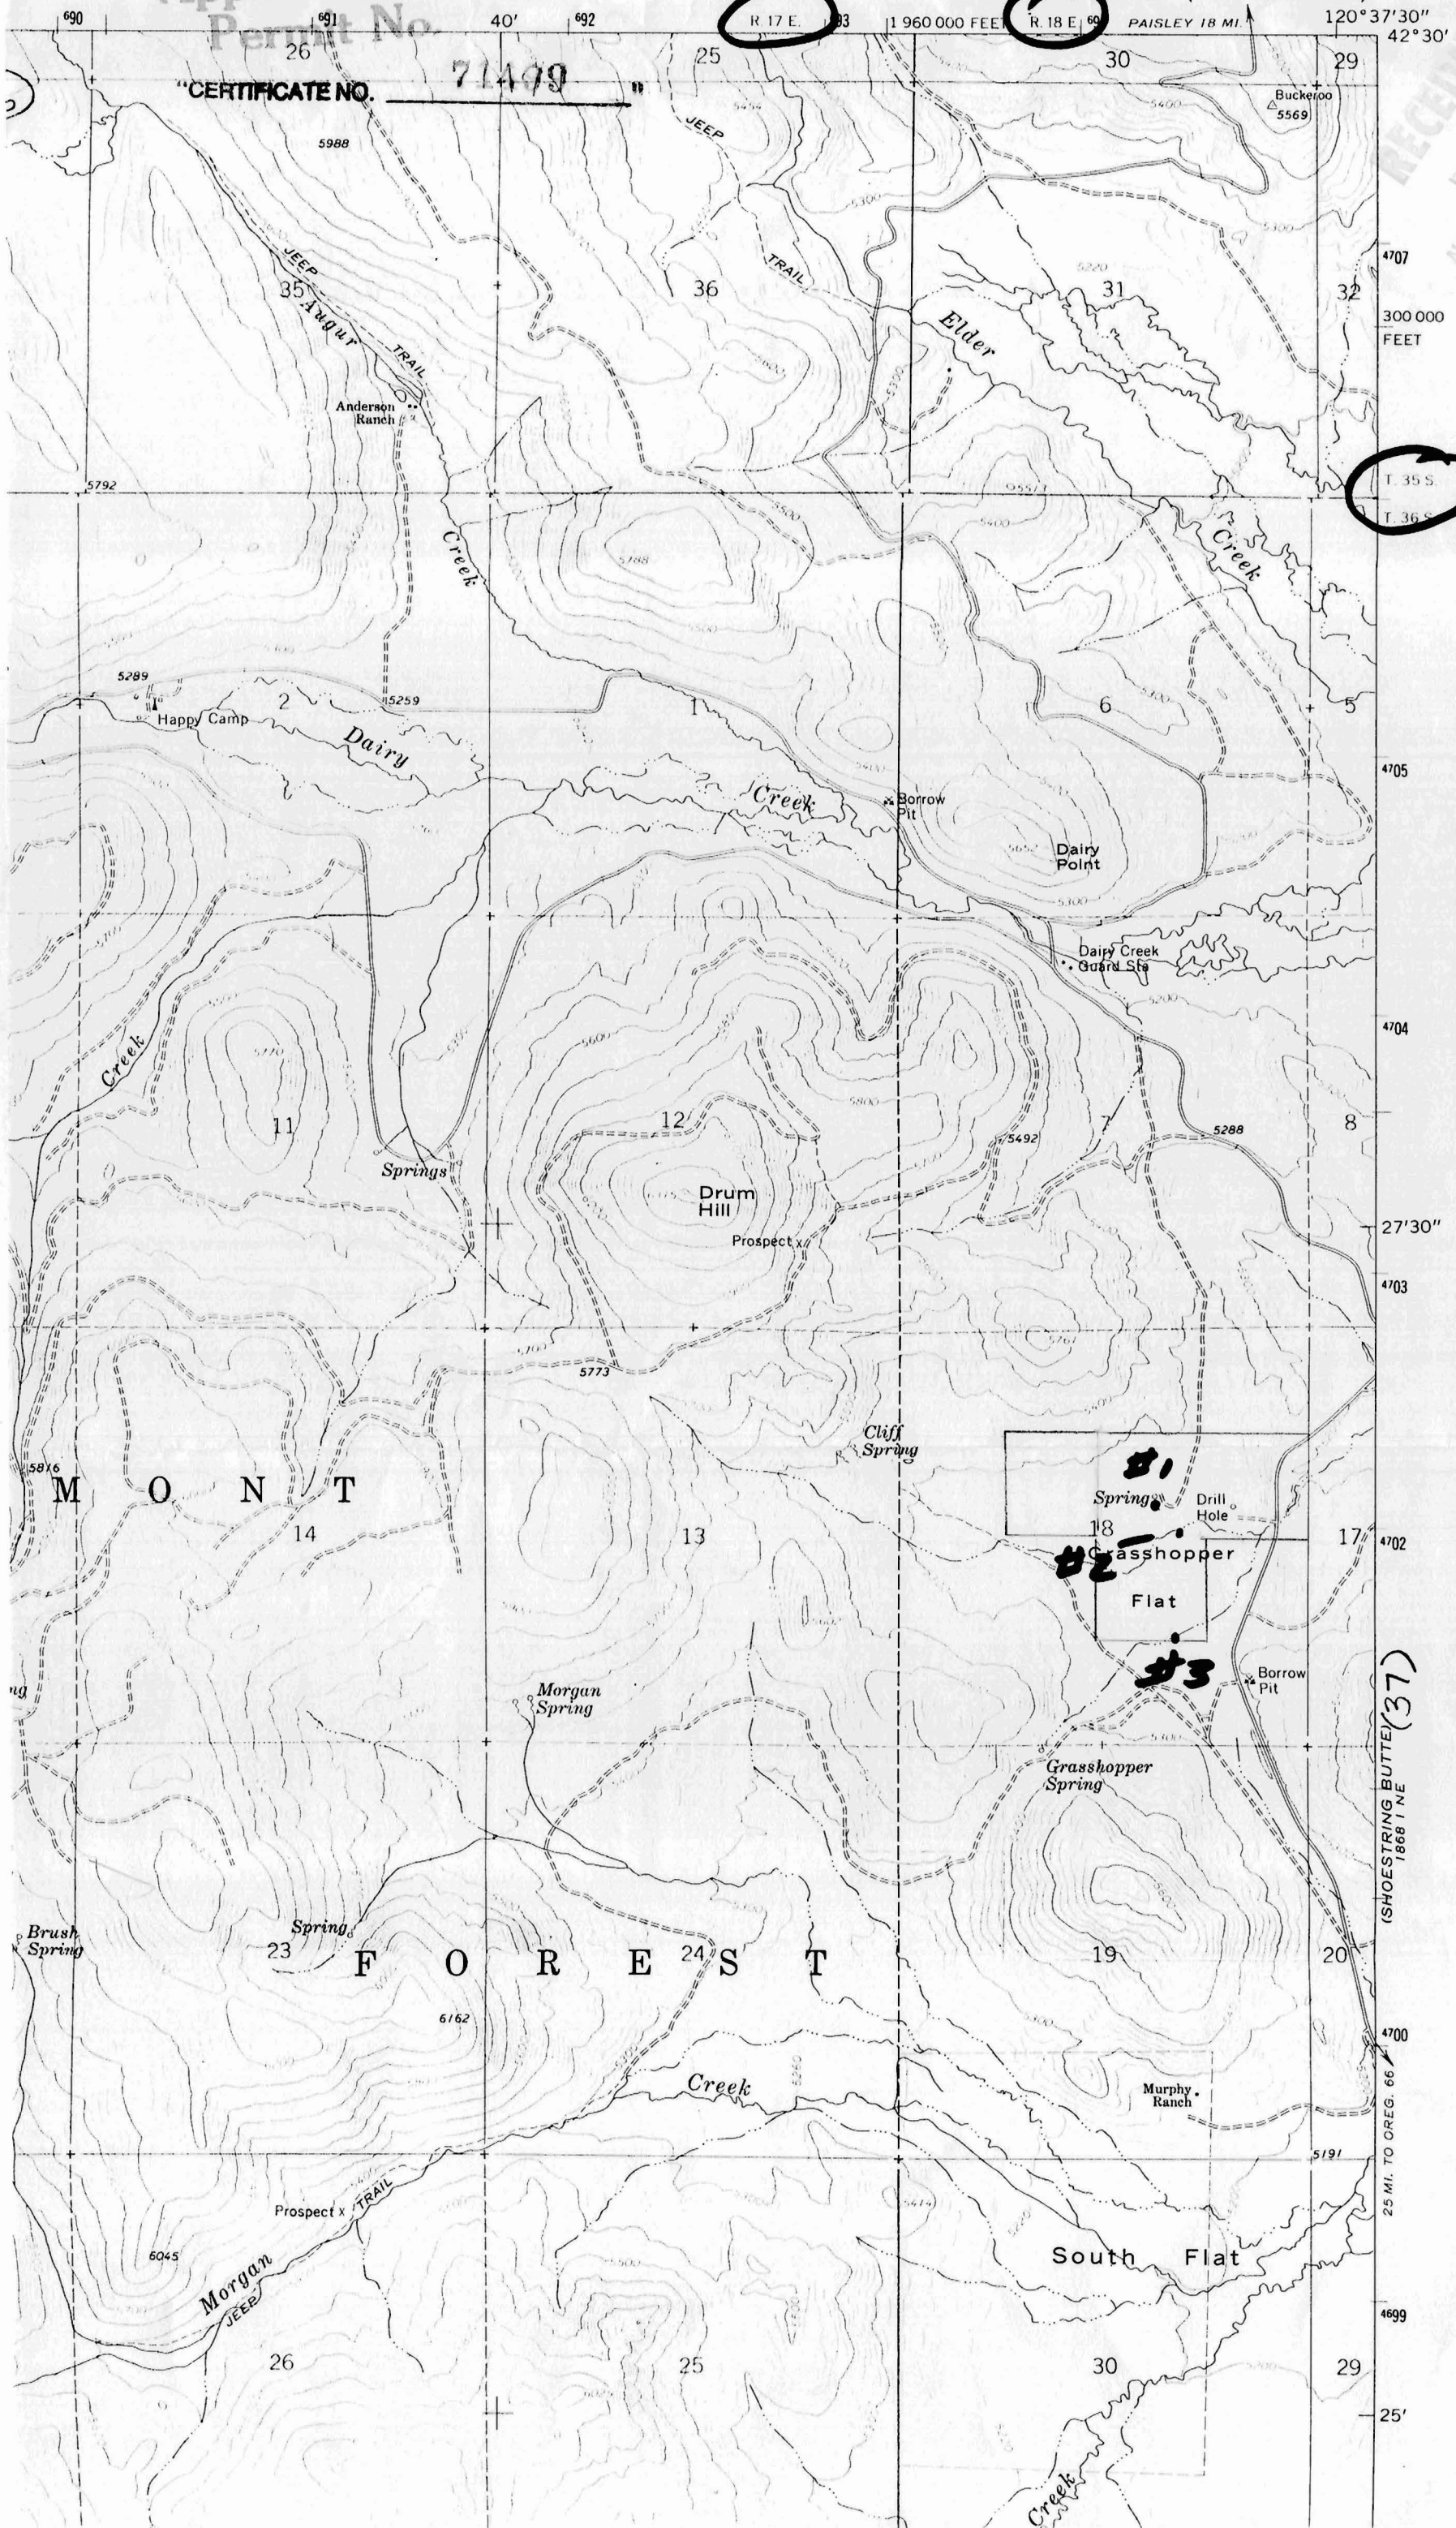

RECEIVED
DEC 23 1964
WATER RESOURCES DEPT.
SALEM, OREGON

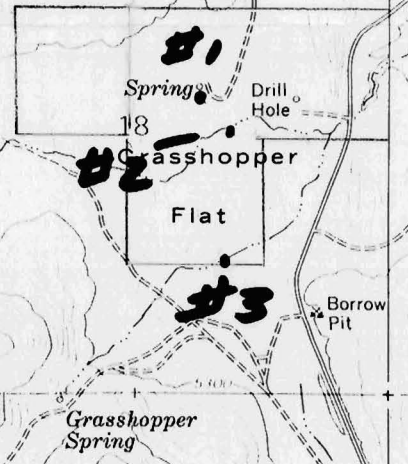

(SHOESTRING BUTTE) (37)
1868 1 NE