


7-501

"CERTIFICATE NO. _____"

SEE MAP 5S 10 5

Application No. R 79631
Permit No. _____

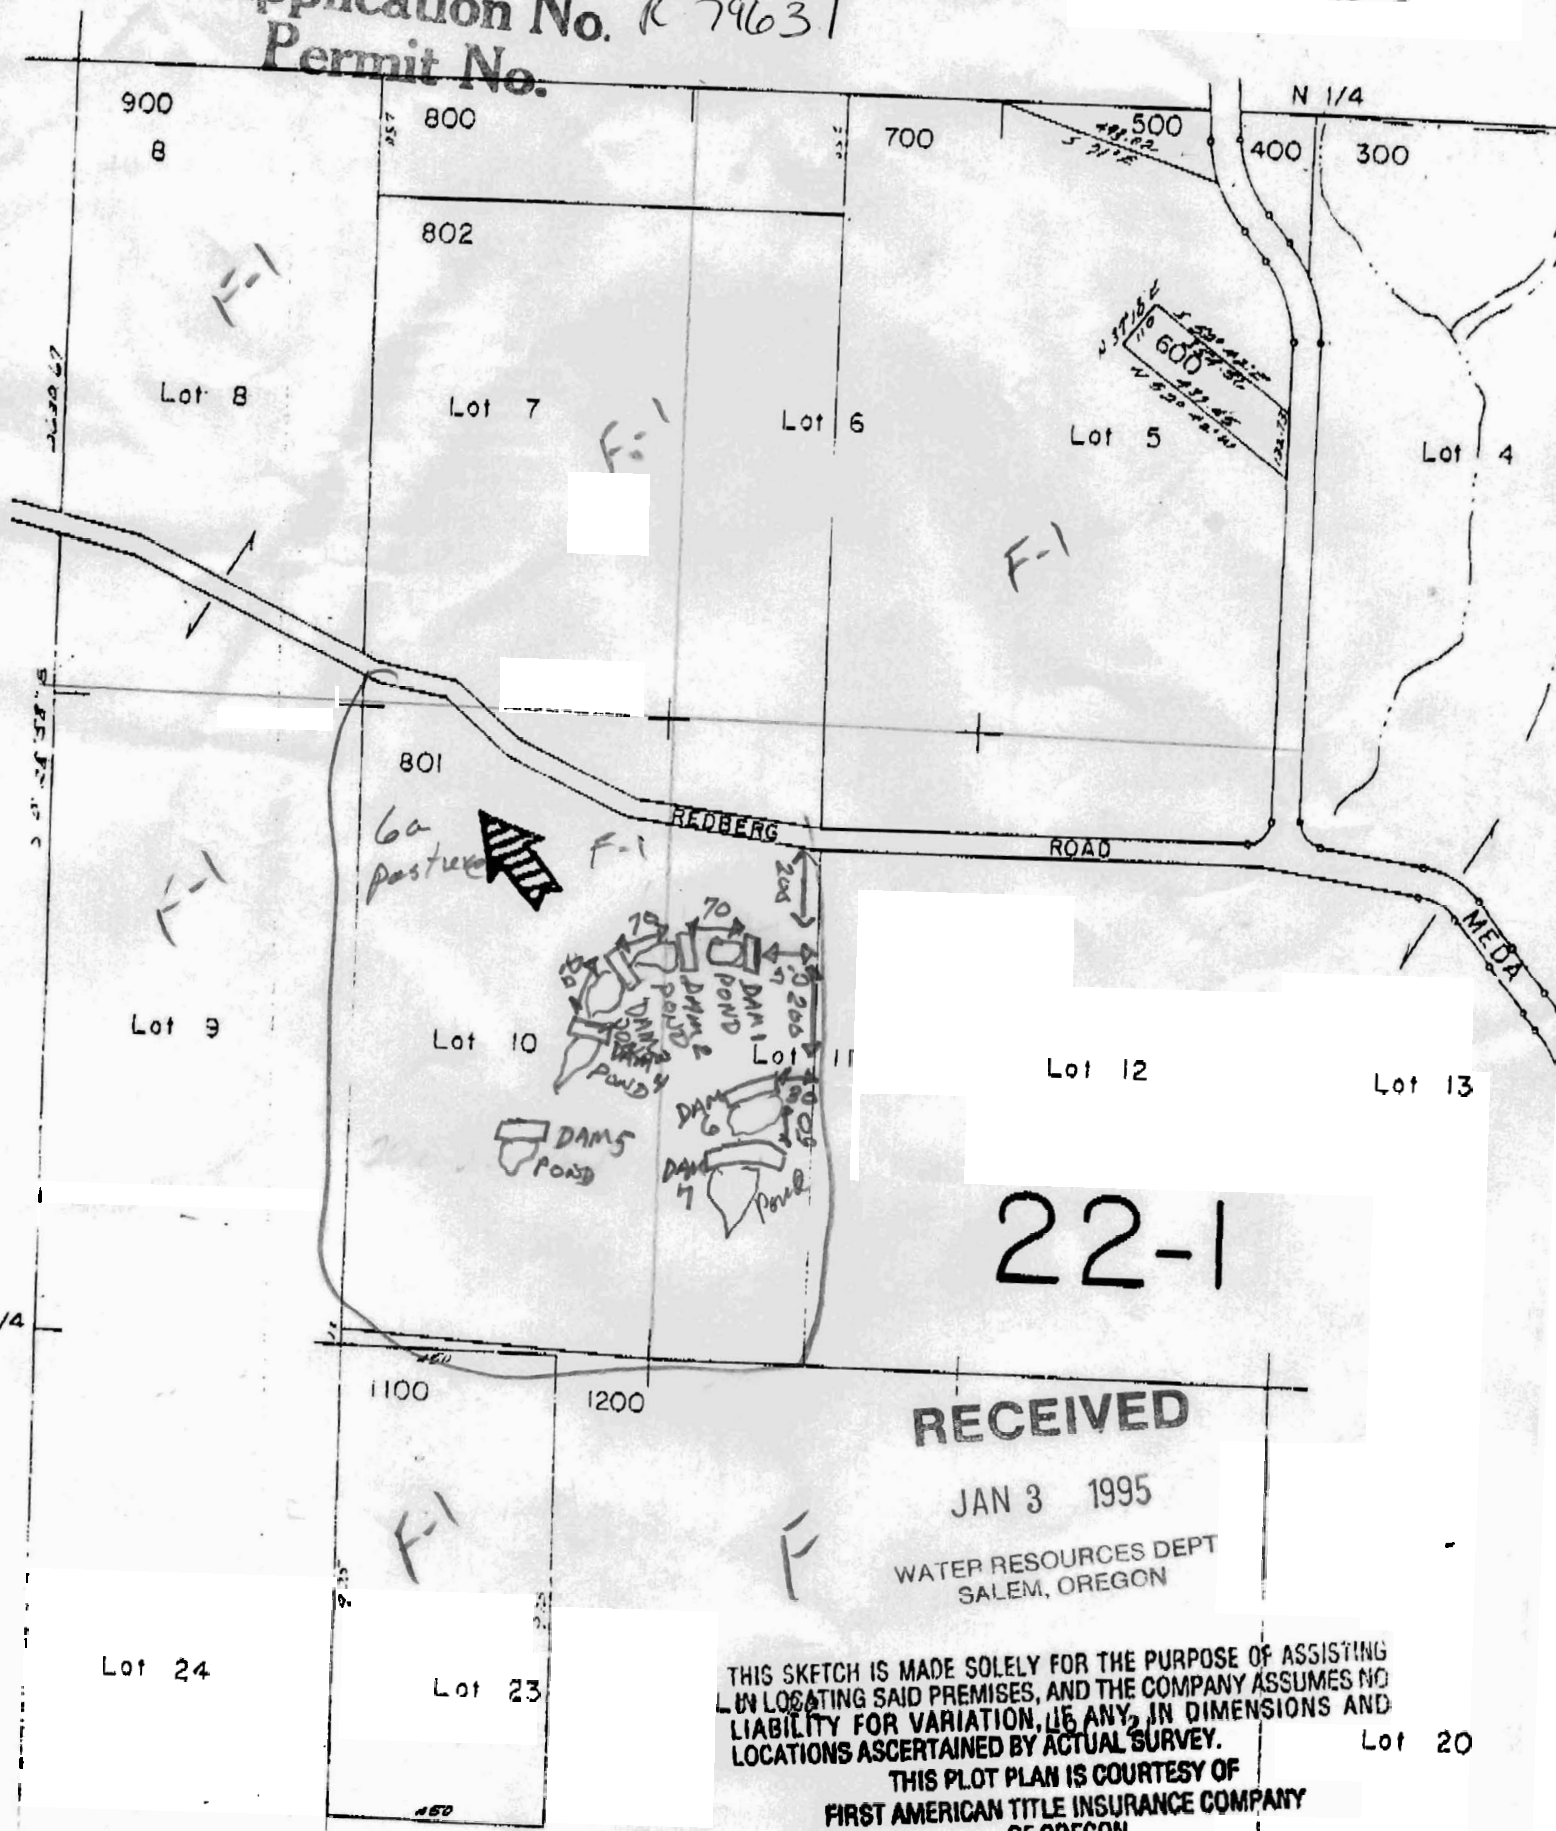

RECEIVED

JAN 3 1995

WATER RESOURCES DEPT
SALEM, OREGON

THIS SKETCH IS MADE SOLELY FOR THE PURPOSE OF ASSISTING
IN LOCATING SAID PREMISES, AND THE COMPANY ASSUMES NO
LIABILITY FOR VARIATION, IF ANY, IN DIMENSIONS AND
LOCATIONS ASCERTAINED BY ACTUAL SURVEY.

THIS PLOT PLAN IS COURTESY OF
FIRST AMERICAN TITLE INSURANCE COMPANY
OF OREGON

5 S 10 8