

Powerline Pond #1
T2S R 36E



CERTIFICATE NO. 71506 Application No. R-79660
Permit No.

R. 79660

#55


WALDO W. WHITE

ARTIO

Fender Pond #4

T2S R36E

R. 79660

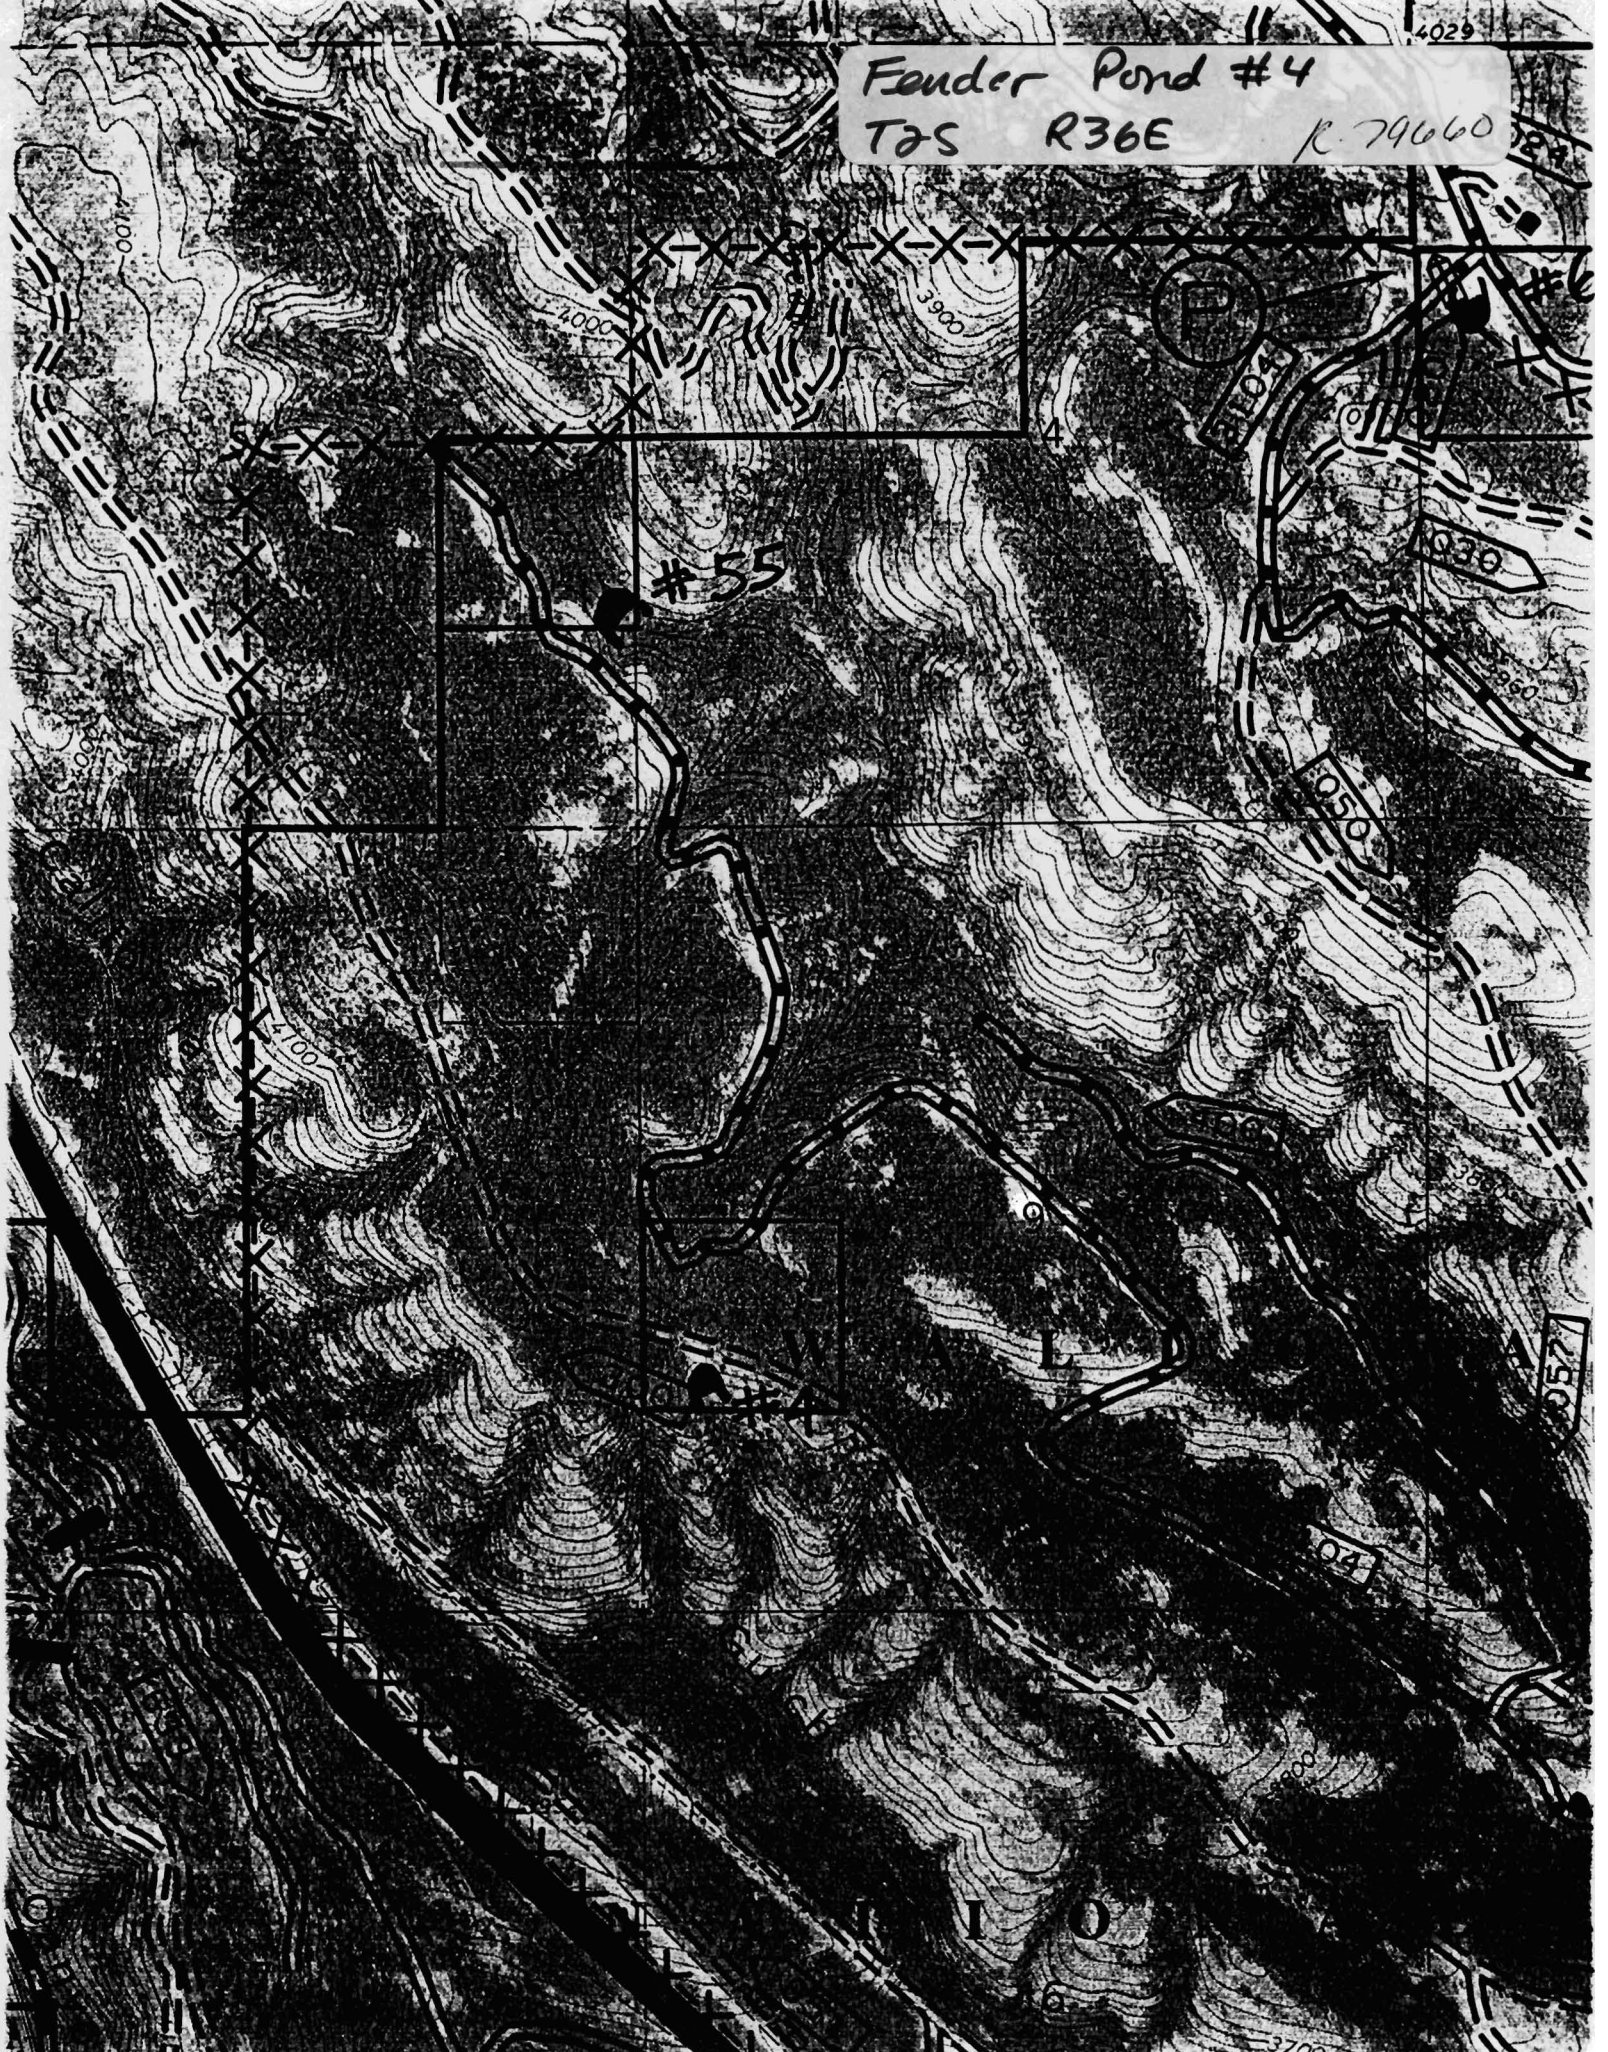

Application No. R-79660


Permit No.

CERTIFICATE NO.

71506

Lodgepole Pond #6

T2S R 36E

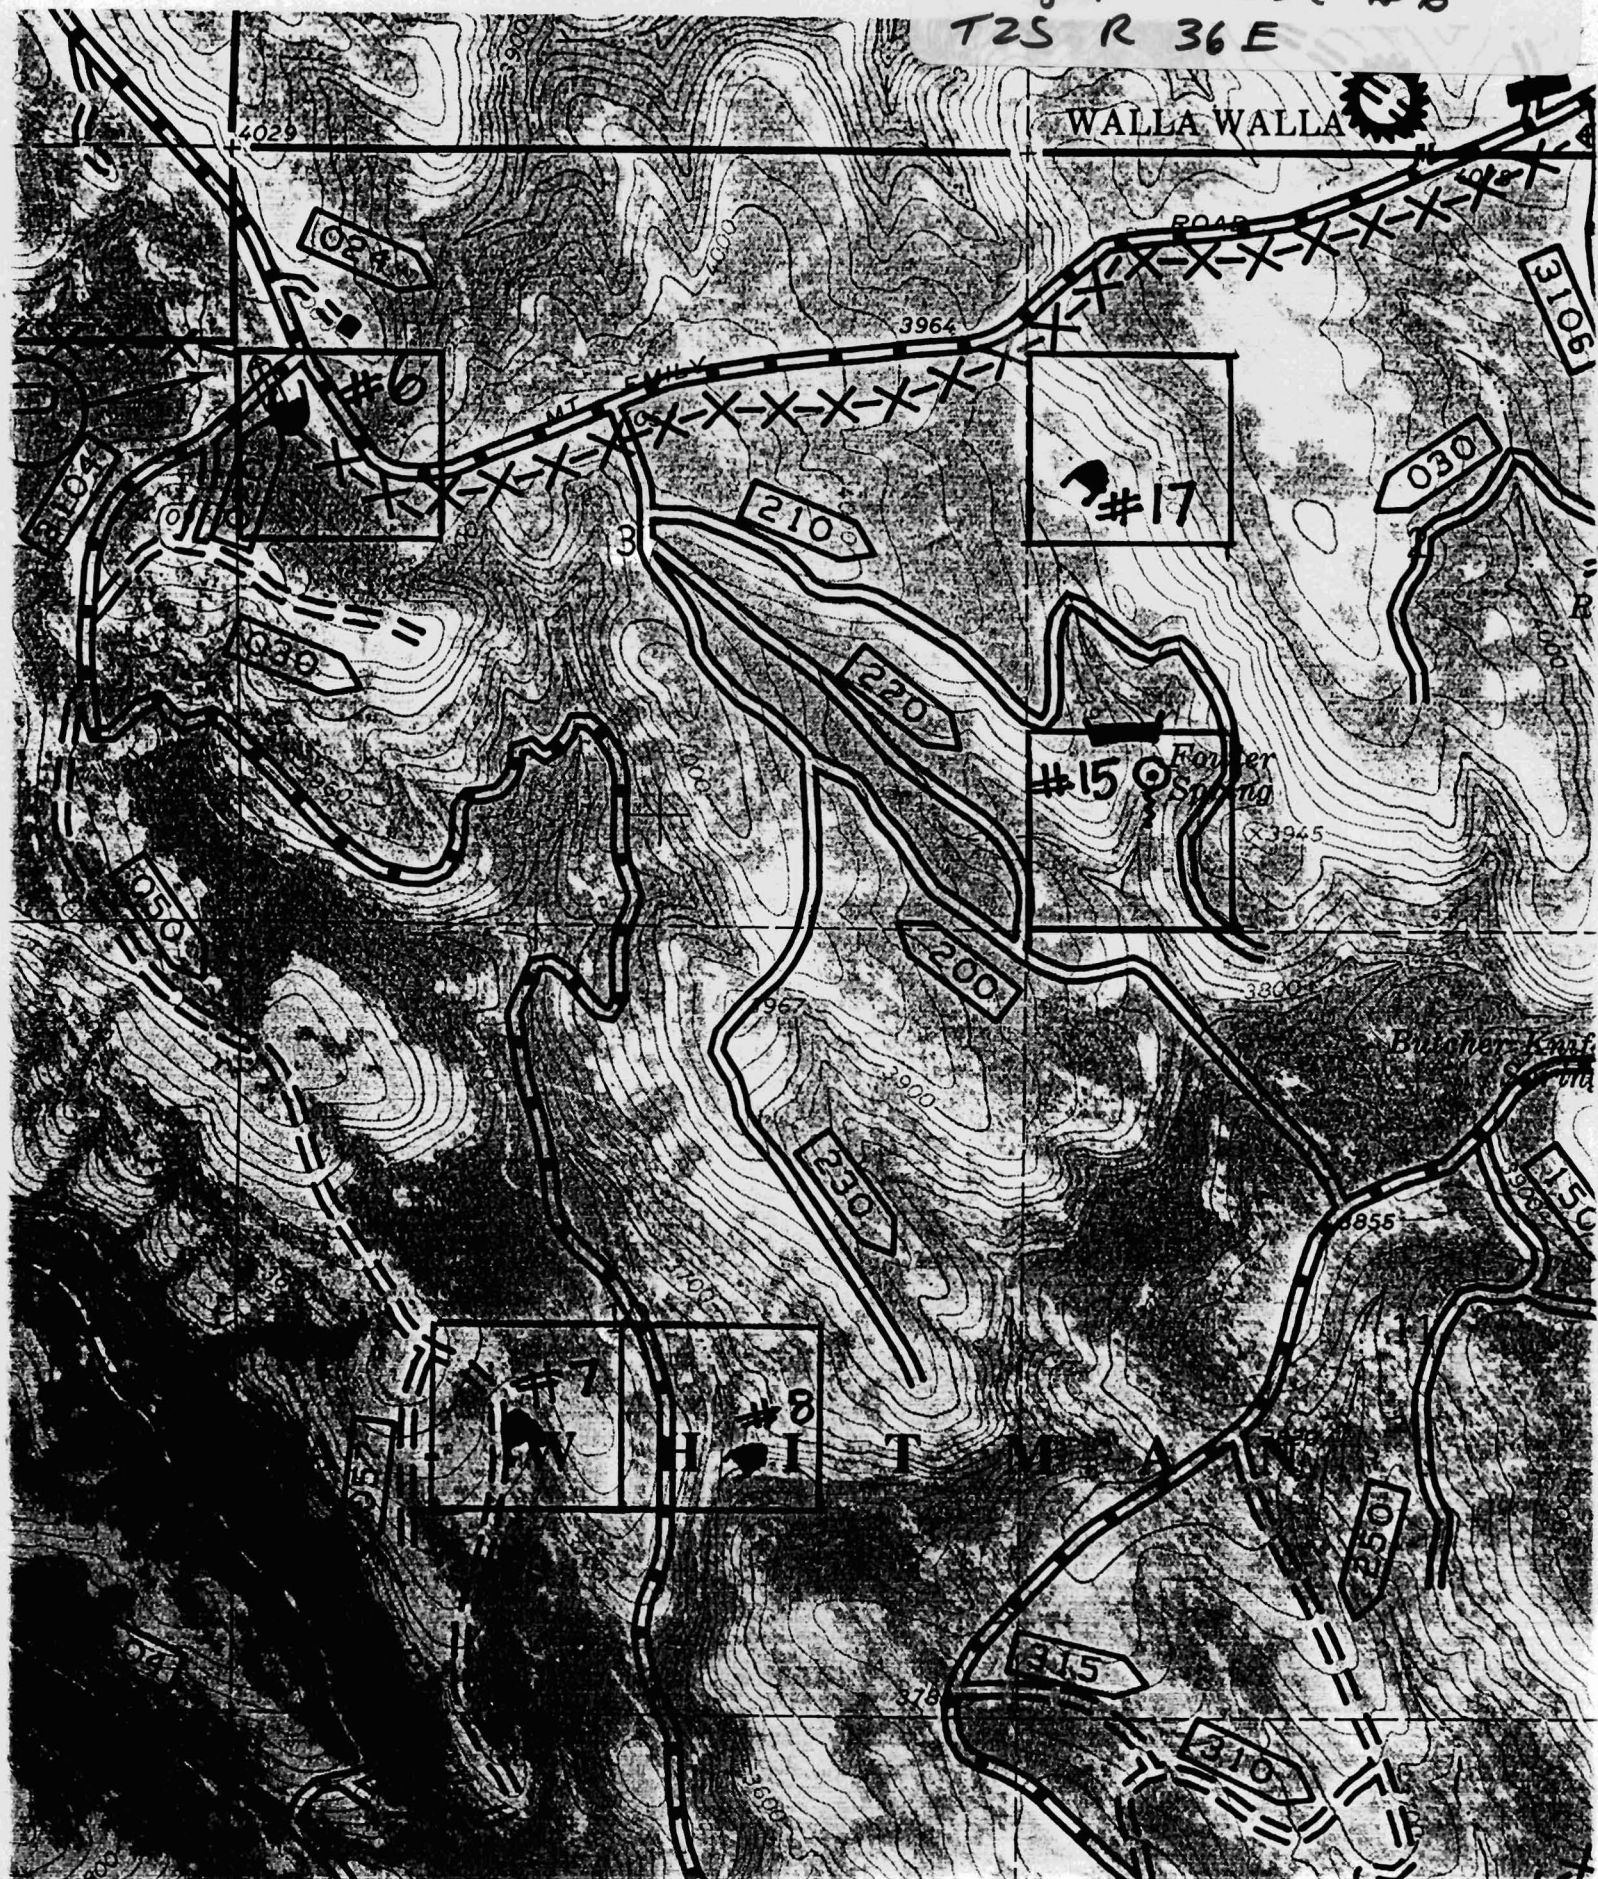

Application No. R 79660


Permit No.

Red Pond #7


T2S R36E

"CERTIFICATE NO.

71506 "

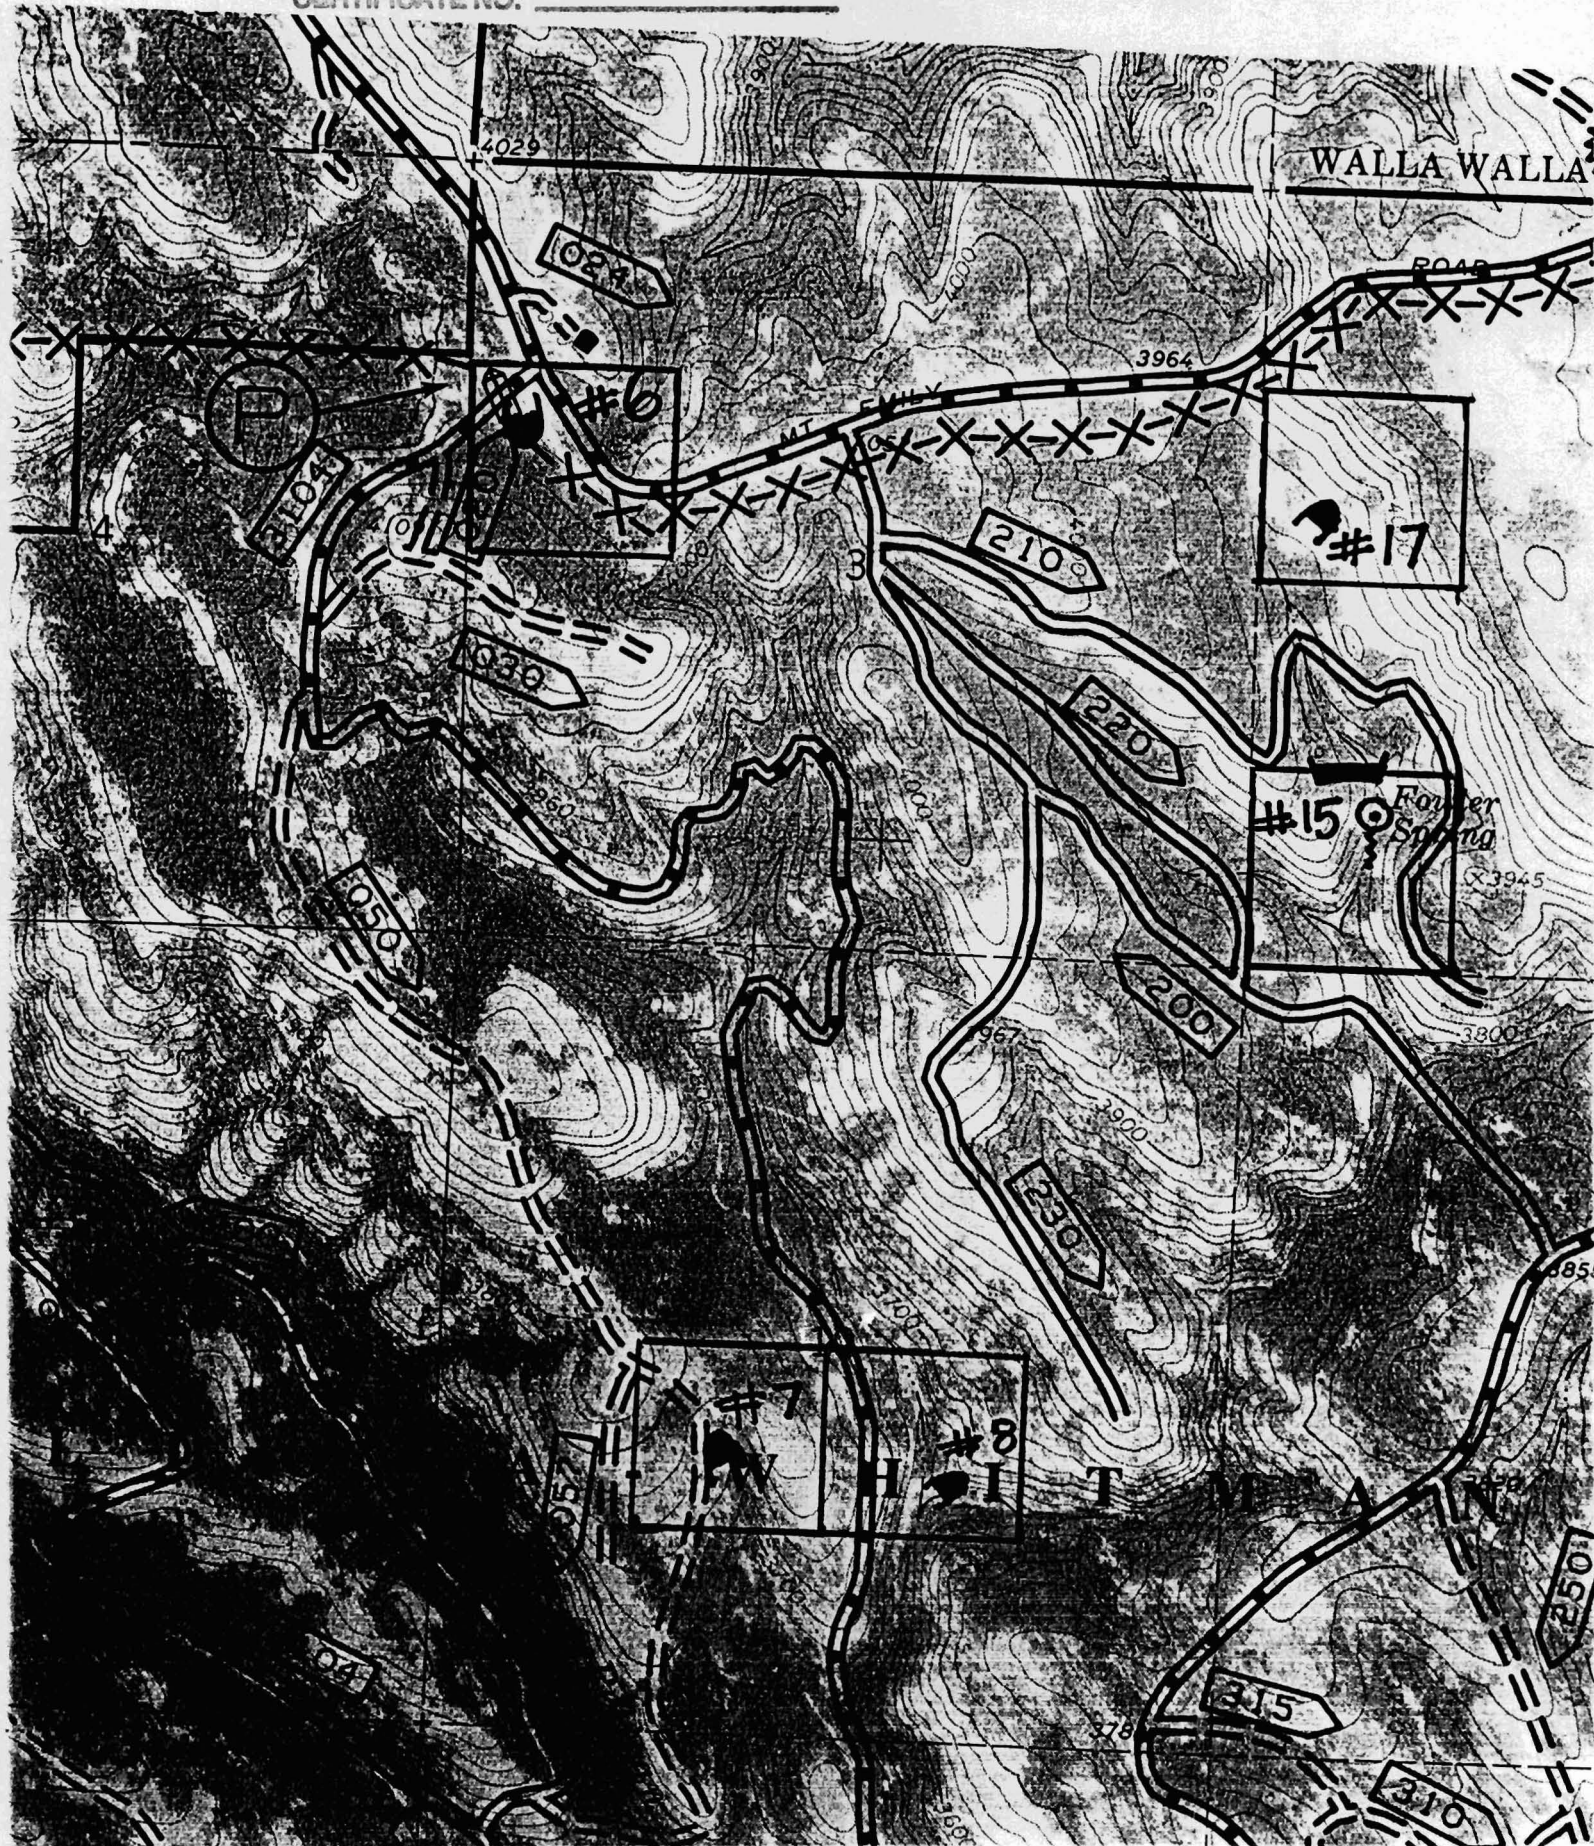

Butcher Knife
Farmer Jack Pond #9
T2S R36E

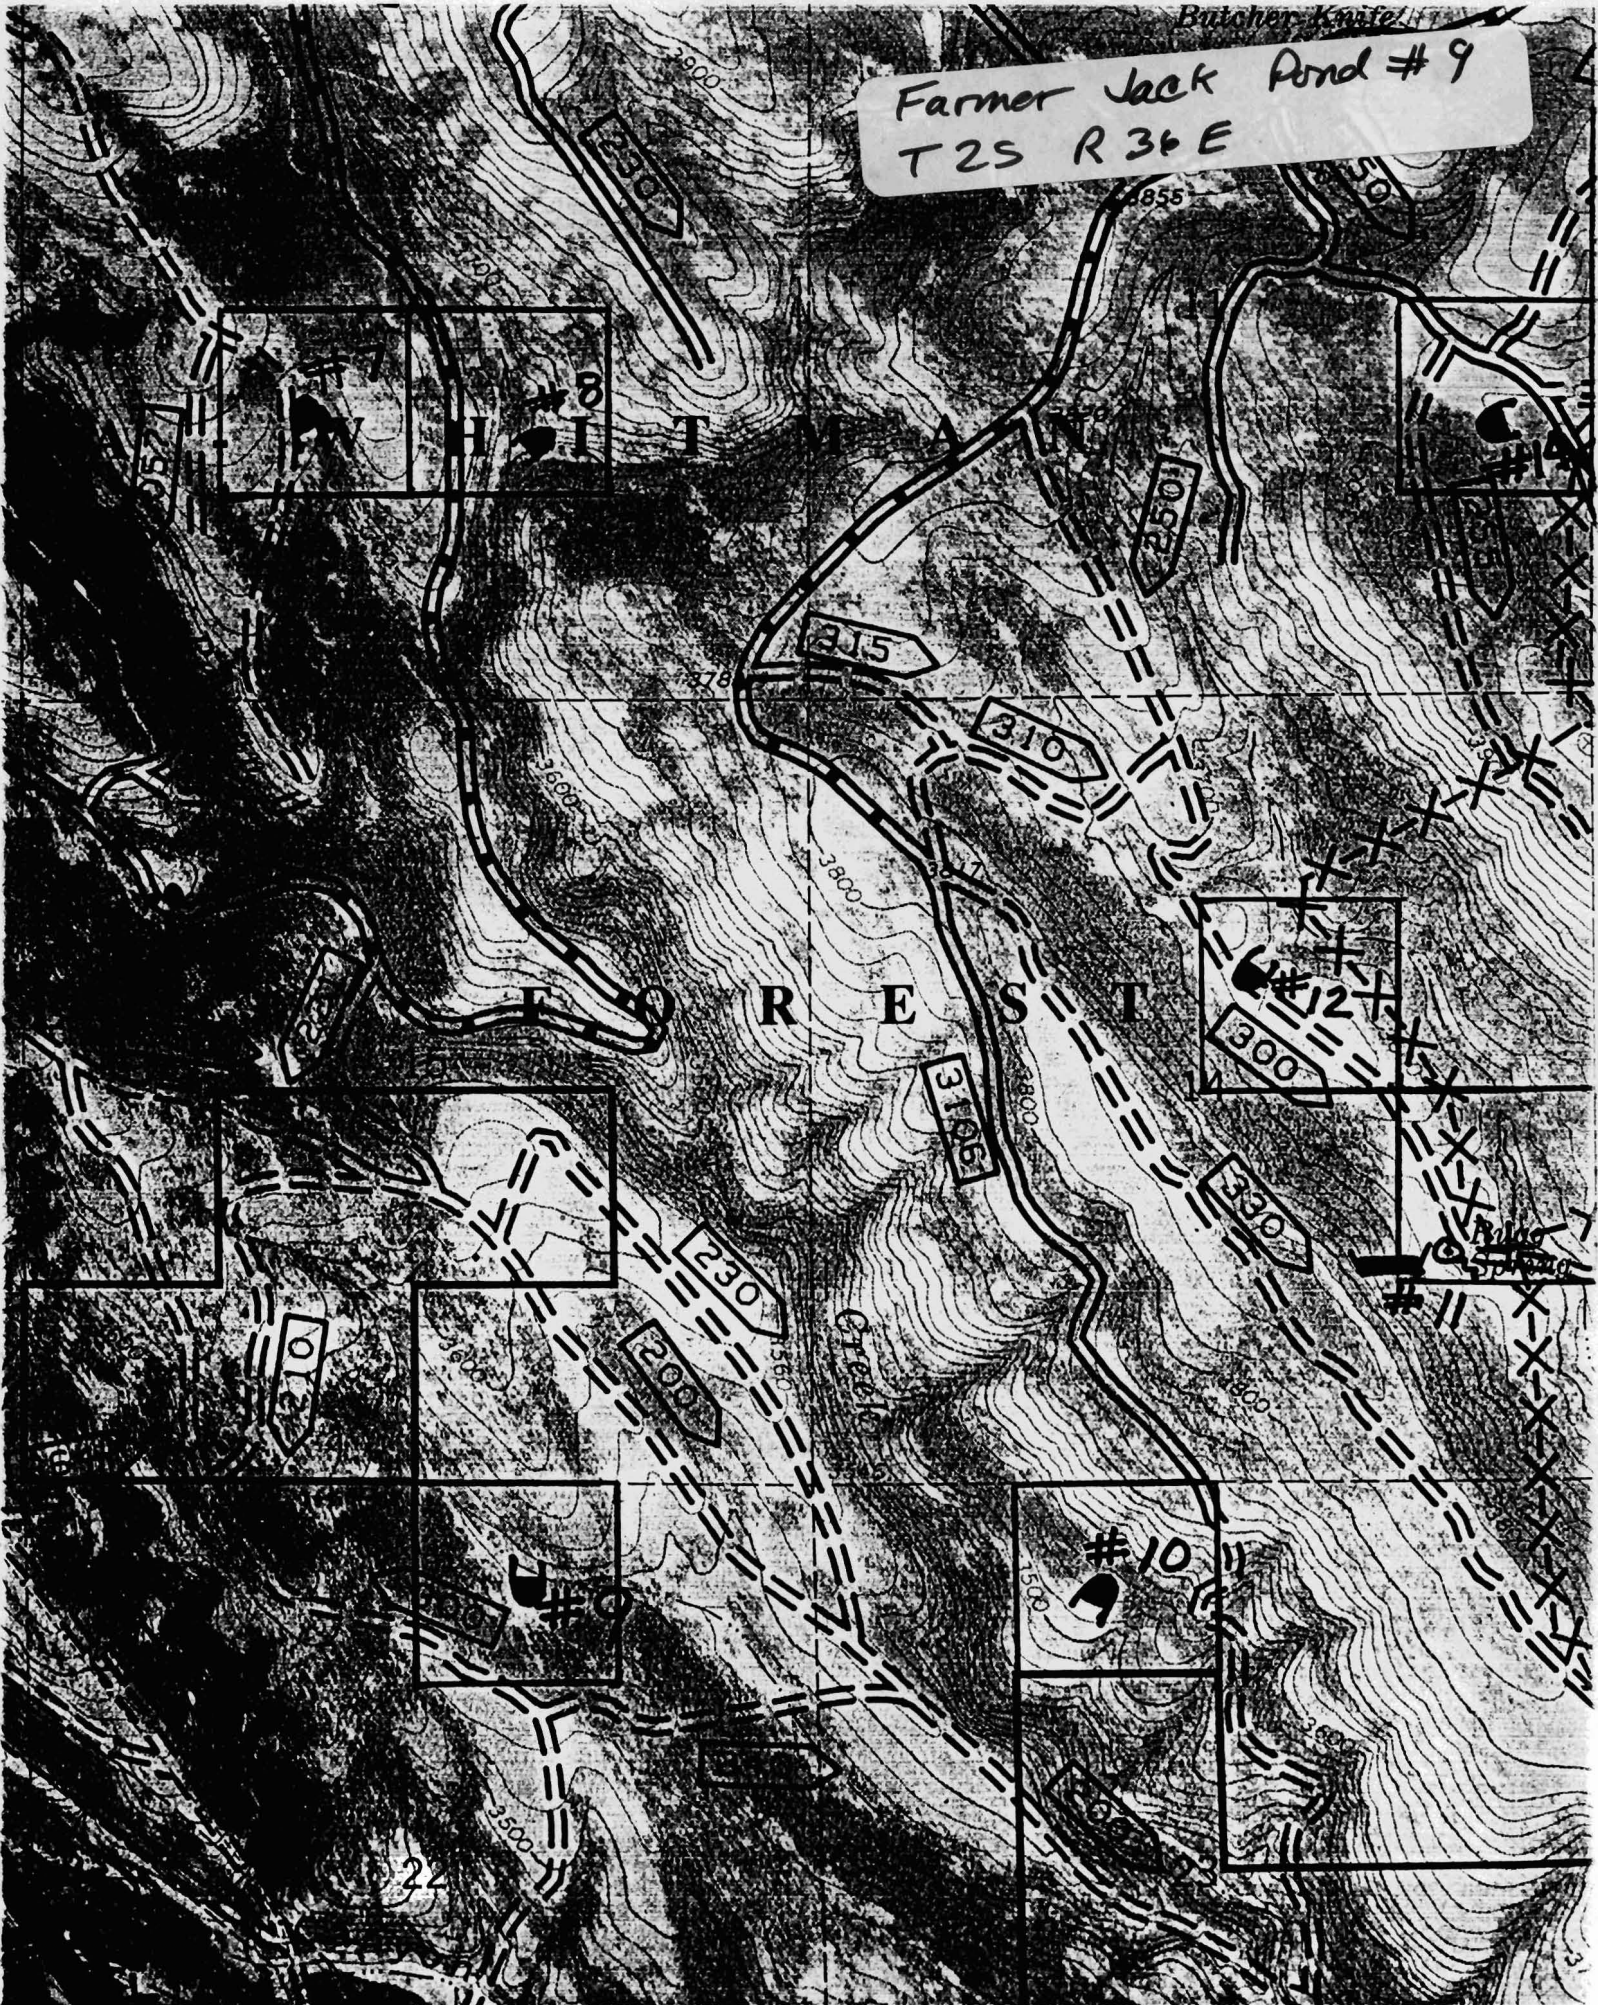

CERTIFICATE NO. 71506


R 79660

Trail Pond #10


T 2S

R 36E

R. 79660

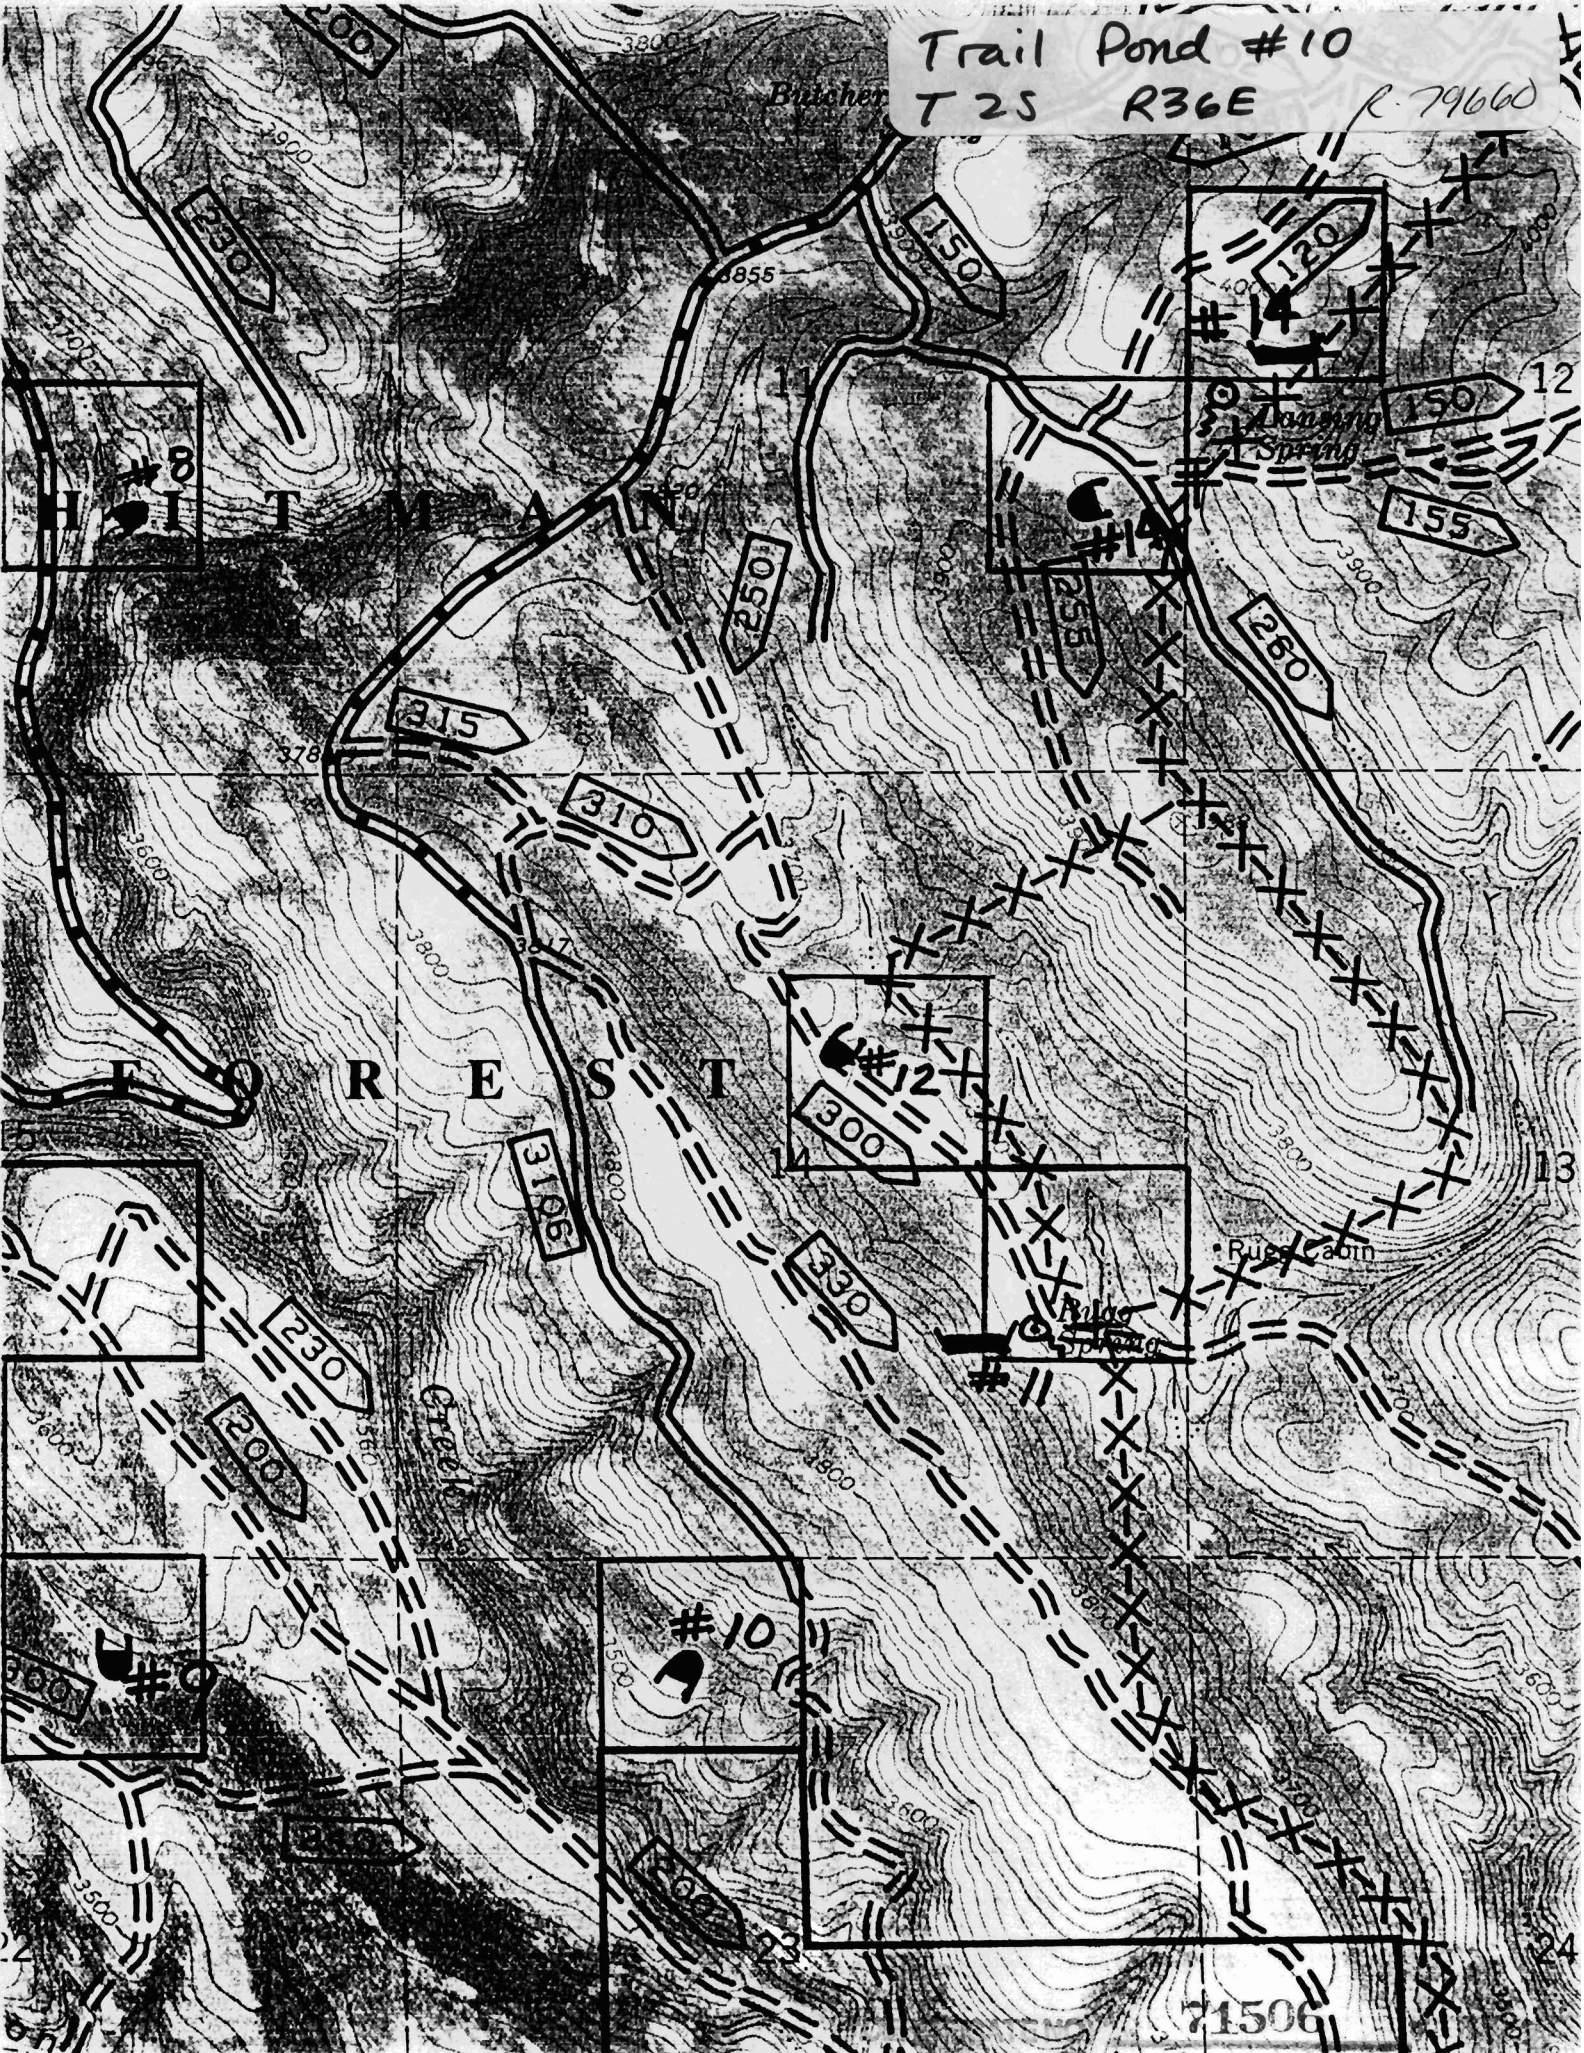

Rugg Pond #12
T 2S R 36E R. 79600

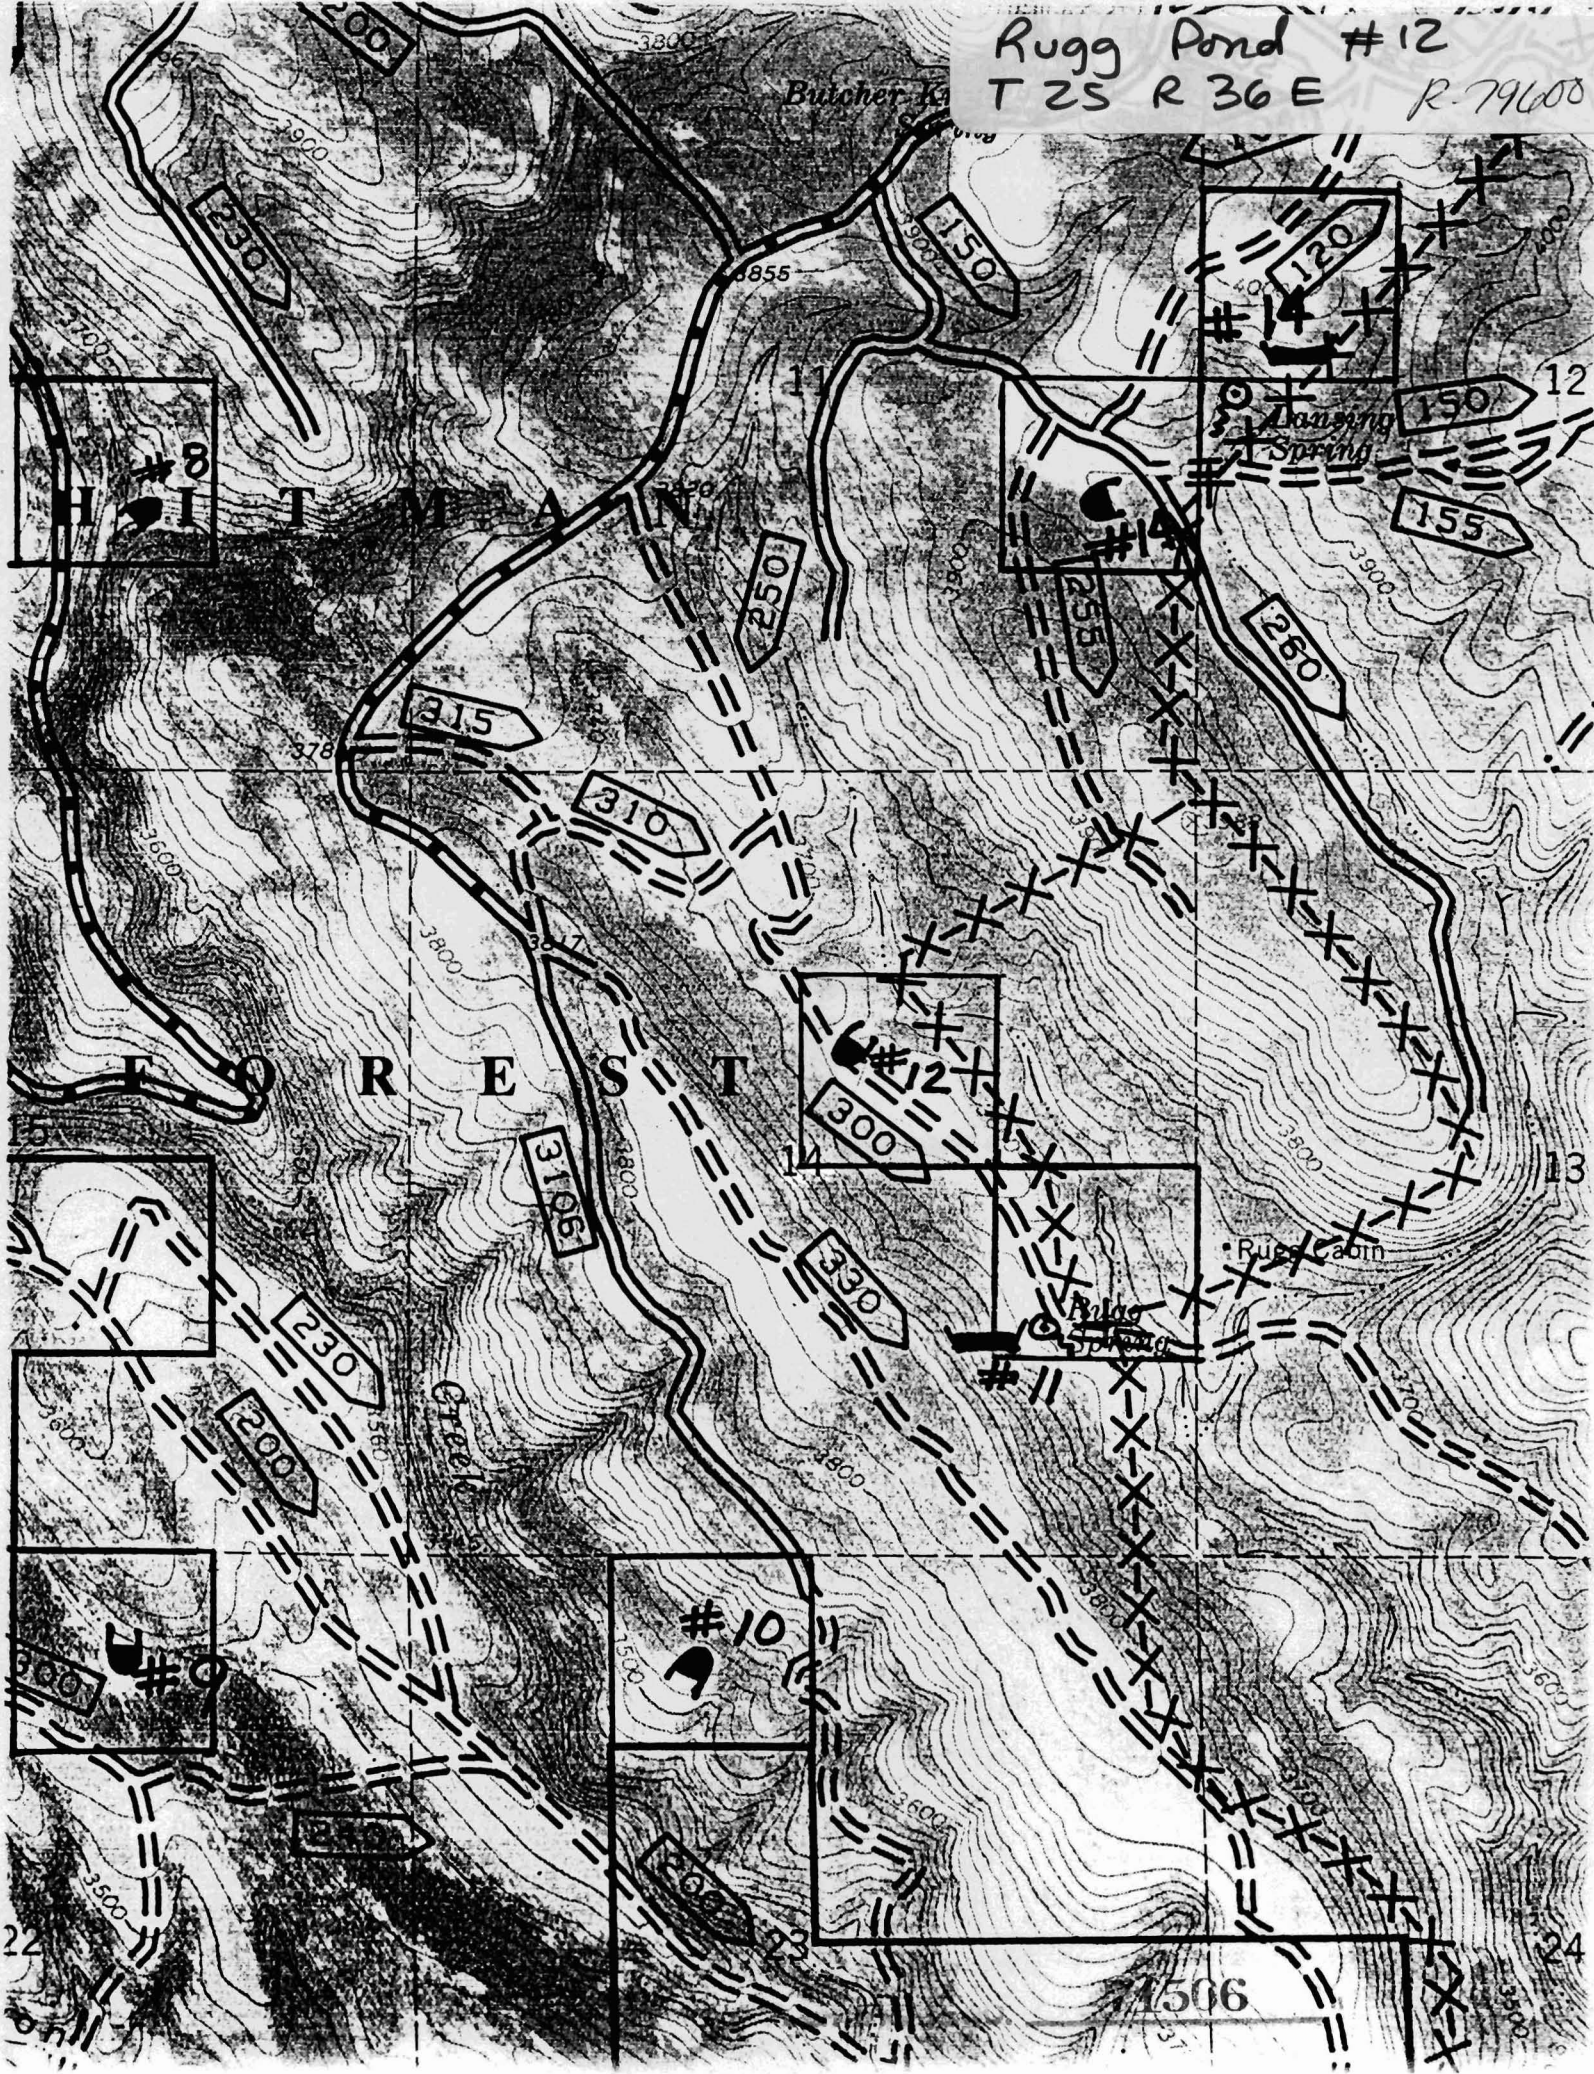

Lausling Pond #14

T2S R36E

R. 79600

