



Penny Spring #3
T4S R 35 E


R. 79661

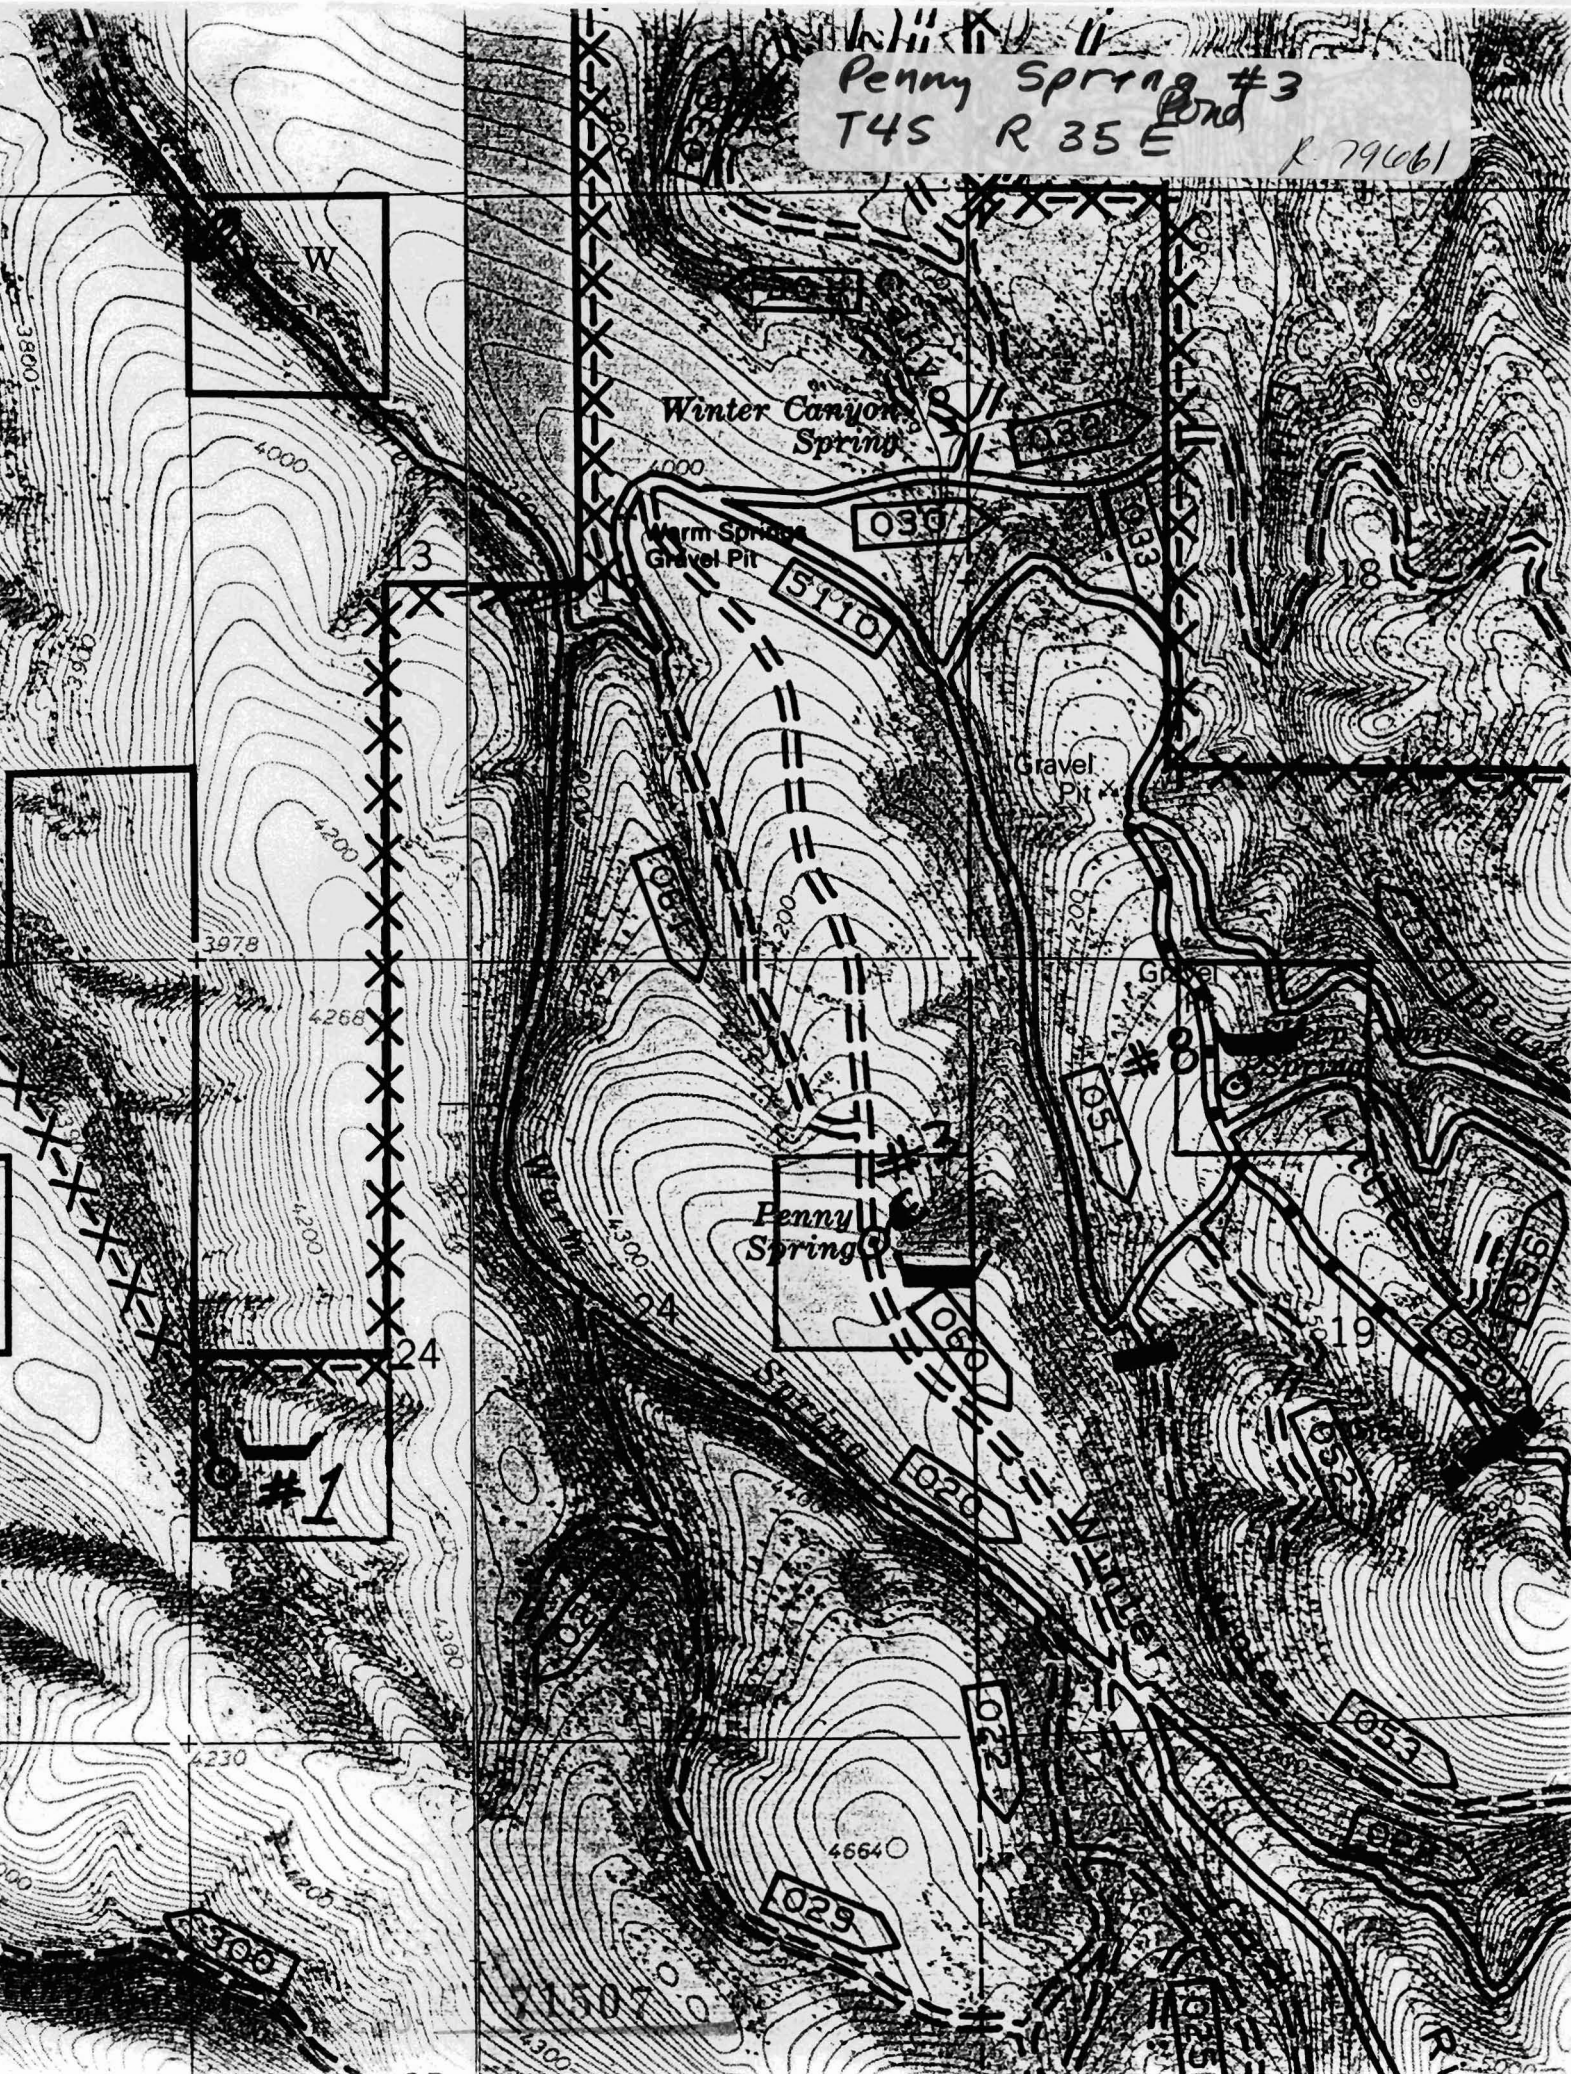


Saddle Camp Sp. Pond #6
T4S R 36E (R 79661)

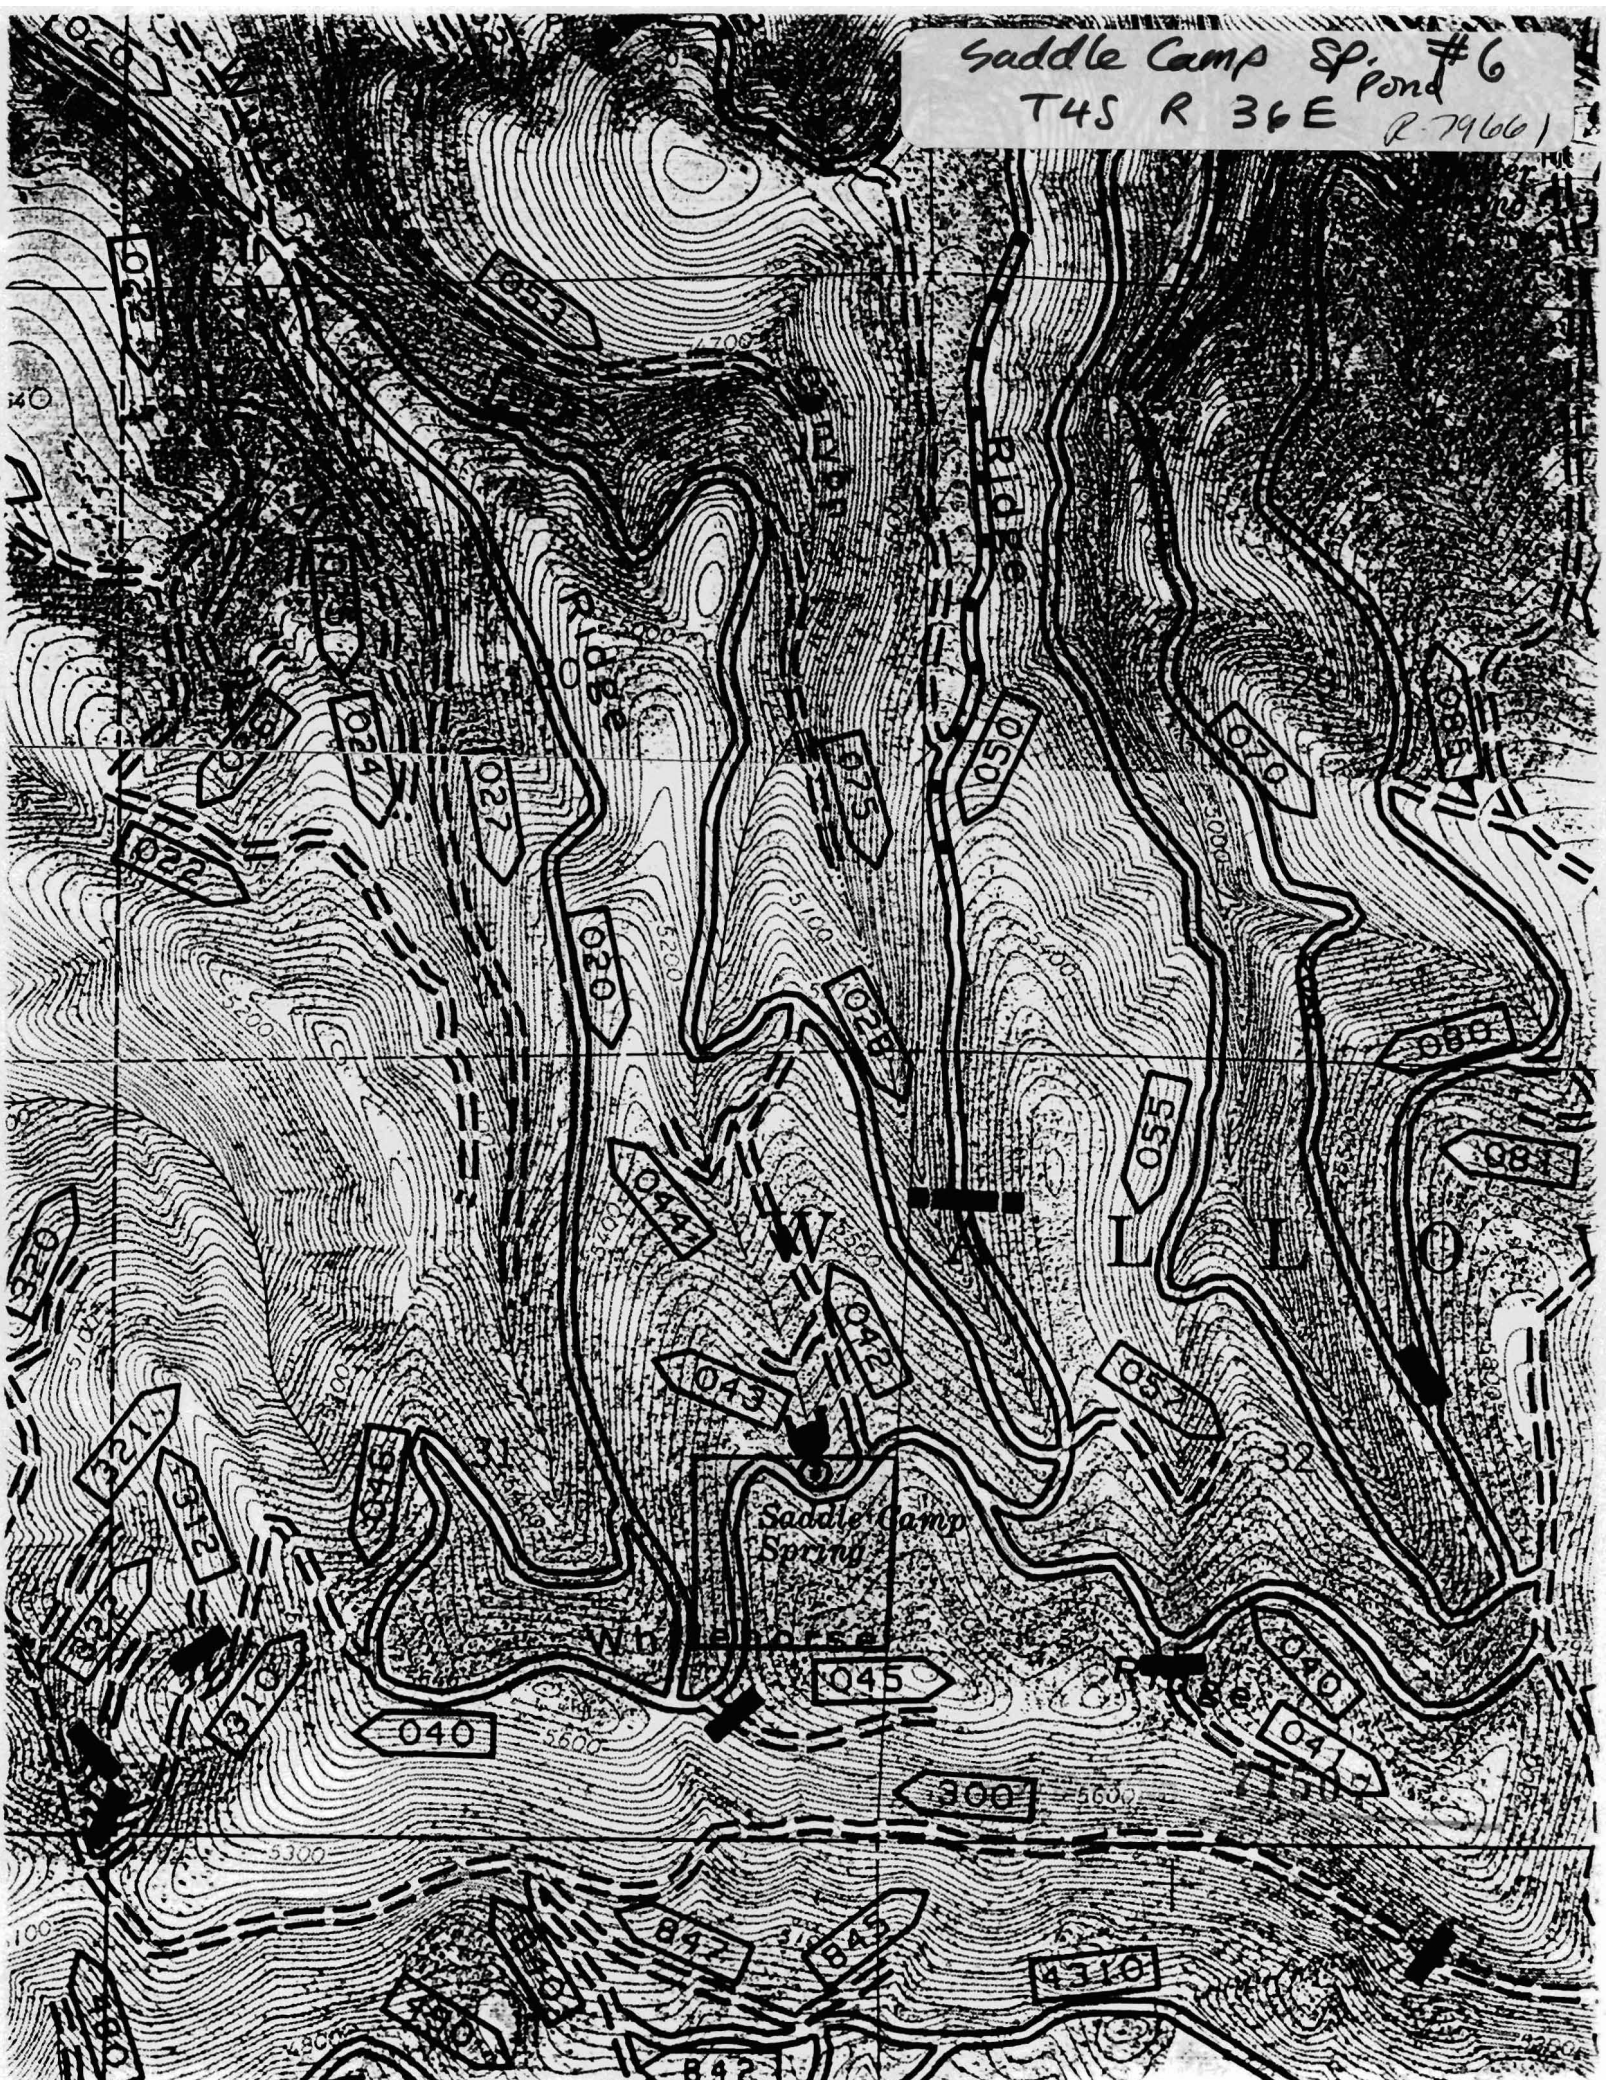


R. 79661

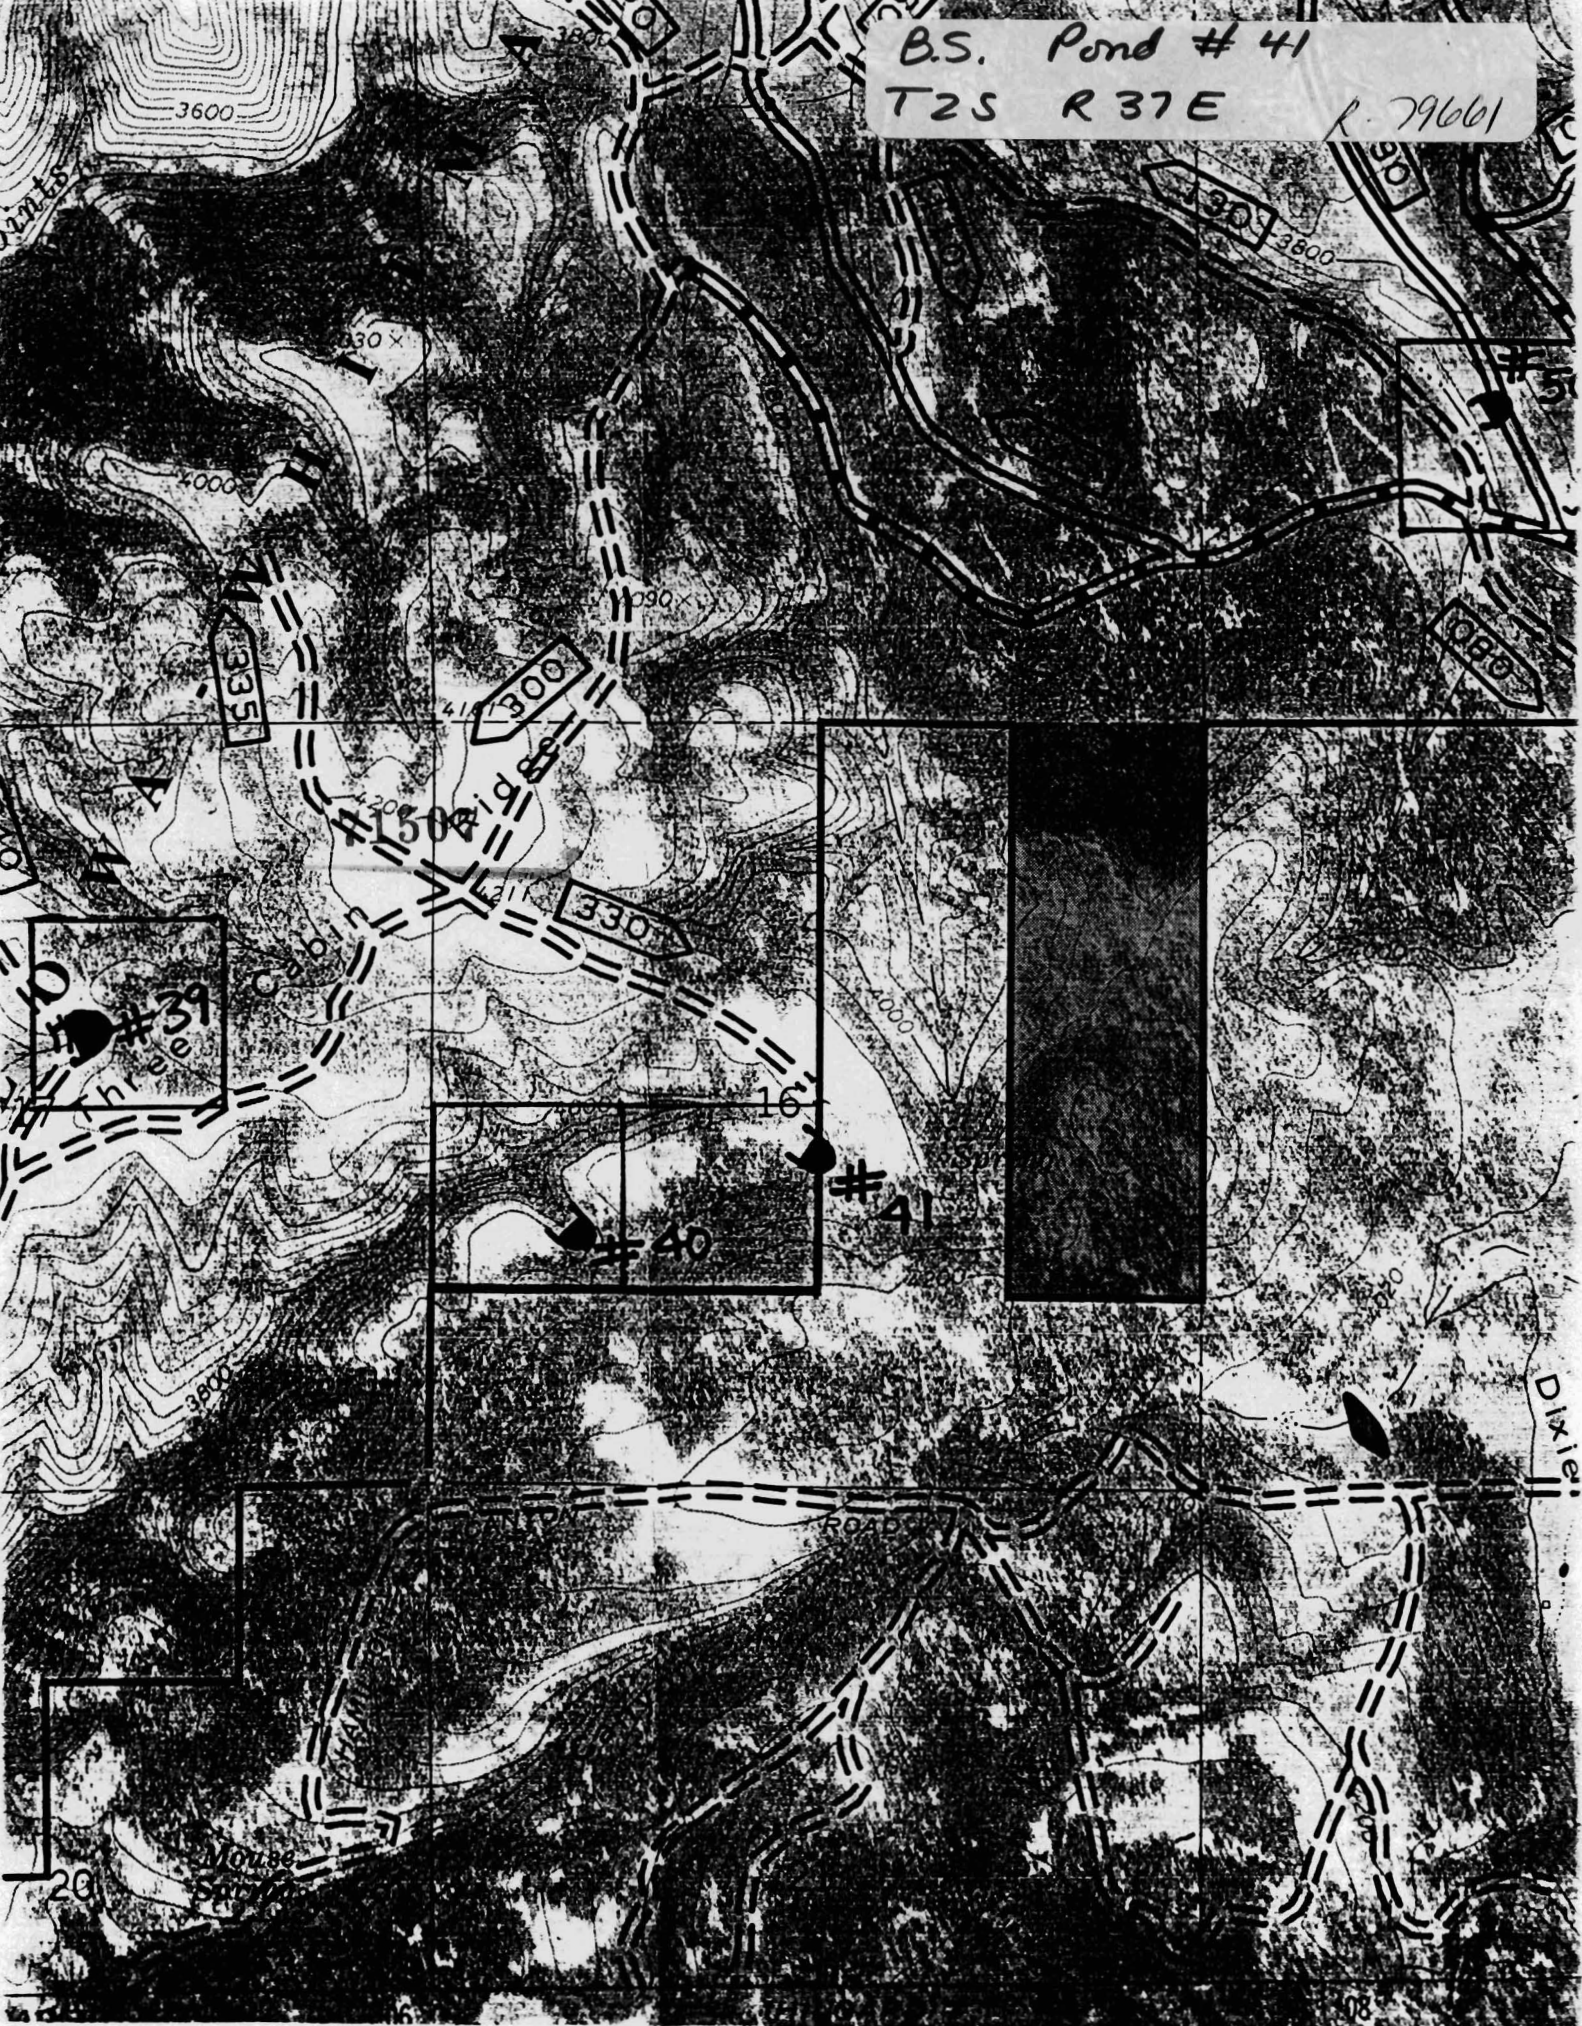

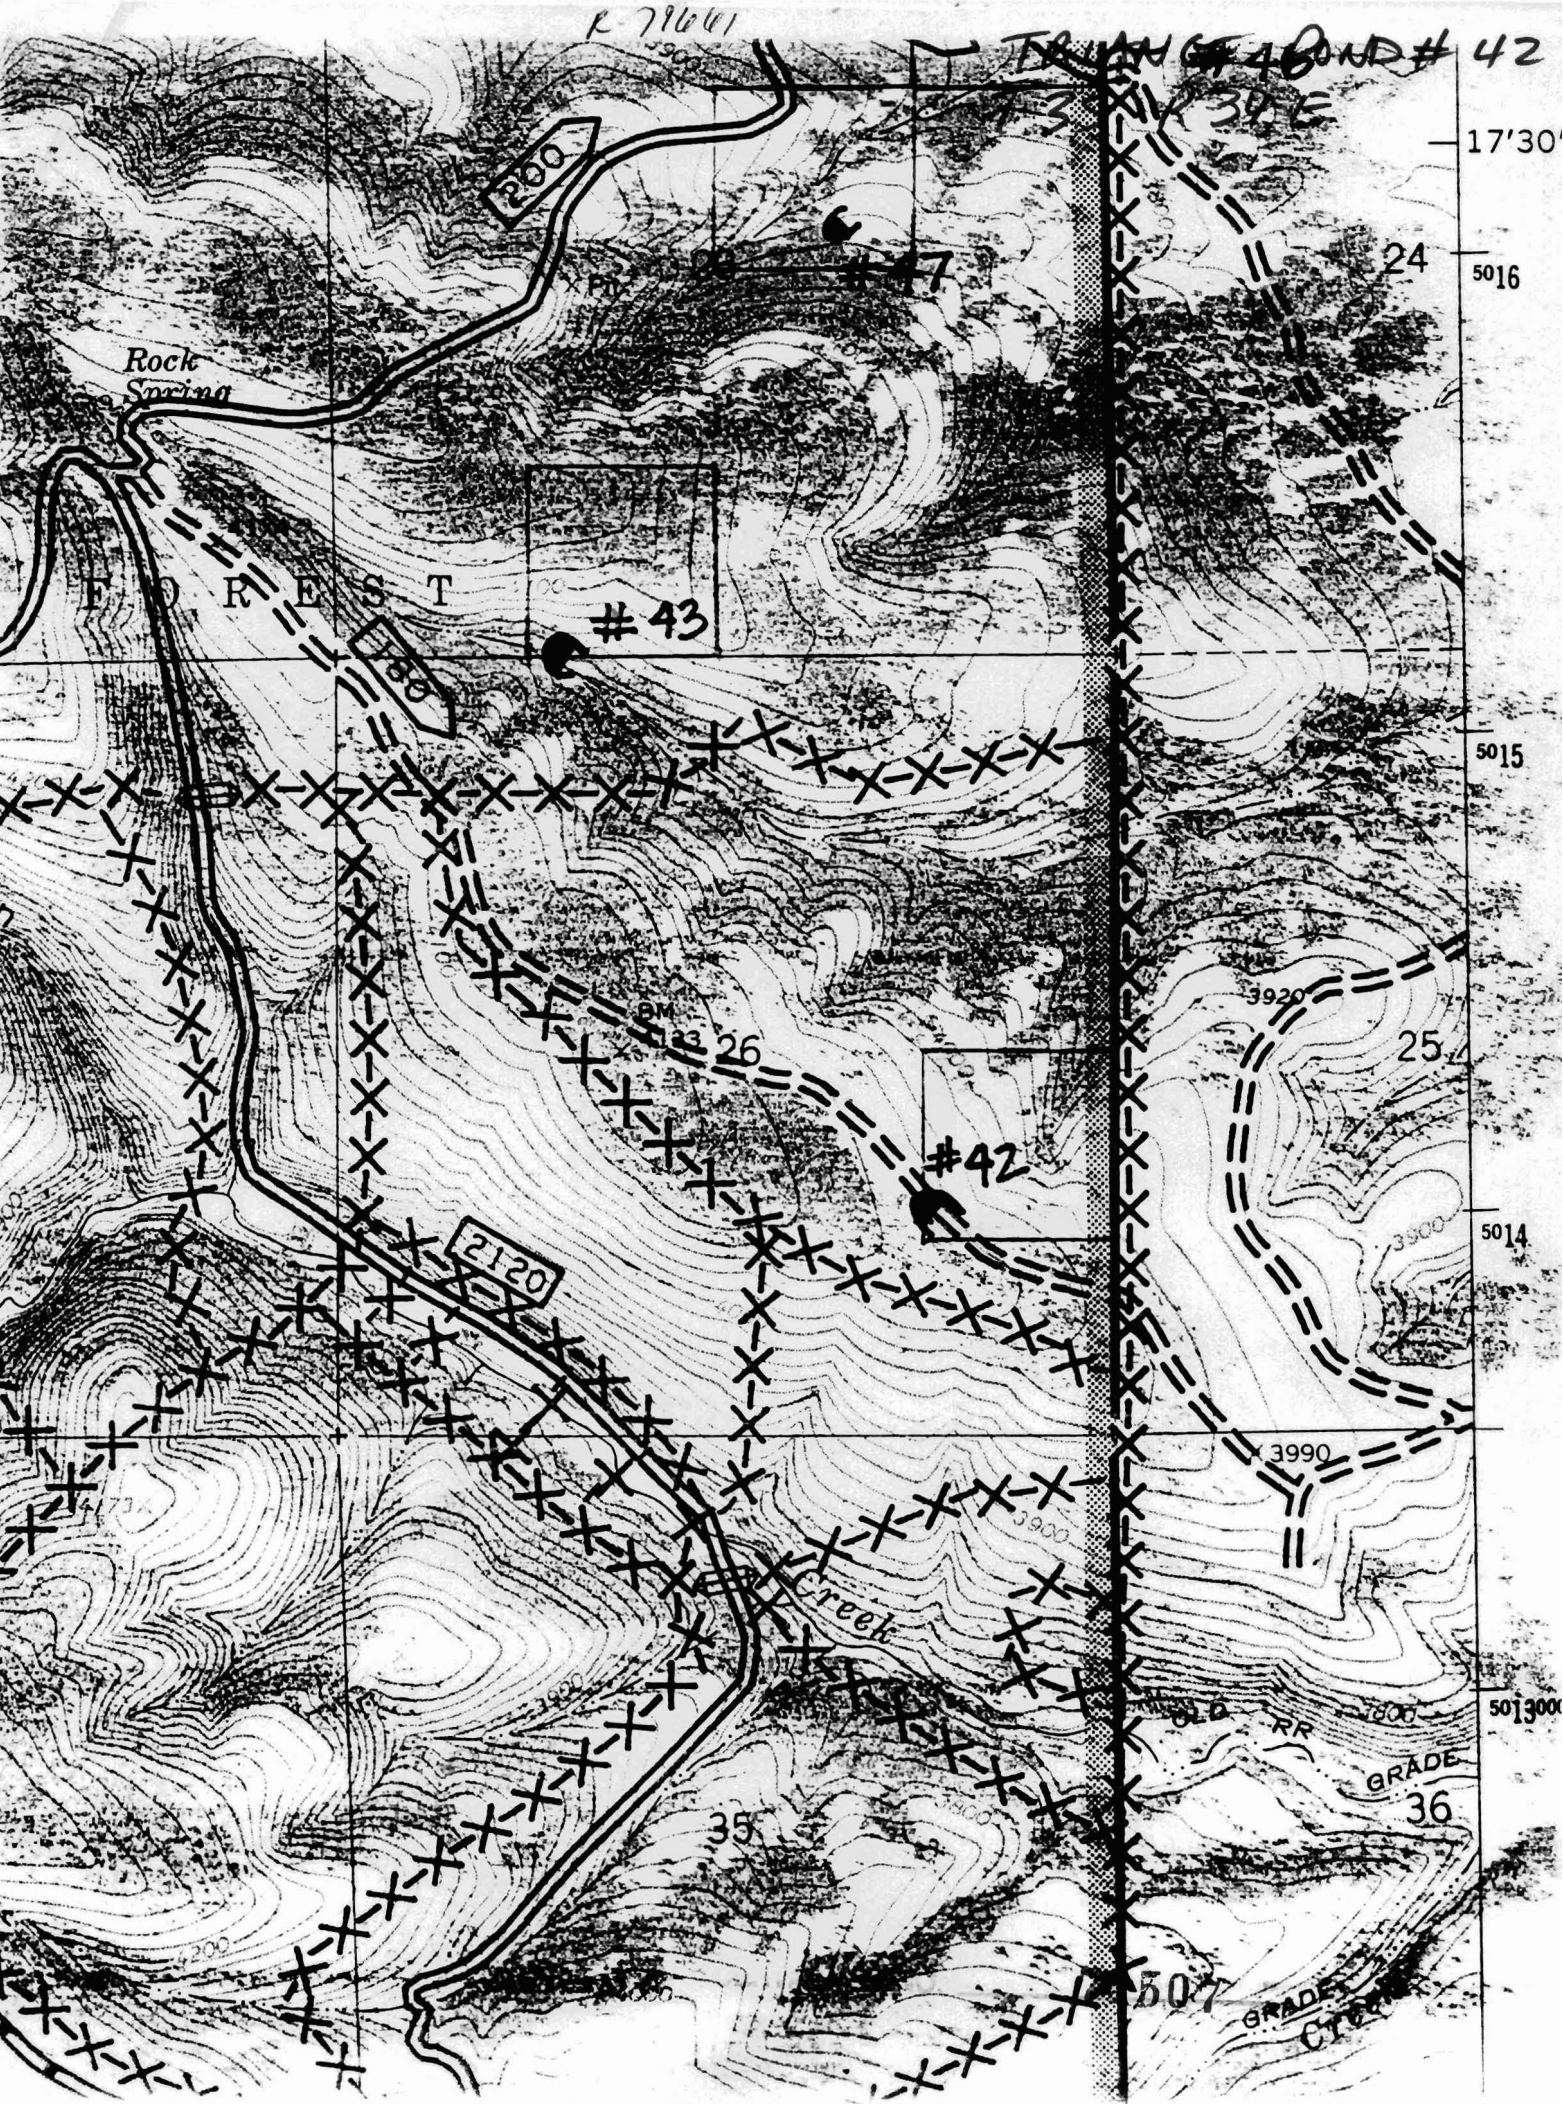

Thimble Pond #44

T 2 S R 37 E R. 79601

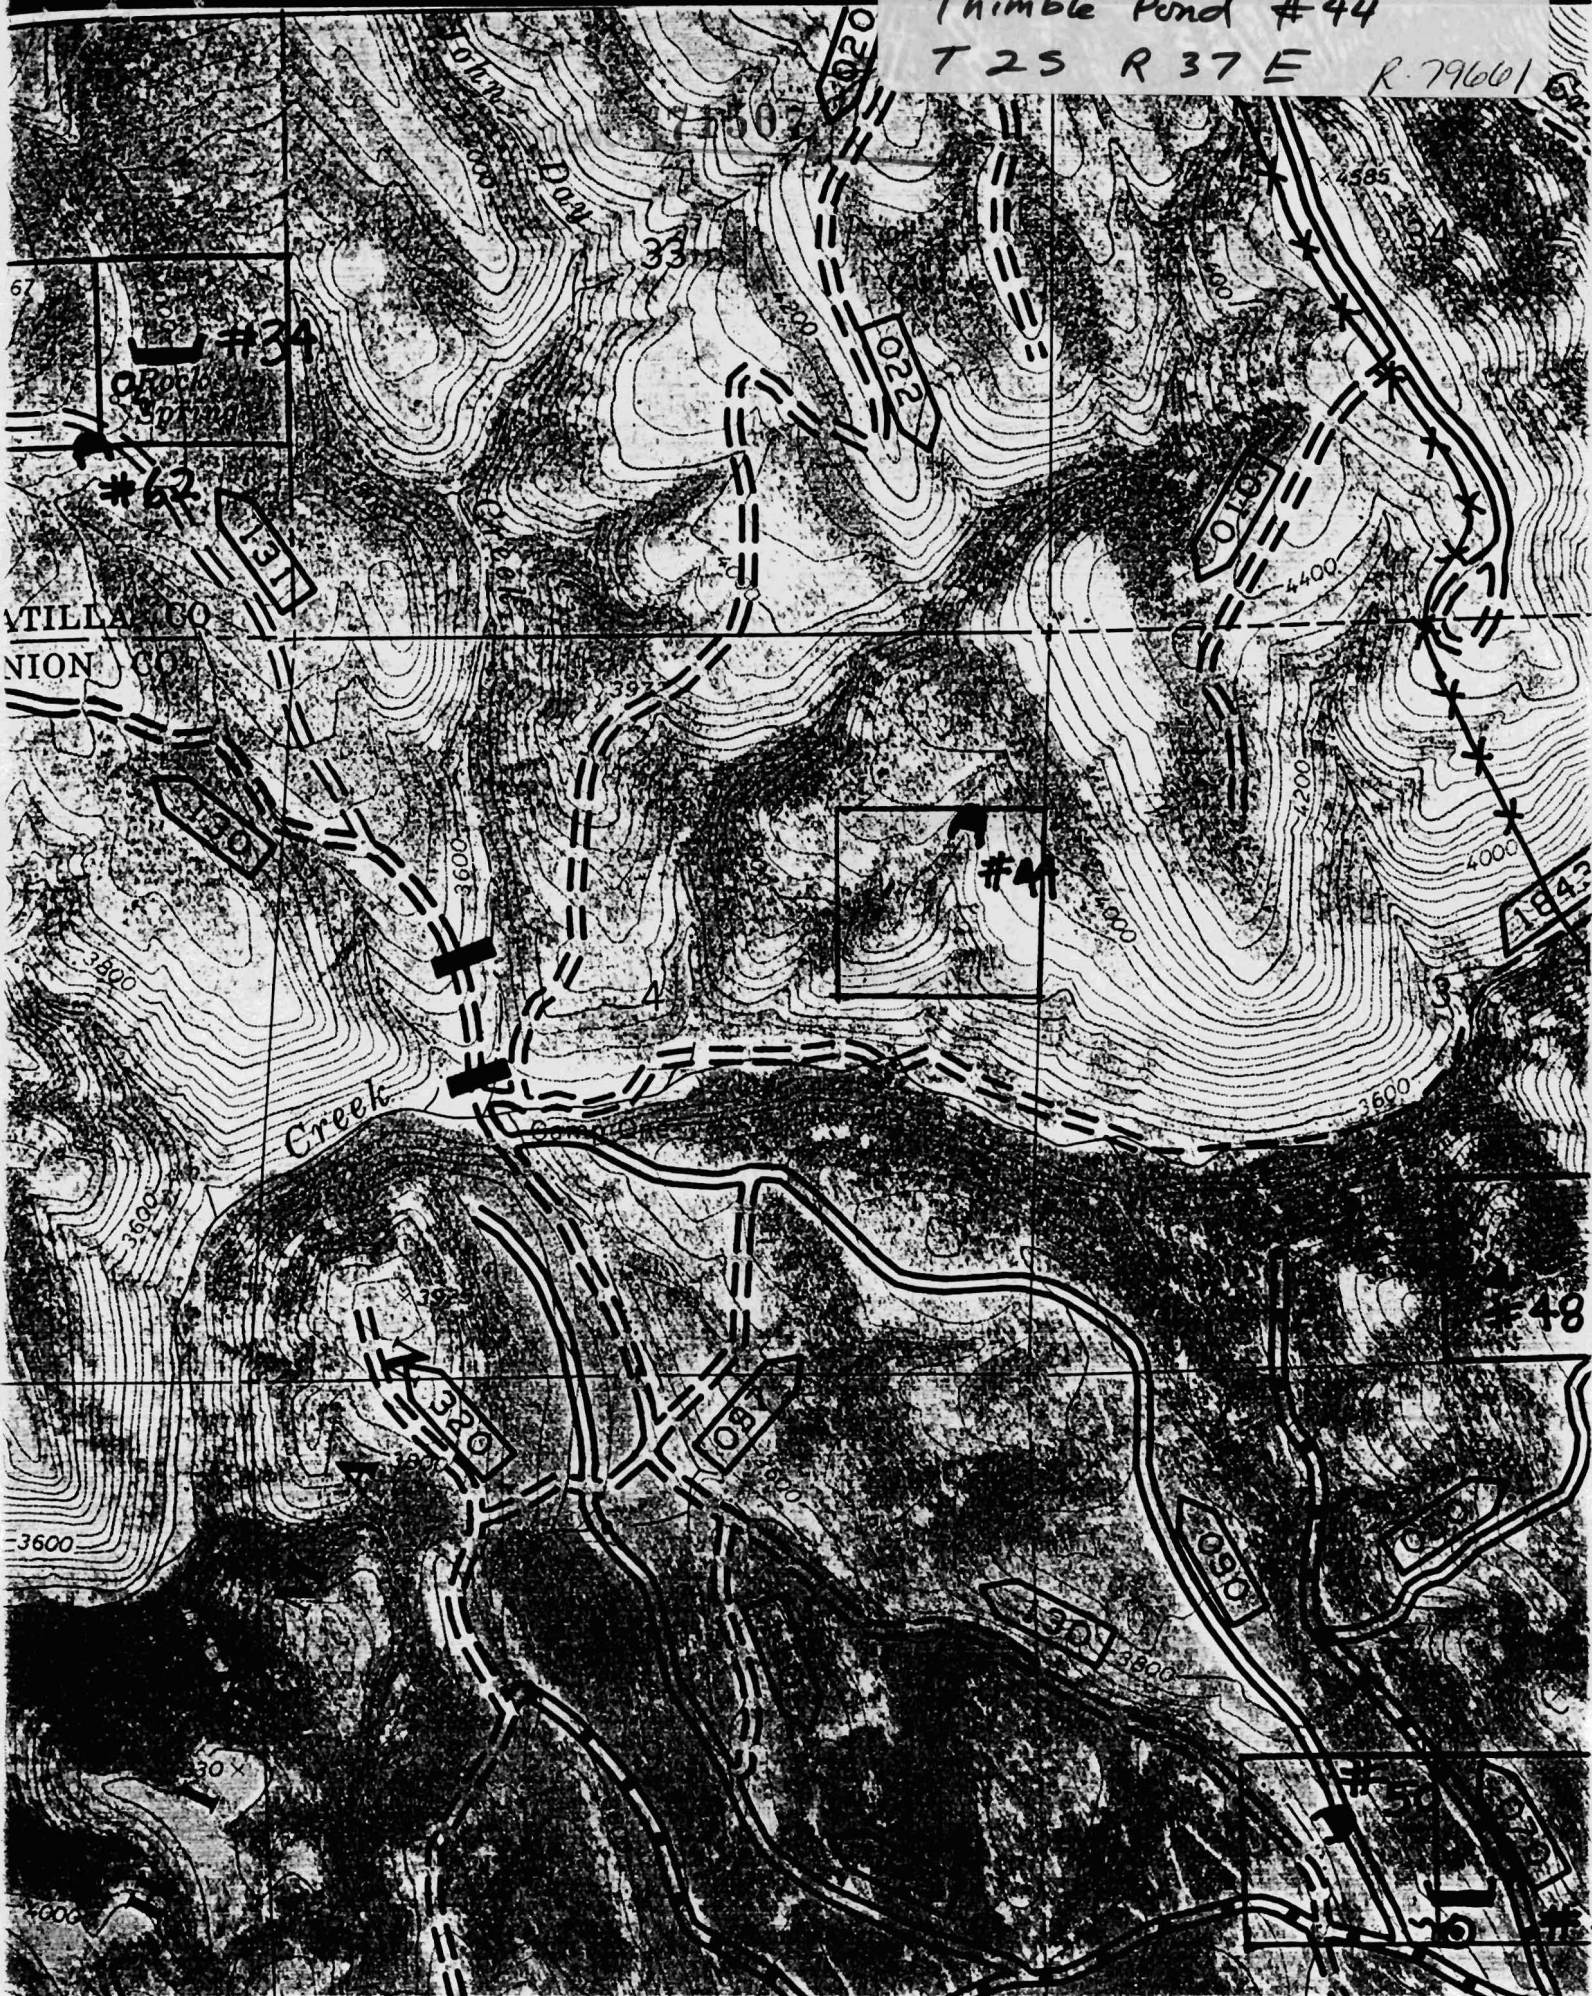

Dry Pond # 48

T2S R37 E R. 79661




71507

Prairie

Rail Road Grade Pond #52

T2S R36E


R 79601

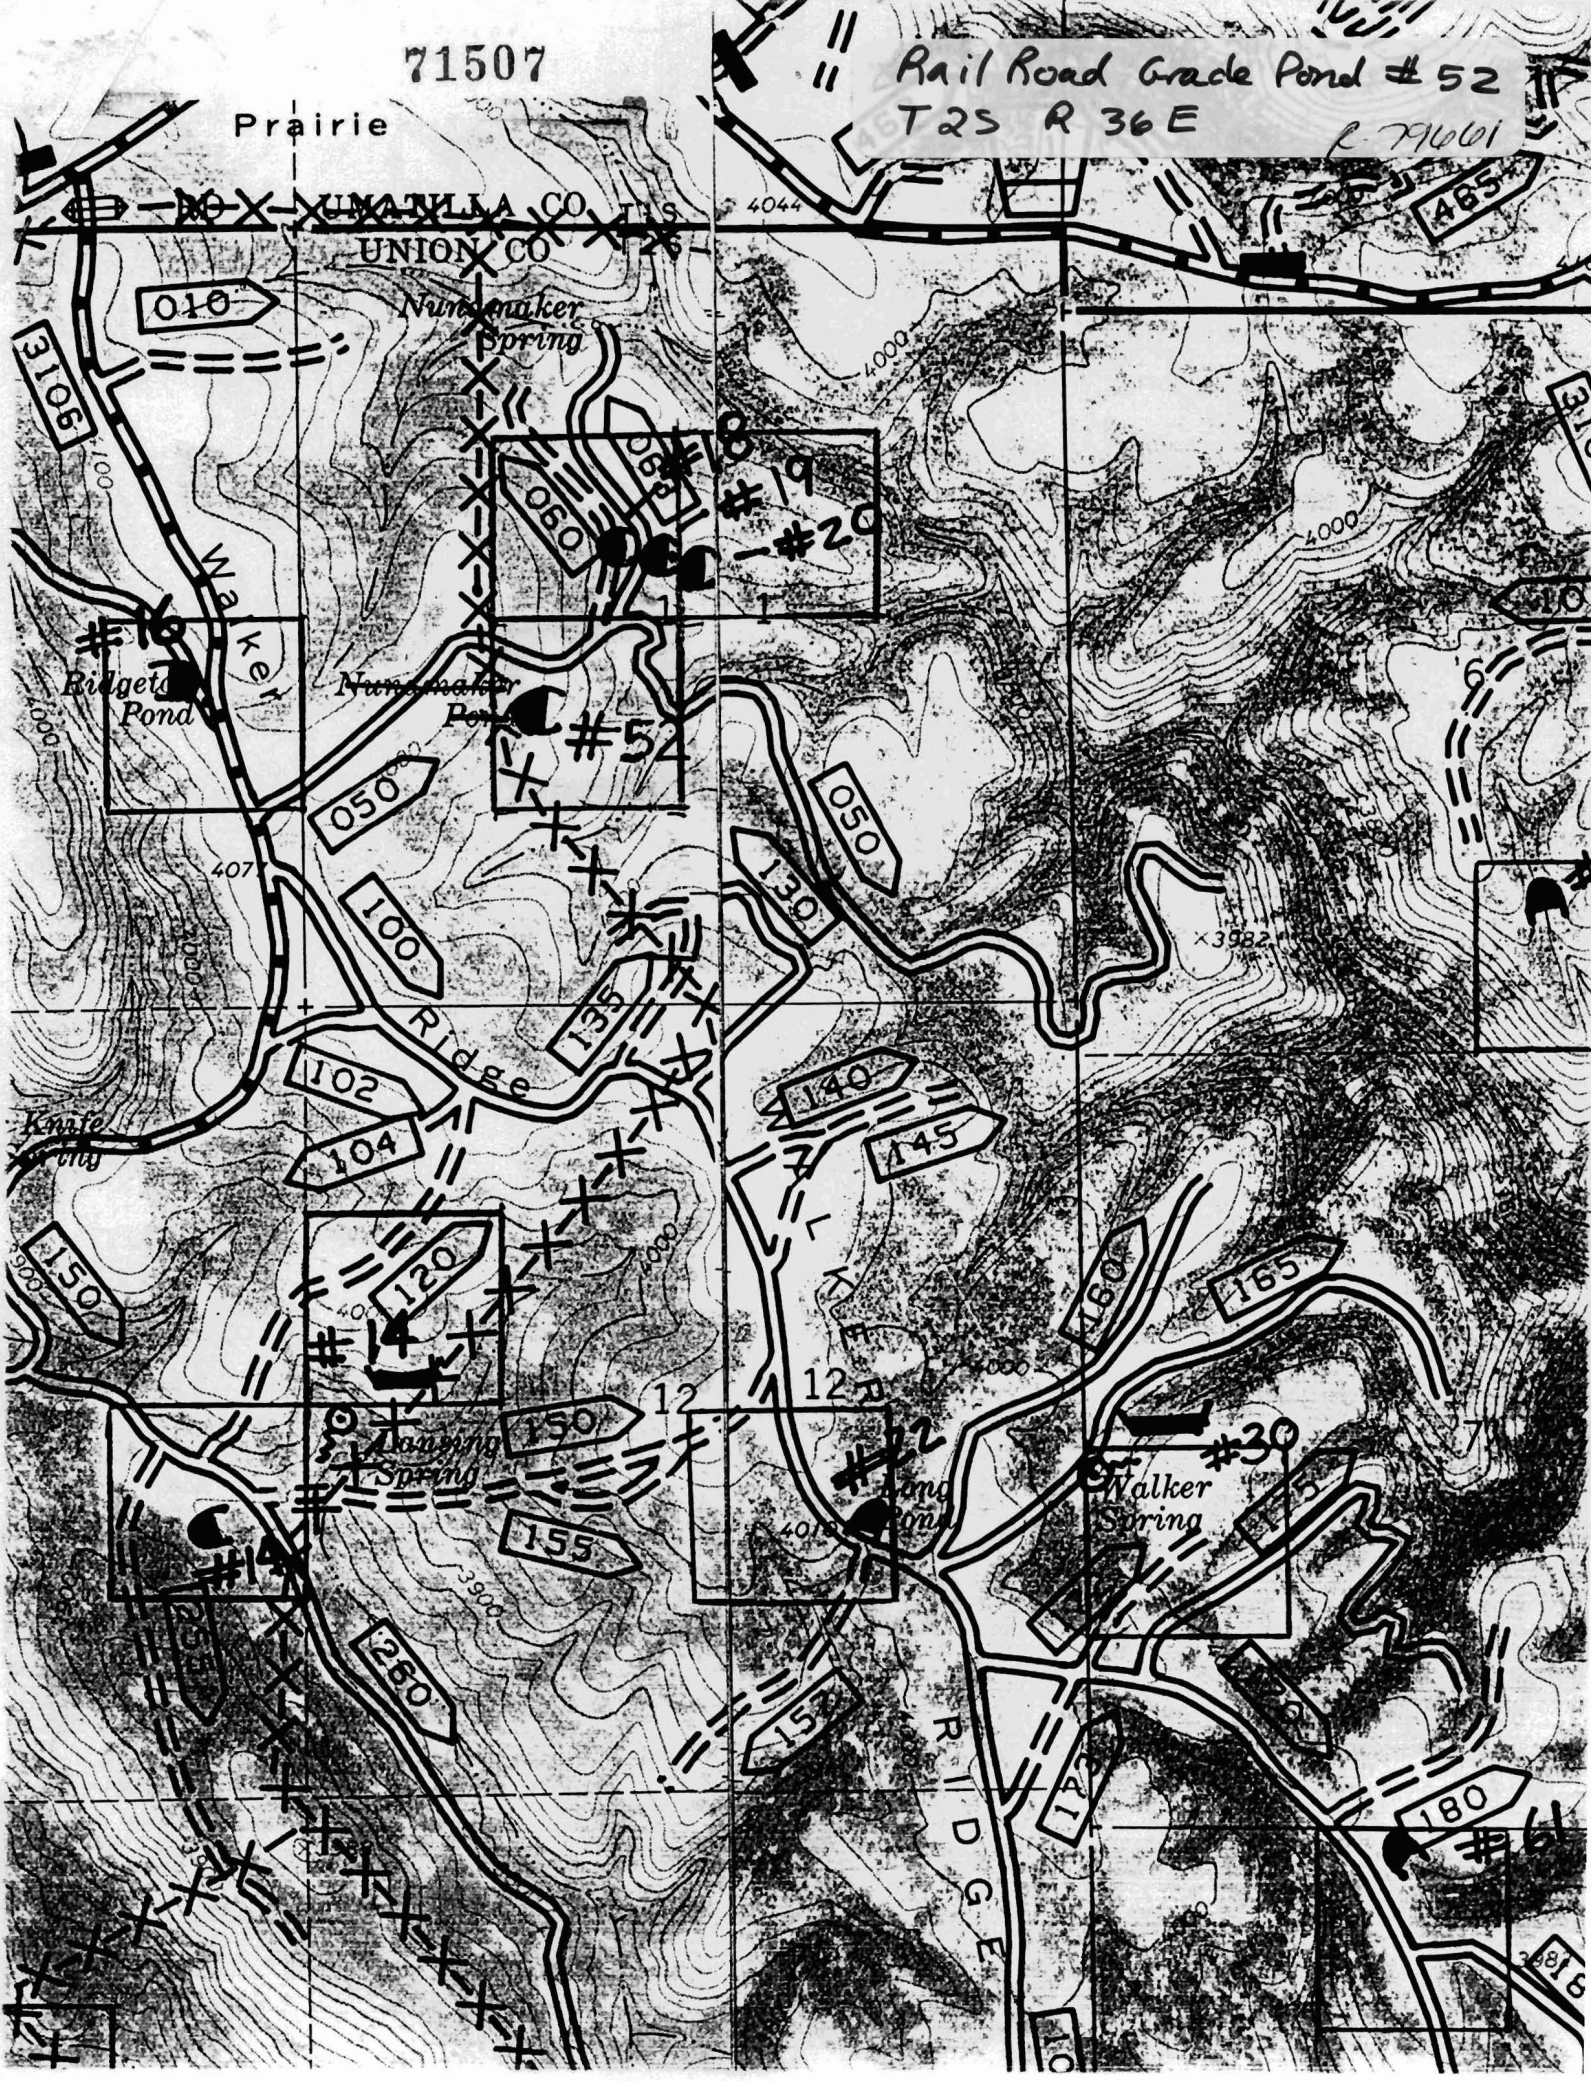

McClure Pond # 50
T2S R37E L79661



~~Walker~~ Pond #1 (#61)
Alexander
T2S R 37E R. 79661

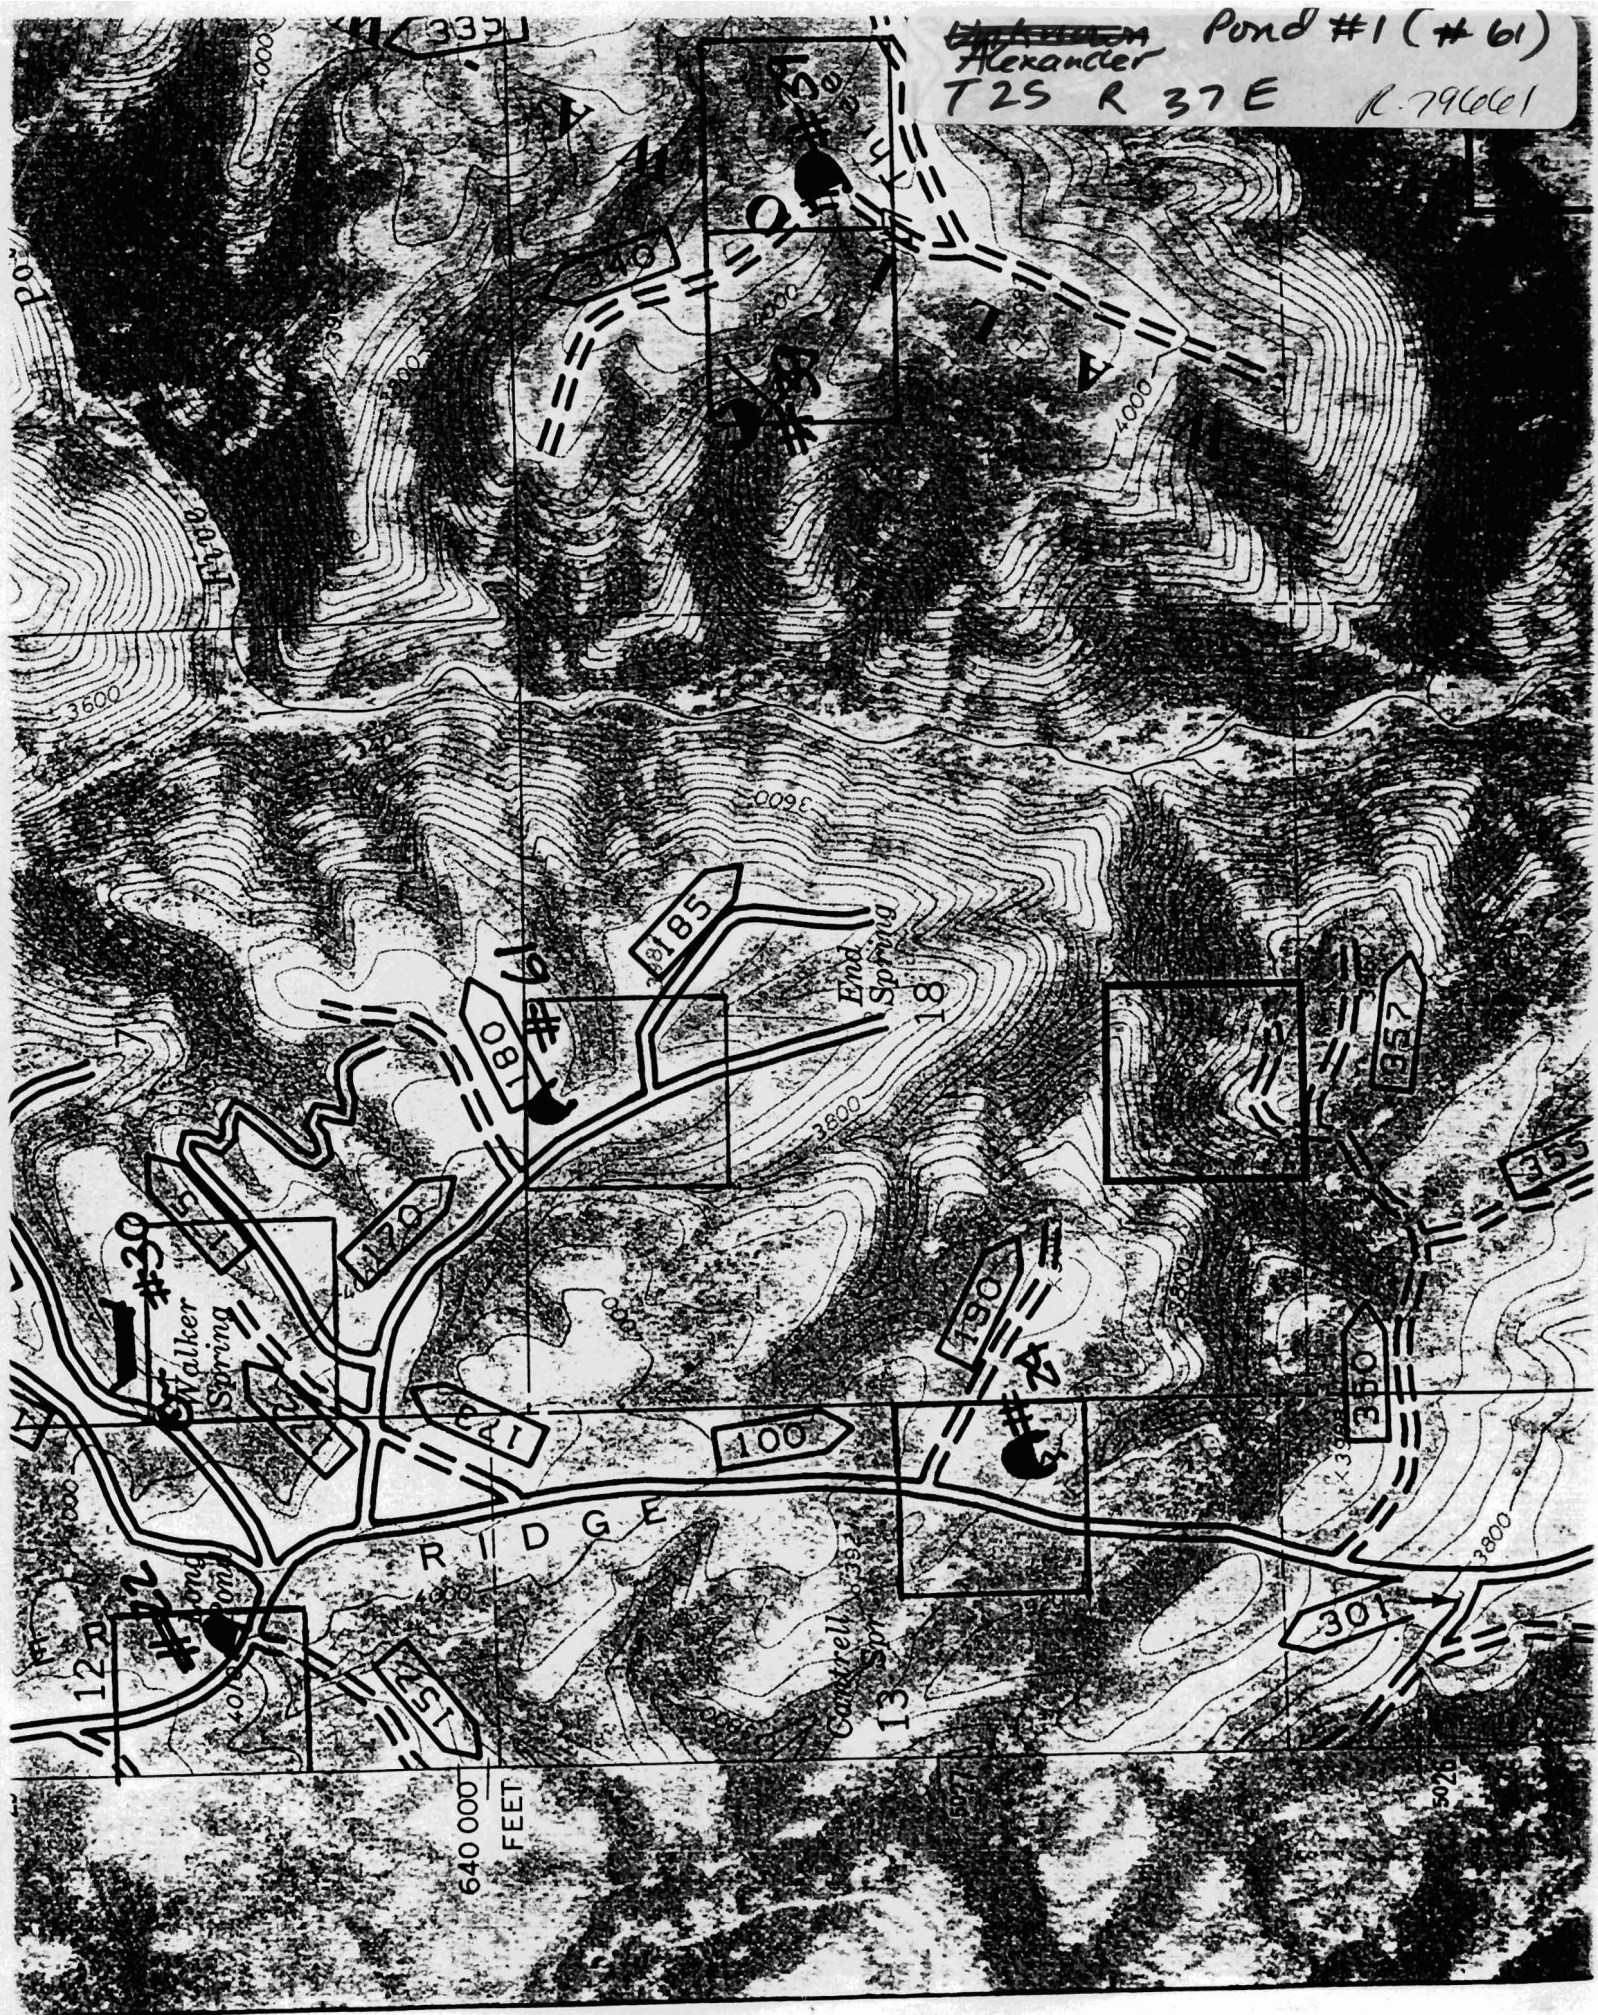

Application No R. 79661
Permit No. 71507

Unknown Pond # 62
(Rock Sp. Pond) # 62
T 1 S R 37 E

