


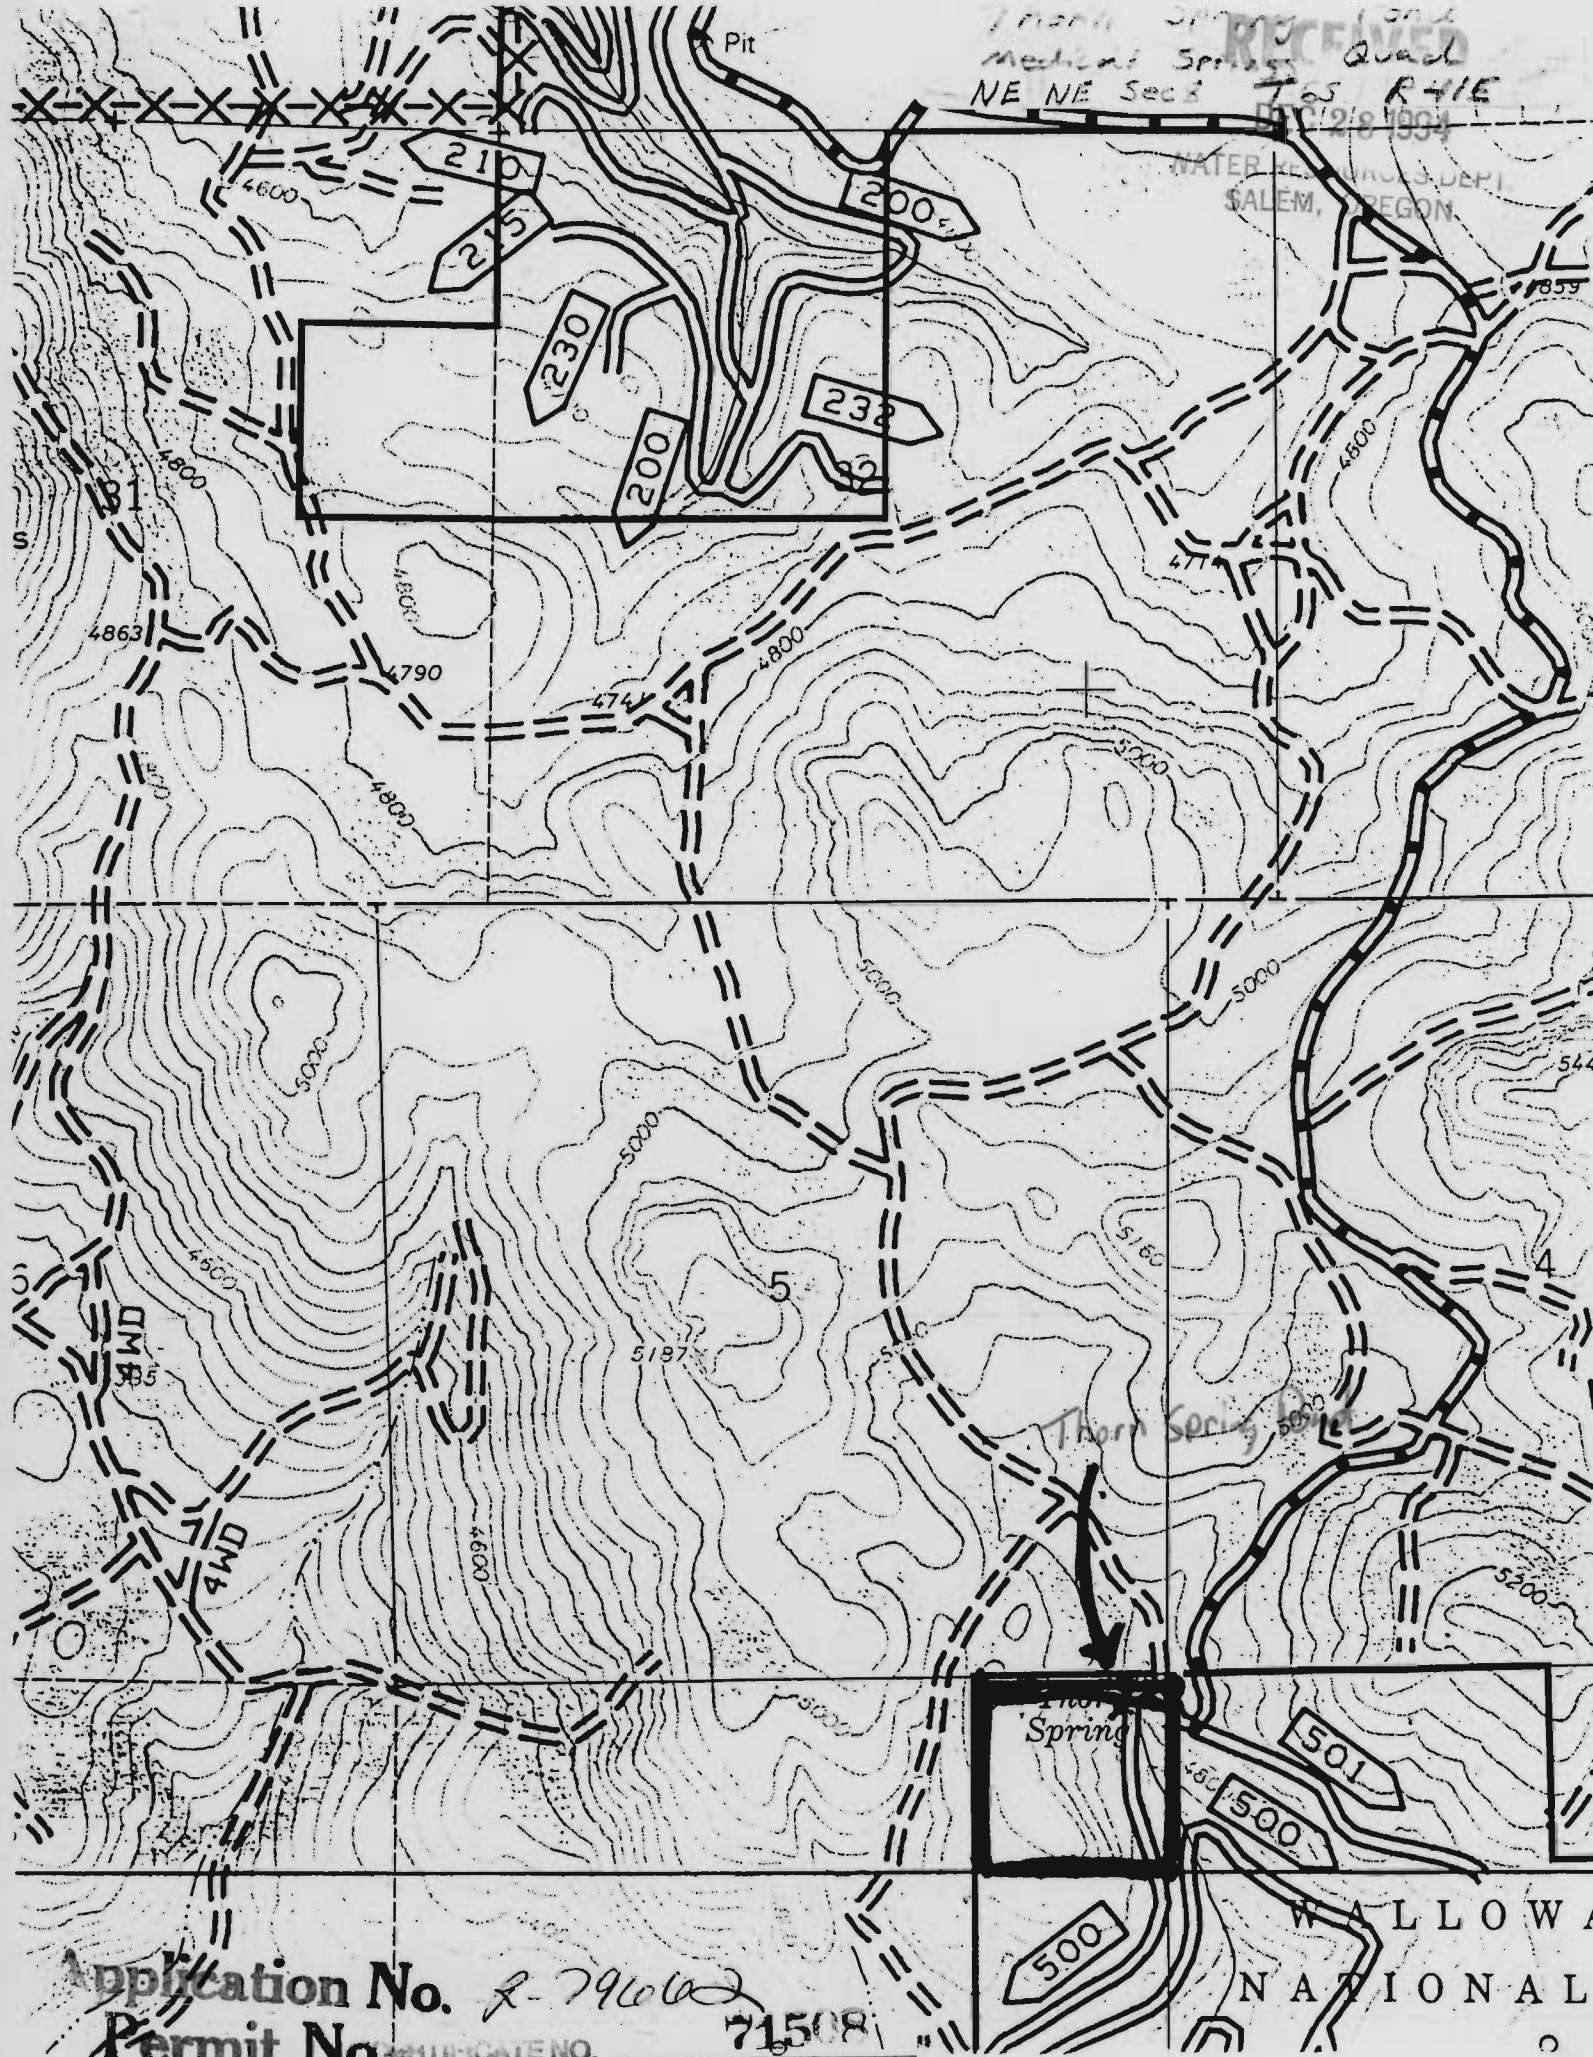

Medical Springs Quad
NE NE Sec 8 T6S R4E

DEC 28 1994

WATER RESOURCES DEPT
SALEM, OREGON

Application No. 2-79662
Permit No. 71508

WALLOWA
NATIONAL