


Bull Hollow Pond
3S 36E 2SENE


#25
R 790004
N1/2 Kamela




Tip Top Corral Pond #24
3536E 7SESW N 1/2 Kamela

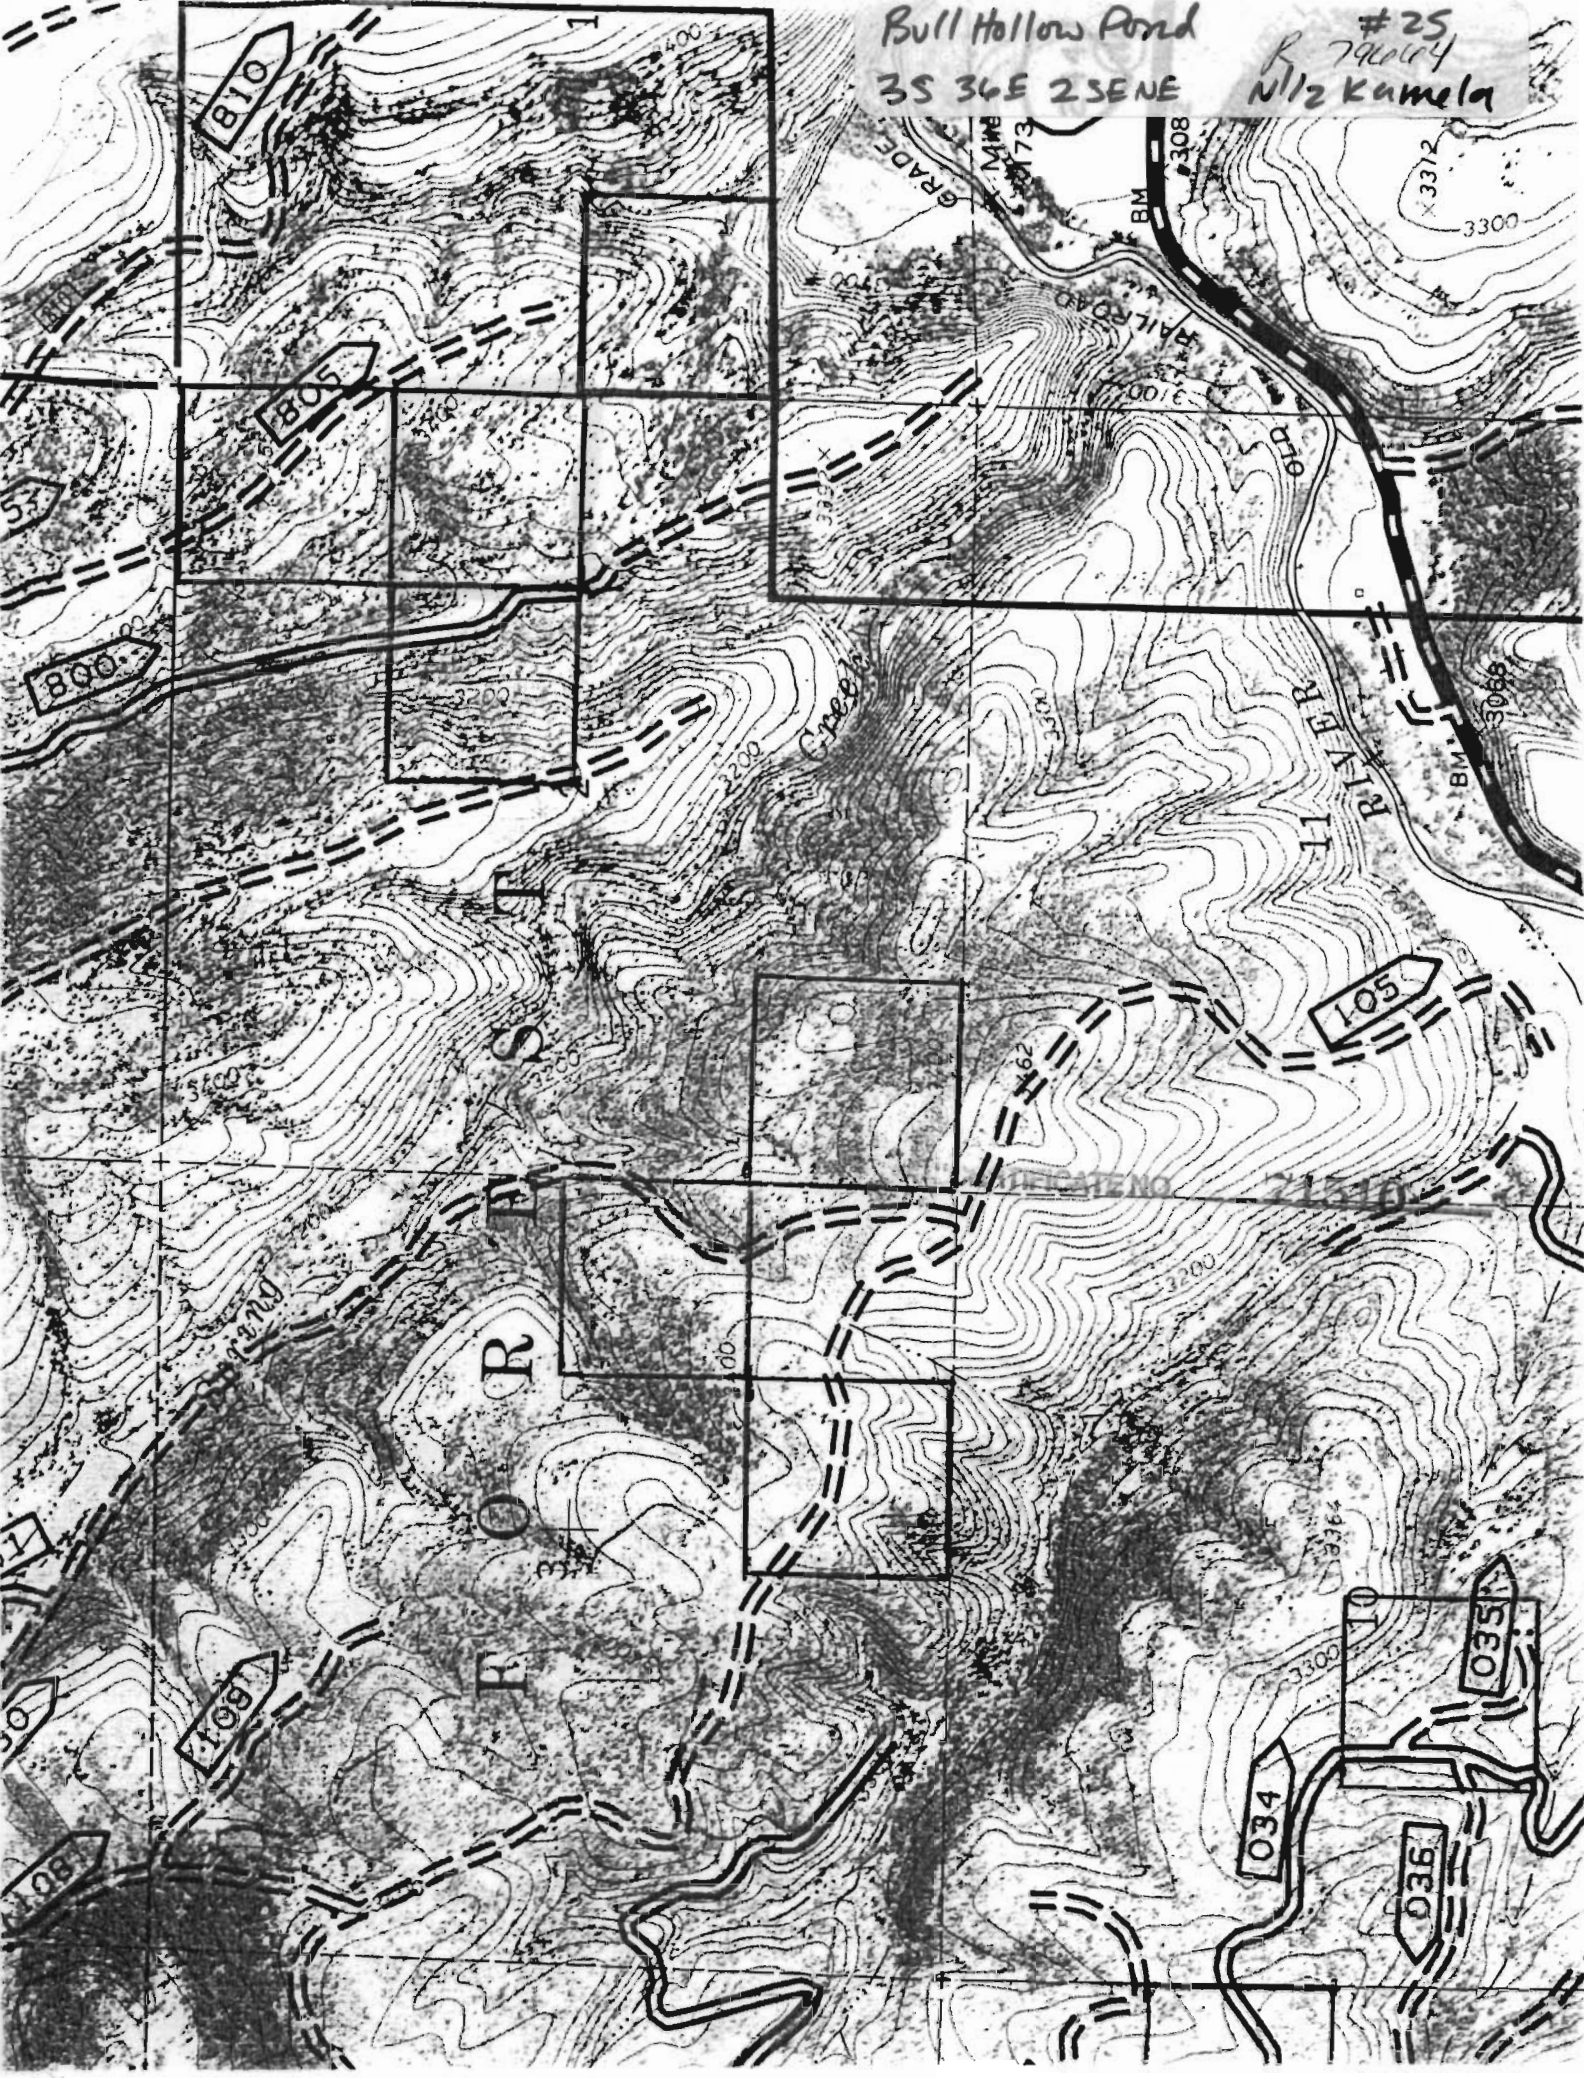


Lower Mill Corral Pond #23
R 14064
3S 36E 3 SENE N 1/2 Kamela

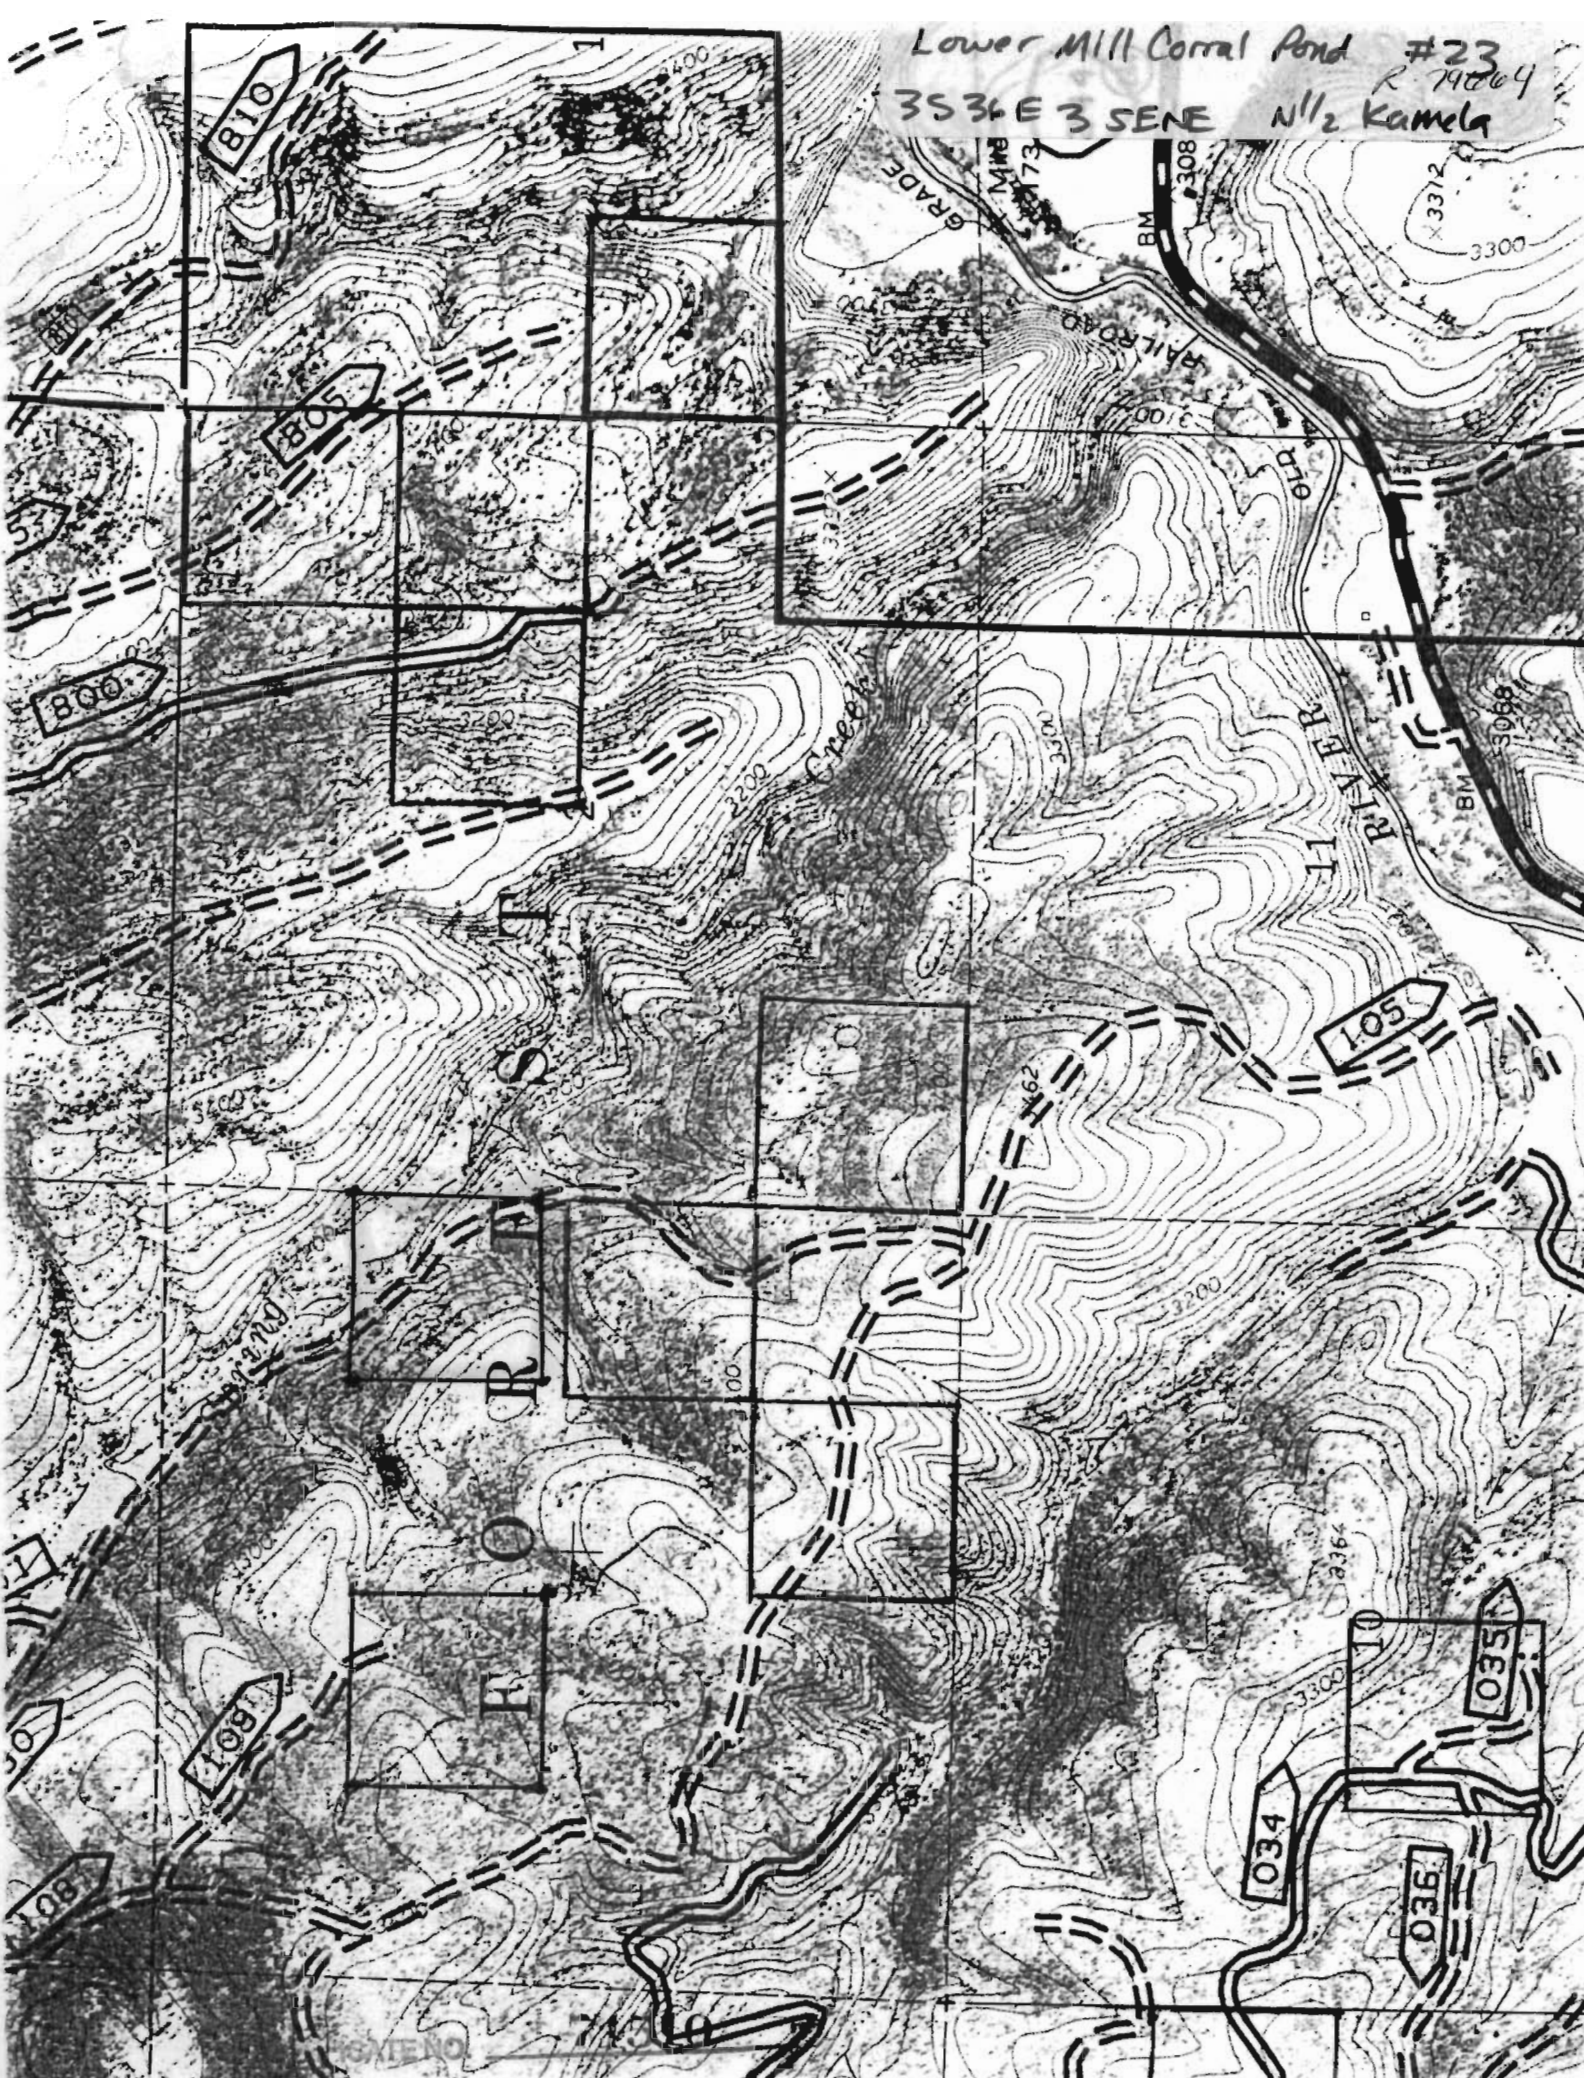


Cougar Pt. Prod #22
R 79664
35 30 E 19 SWSE 5 1/2 kamela

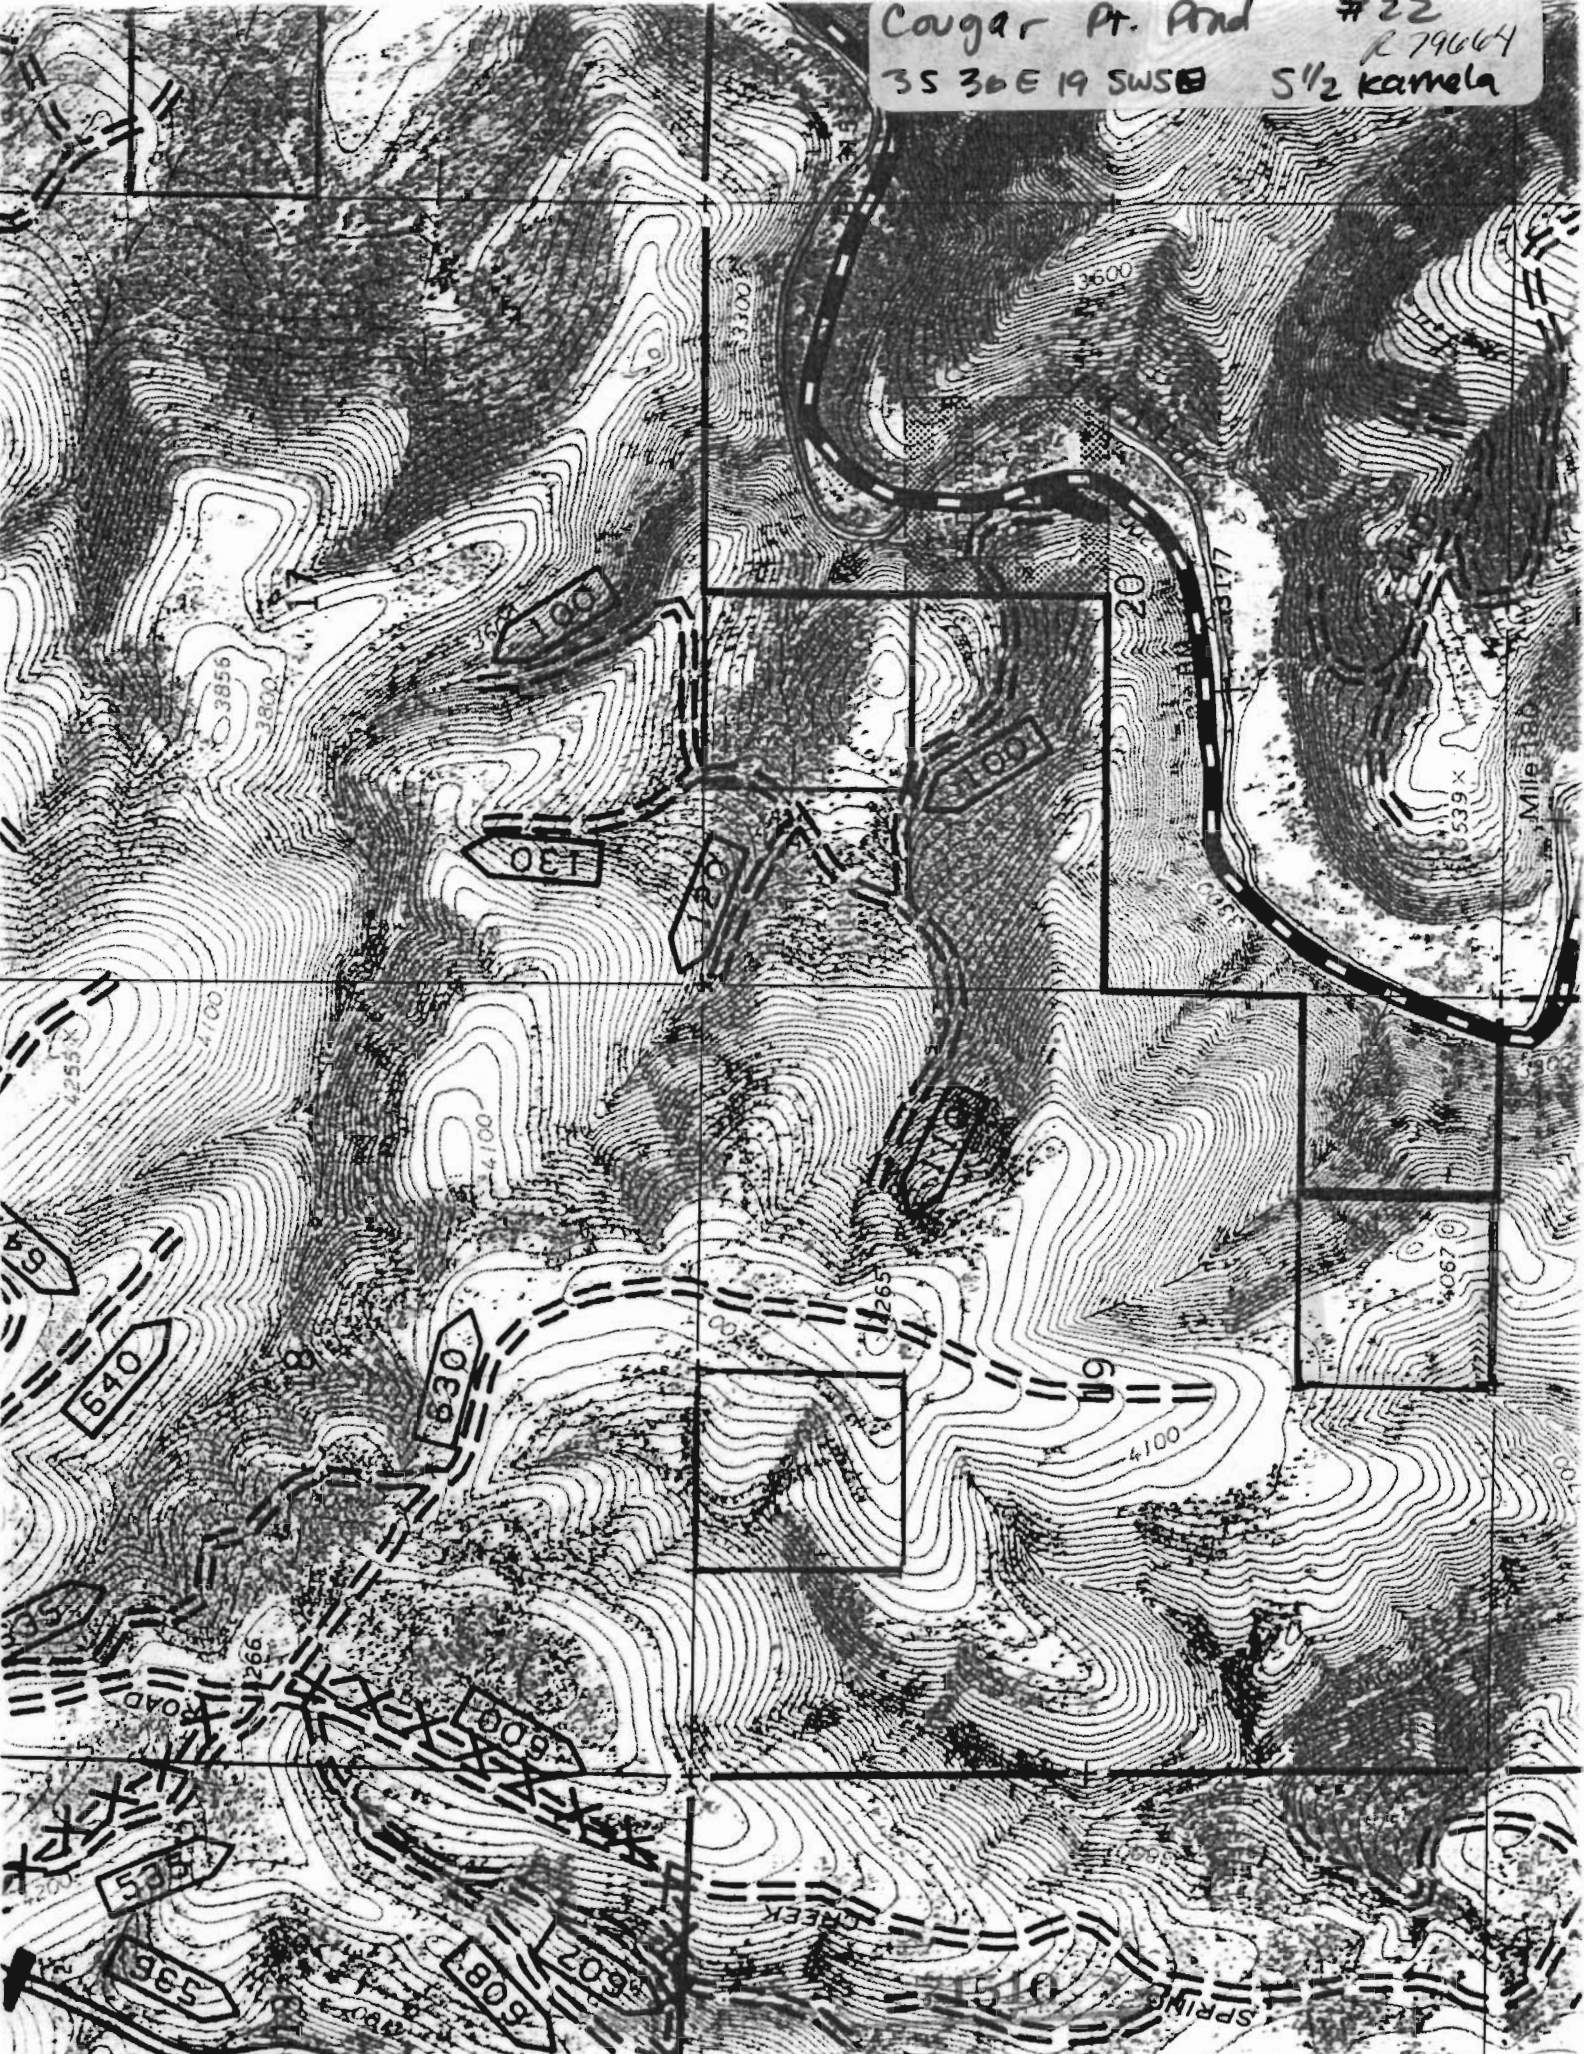

UNNAMED Pond #21
35 36 E 19 NENE ~~SE~~
R-79664
S 1/2 Kanela

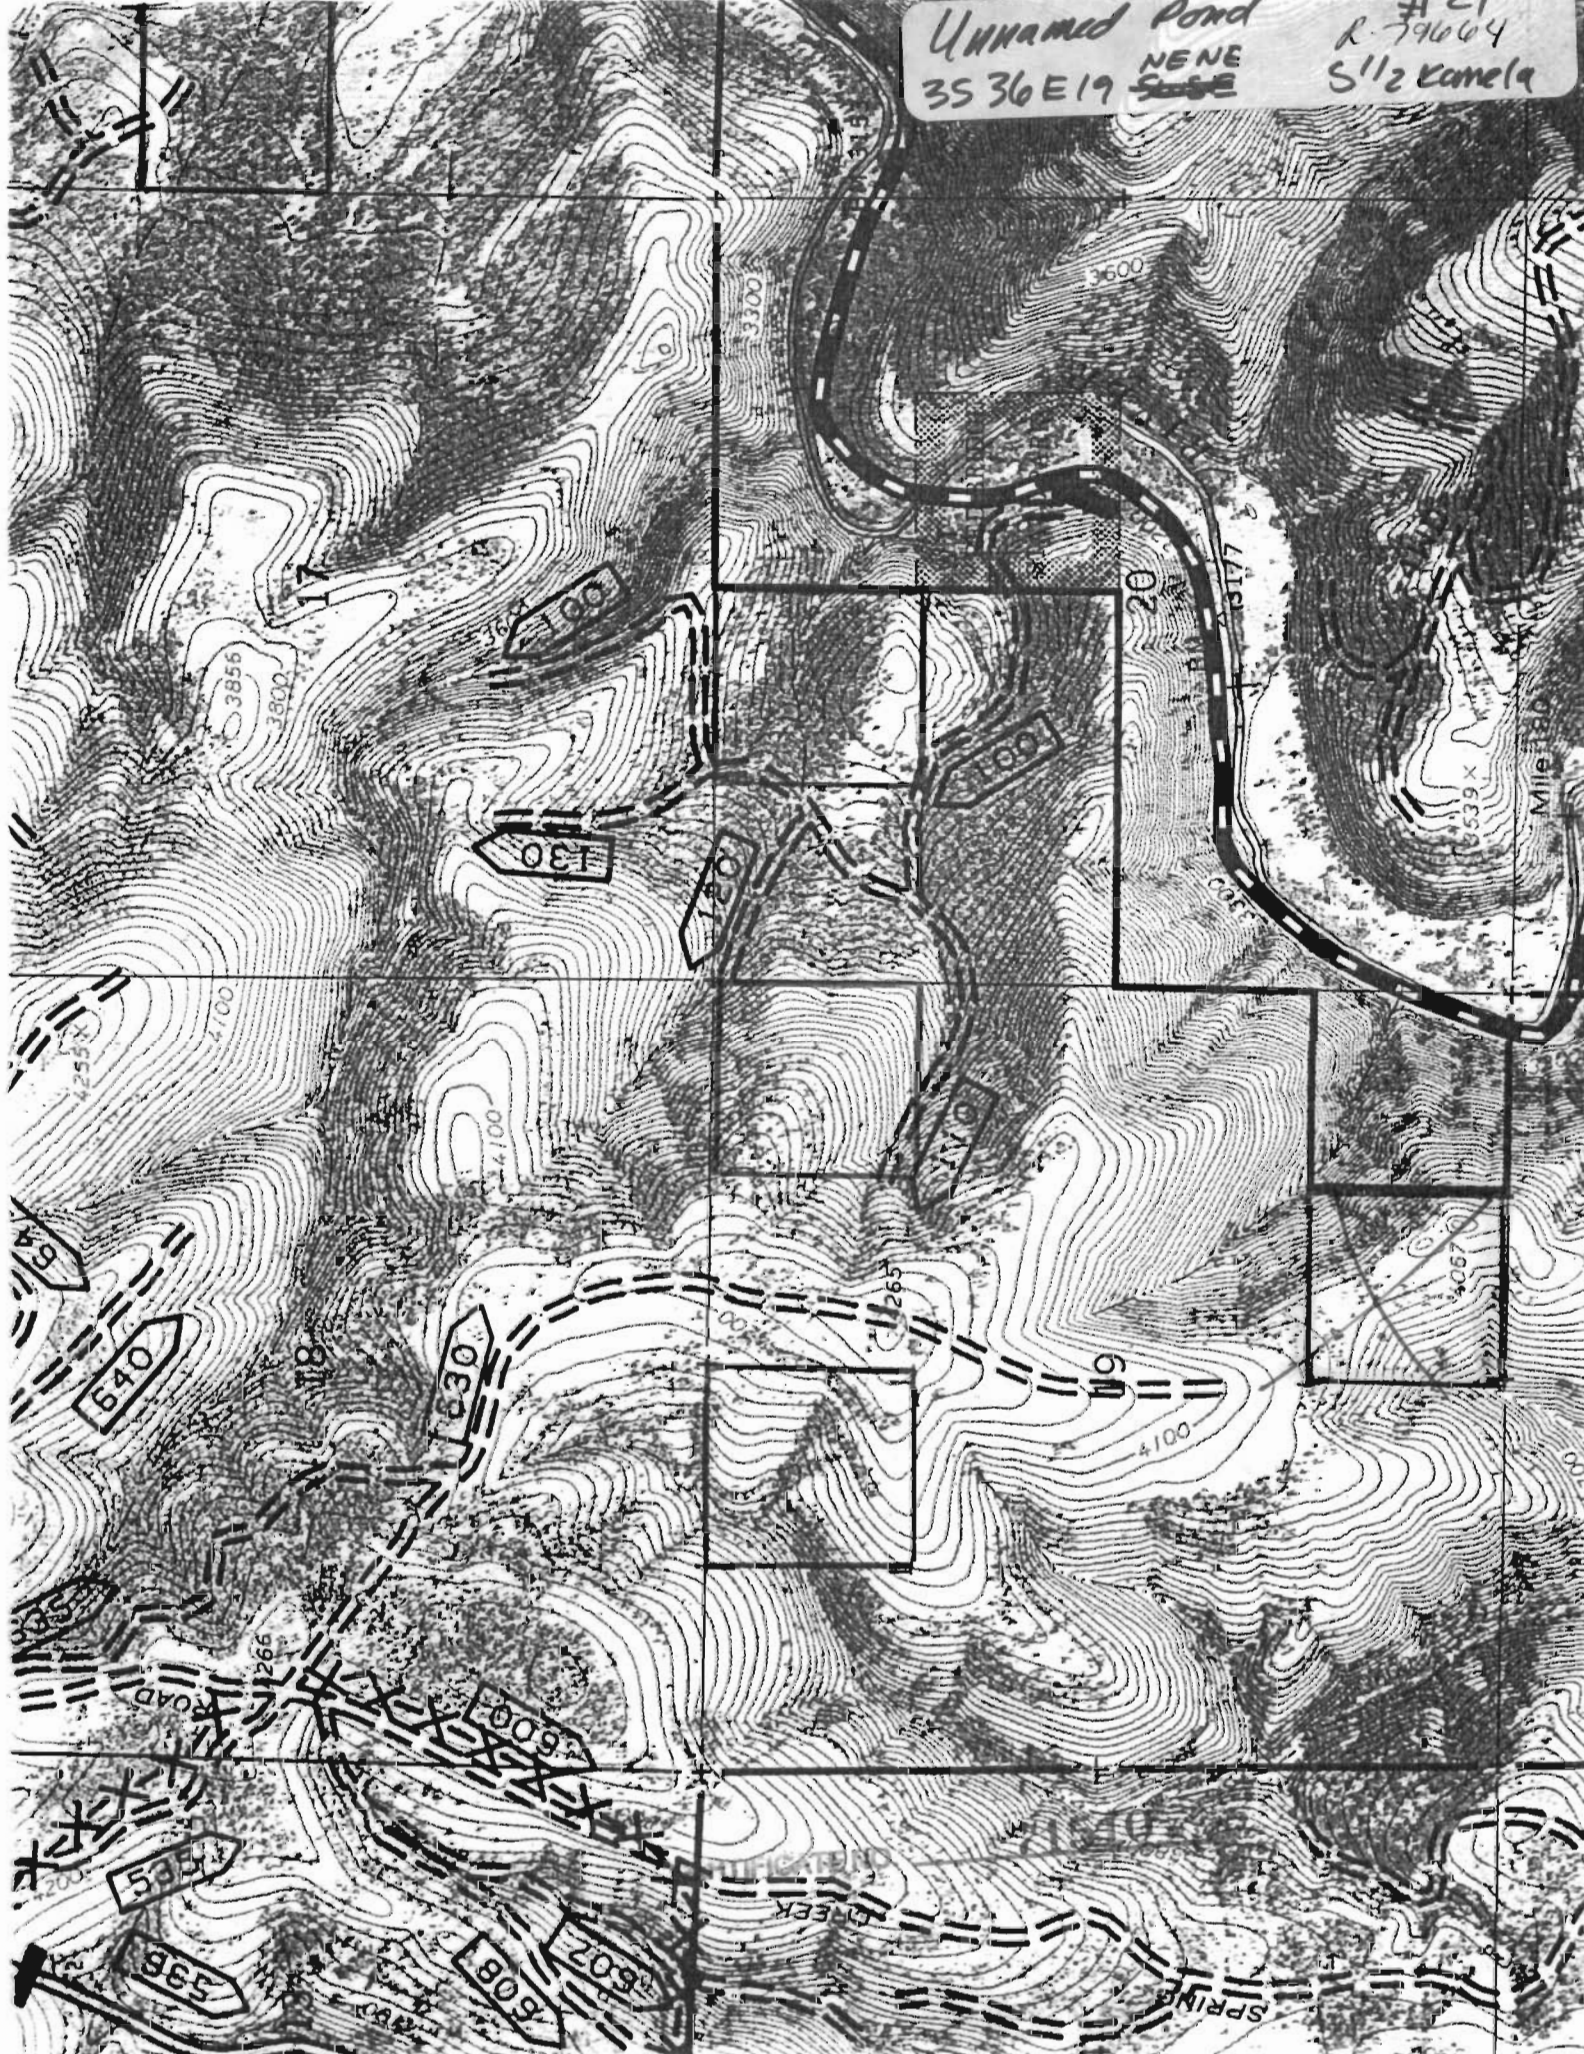


Red Bridge Pond #20
R 79604
35 36 E 20 NE NW S 1/2 kamela

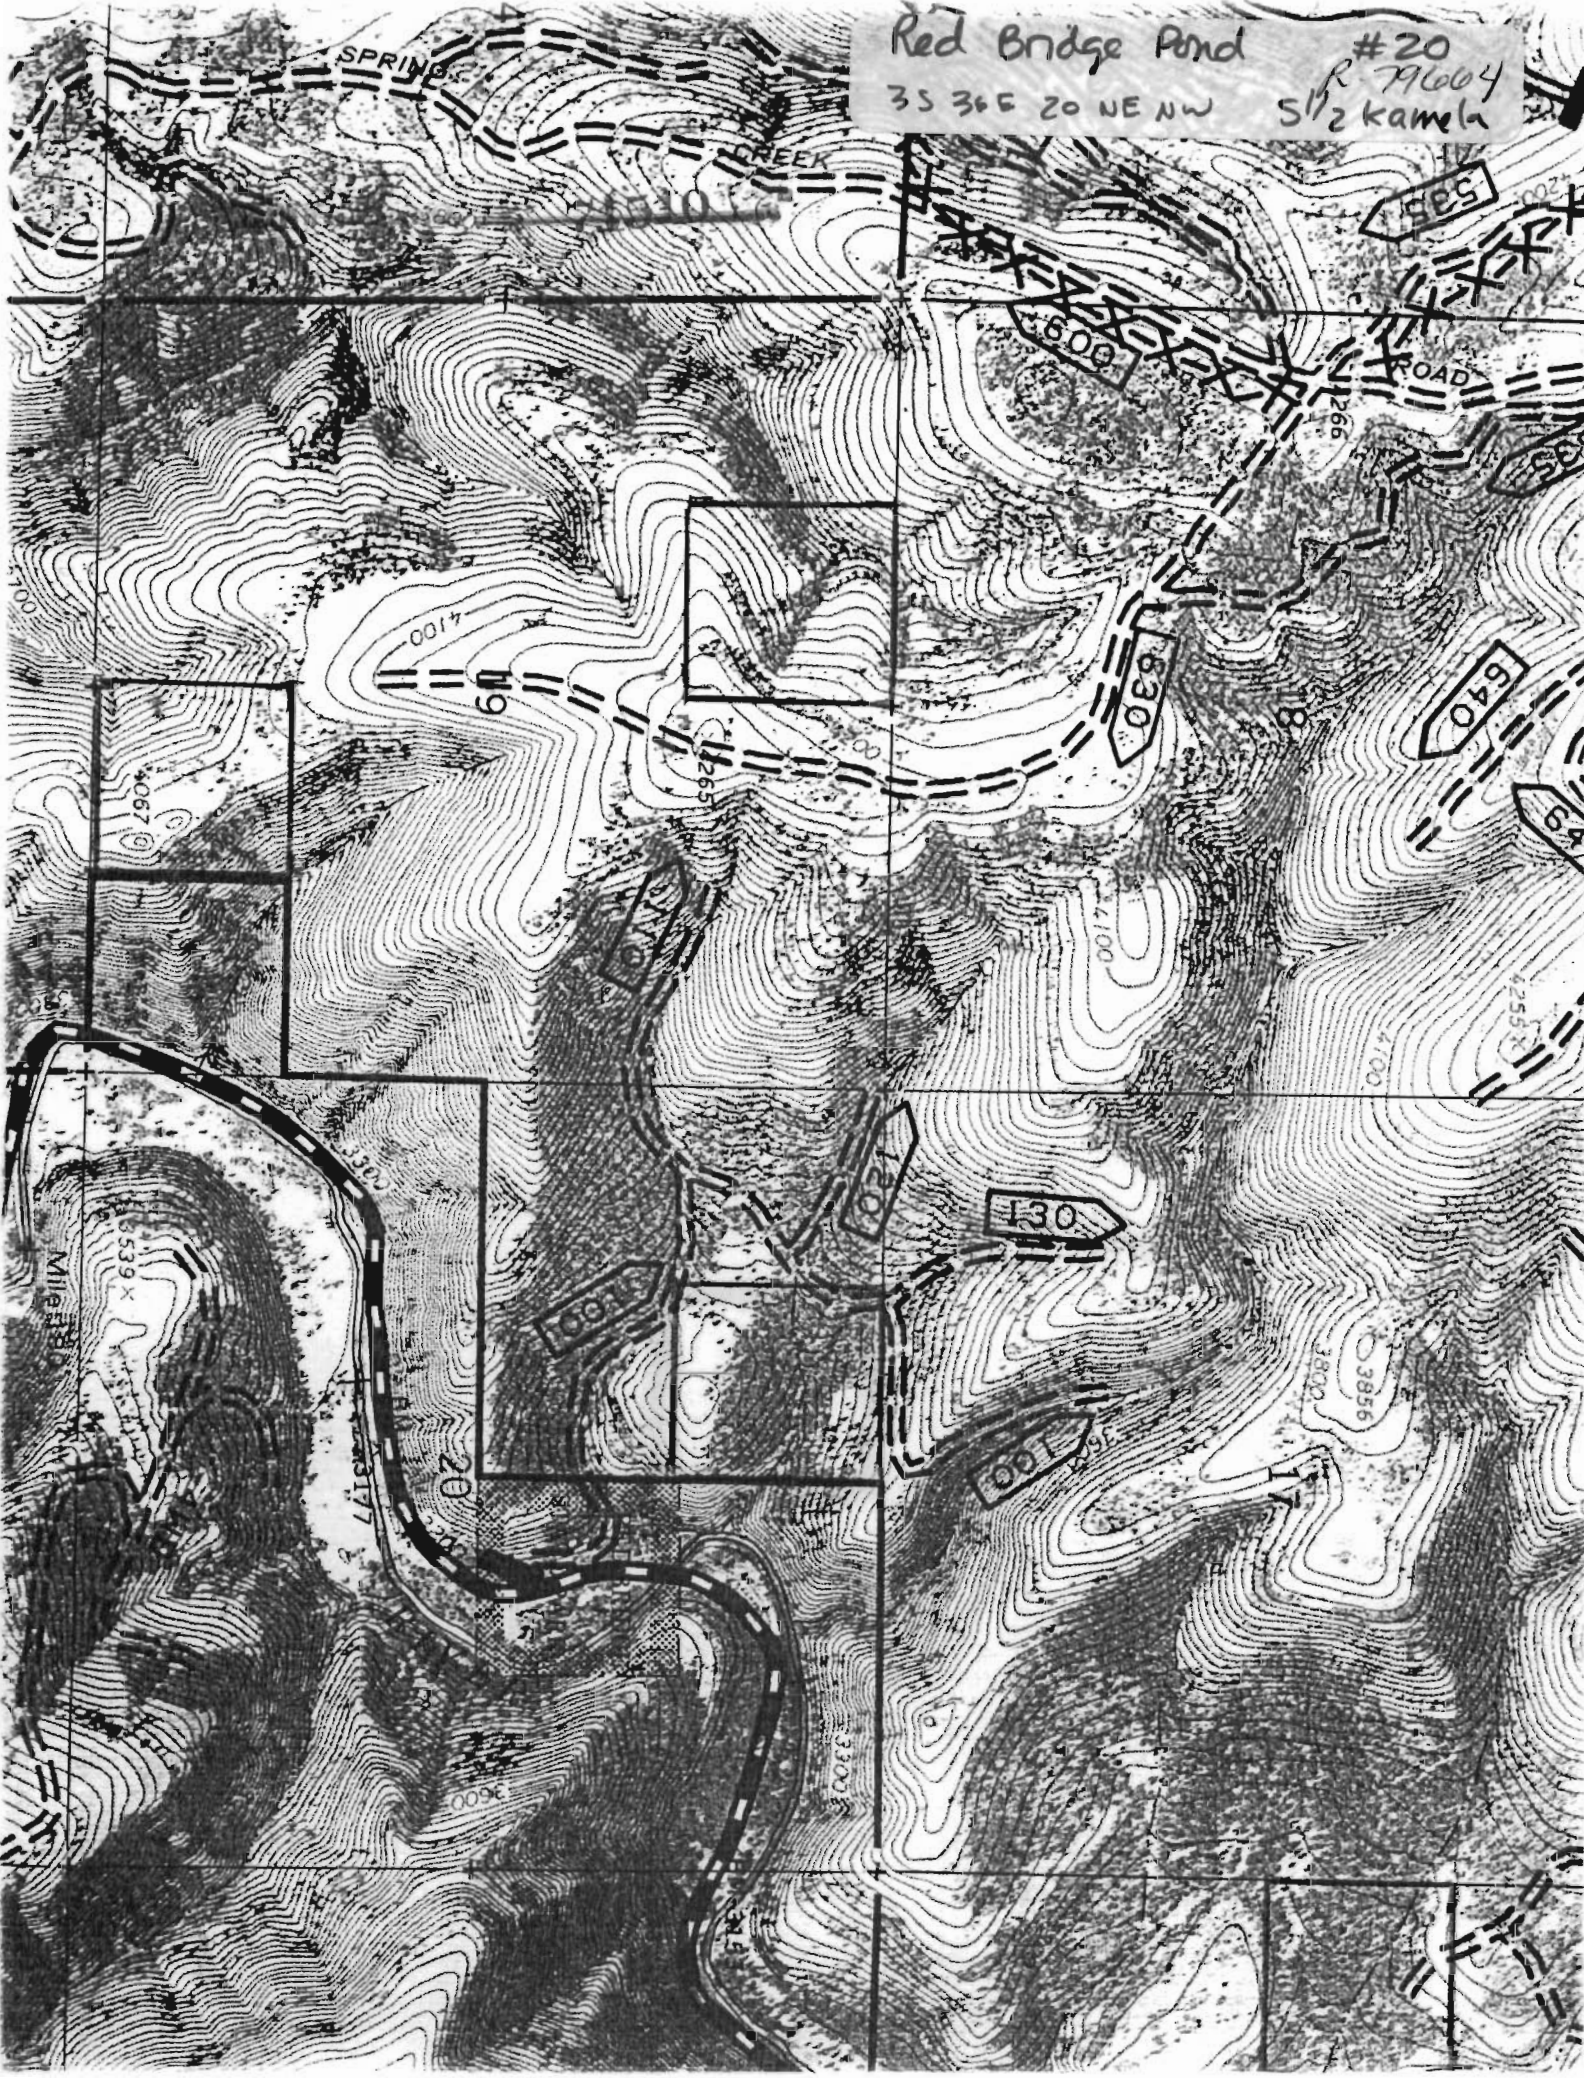


Turn Pond
3536 E 9 SE NE

#17
N 1/2 kameda

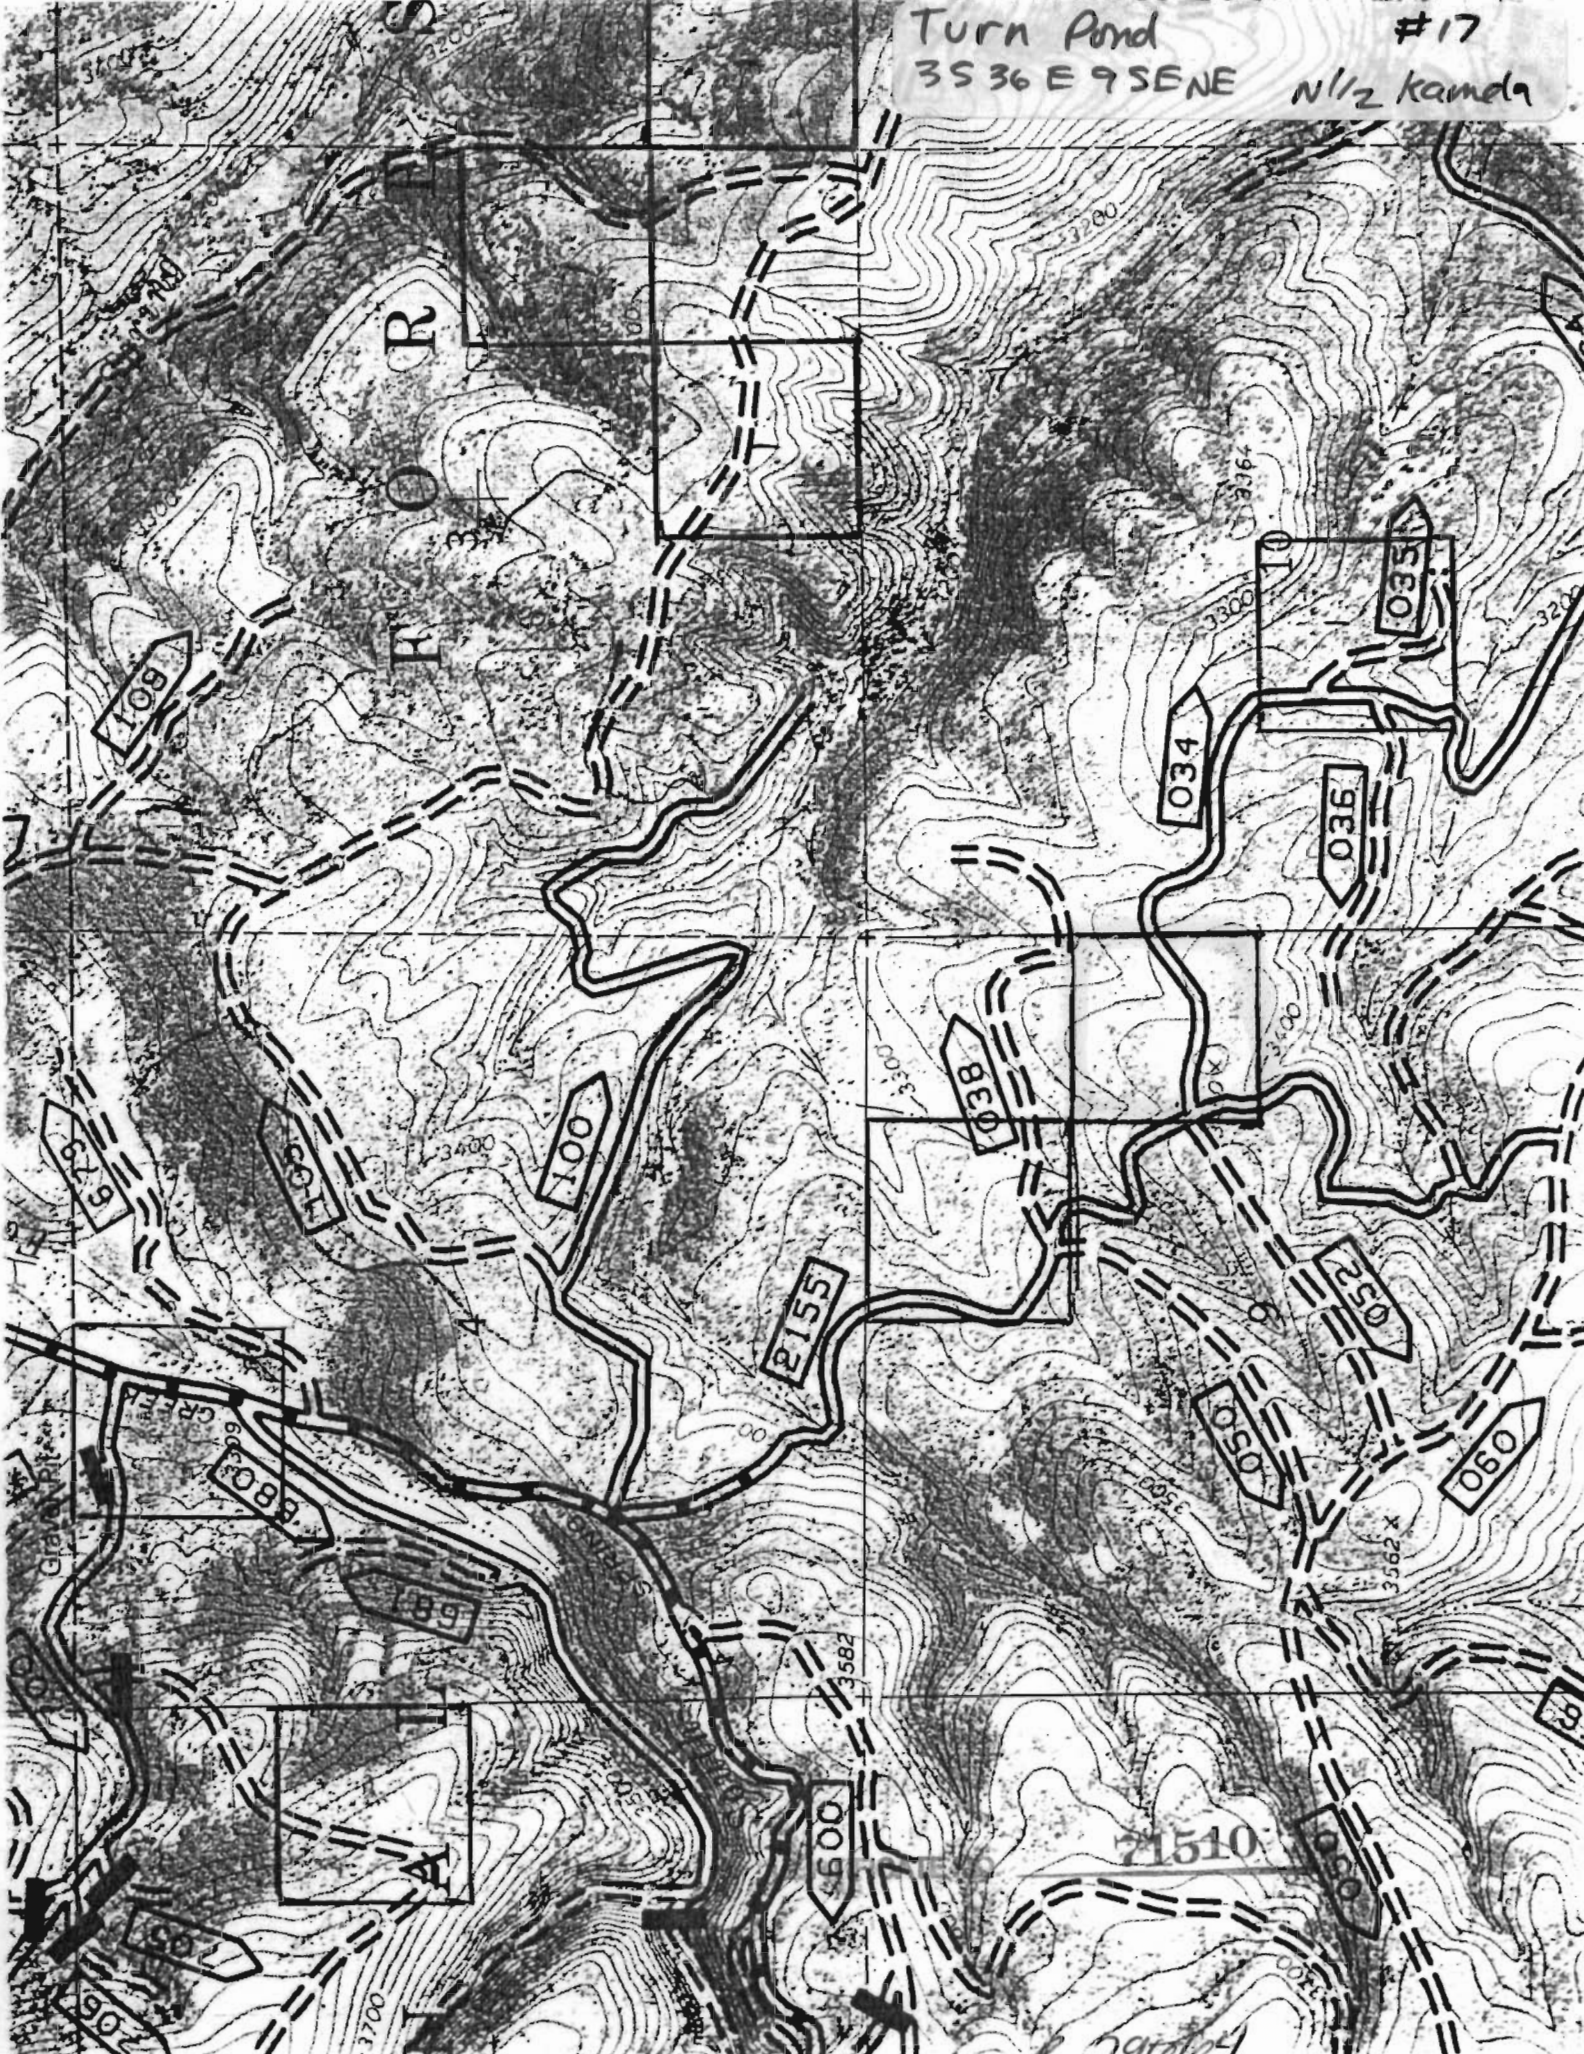

Upper Hunter And R-16
3S36E 7 NWE N1/2 Kamela

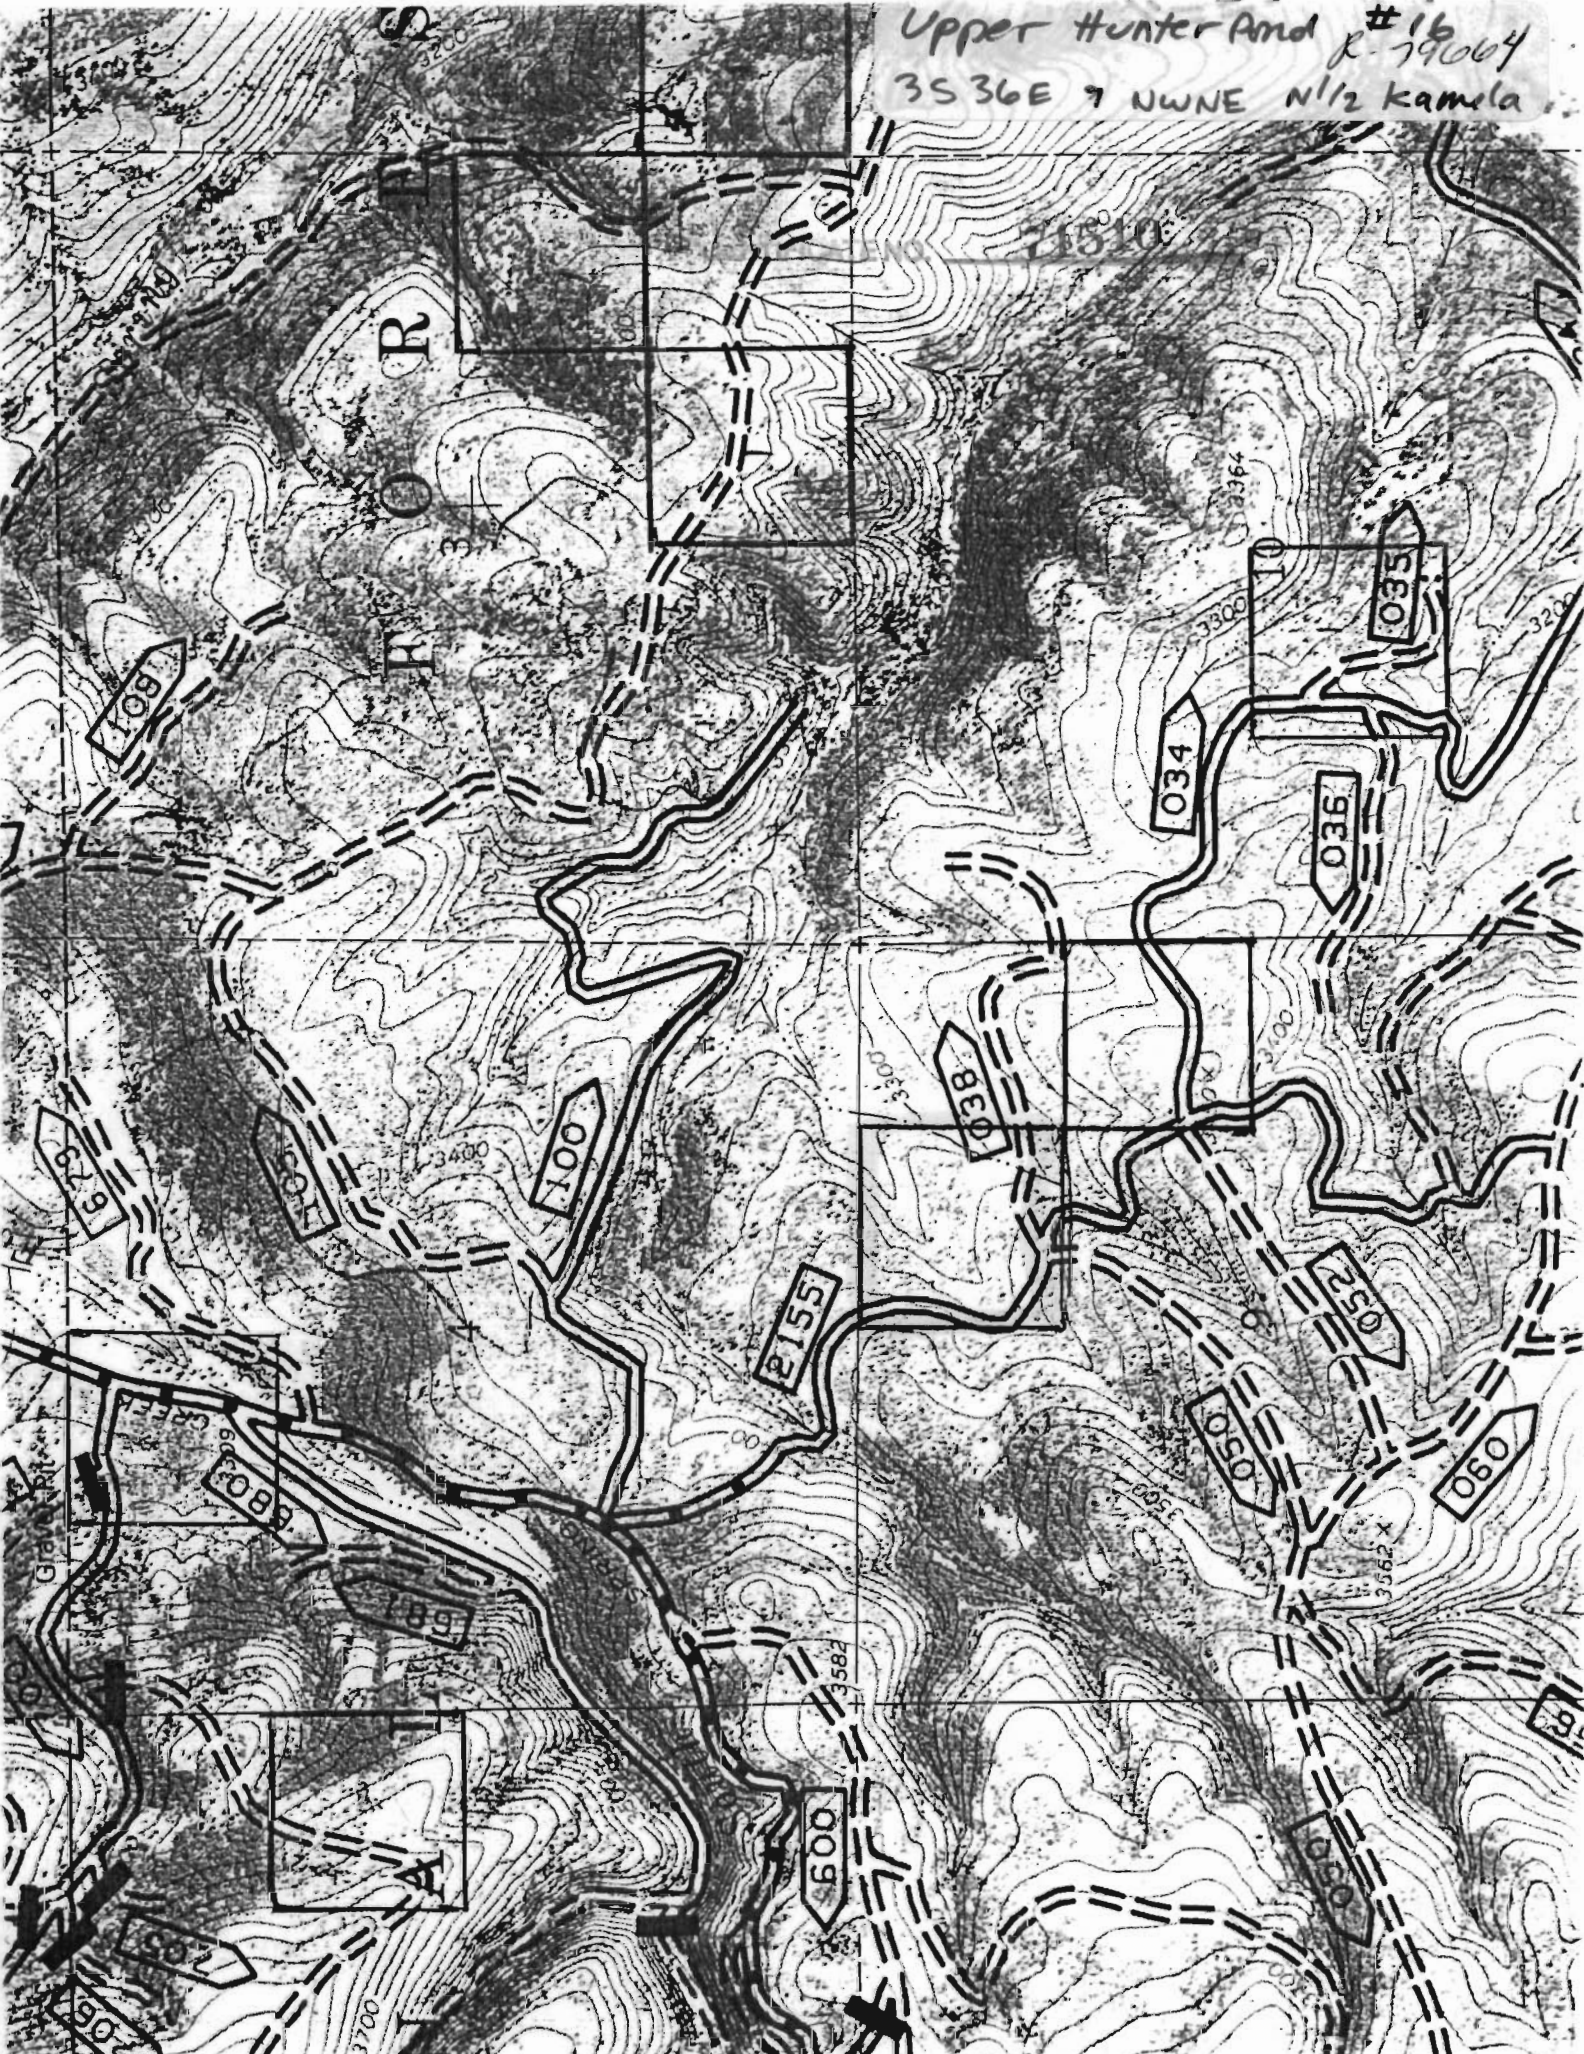

Shoe Camp Pond #15
3S36E 8SWNW N¹/₂ Kamela



Shady Rest Pond #14
3636E 1 NESE N 1/2 Kamole

