



[illegible]

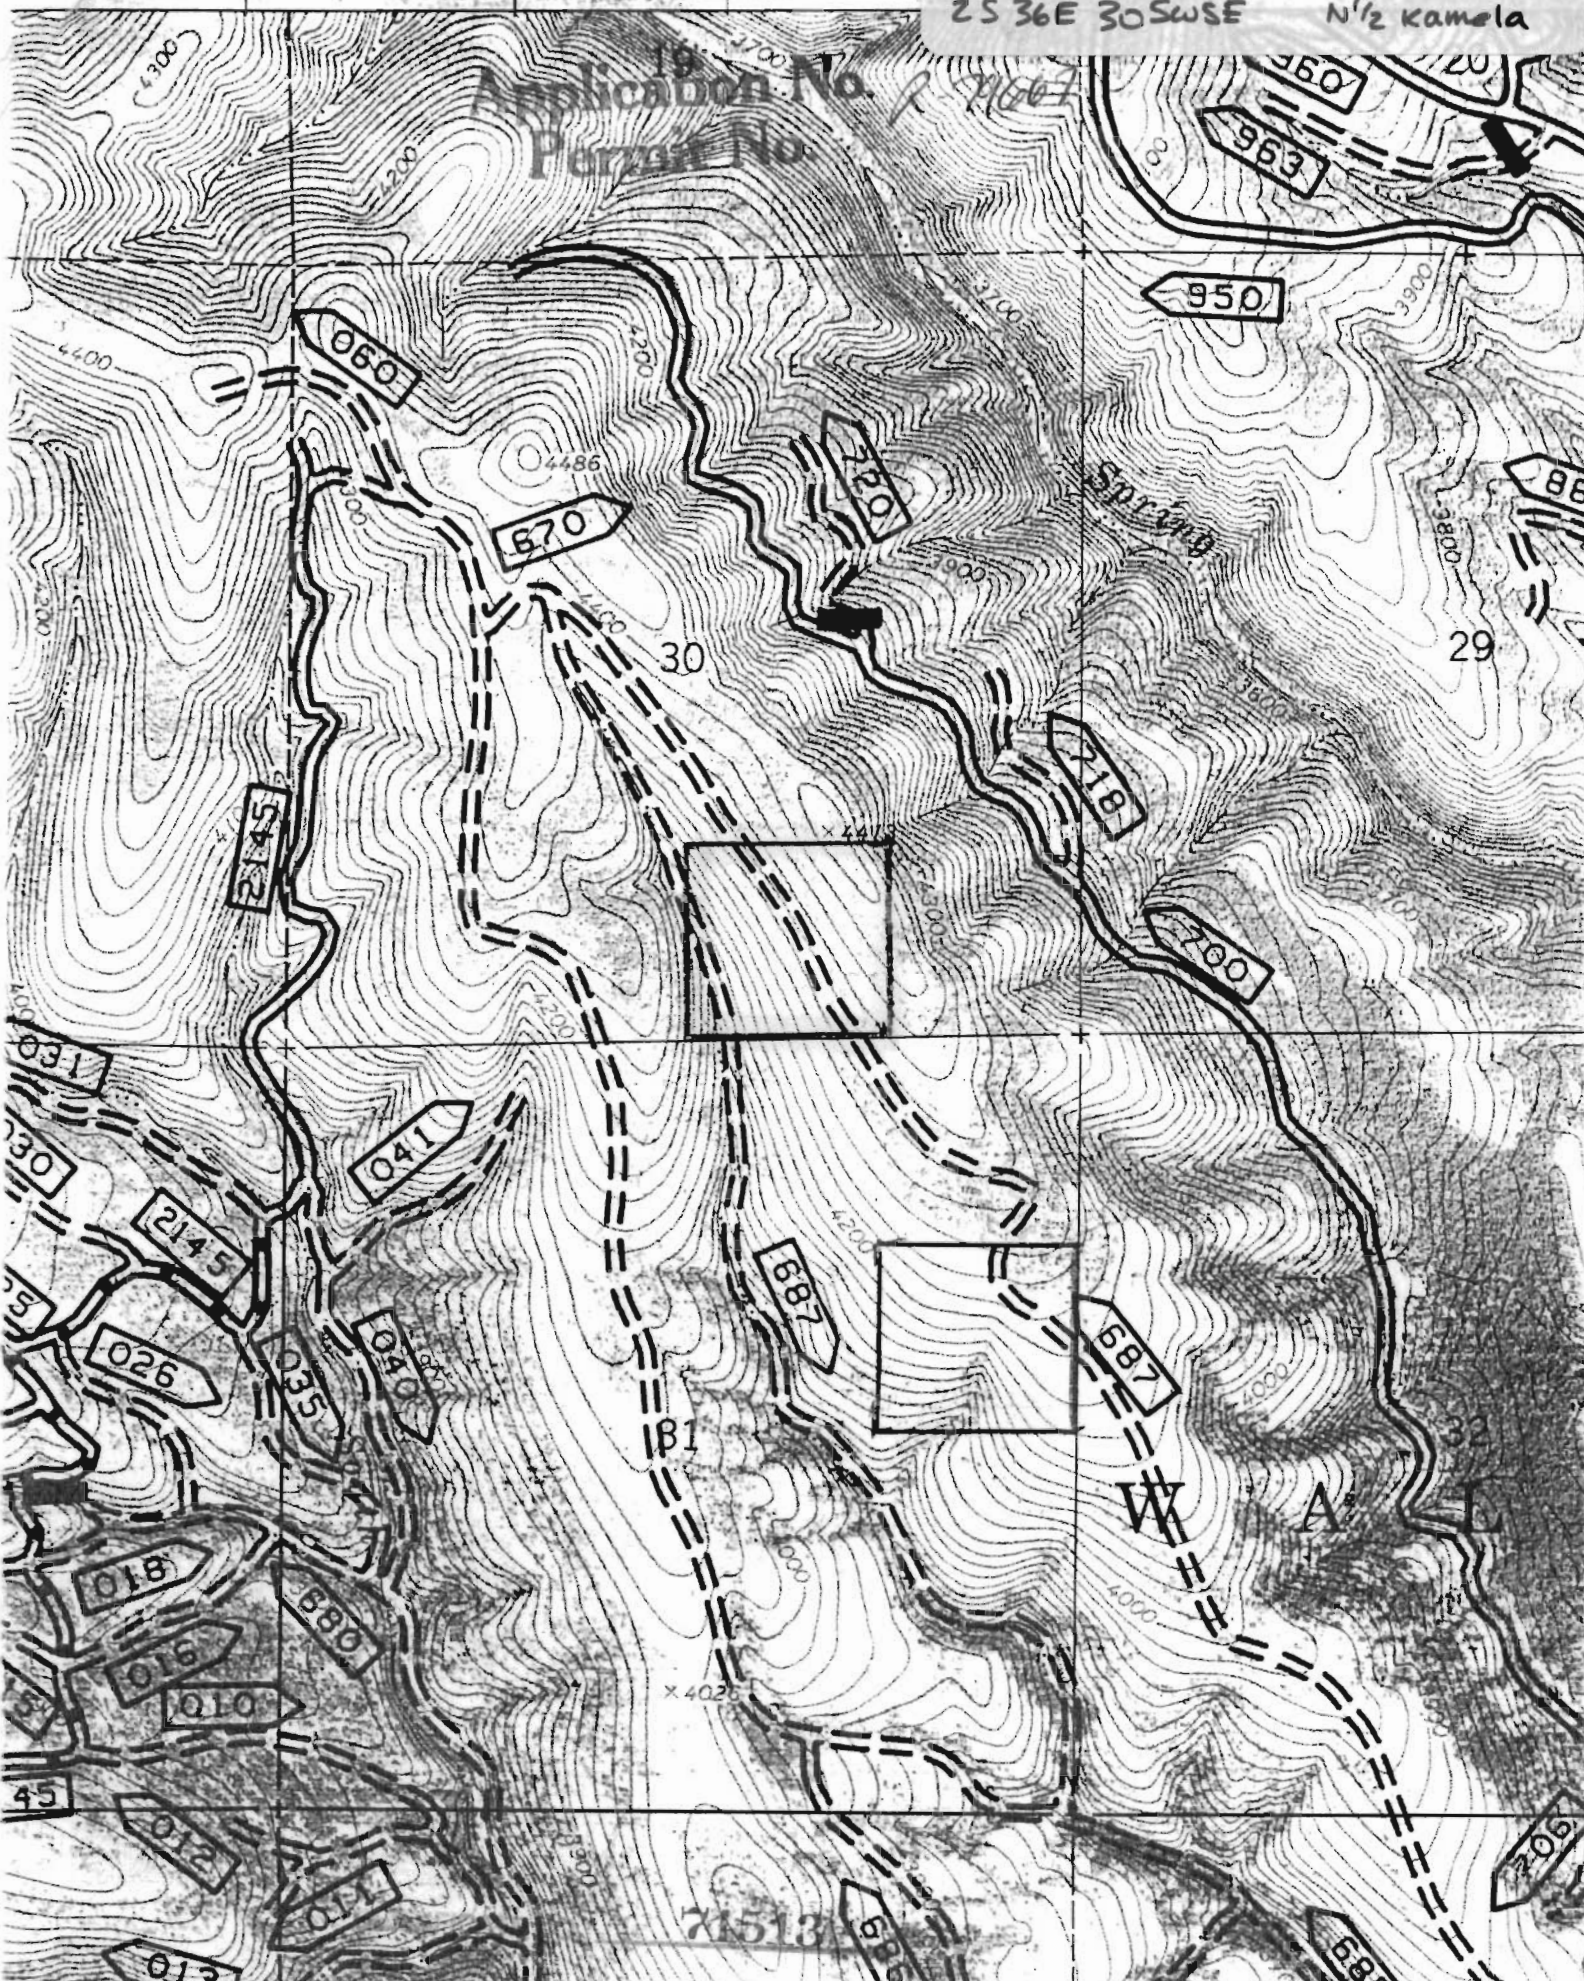

Application No. *879867*
Permit No.

Unnamed Pond #7
SS 35E 22 SESE N 1/2 FL7

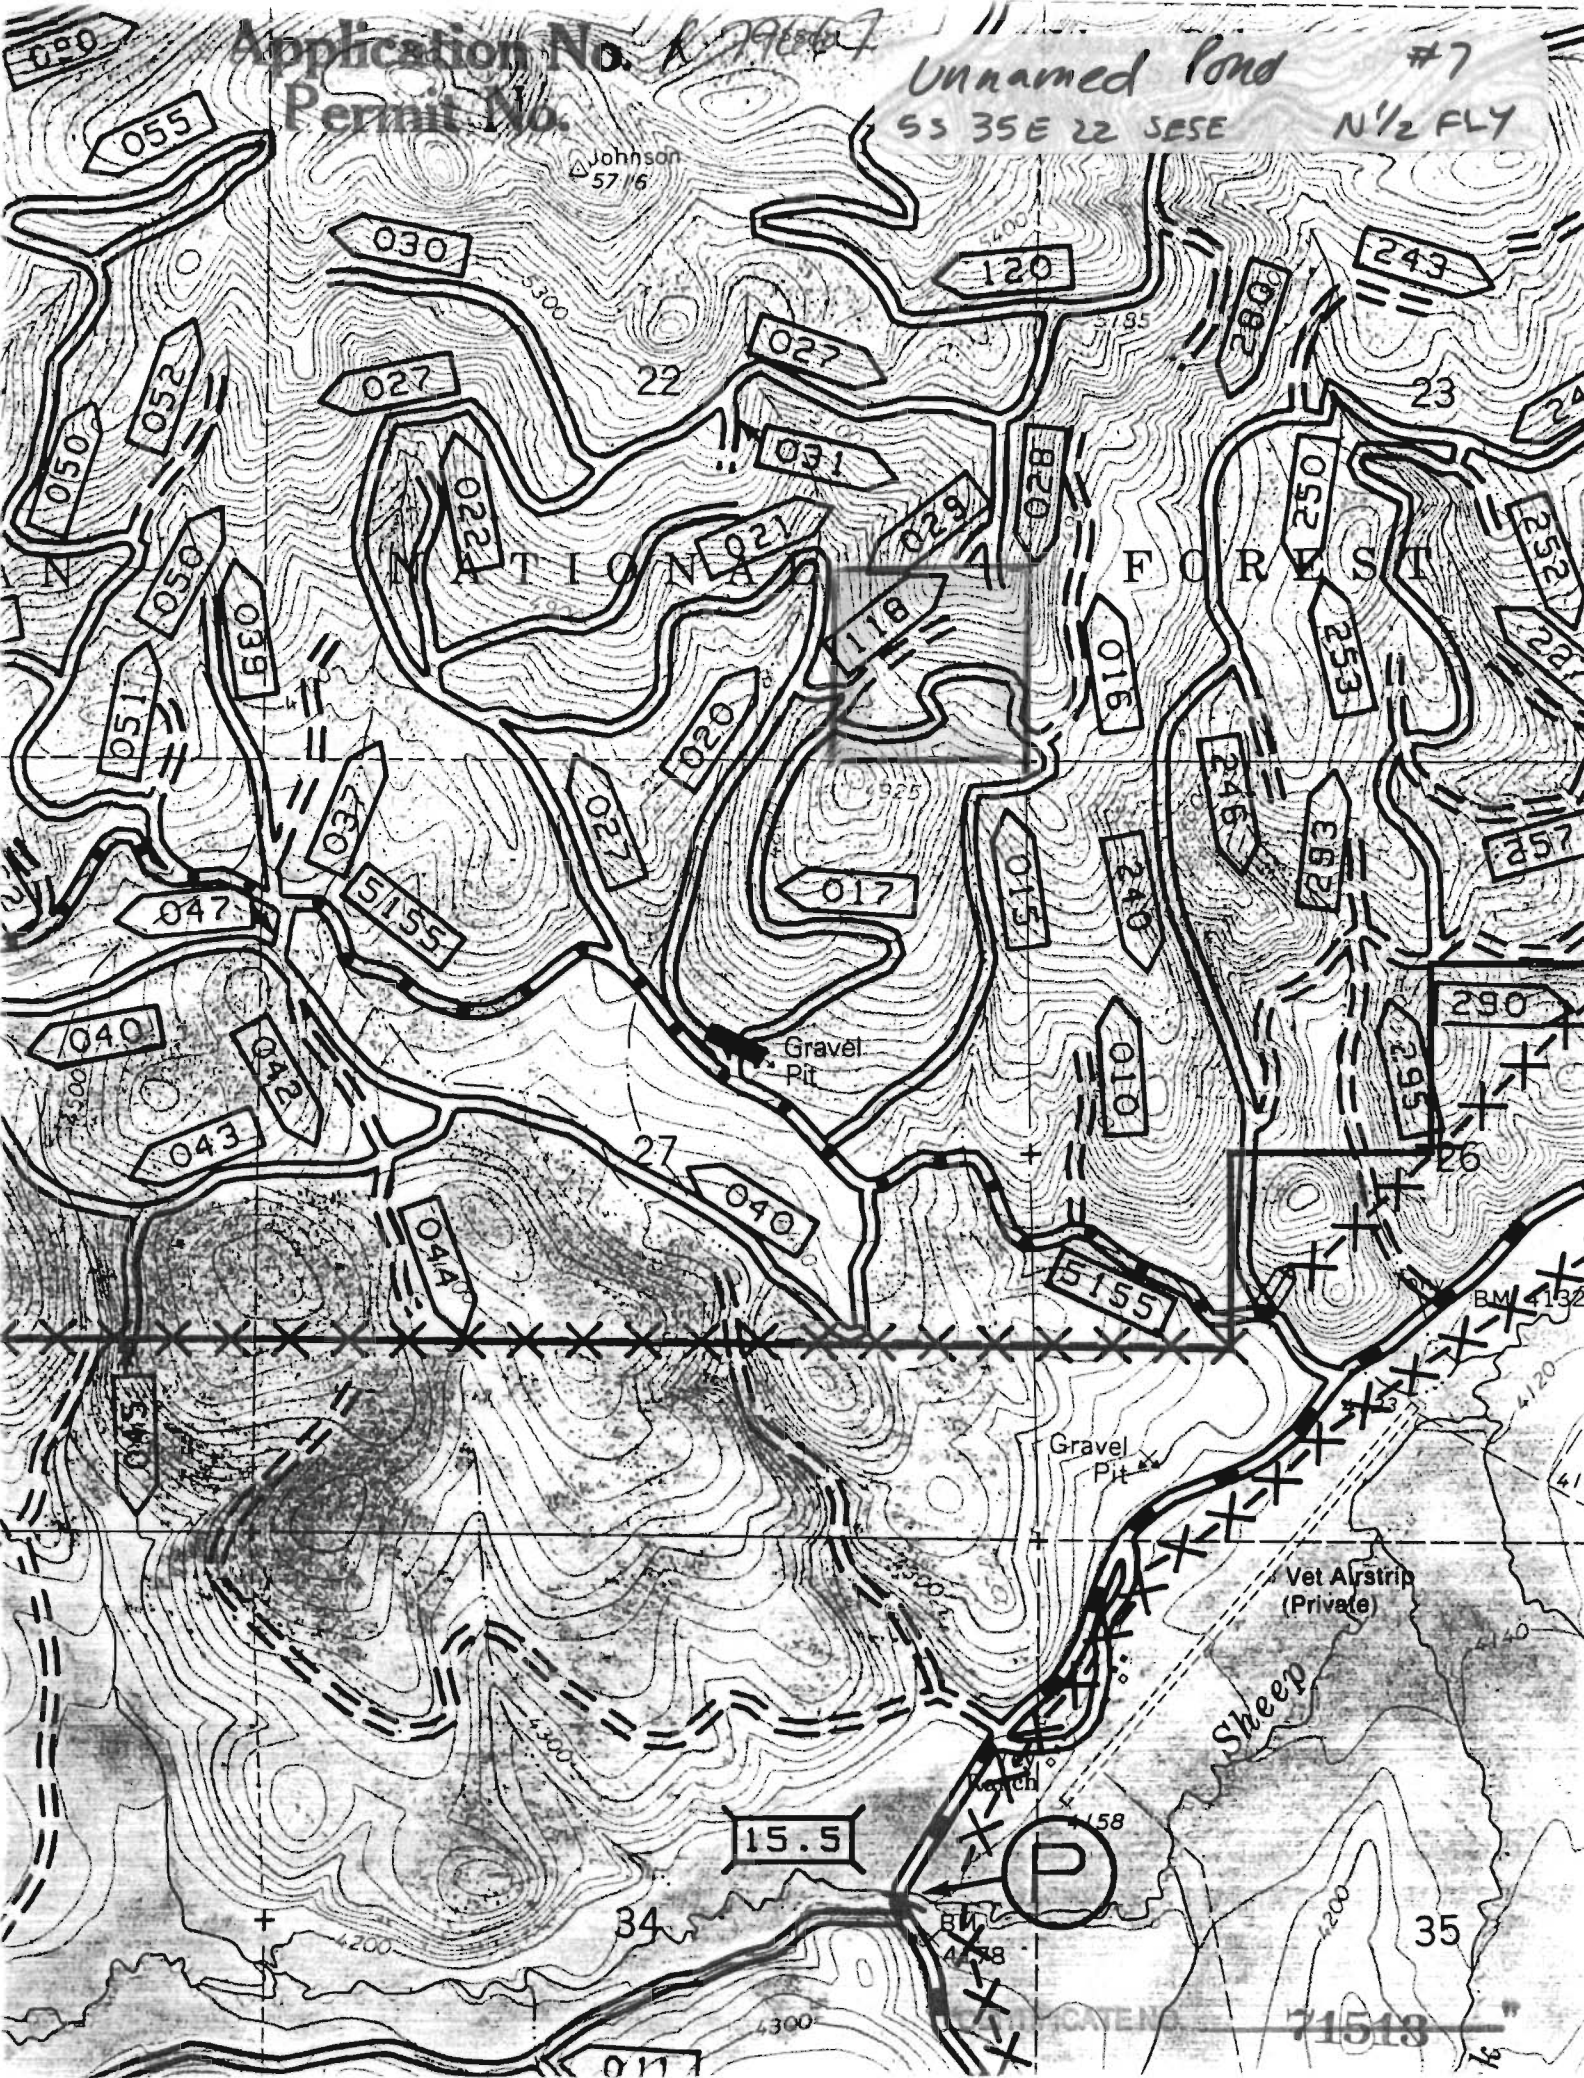

Johnson
57116

Gravel Pit

Gravel Pit

Vet Airstrip
(Private)

Sheep


15.5

P

71513

Johnson
5716

5657
M Avenue Pond #5
55 35E 27 NWSW N 1/2 FLY

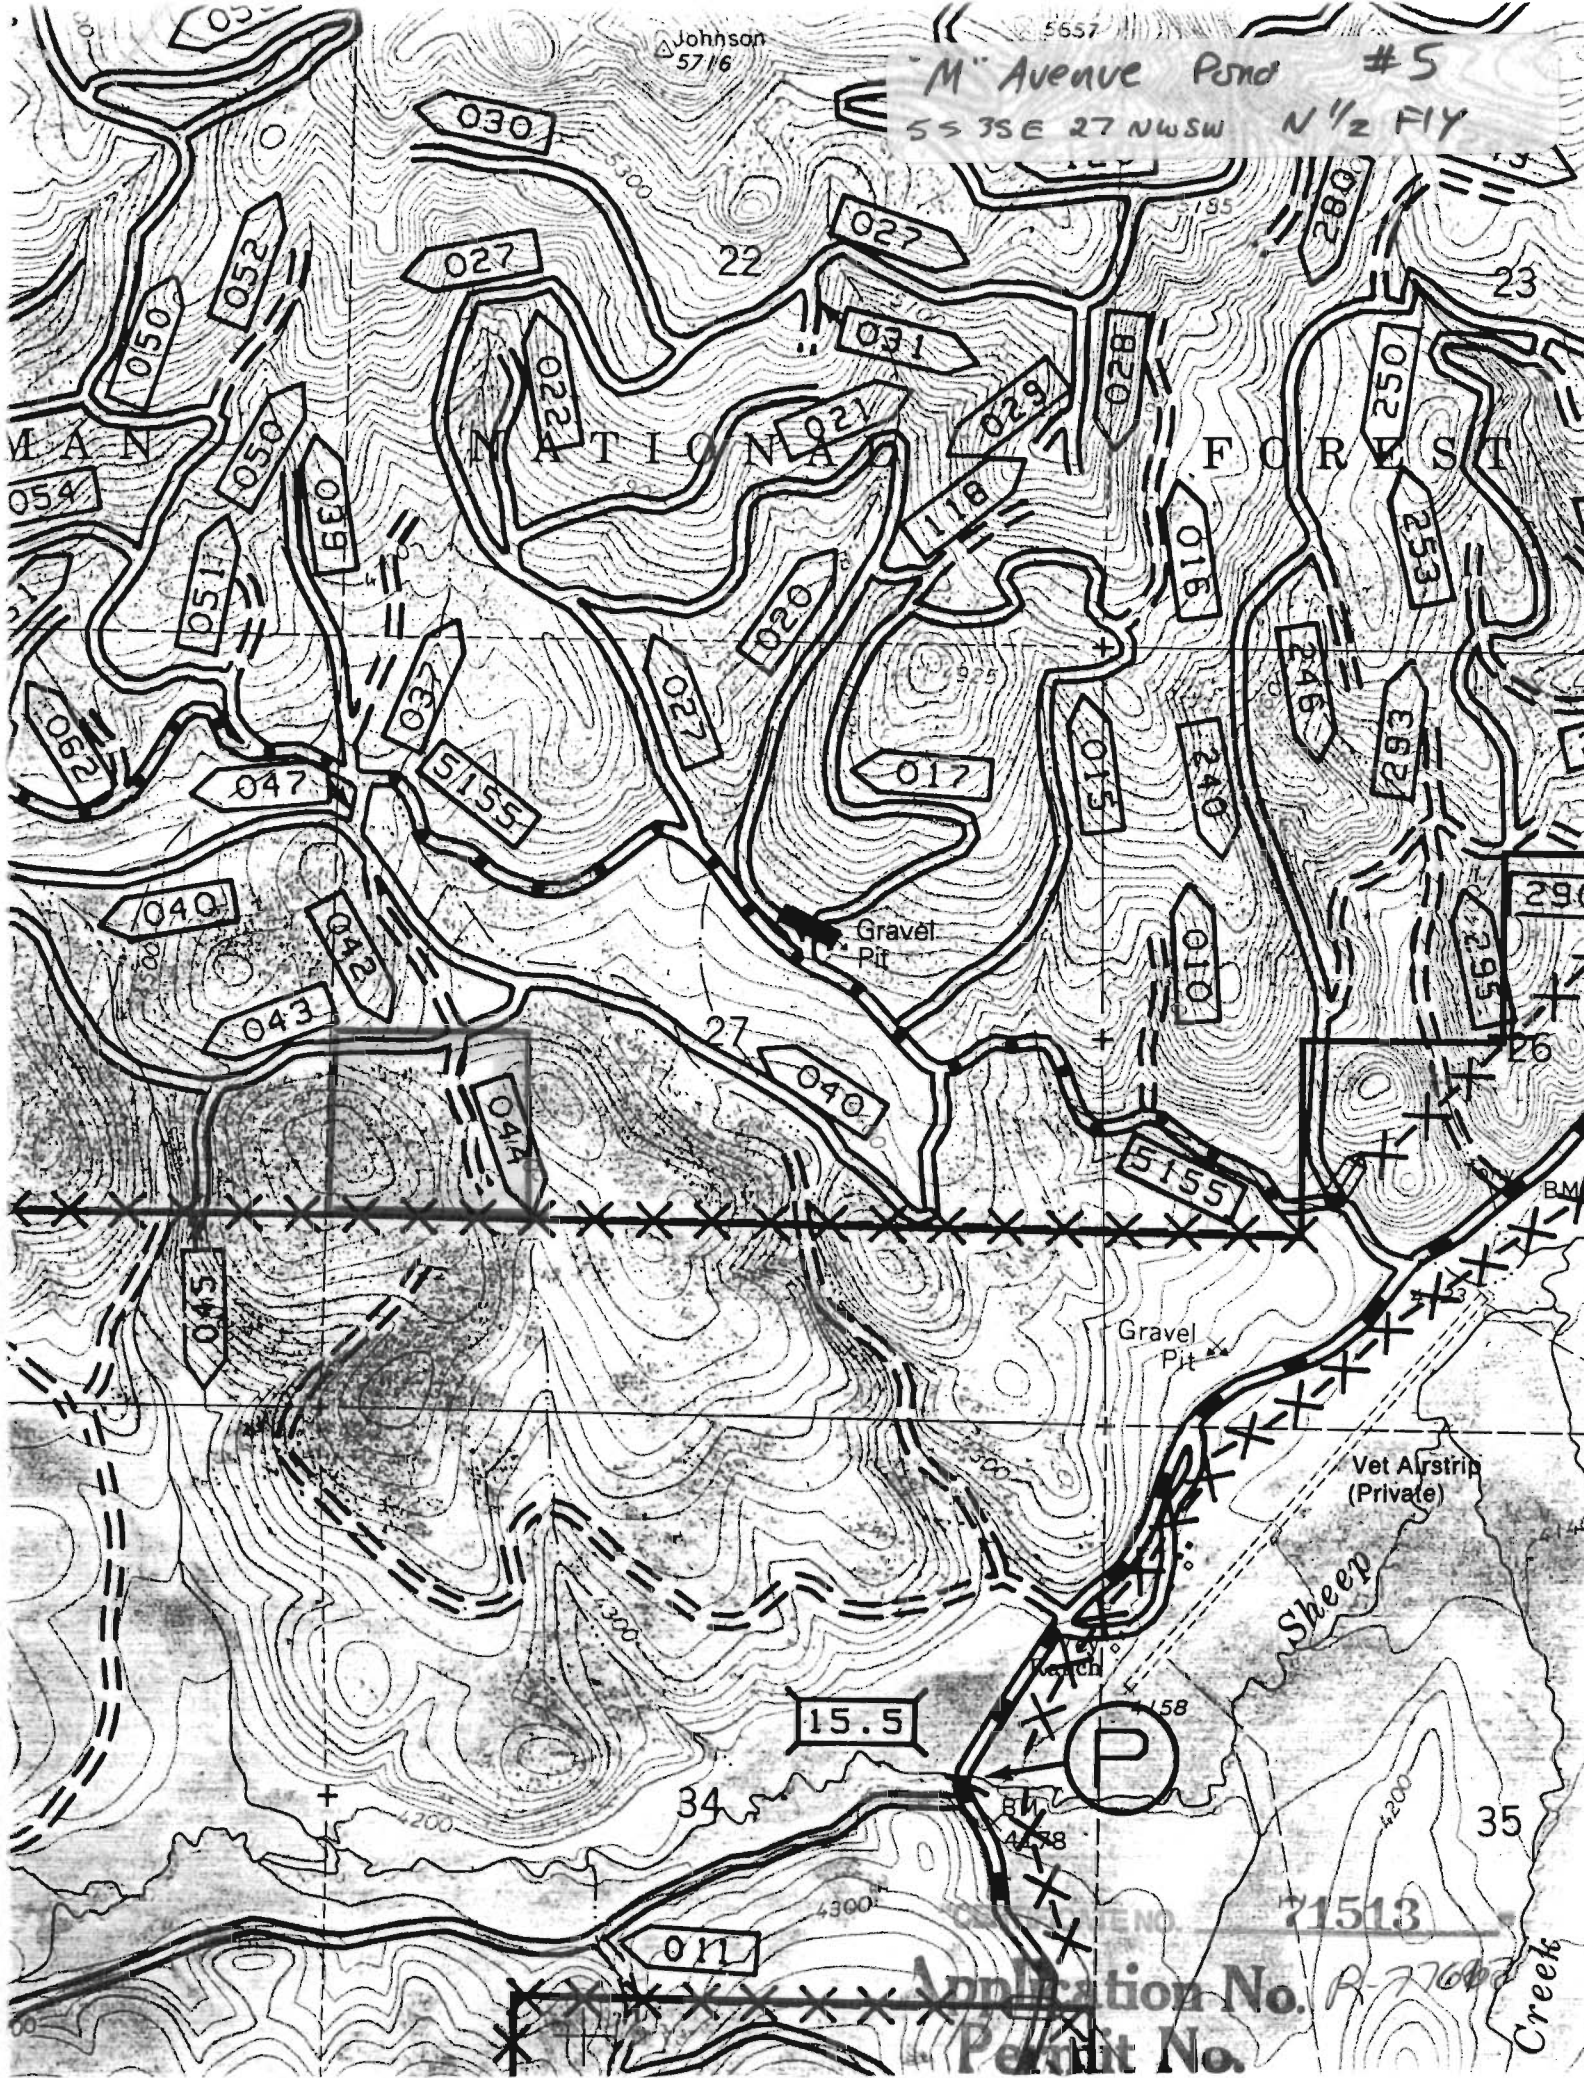

Application No. P-77600
Permit No.

Otis Flat Pond #2 (#25)
SS3SE6NENW S1/2 Marley

Application No. *L 79667*

Permit No. 71513 W. A. L. 32%