


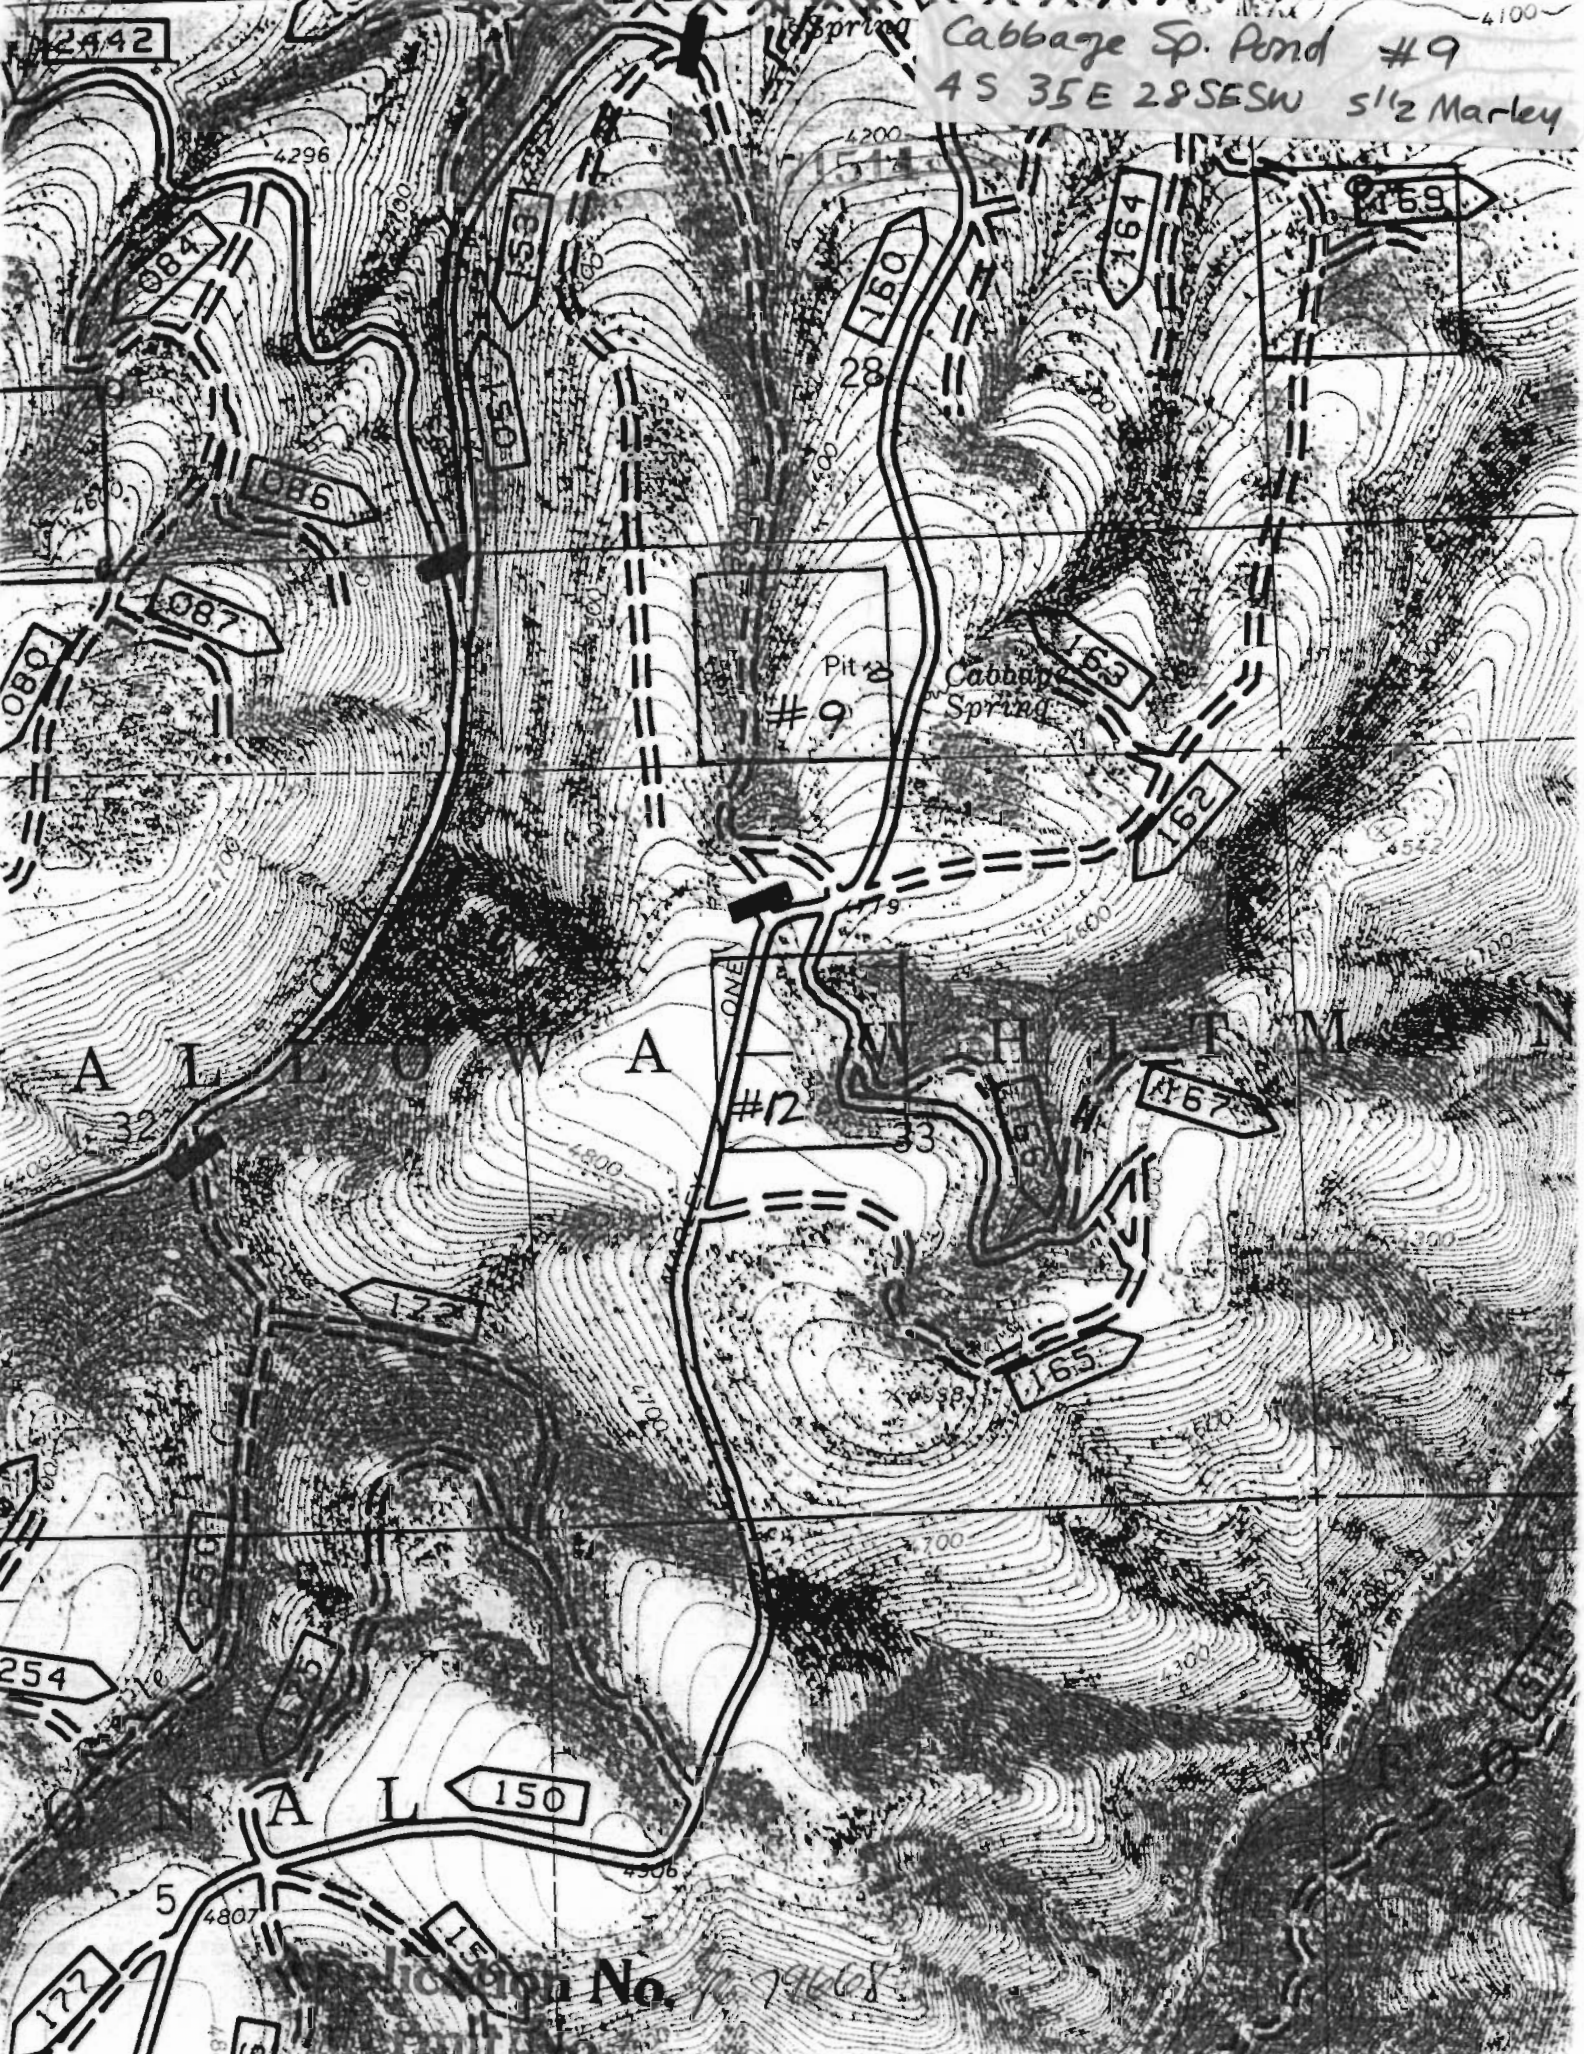

Cabbage Sp. Pond #9
4 S 35 E 28 SE SW 5 1/2 Marley

Pit #9

Cabbage Spring

ONE

#12

Location No. 79668


Application No. R. 796608
Permit No.

Basin Pond #10
4S35E27SWNW N¹/₂Marley



2442

Dam Road Pond #12
4S 35E 33 SENW S 1/2 Marley

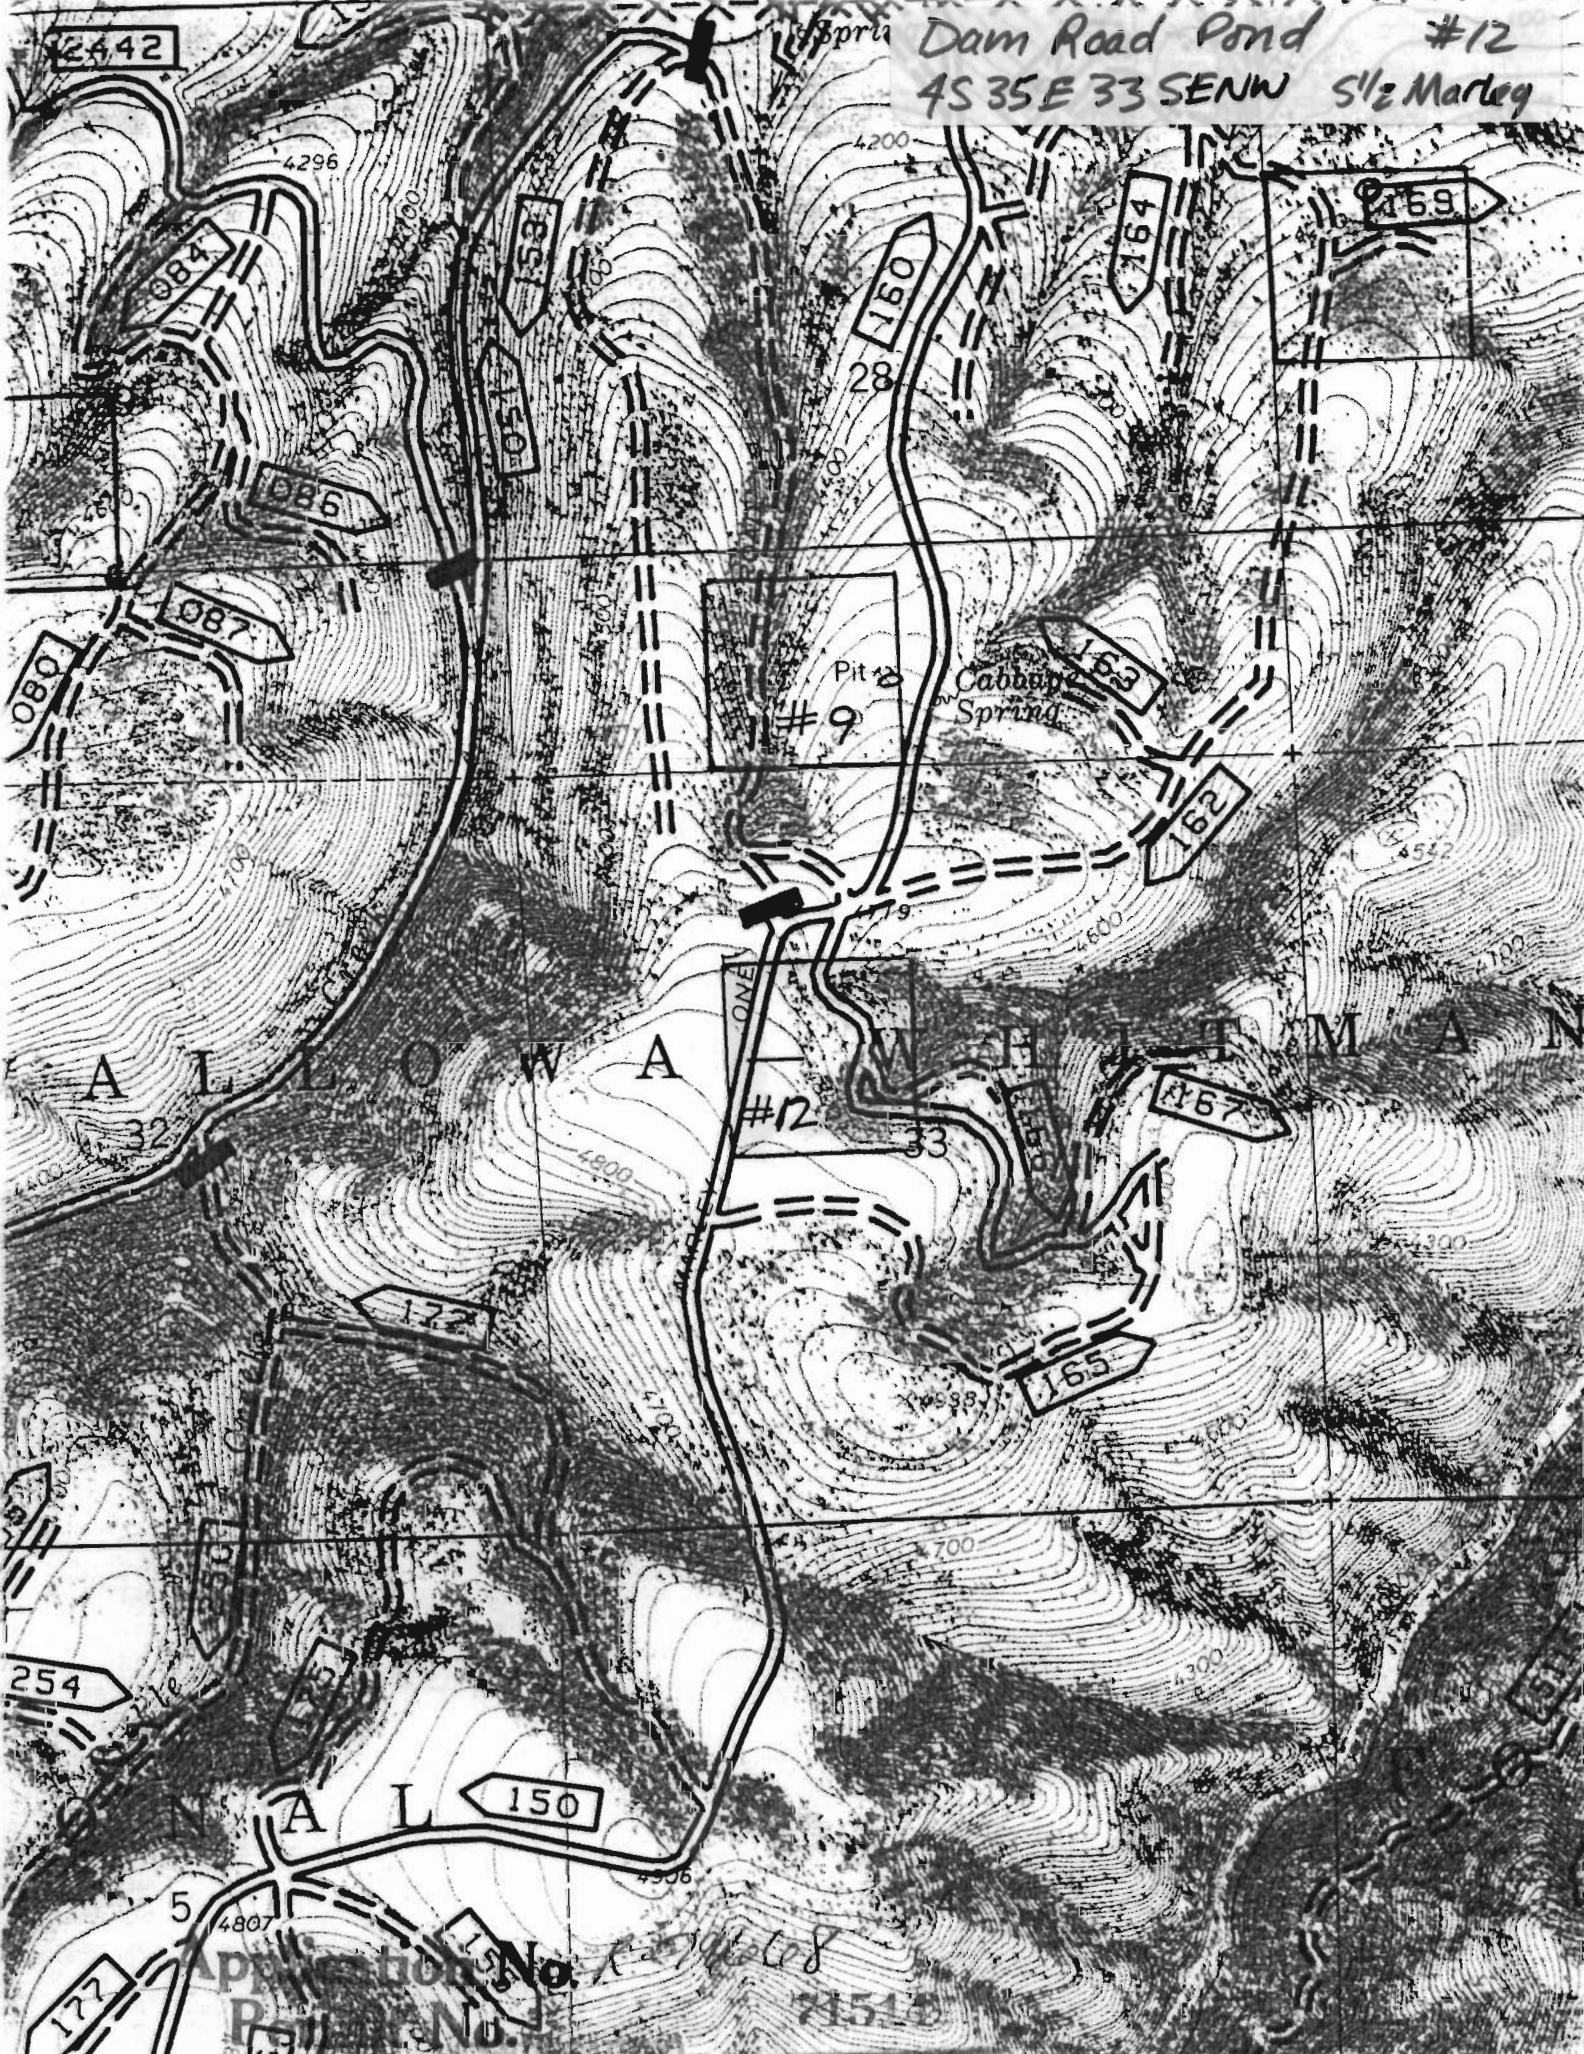


Application No. R-79608


Page No. 1

71510


Otis Flat Pond #1 (#13)
5S35E6NENW S 1/2 Marley

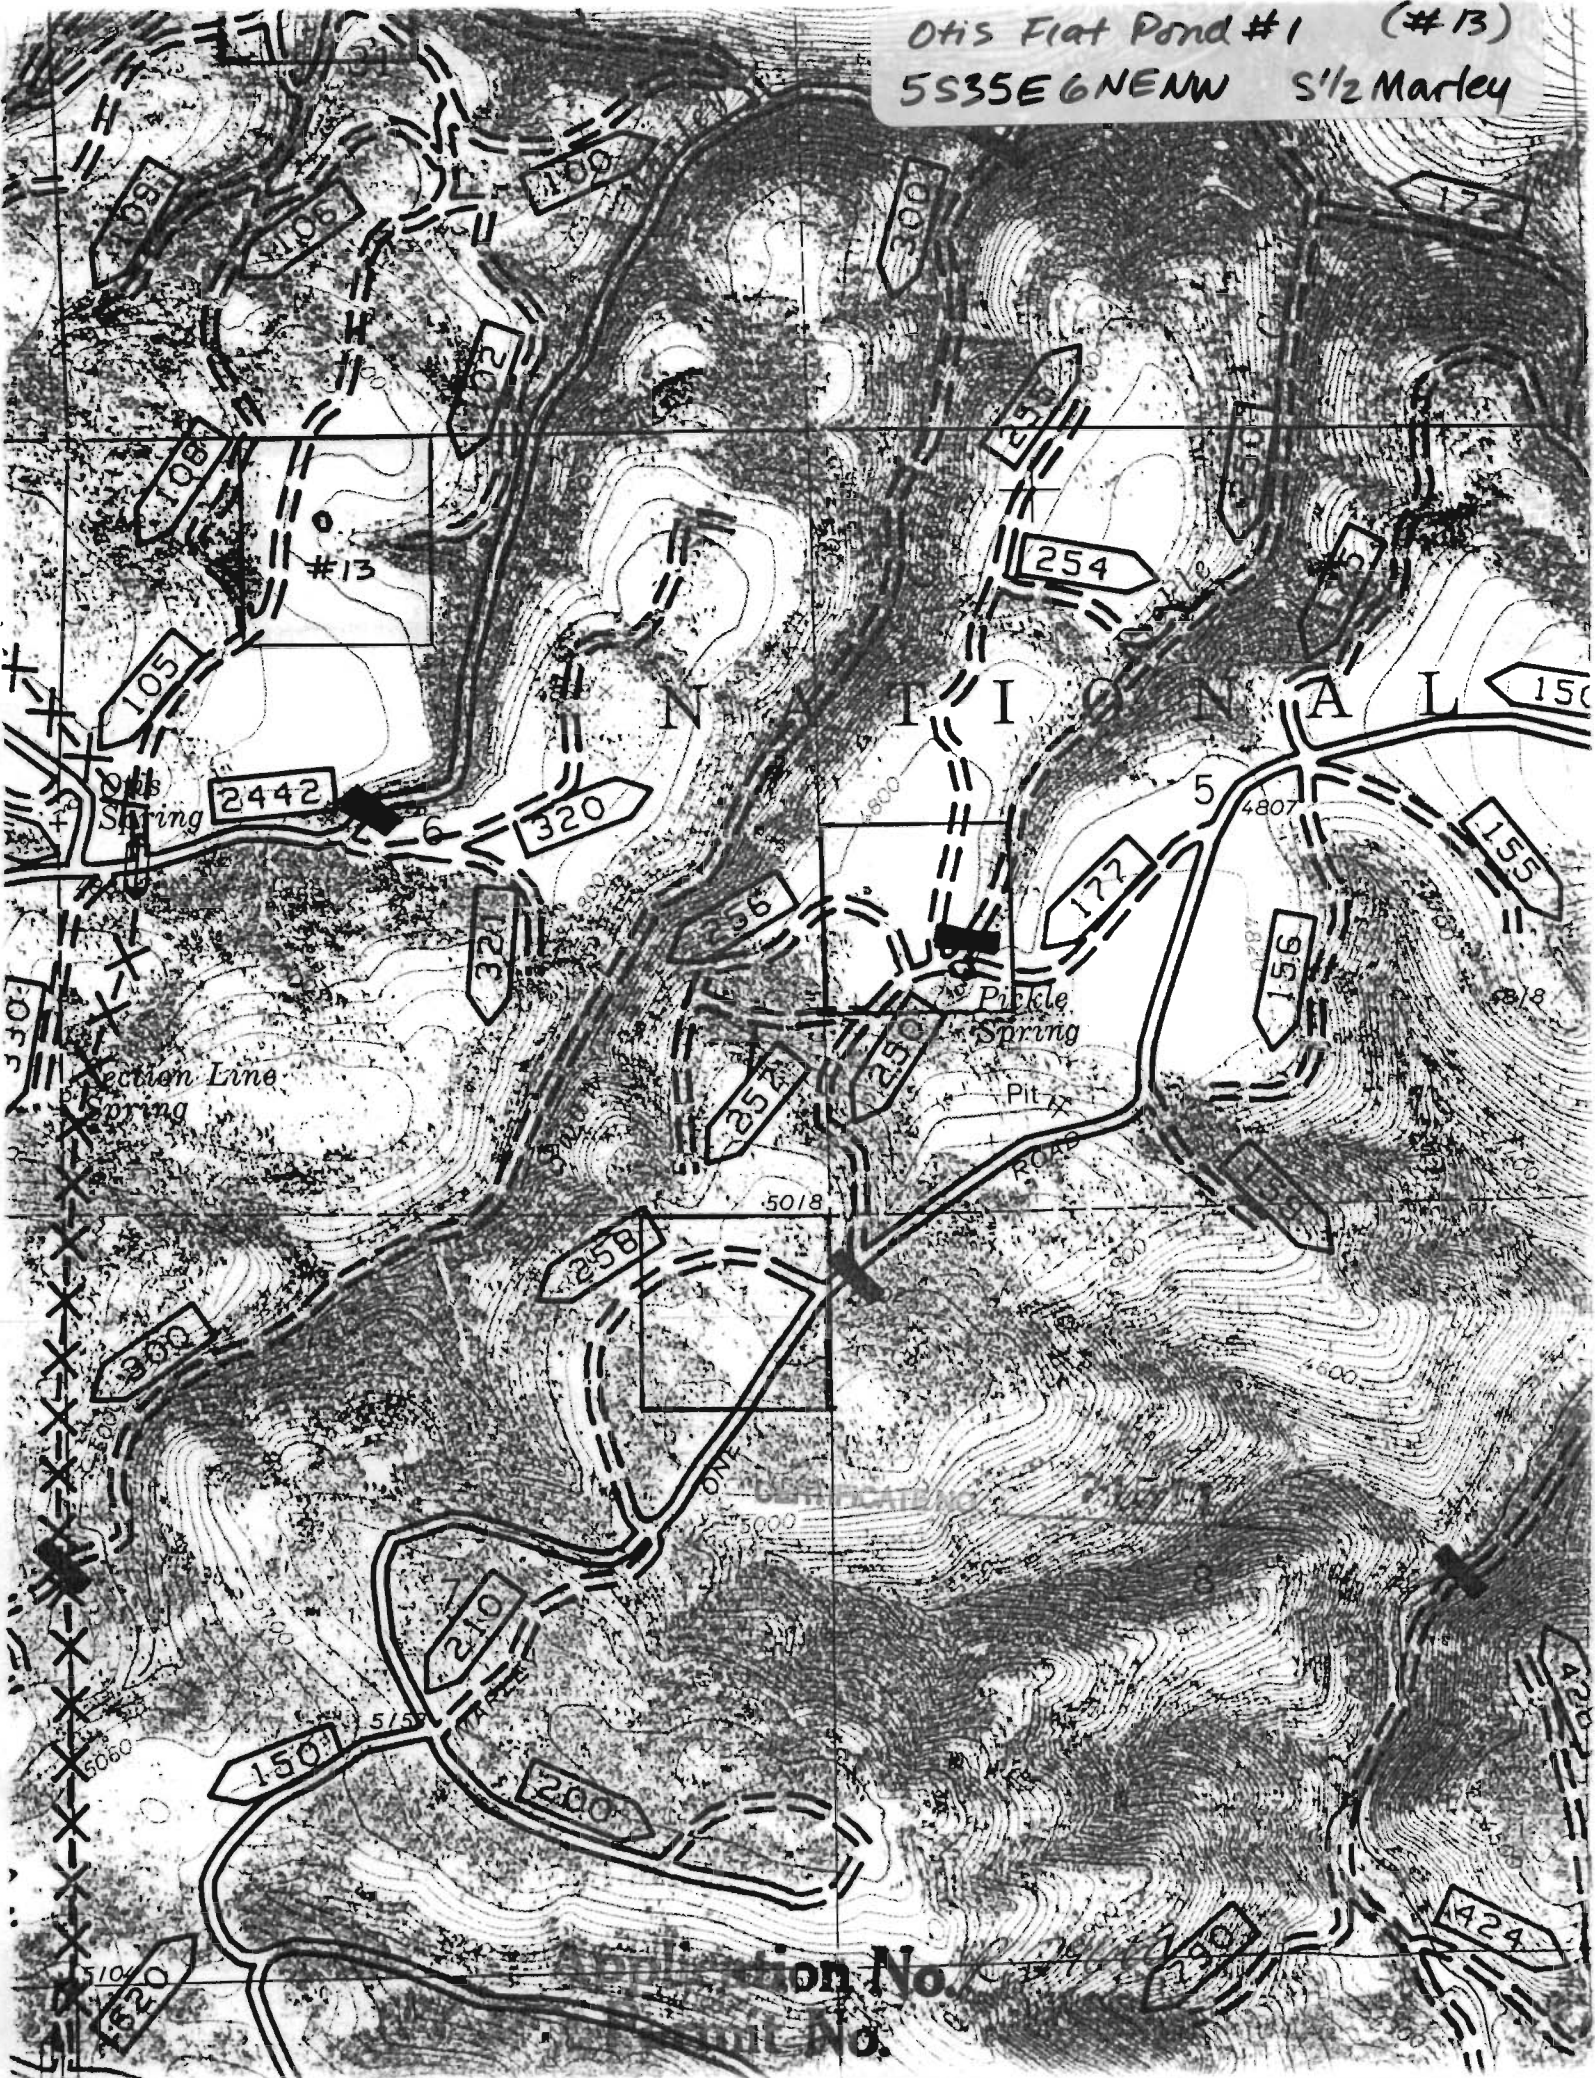

Upper Pickle Pond #16
R 74608
5S3SE7NENE S1/2 Marley

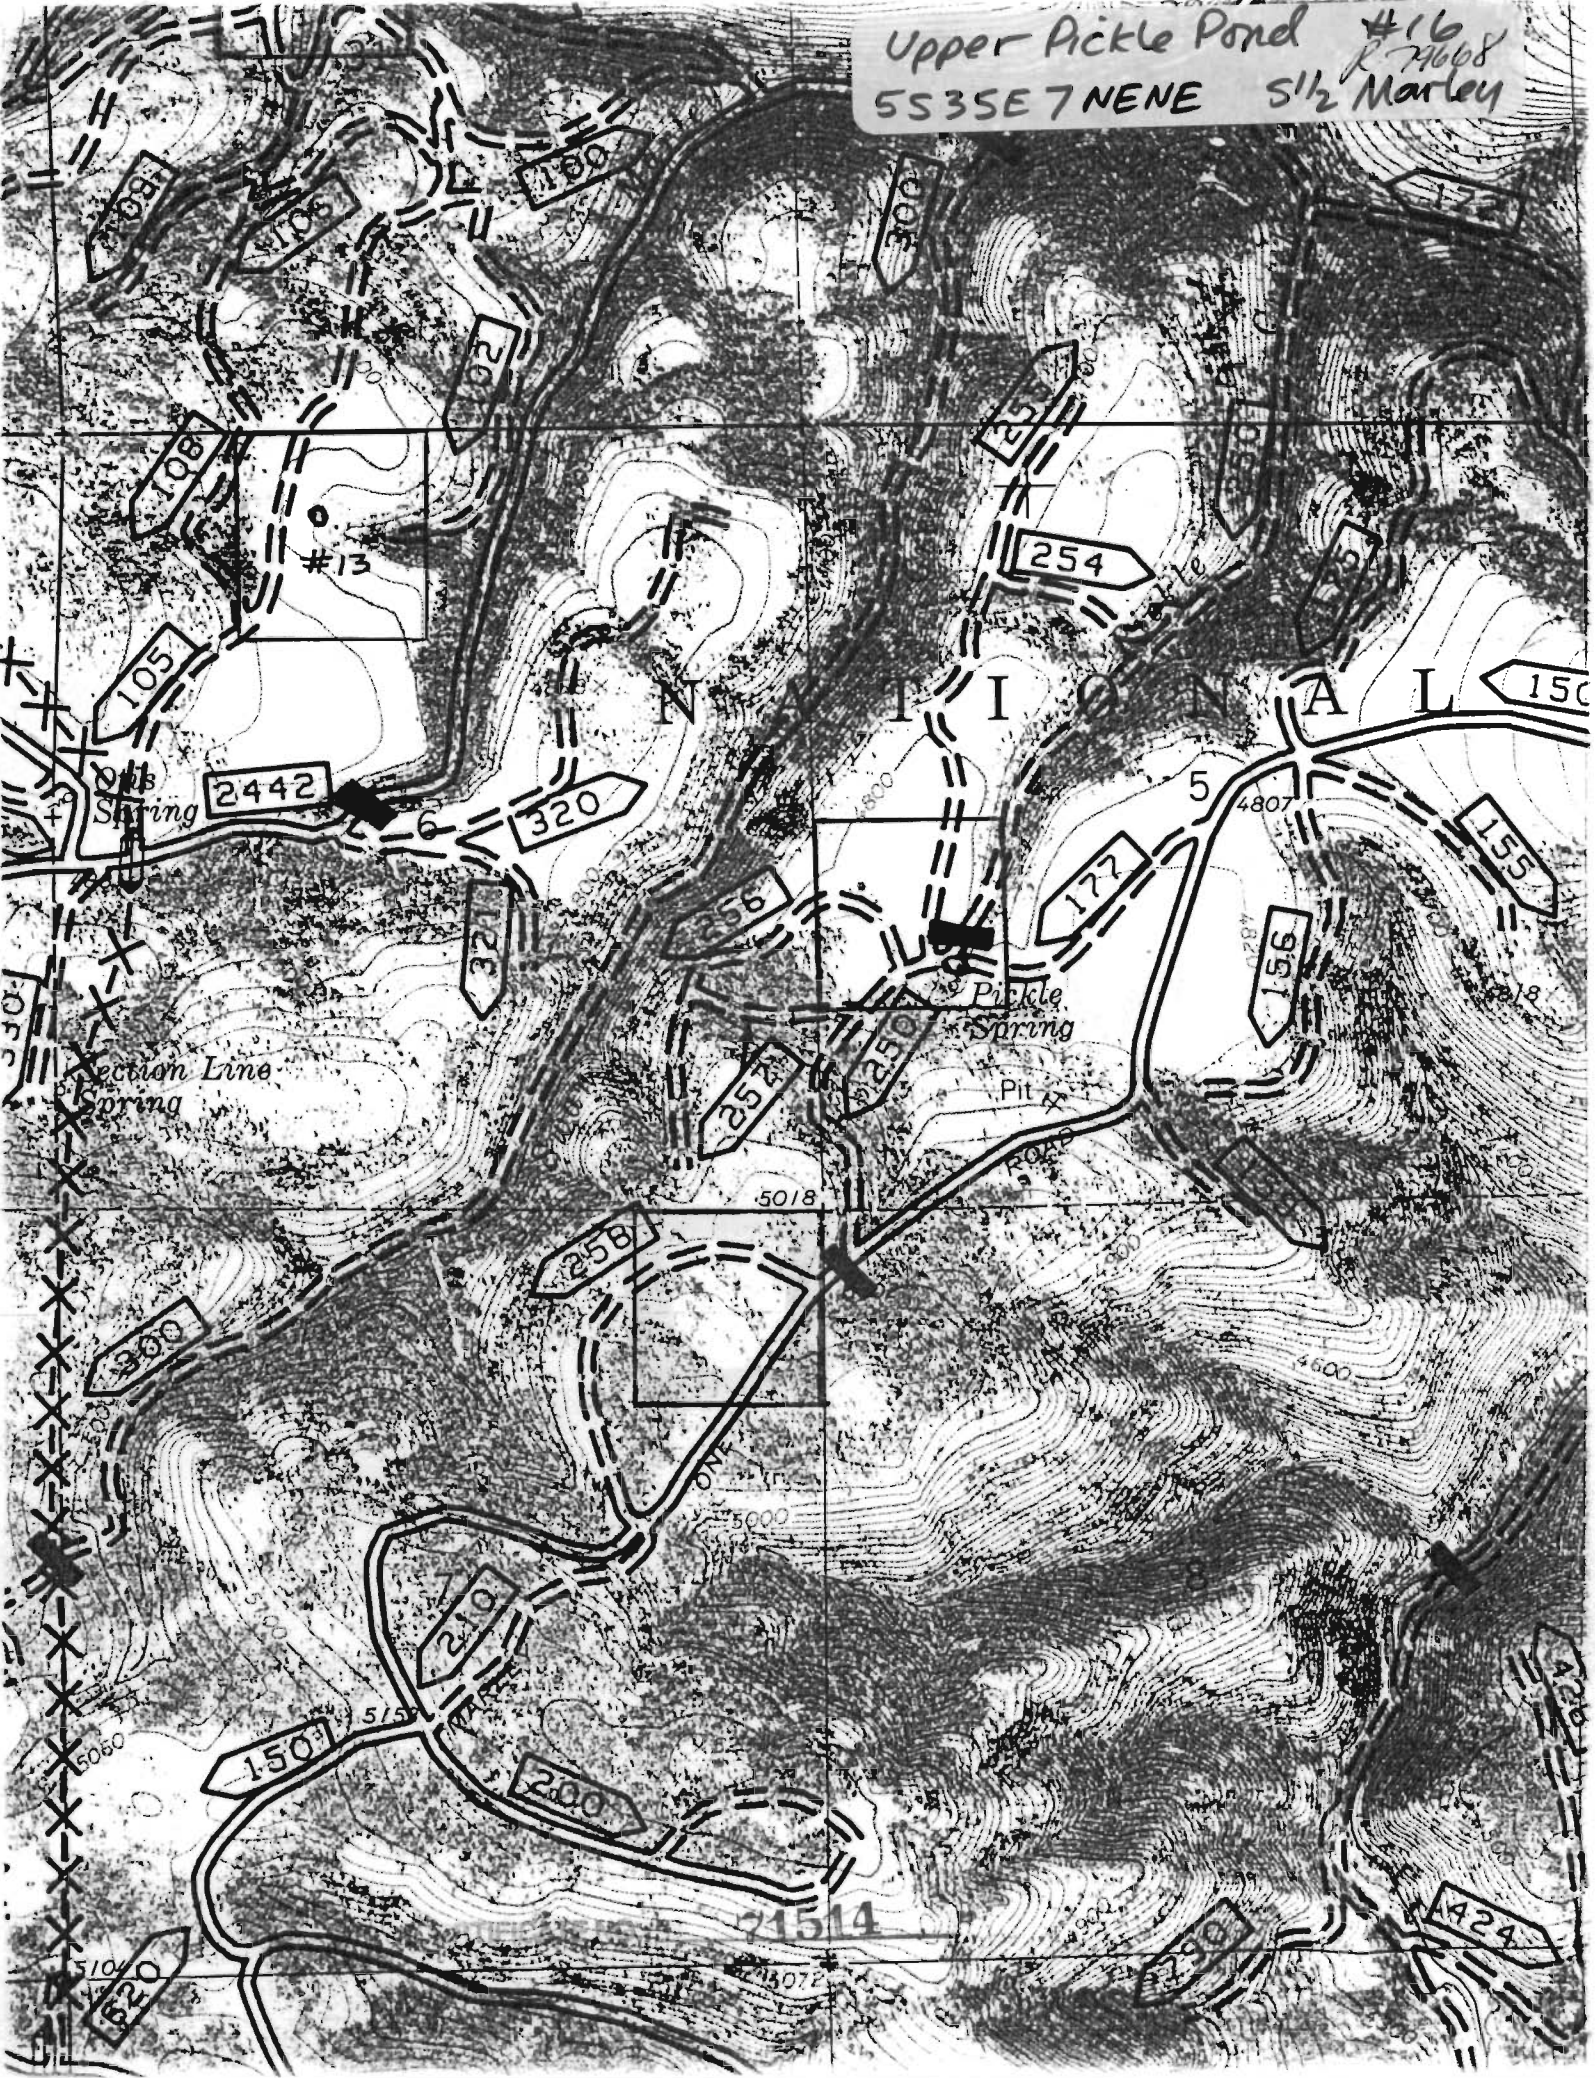


Elkana Pond #2 (#17)
4S35E17NWSW N 1/2 Marley

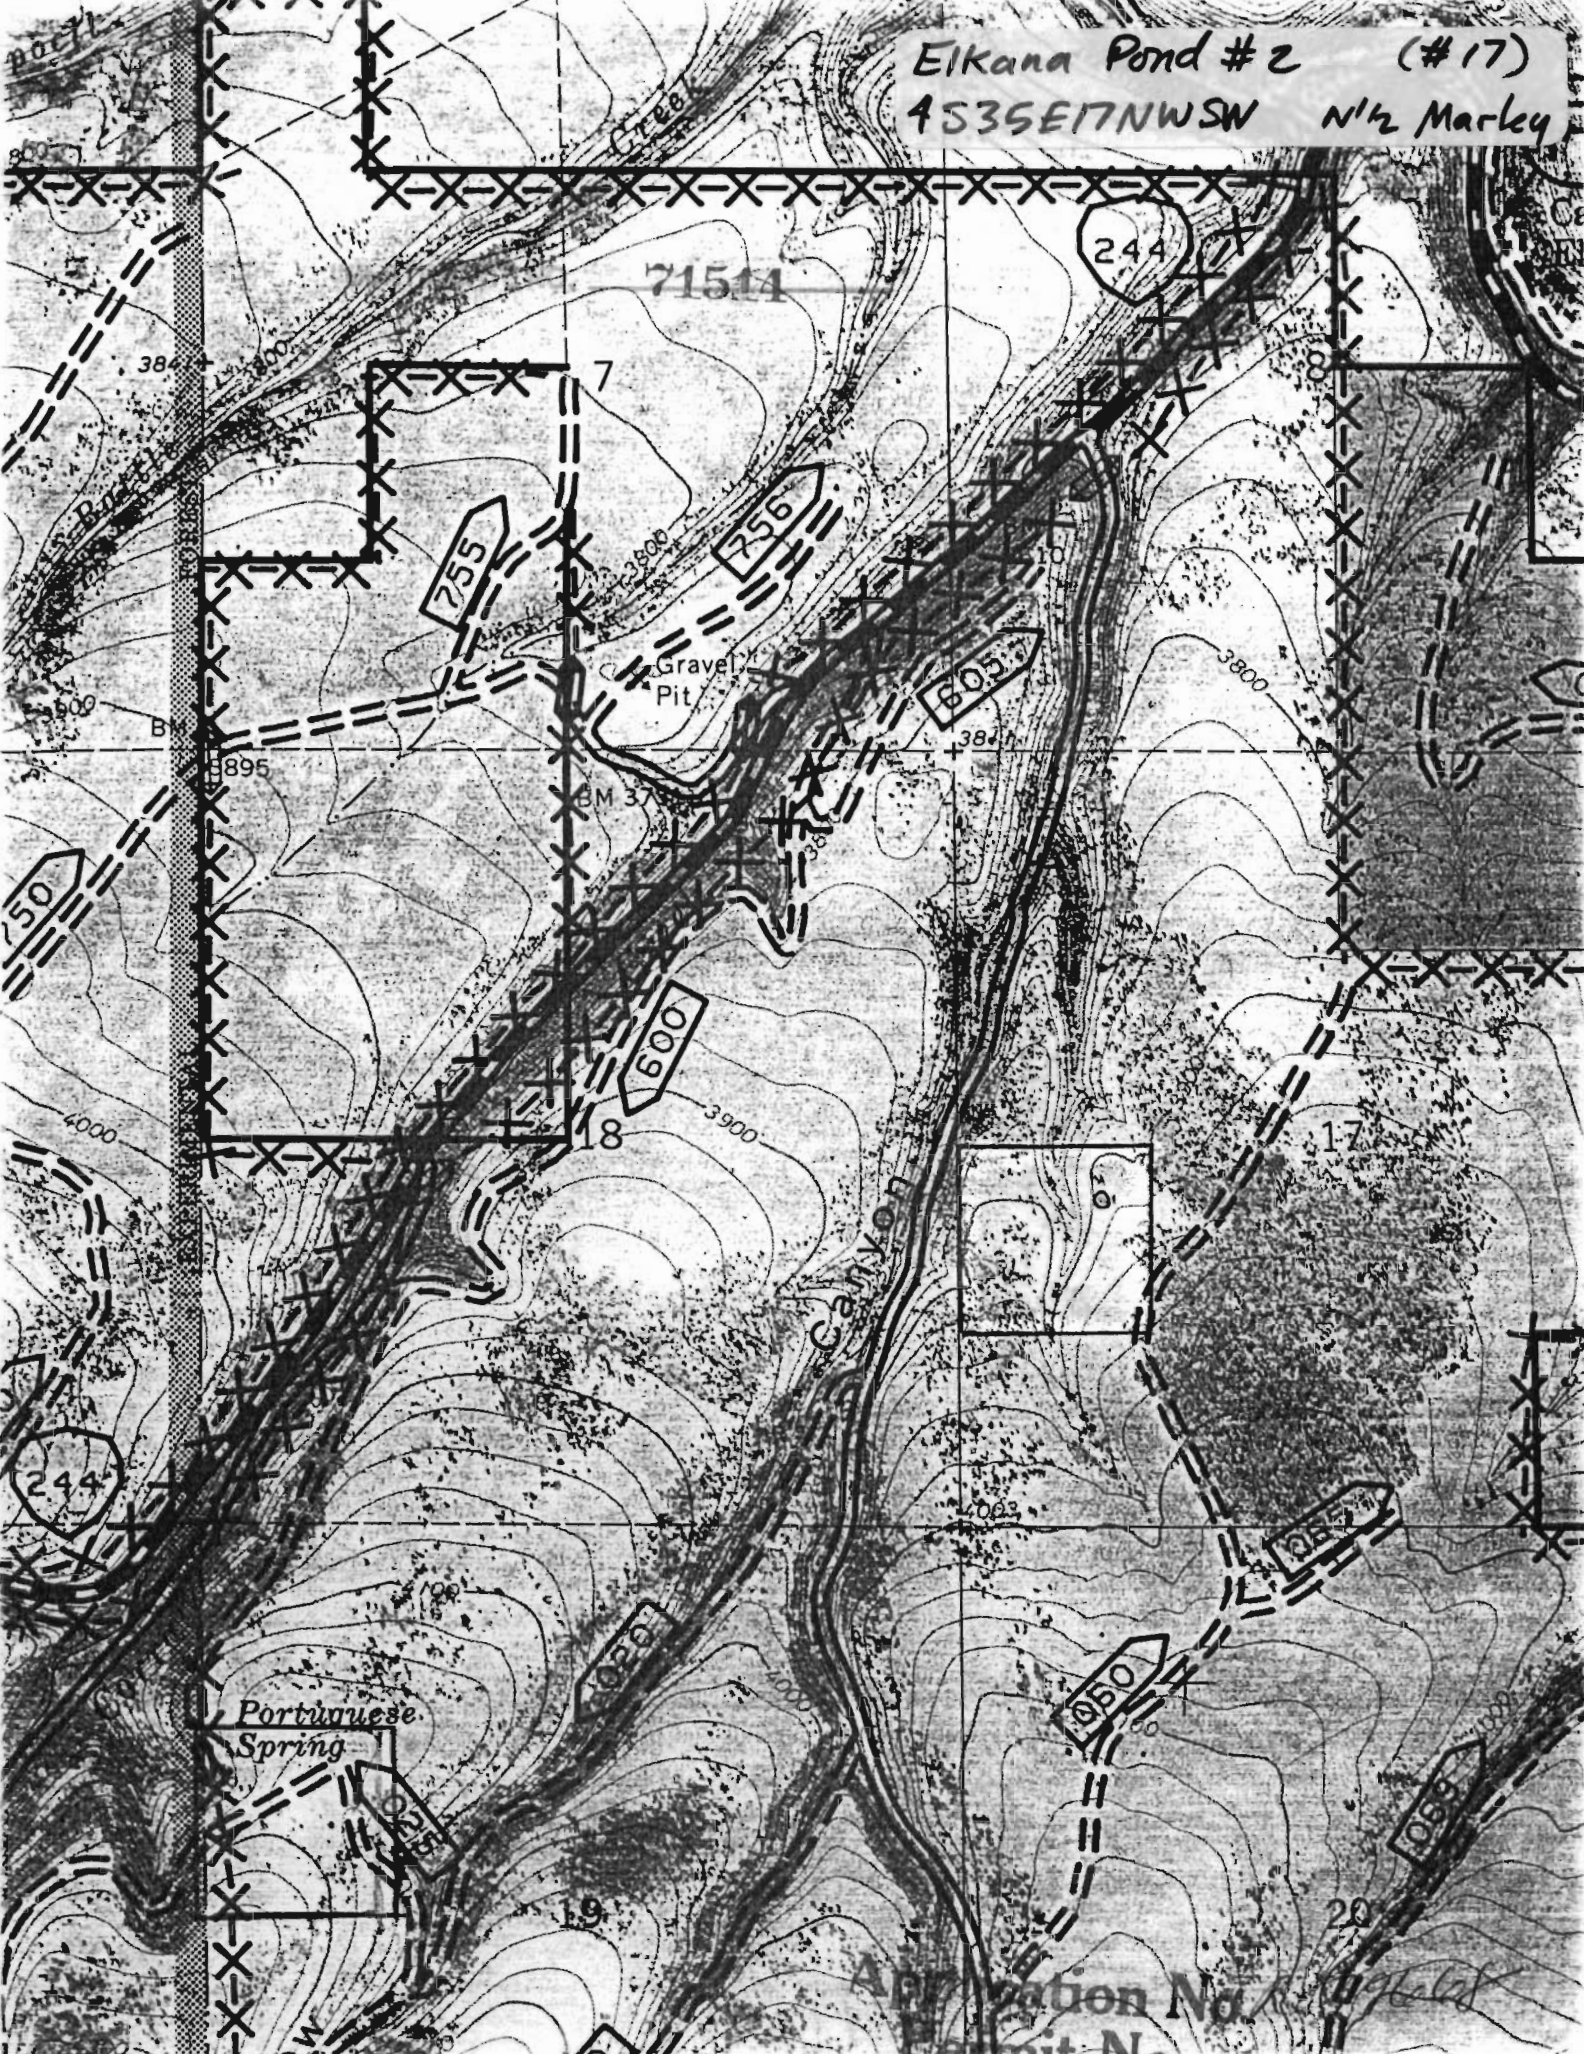


Application No. R 79648
Permit No.

Elkawa Pond #3 (#18)
4535E 17NWSW N 1/2 Marley

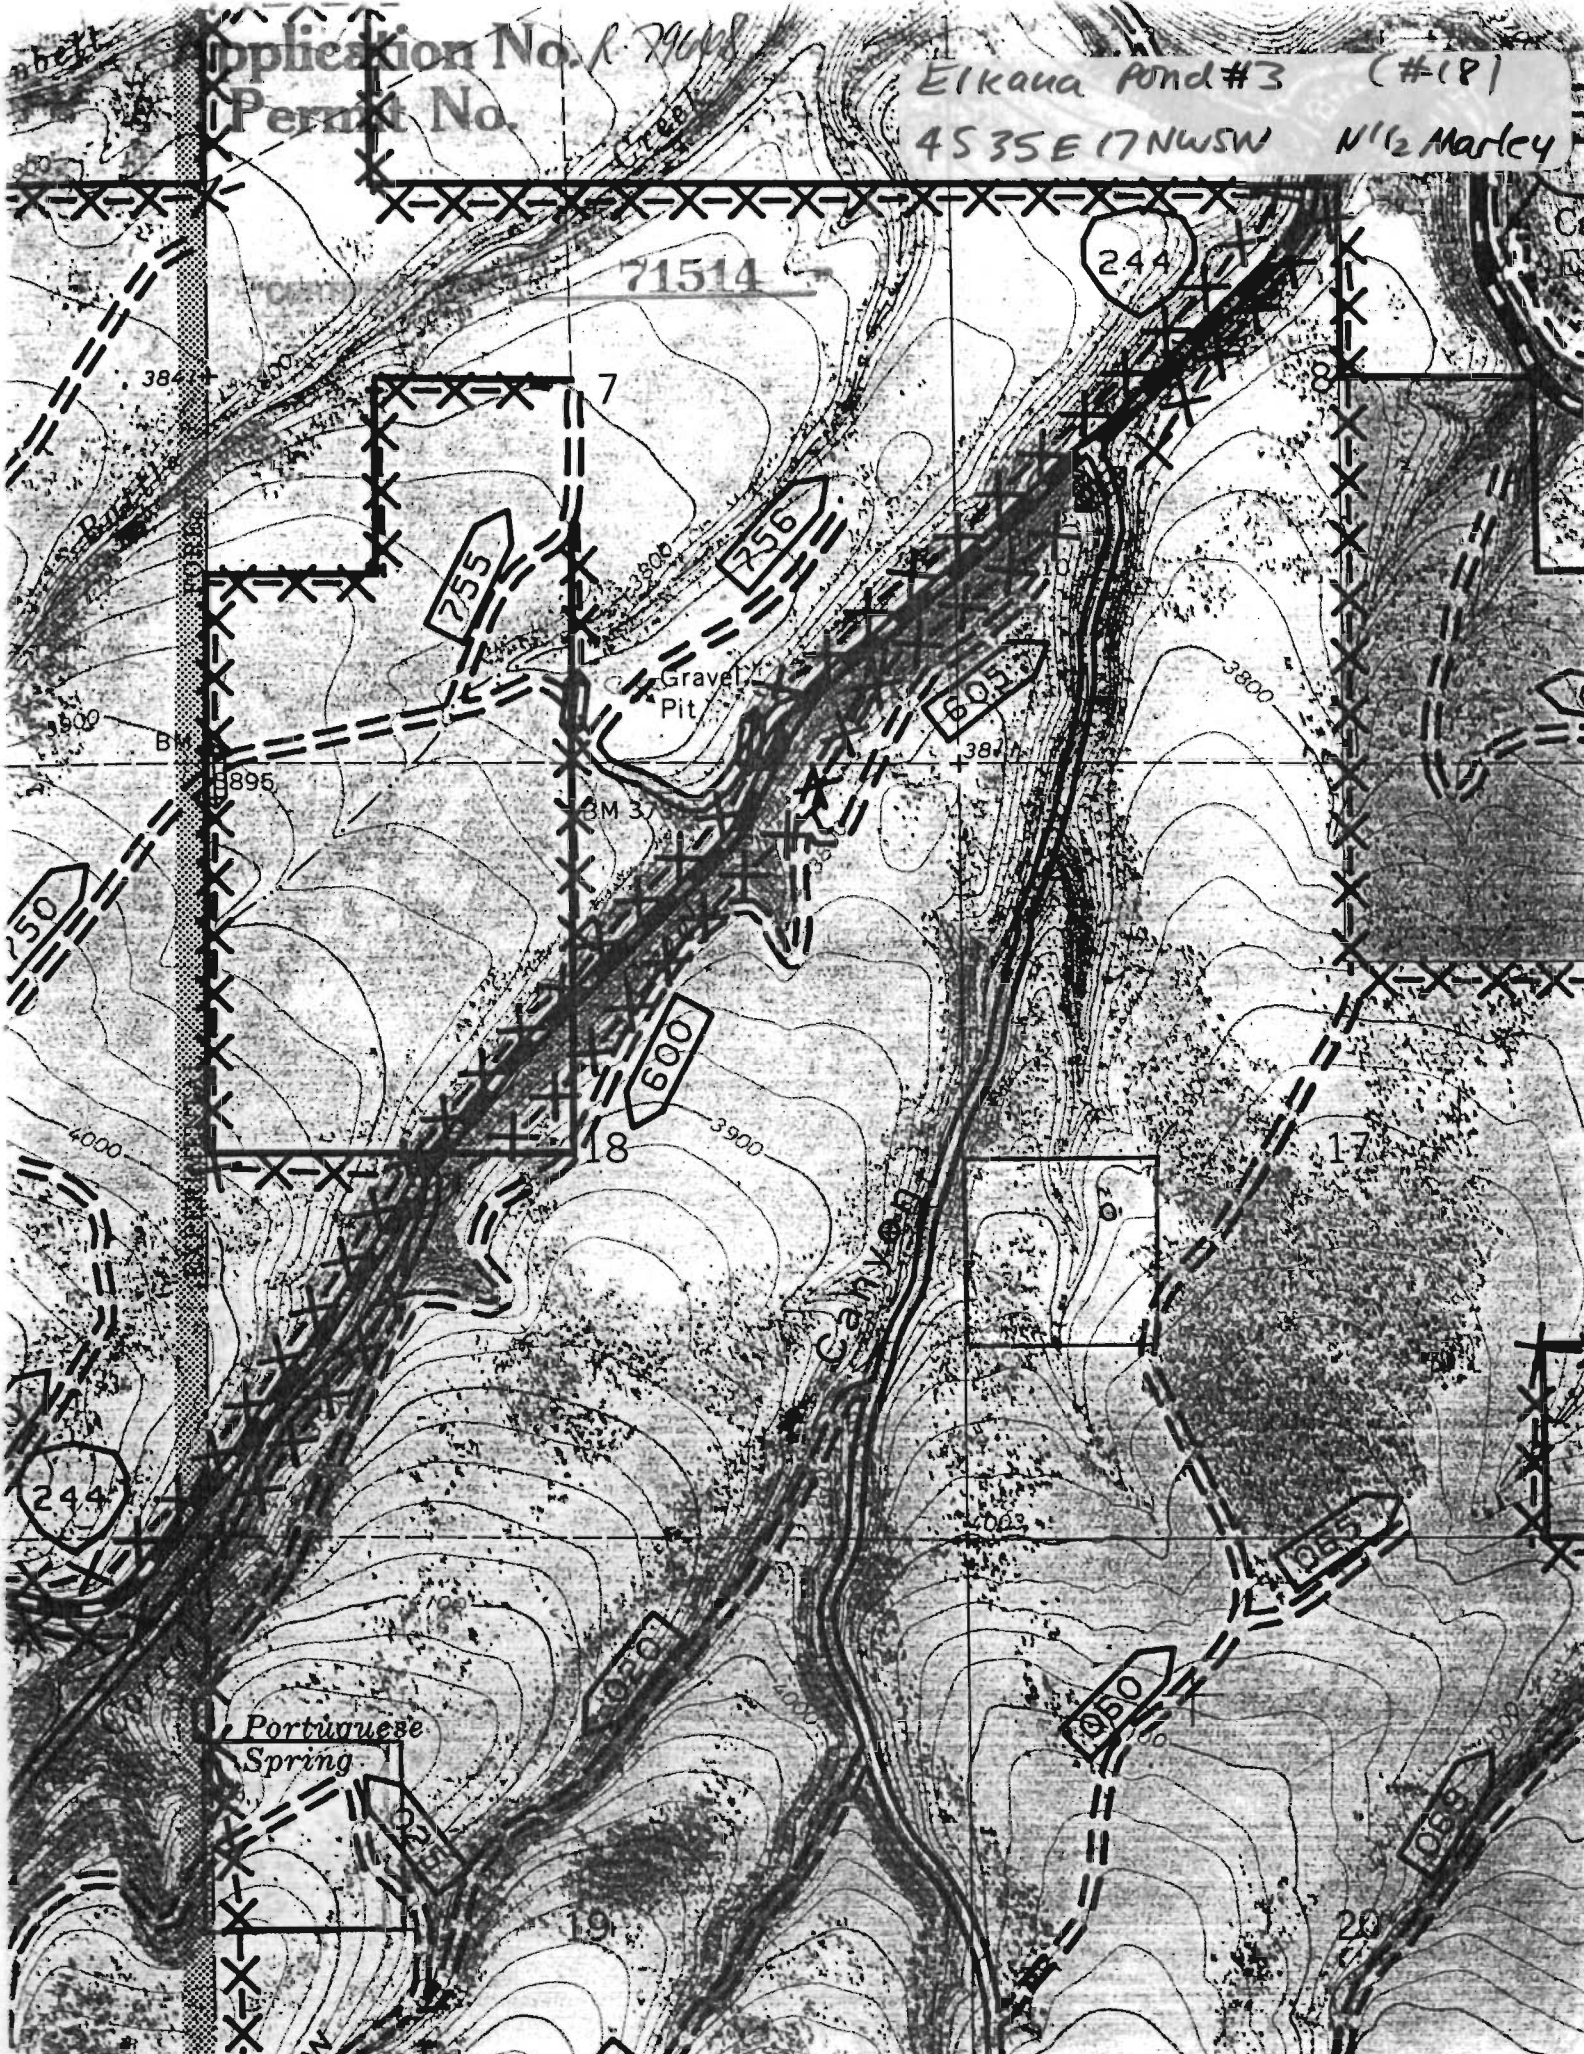

Three Pond #2 (#19)
R. 79608
45 35E 20 SWSE N 1/2 Marley

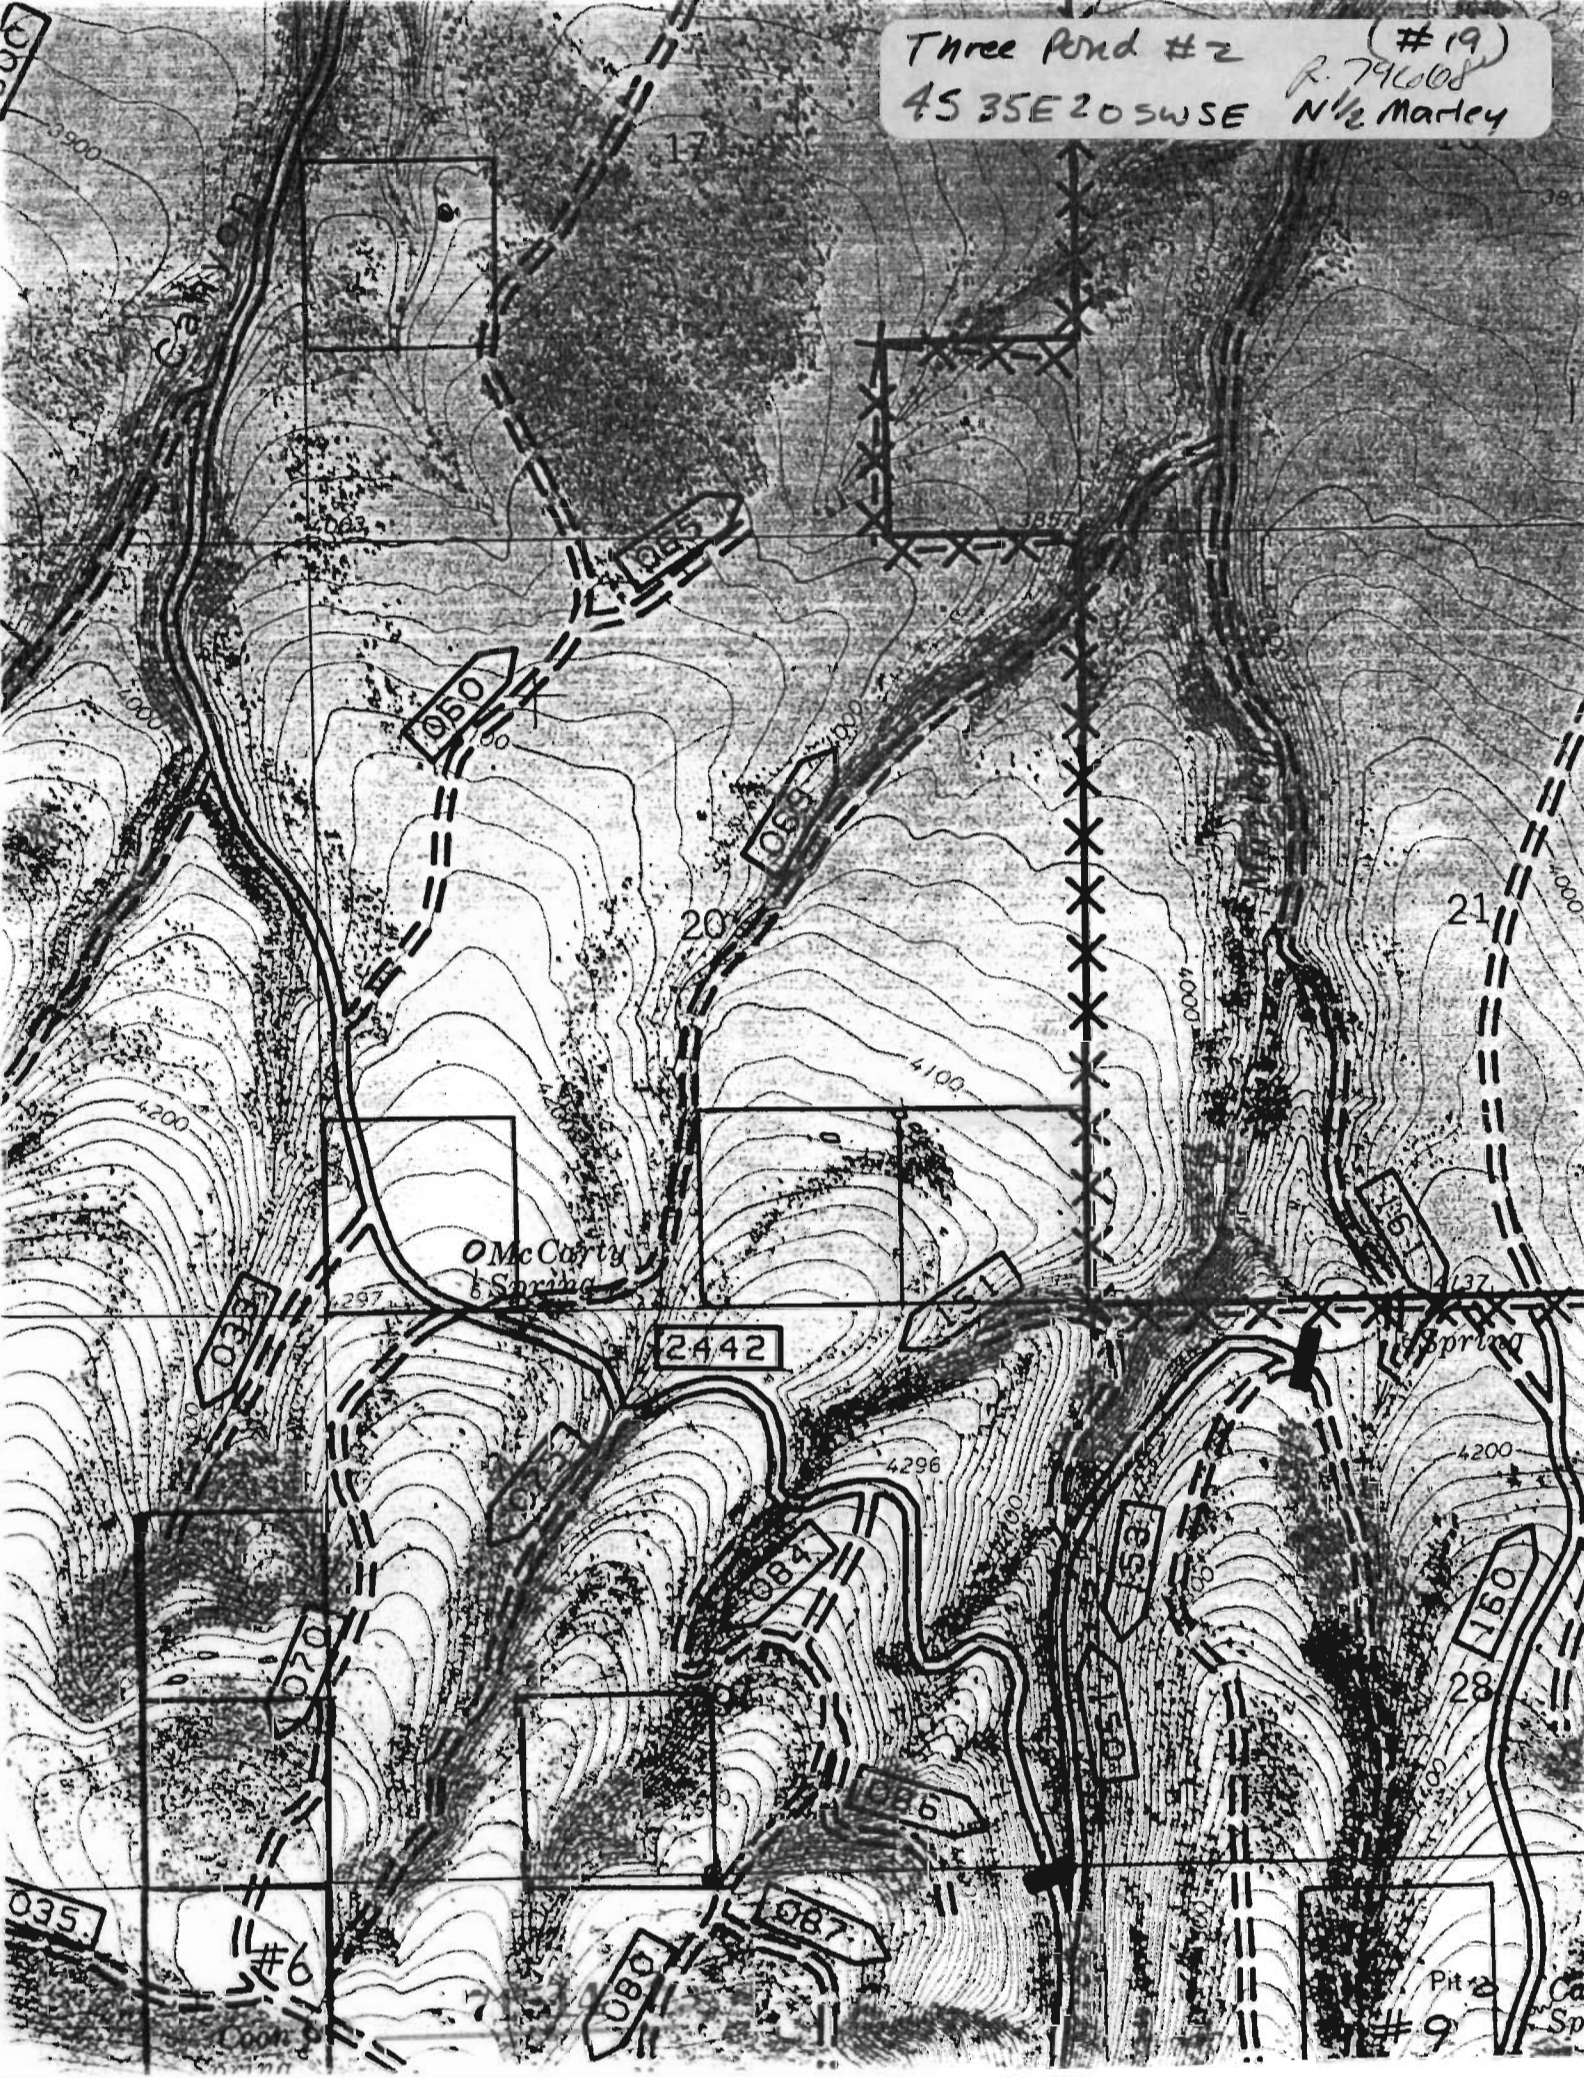

Three Pond #3 (#20)
4535E 20SESE N $\frac{1}{2}$ Marley R 7948

