

Ferrin Pond


#12

2S 35E 32 NENE N 1/2 McIntyre



CERTIFICATE NO.

R-79669

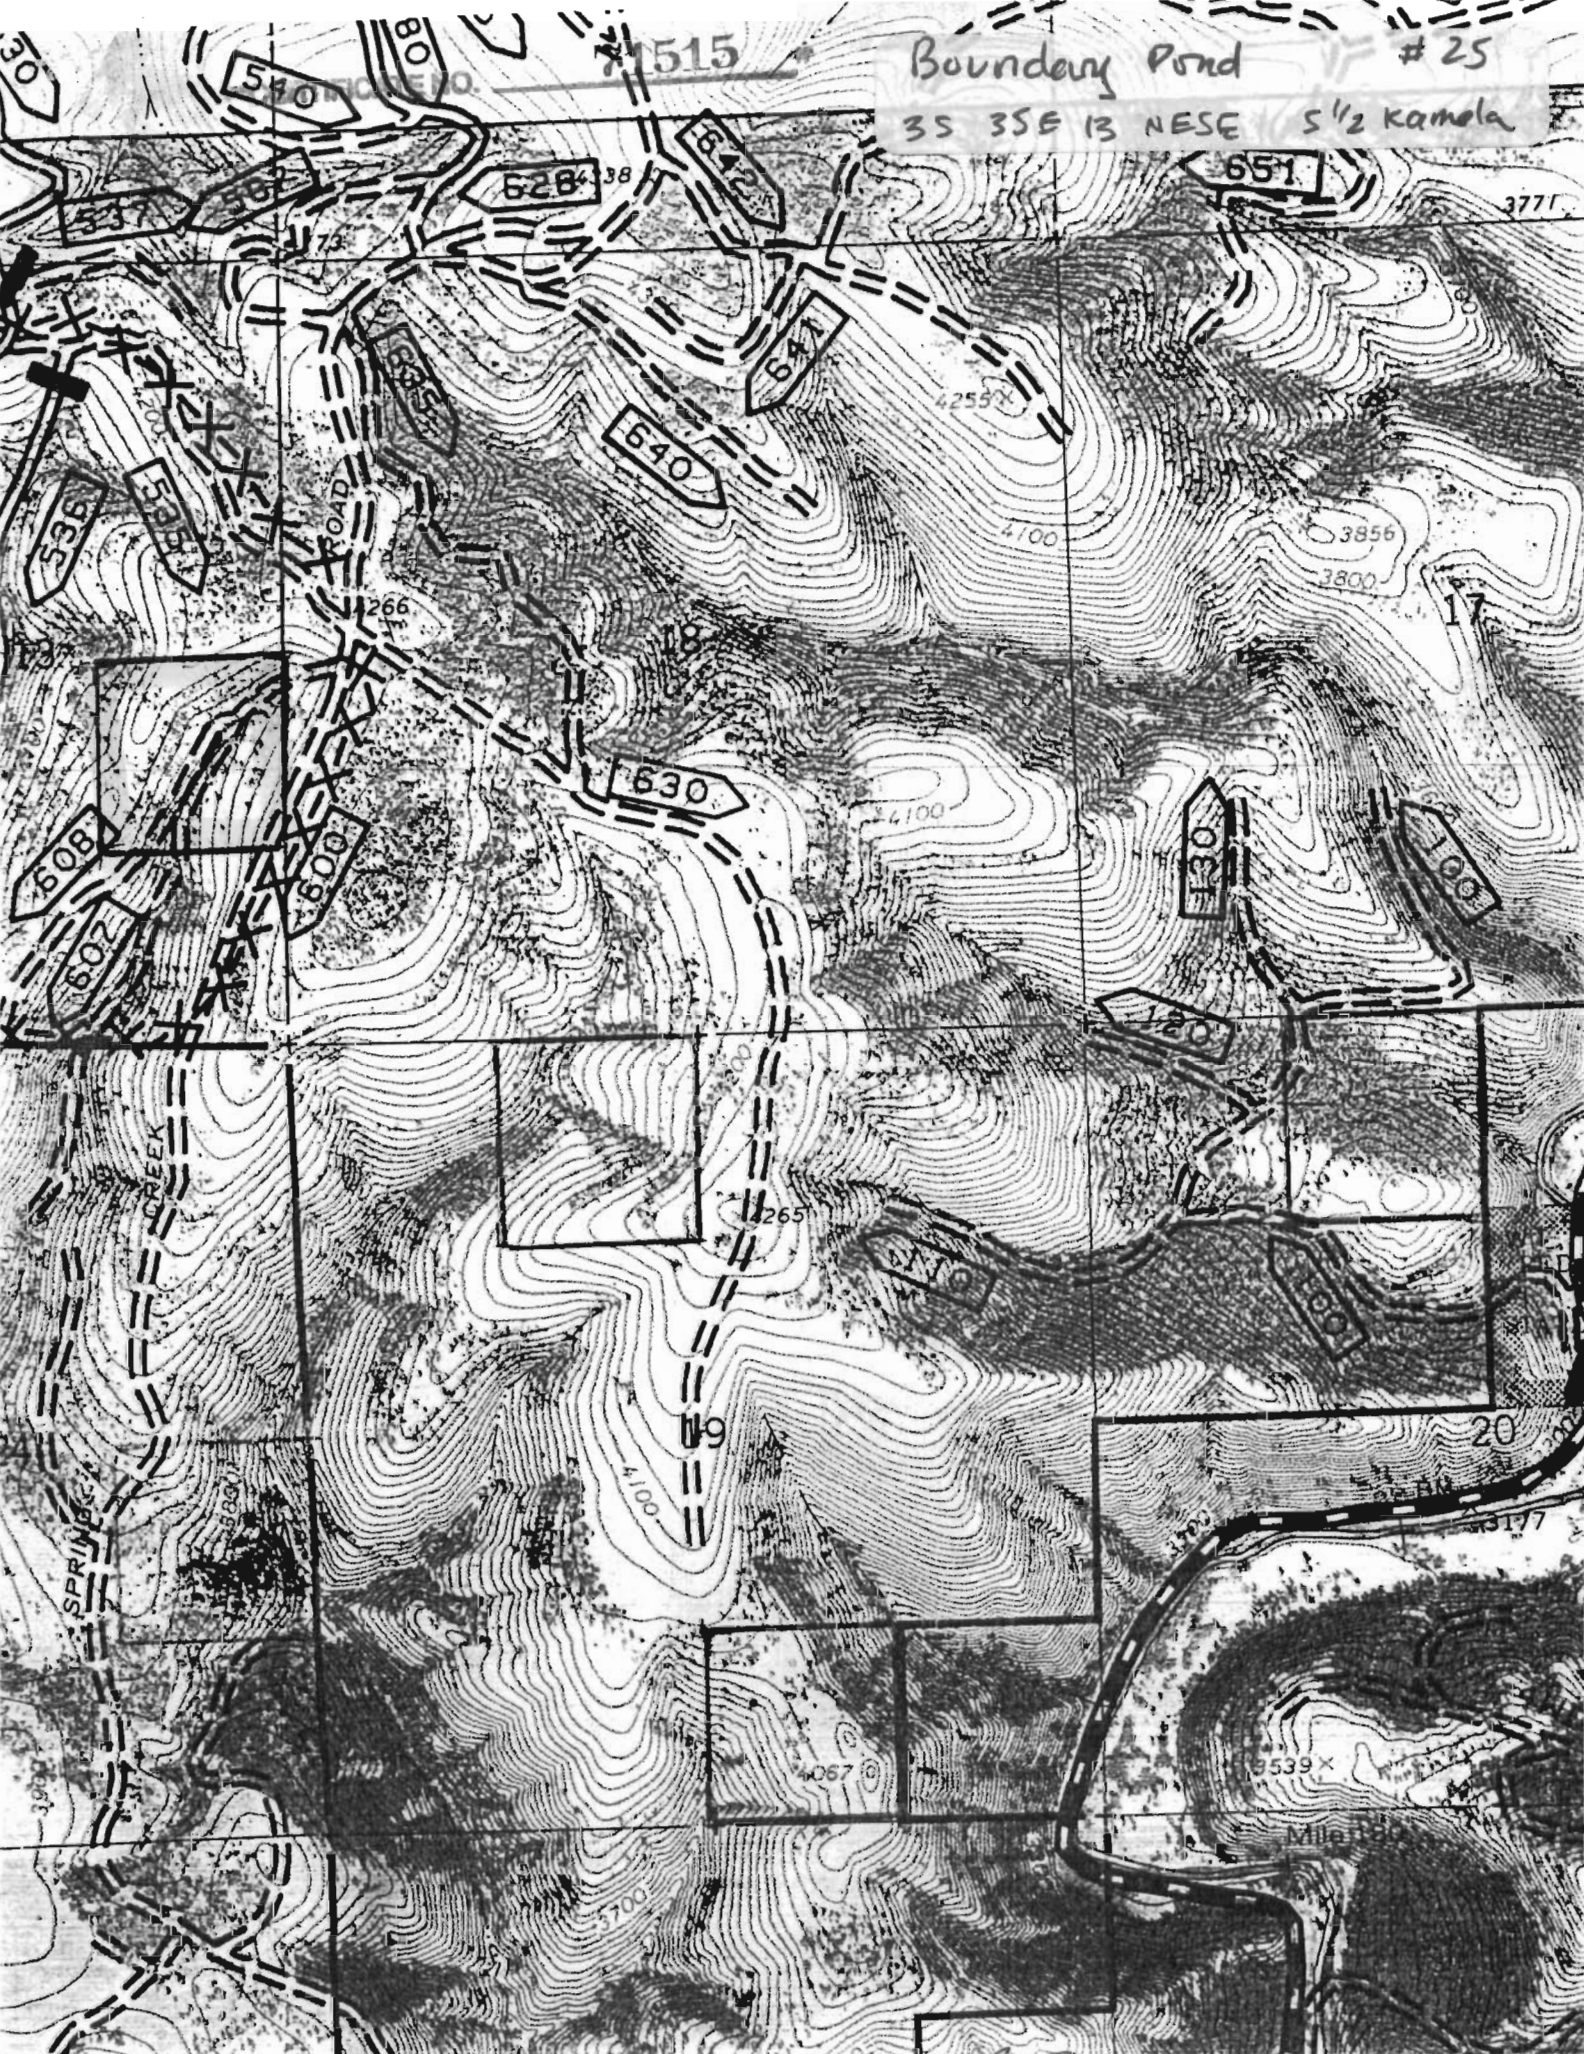

Boundary Pond

25

35 36 37 

1515

651

628

647

640

536

600

630

608

602

130

100

120

100

SPRING CREEK

20

539

Miller

Eikana Pond

#1

4S 35E 17NWSW


N 1/2 Markey




R-796609

Portuguese Sp. Pond #2


4 S 35E 19 SWNW N 1/2 Marley

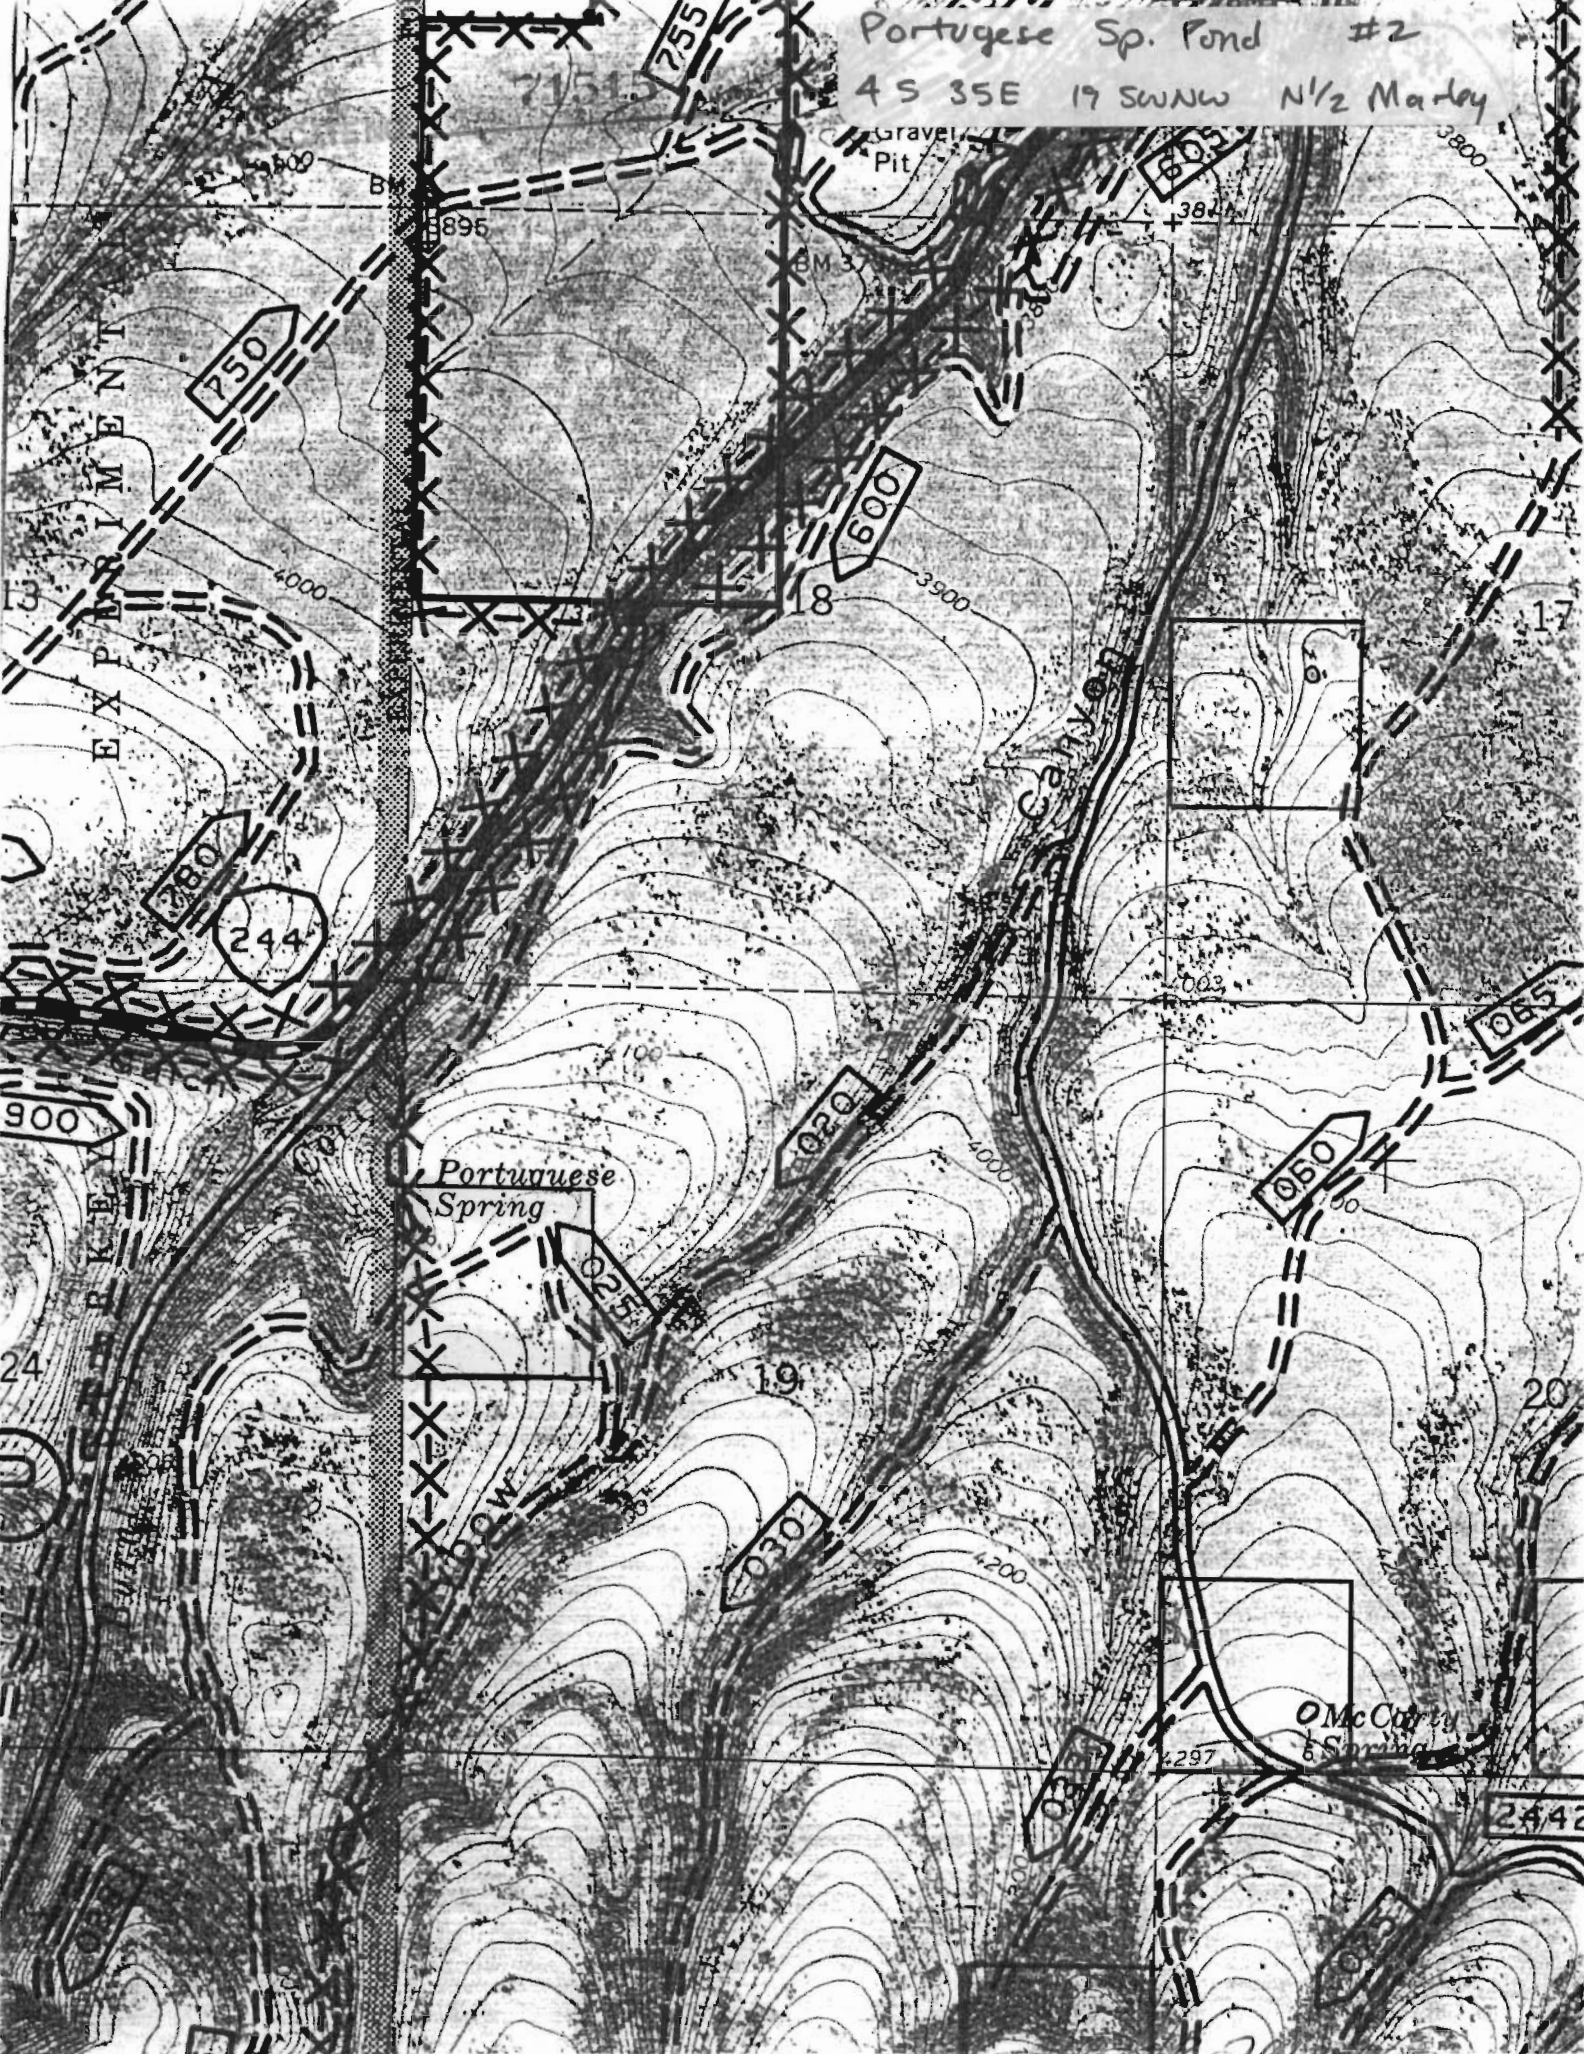

Three Pond #1 R No 69 (#3)
4S 35E 20 SWSE N 1/2 Marley

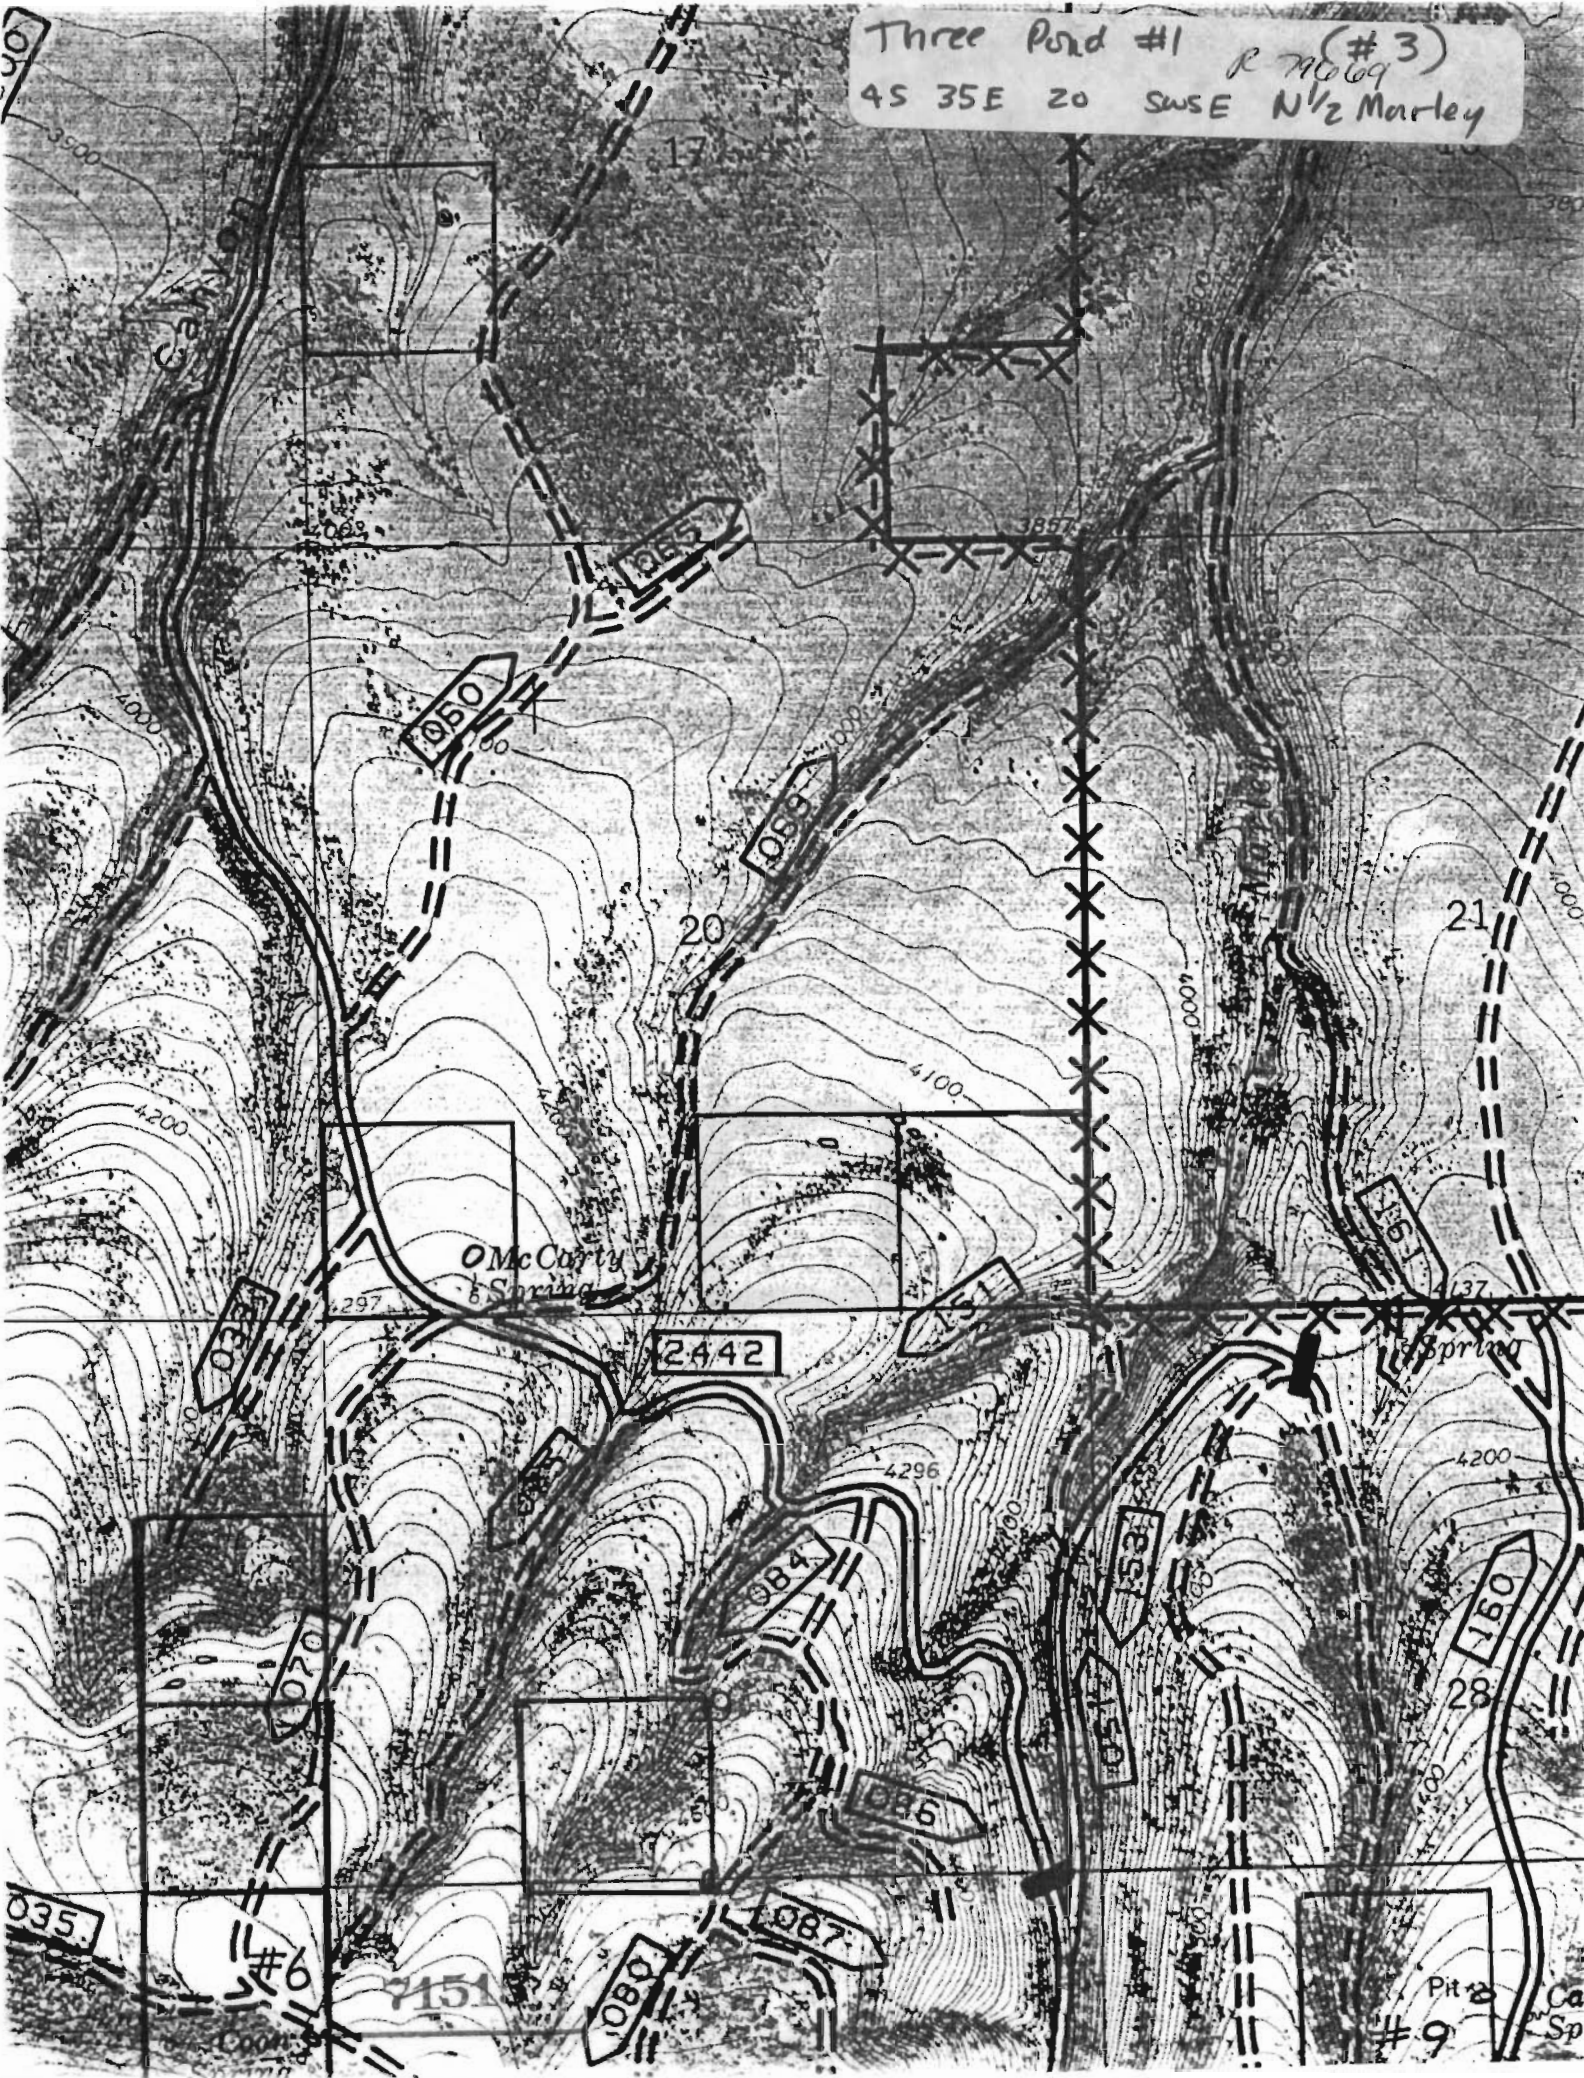

McCarty Sp. Pond #4
45 35 E 20 S WSW N 1/2 Marley

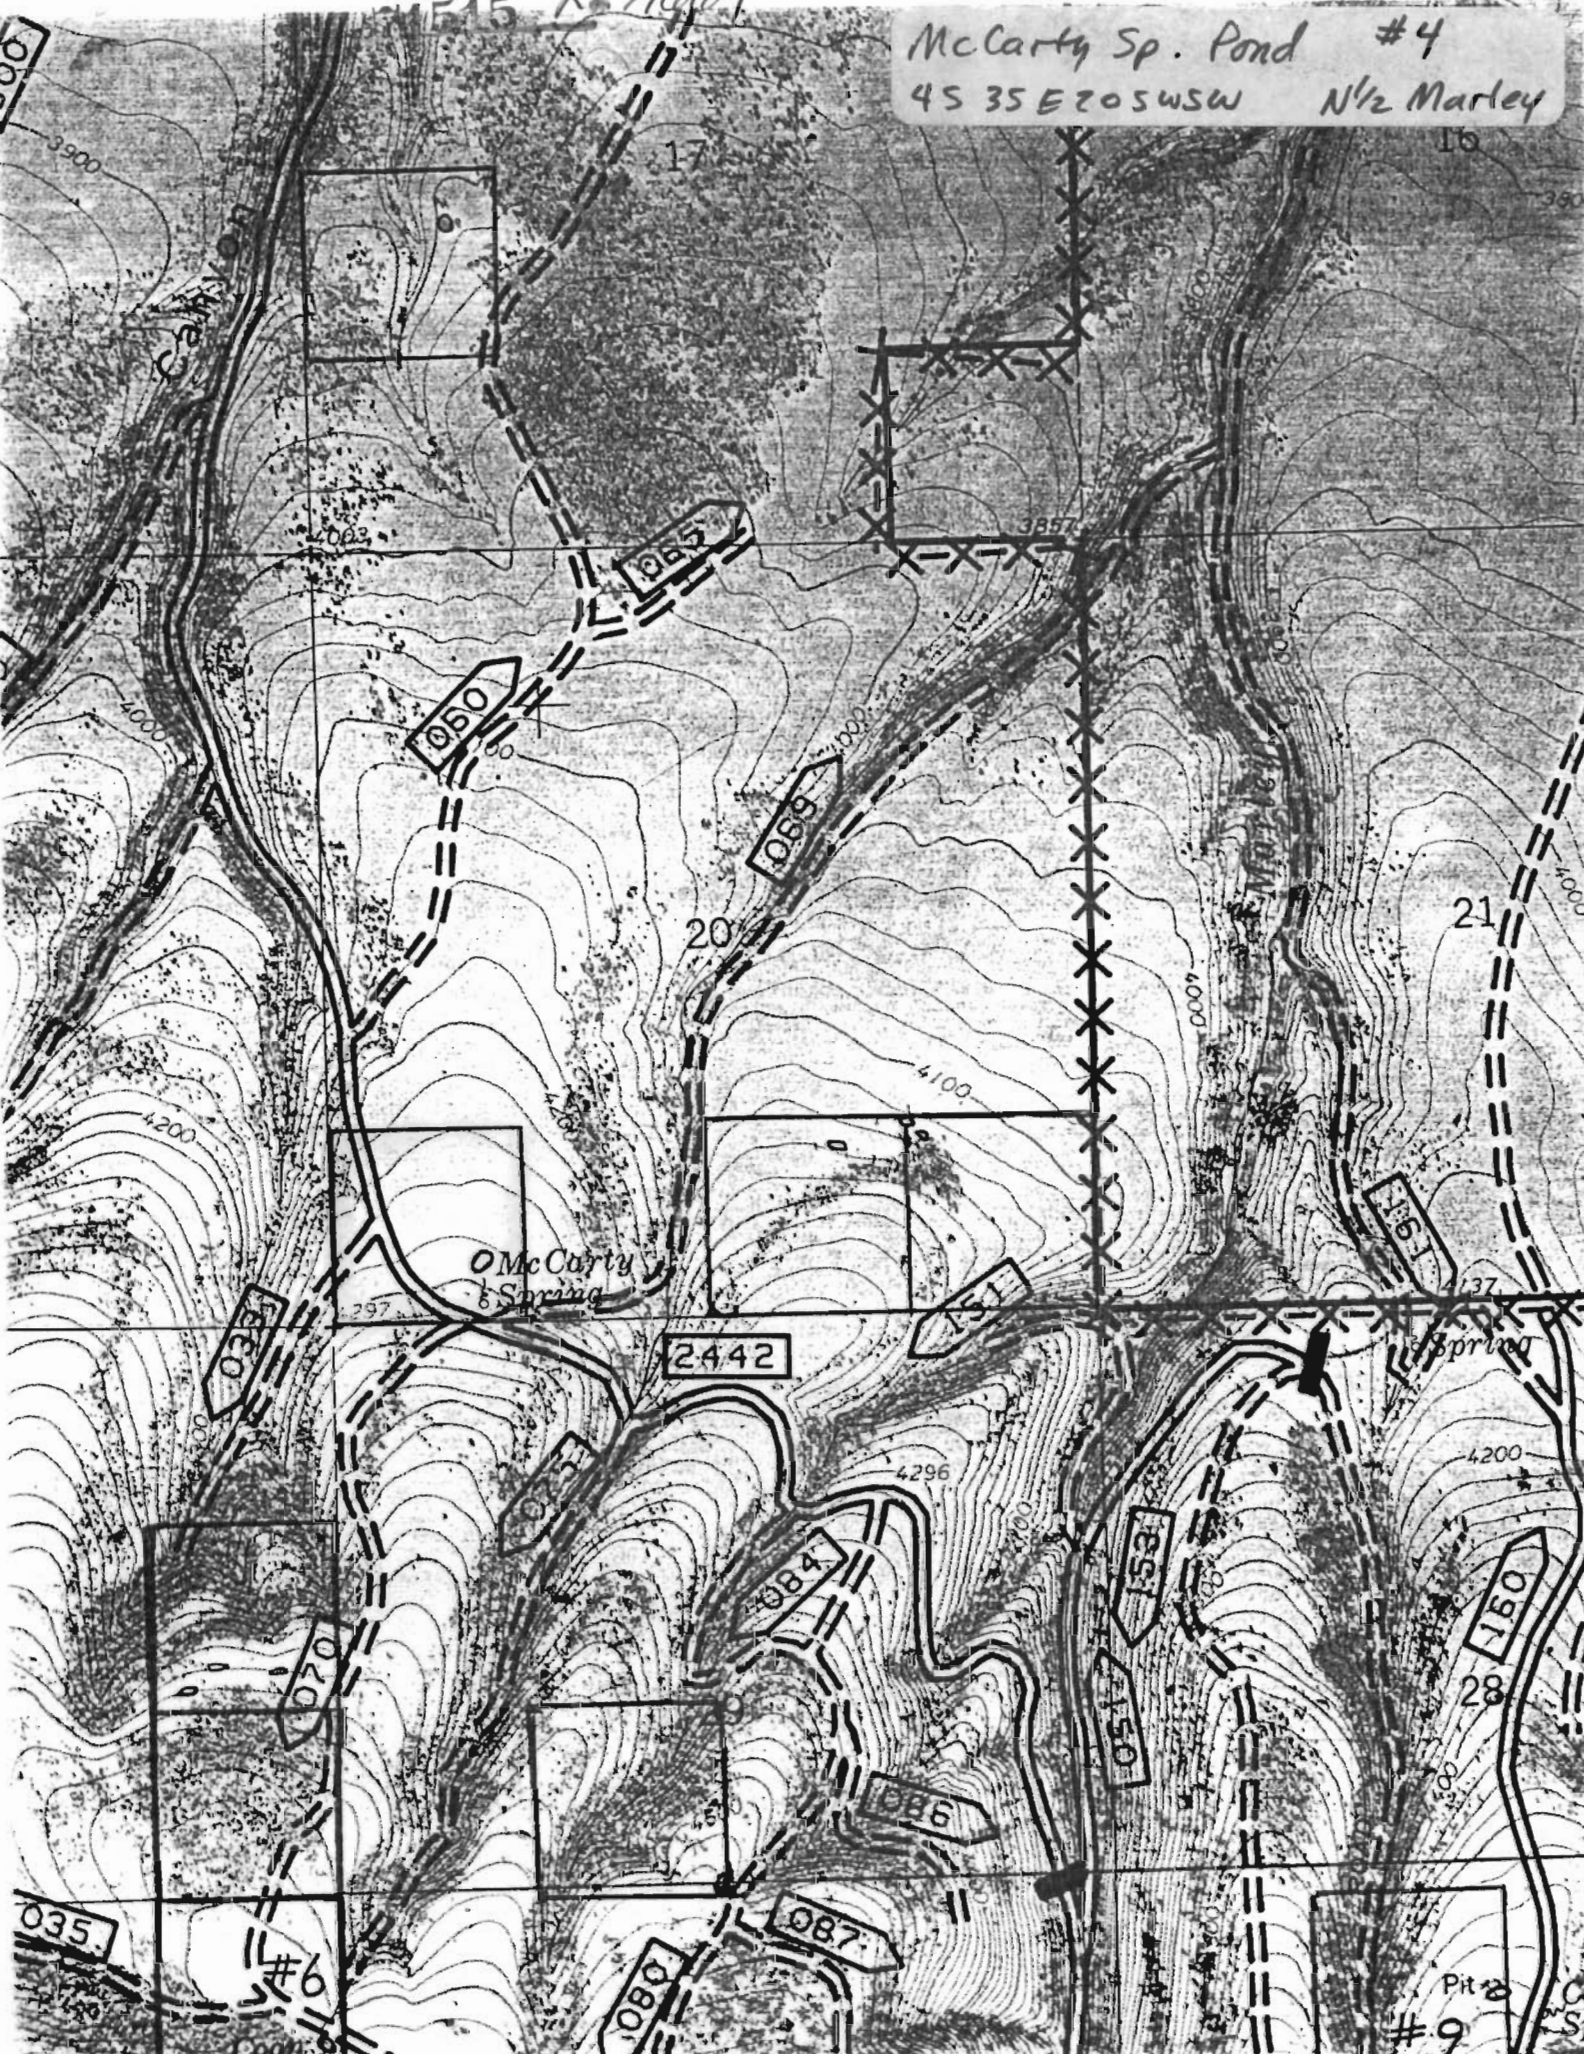

Twin Pond #1

(#5)

45 35 E 30 SENE N 1/2 Marley


Portuguese Spring

McCarty Spring


2442

#6

W A I

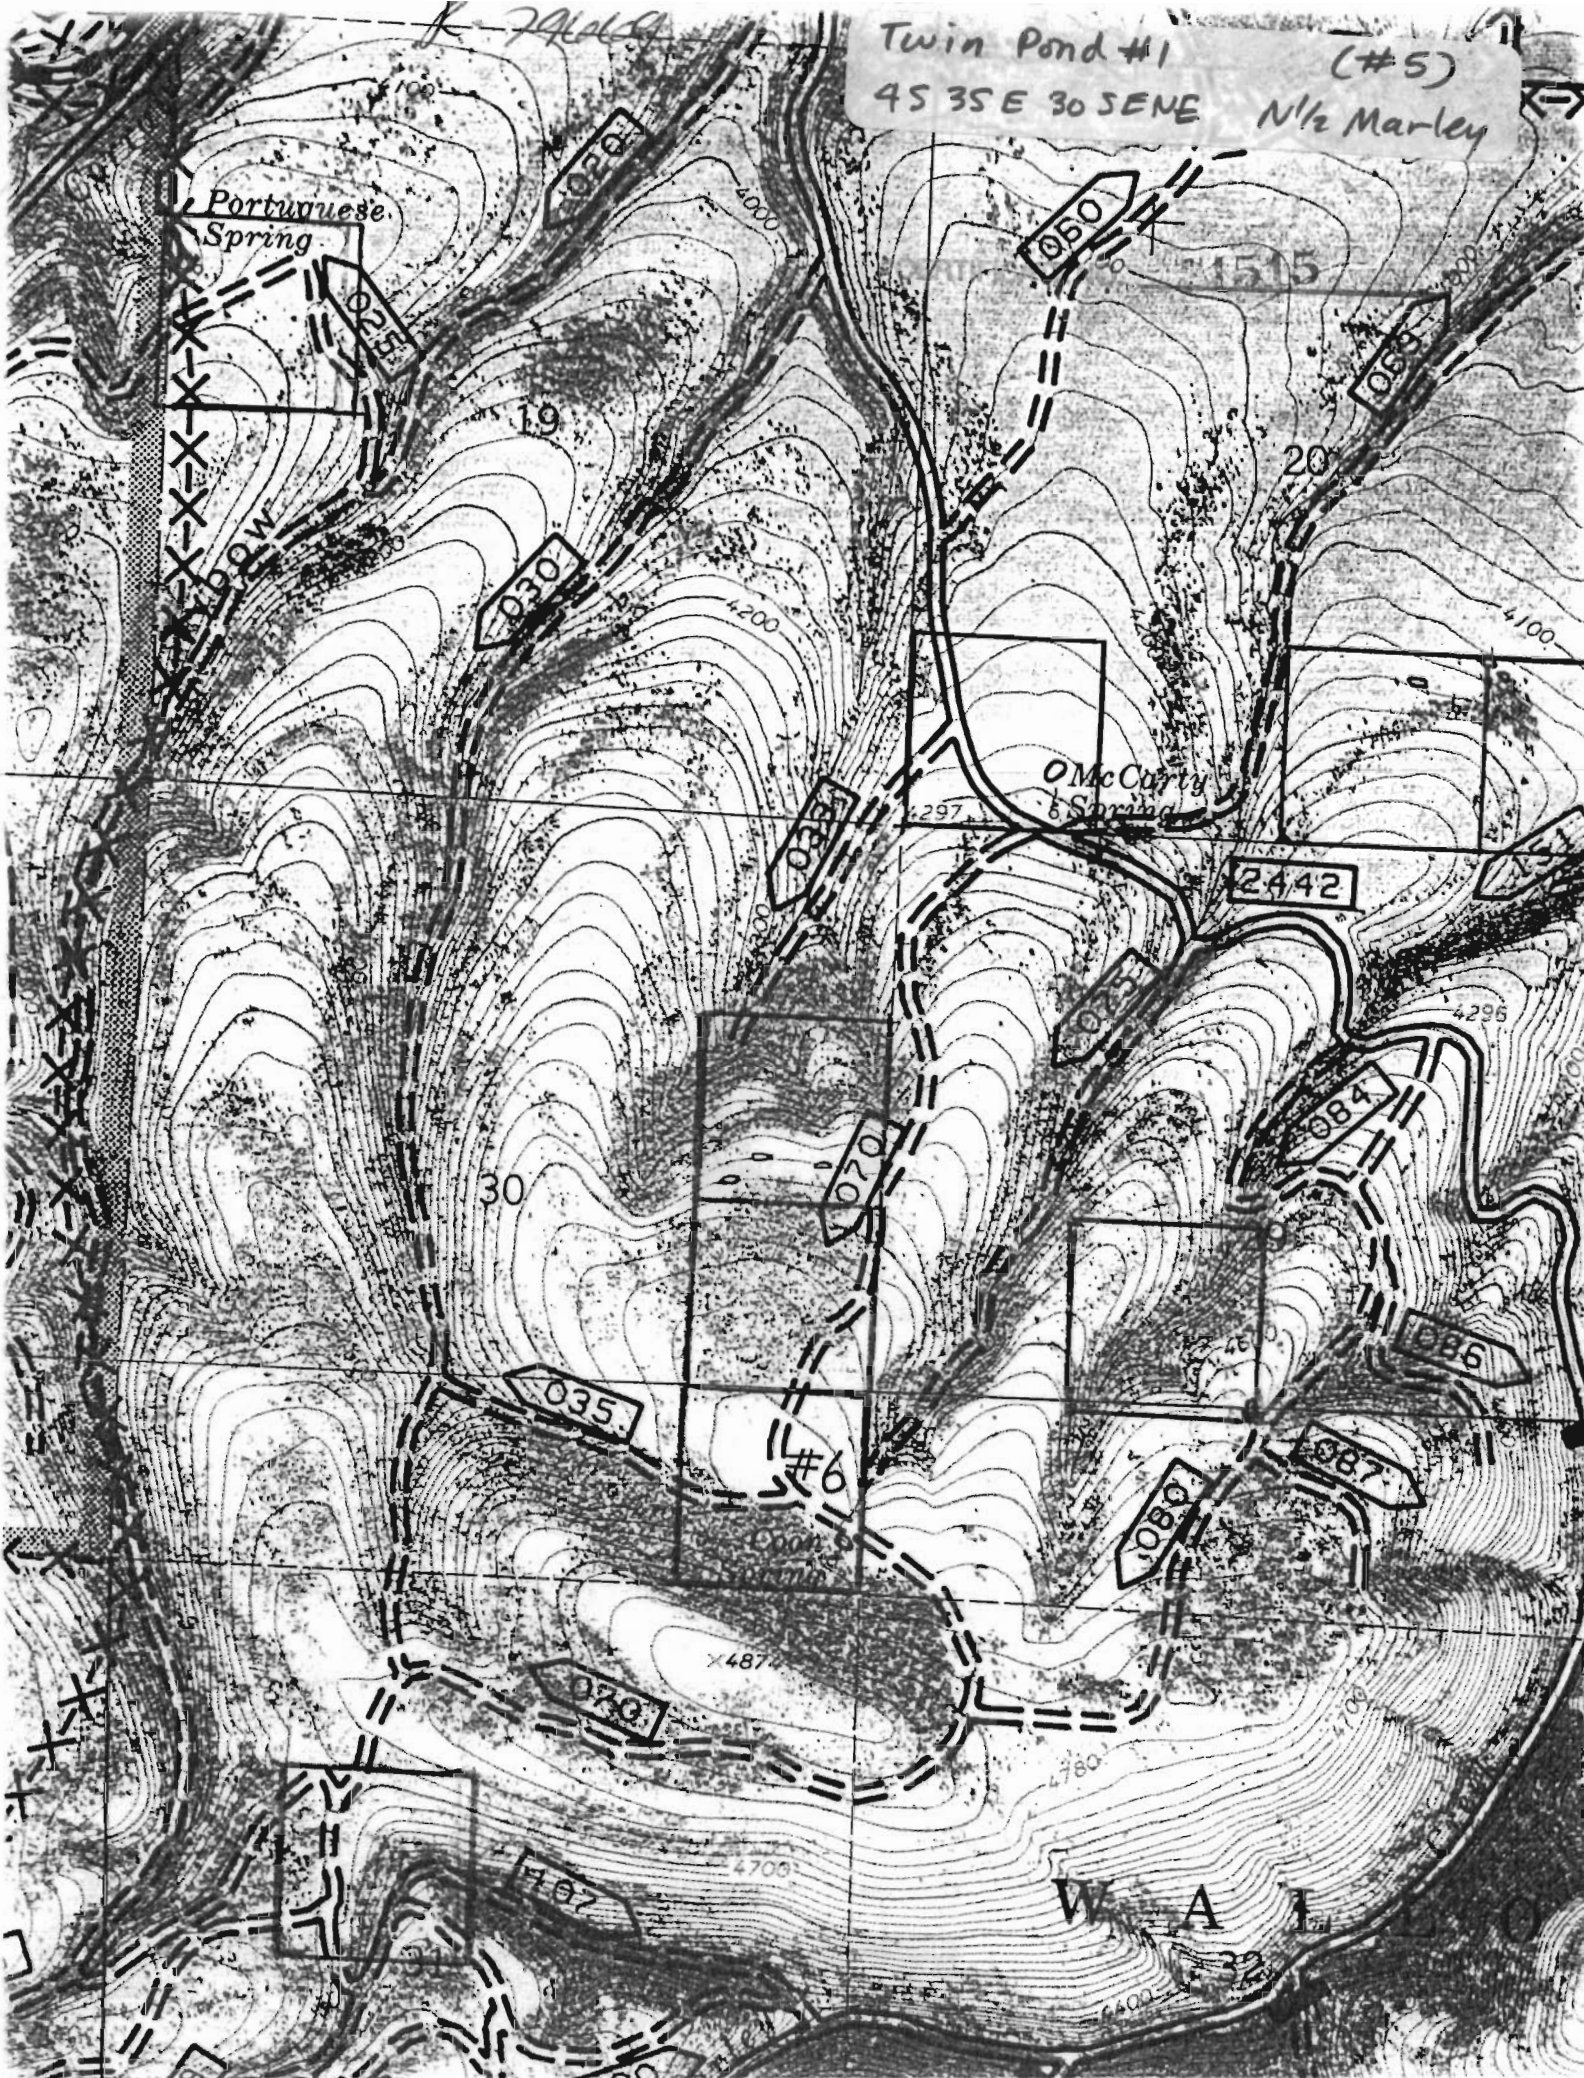

Corn Sp. Pond #6
4S 3S E 30 SESE N 1/2 Marley

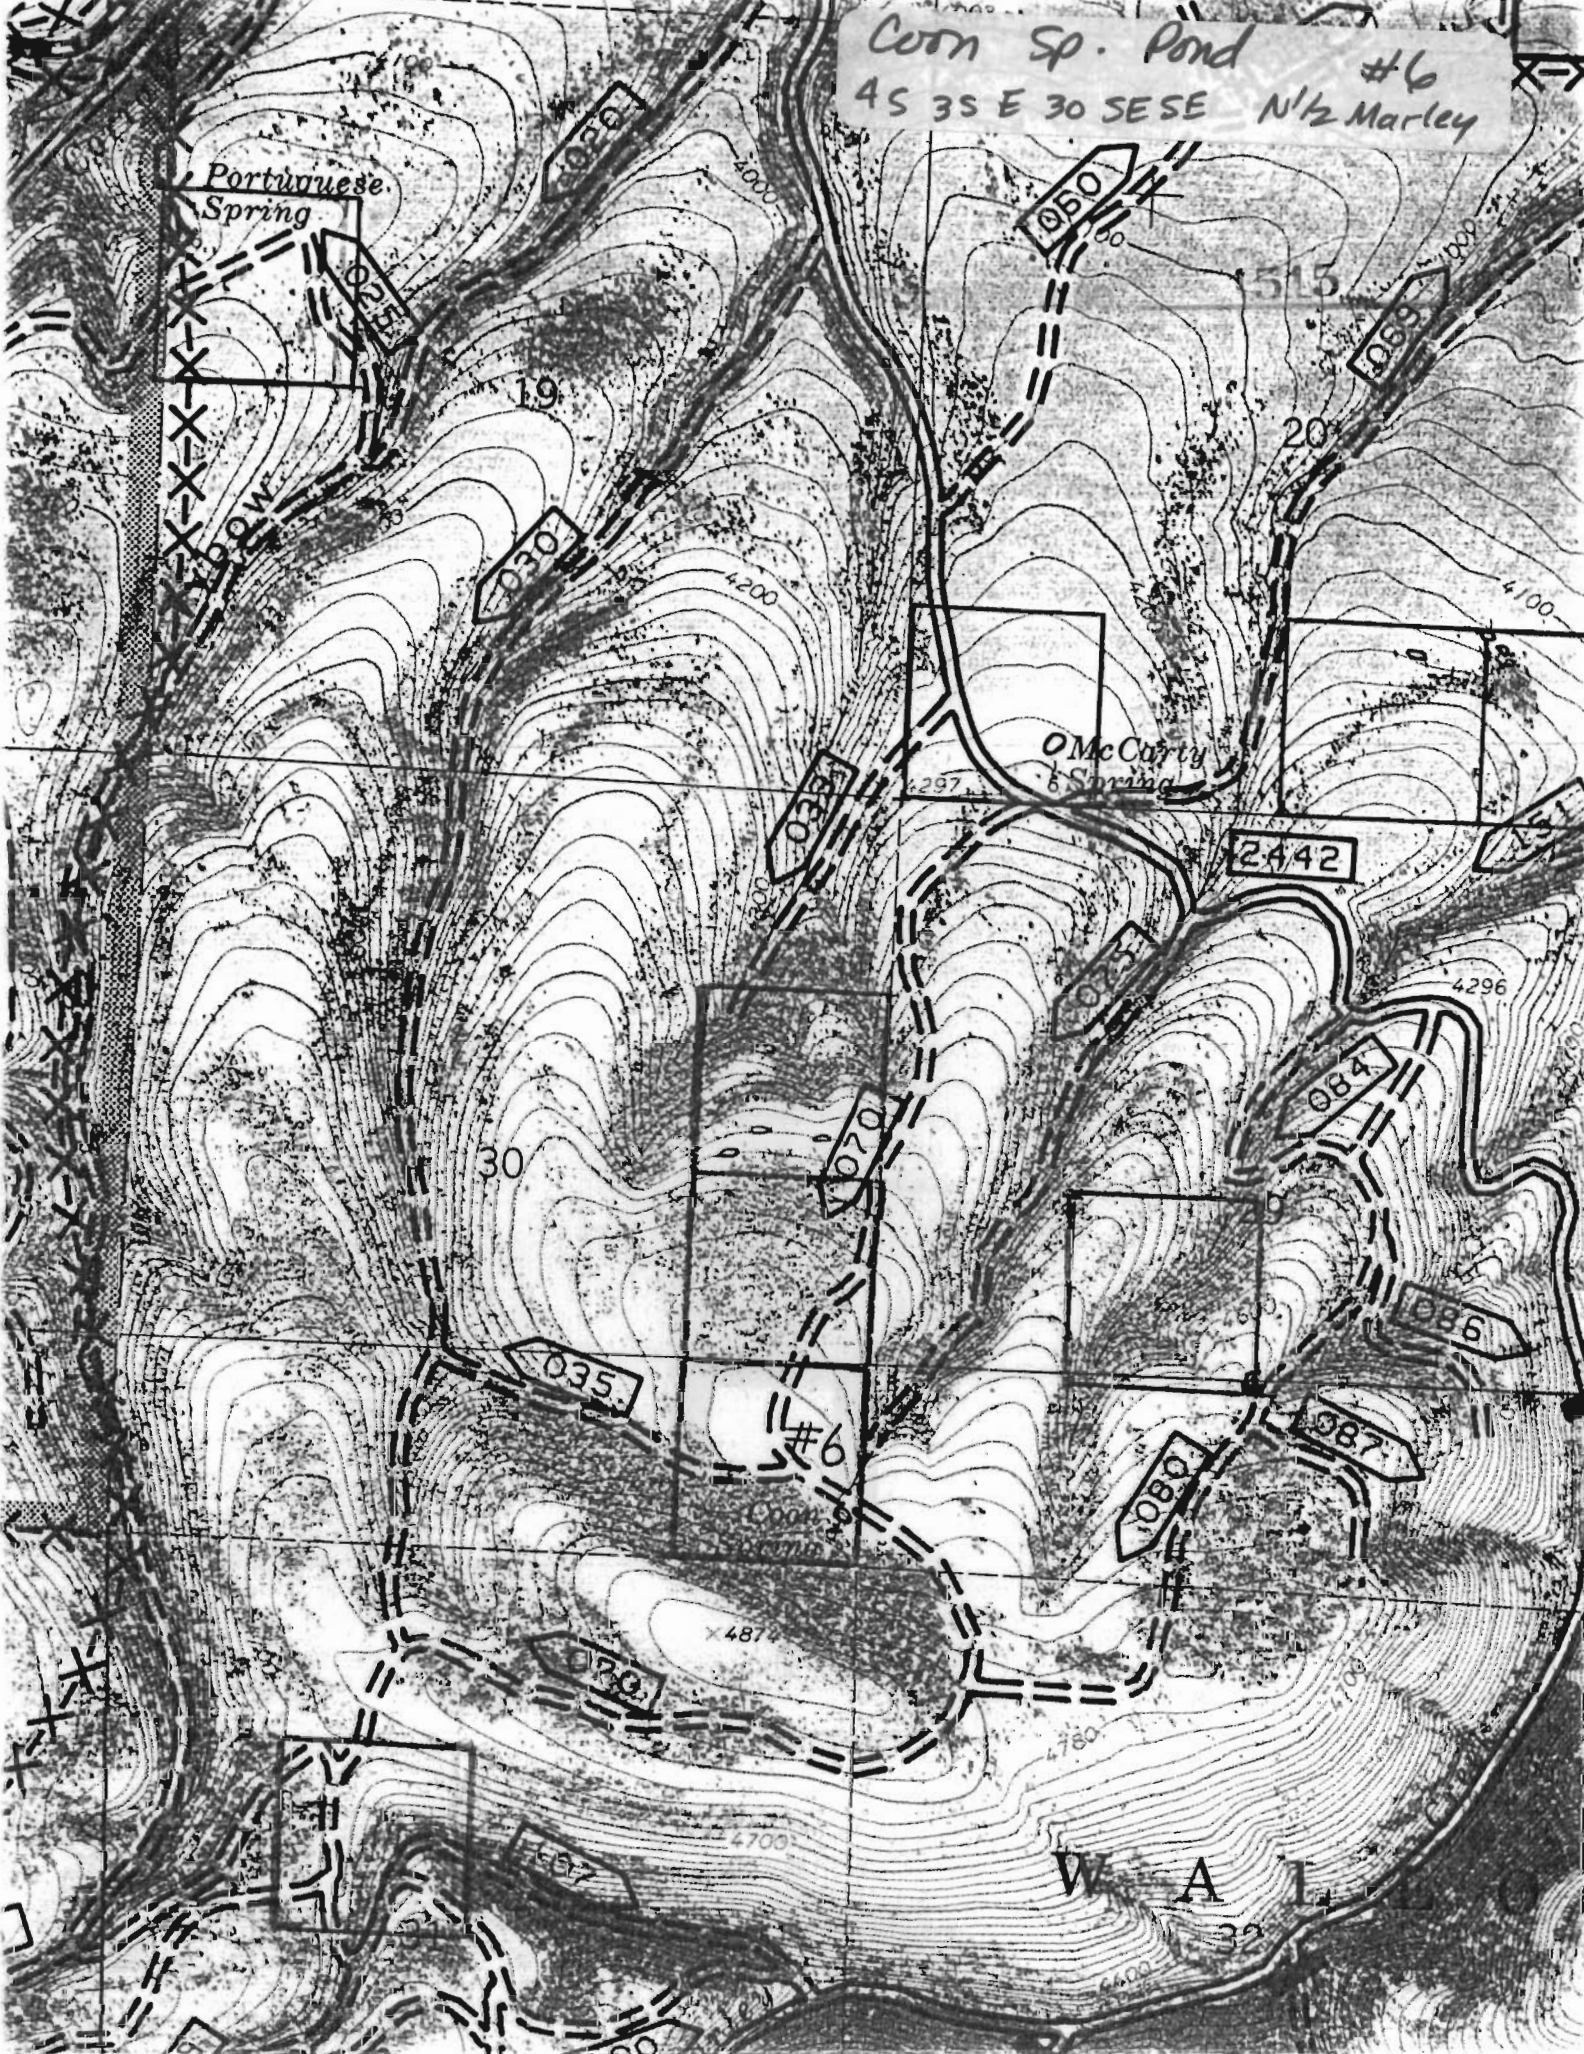

Coon Ridge Pond #7
45 35 E 29 NESW 790609
Nile Marley

