

Application No. *79671*

Permit No.

71517

MT. FANNY QUADRANGLE

OREGON

7.5 MINUTE SERIES (TOPOGRAPHIC)

2474 1 NE
(FOX POINT)

62

MT. FANNY, OREG.


45117-C6-TF-024

1965

PHOTOREVISED 1984

DMA 2474 1 SW-SERIES V892

JH11

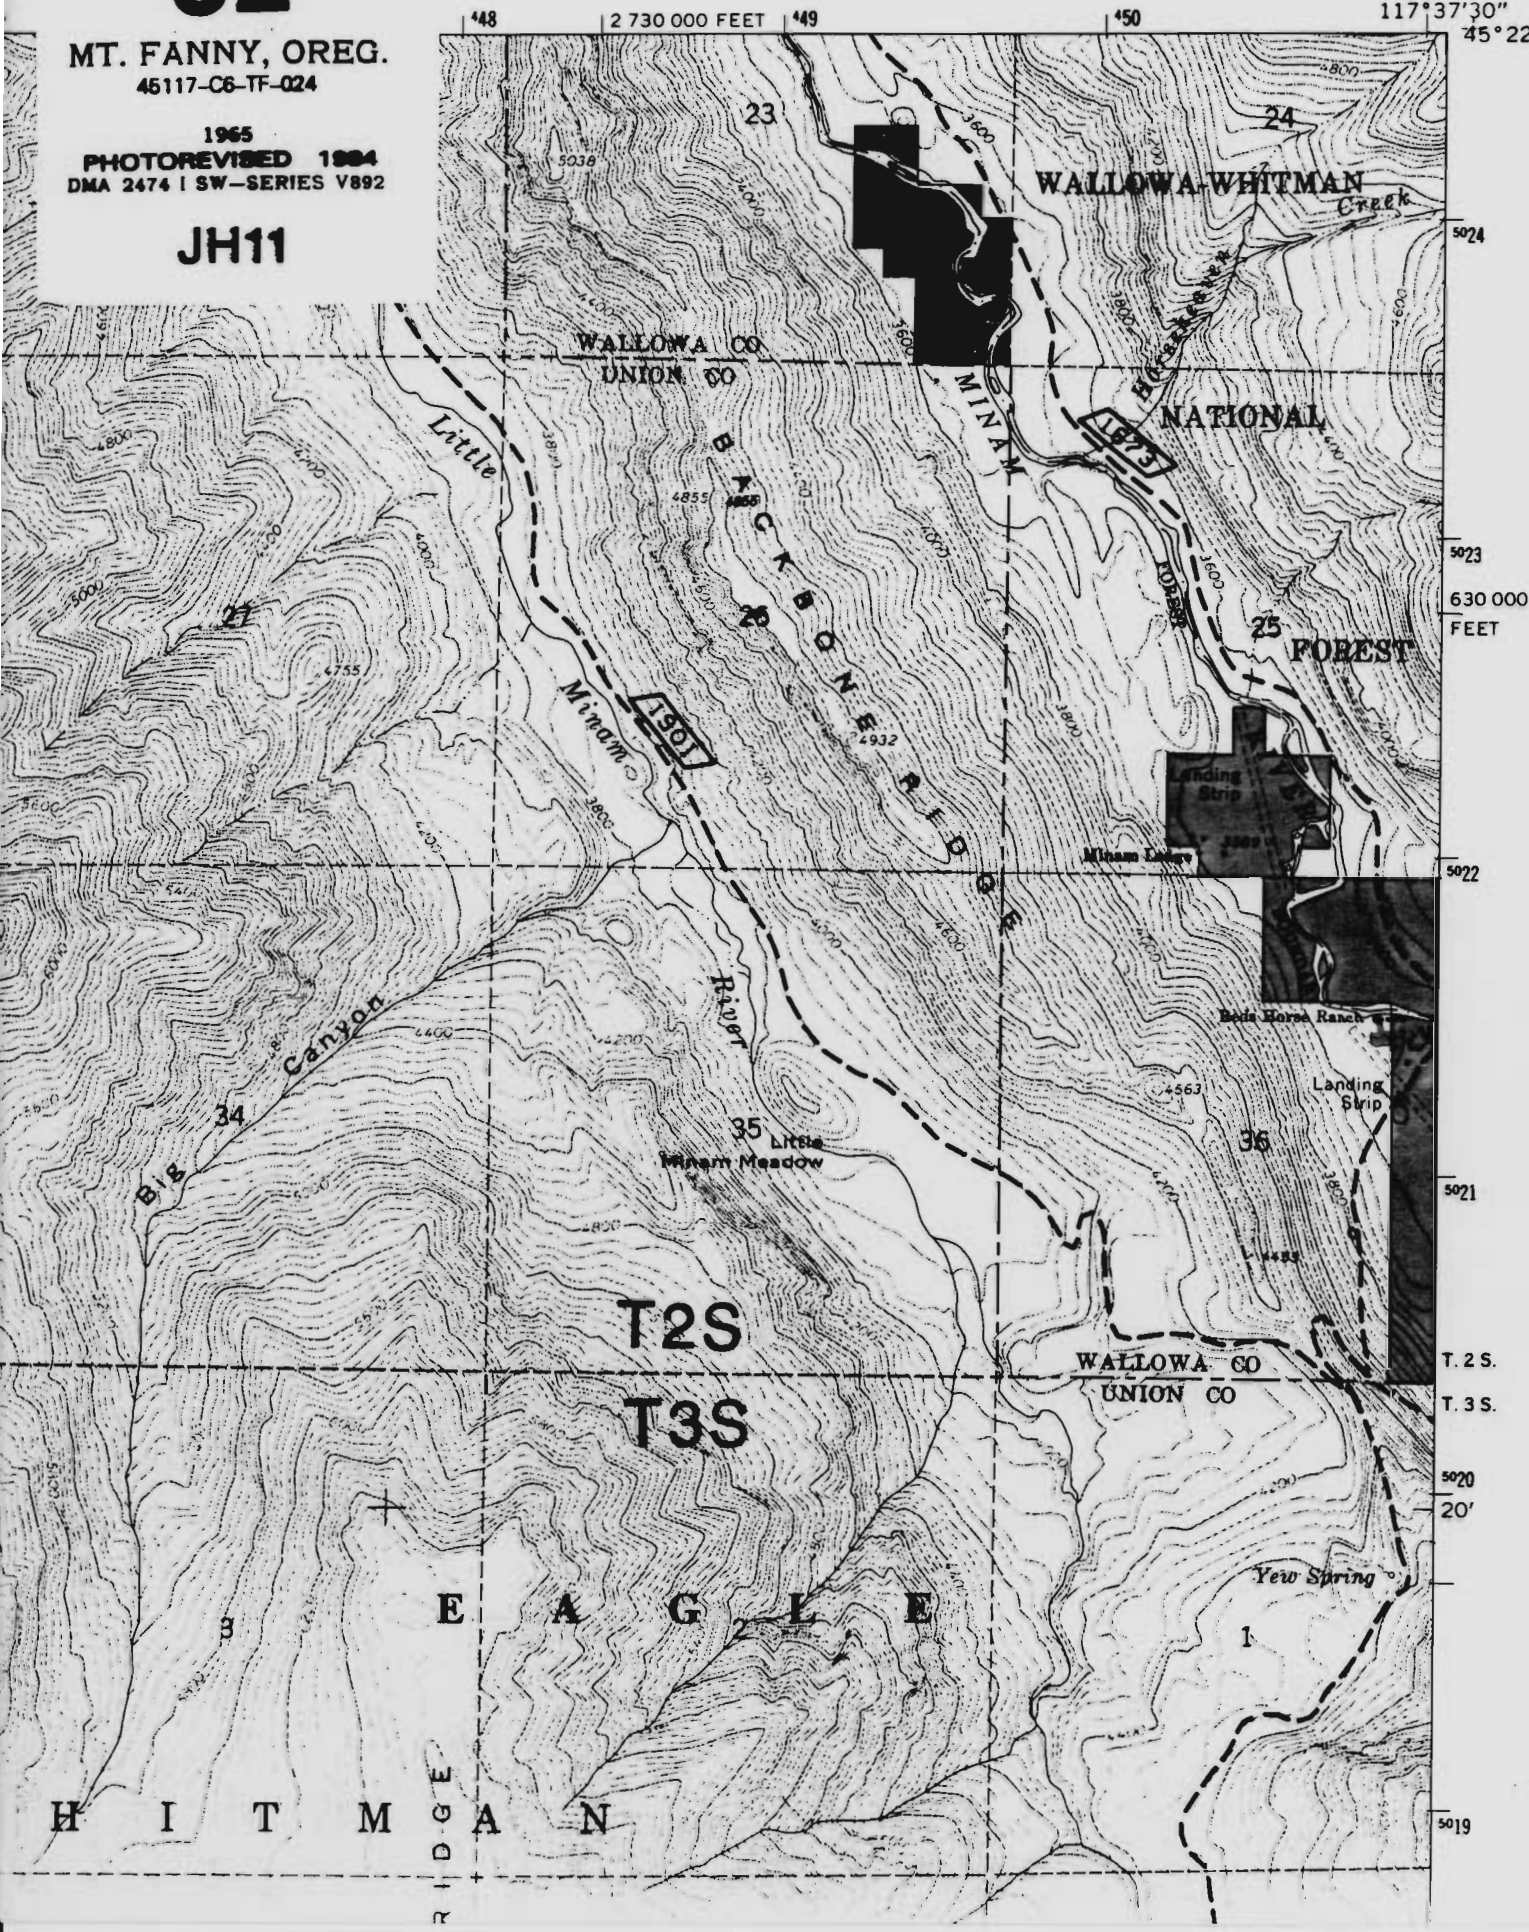

Application No. *R. 796 71*

Permit No. **62**

MT. FANNY QUADRANGLE
OREGON

CERTIFICATE NO. **71517**


7.5 MINUTE SERIES (TOPOGRAPHIC)

2474 1 NE
(FOX POINT)

MT. FANNY, OREG.
45117-C6-TF-024

1965
PHOTOREVISED 1984
DMA 2474 1 SW-SERIES V892

JH11

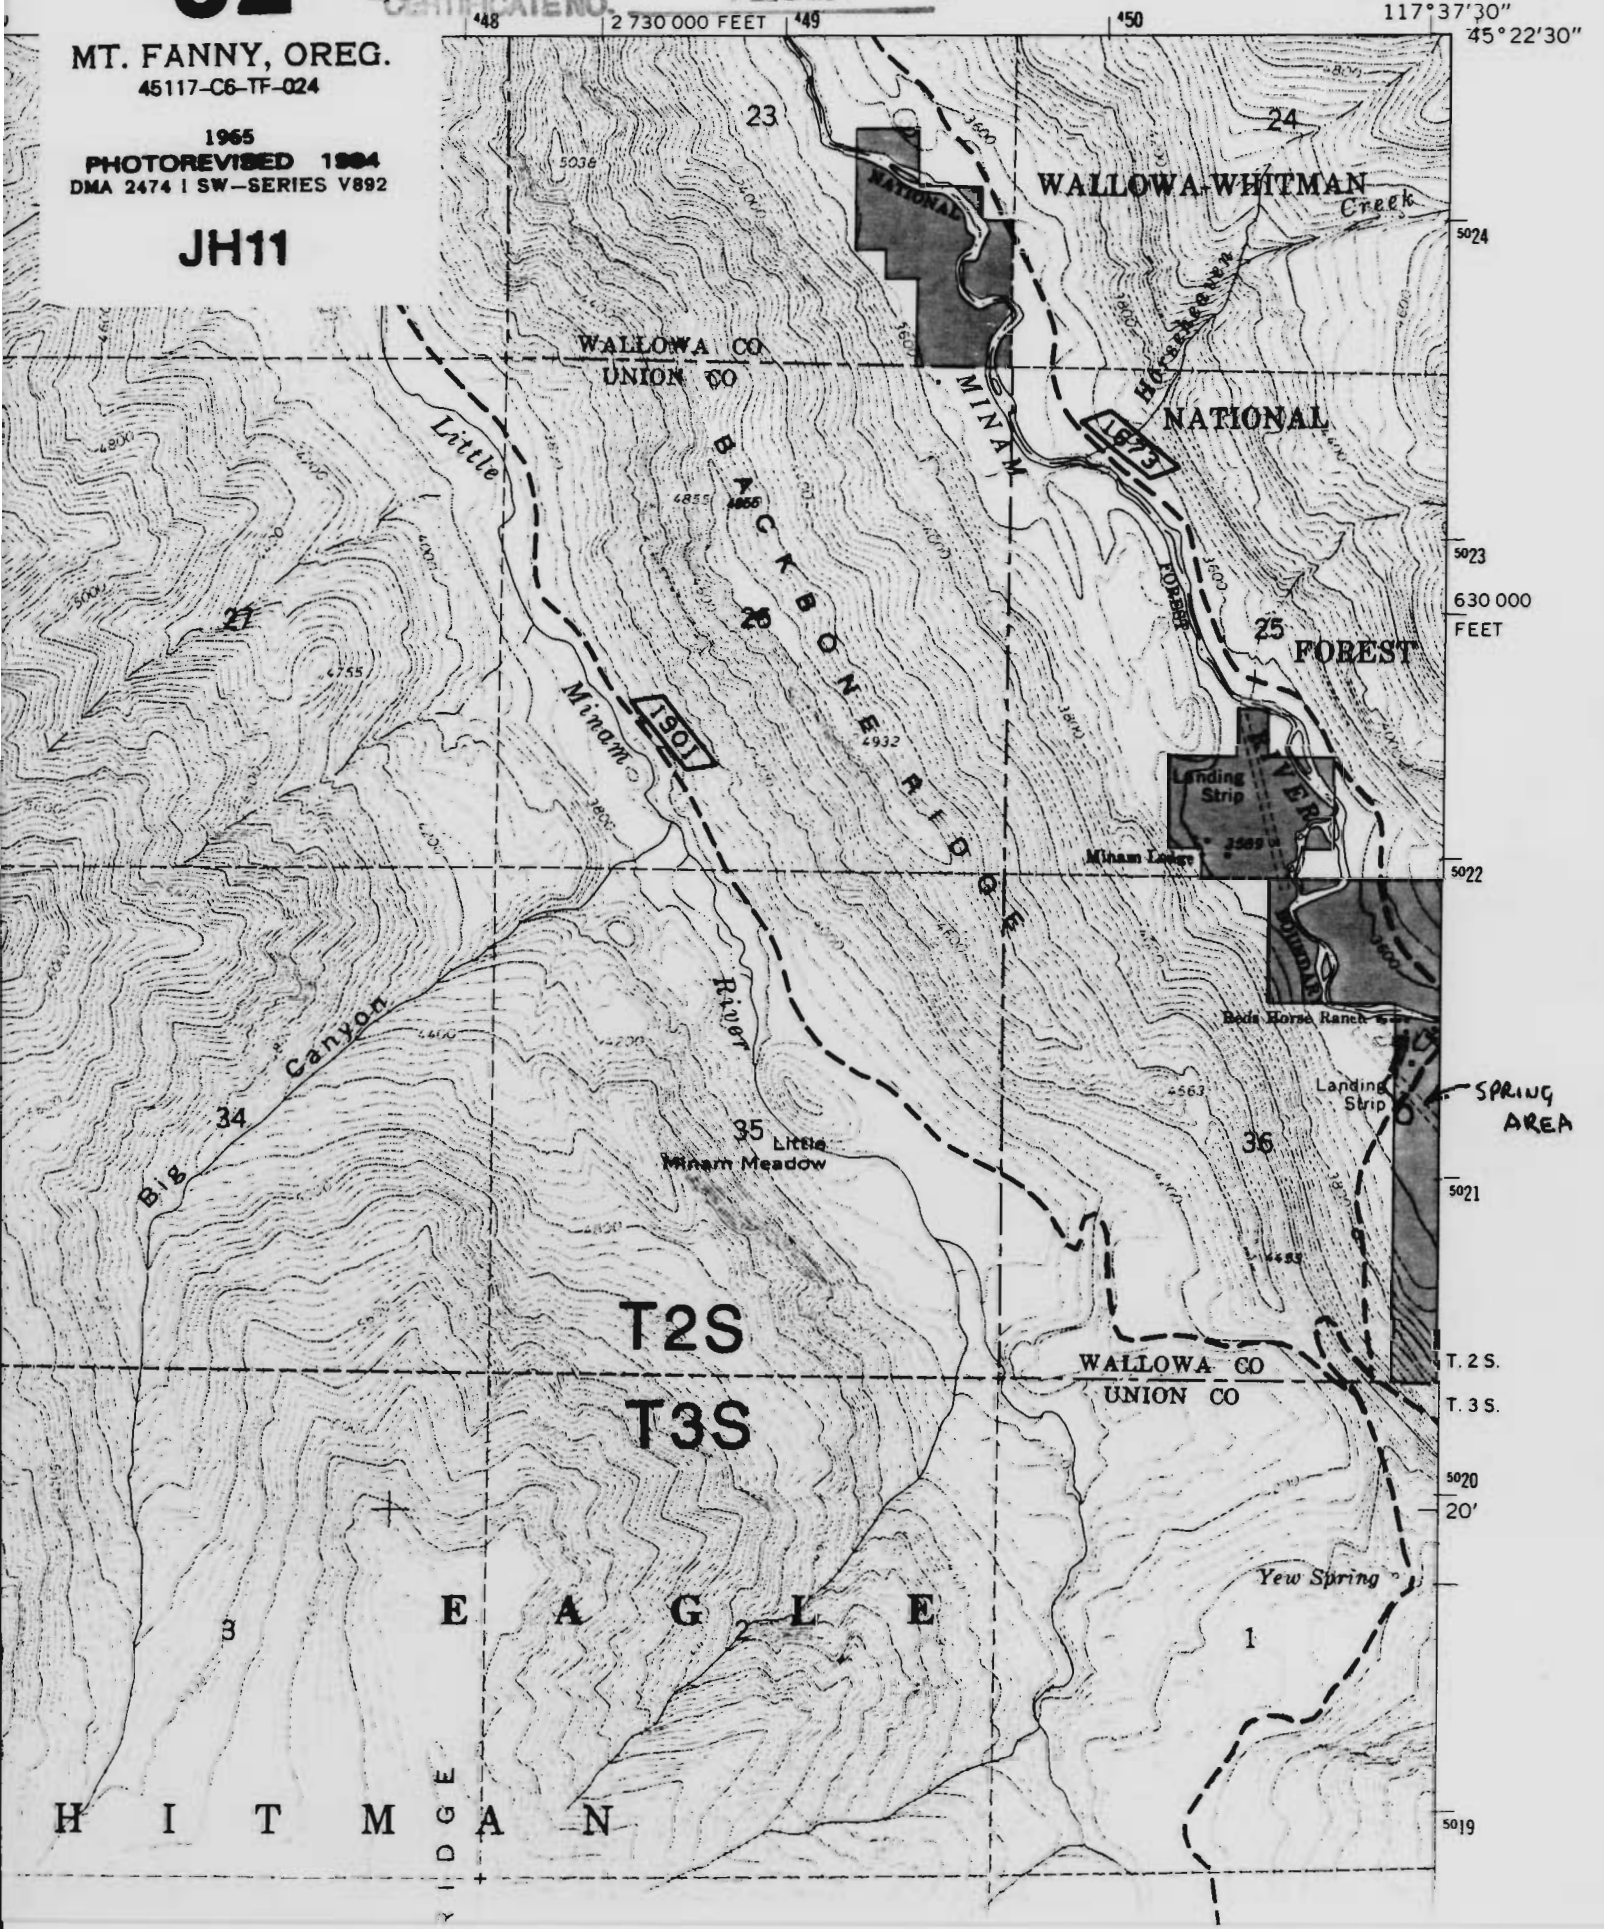

DEPARTMENT OF THE INTERIOR
GEOLOGICAL SURVEY
MODIFIED FOR USDA FOREST SERVICE USE

Application No. R-79071

Permit No.

63

JIM WHITE RIDGE, OREG.
45117-C5-TF-024

1966
PHOTOREVISED 1984
DMA 2474 I SE-SERIES V892

JH12

