

1963

1x3475

ATION

BREACHED

POND # 51 Creek

Baldwin Area

Spencer


POND #2

POND #3

Coon¹

Application No. R-79675

Permit No. "CERTIFICATE NO. 71521

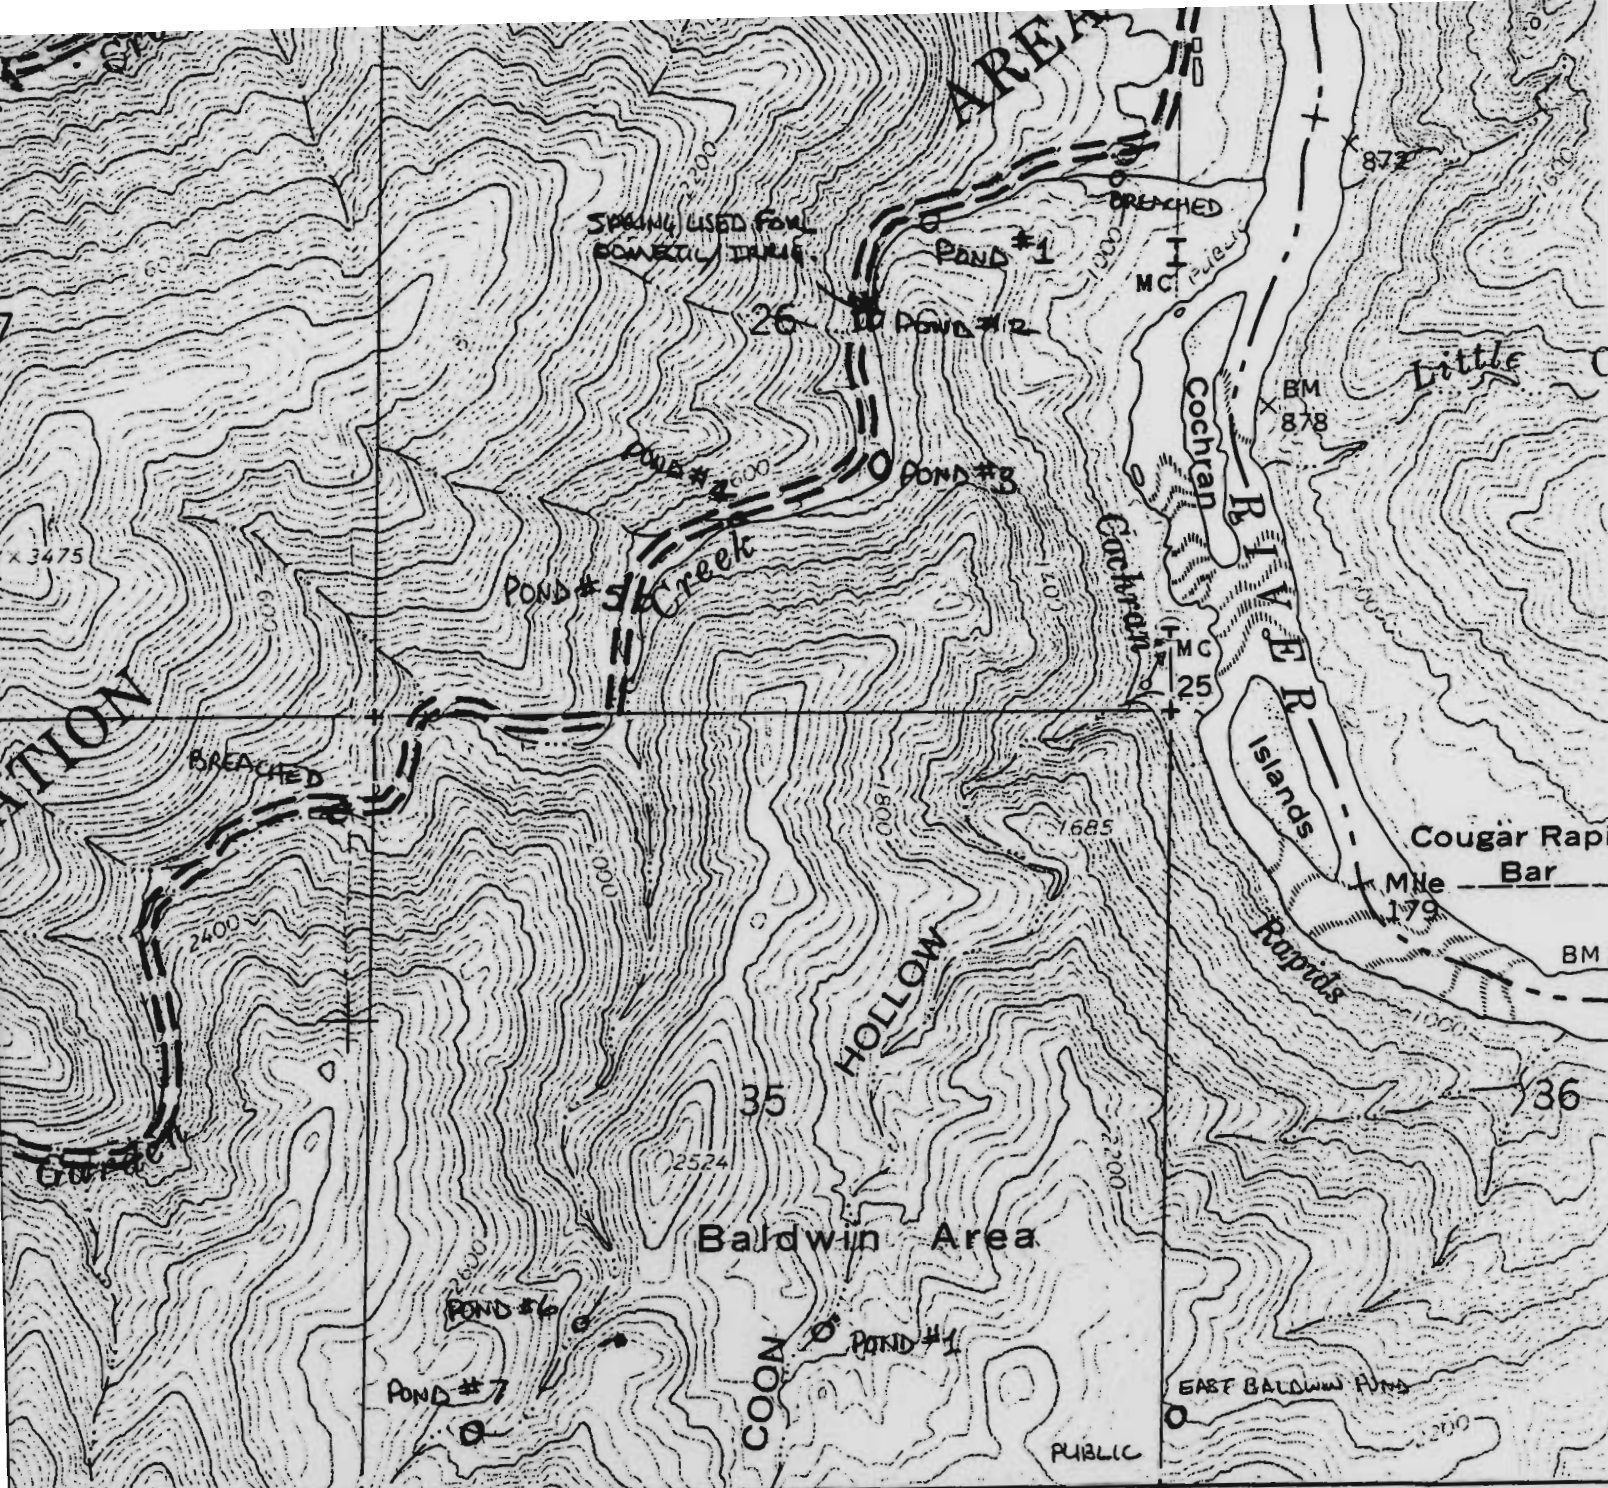

TSN, R47E
8

JIM CREEK BUTTE
OREG.-IDAHO--WASH.
N4552.5--W11652.5/7.5

1963


Permit No.

CERTIFICATE NO.



T6N, R47E

8

JIM CREEK BUTTE
OREG.-IDAHO--WASH.

N4552.5--W11652.5/7.5

1963

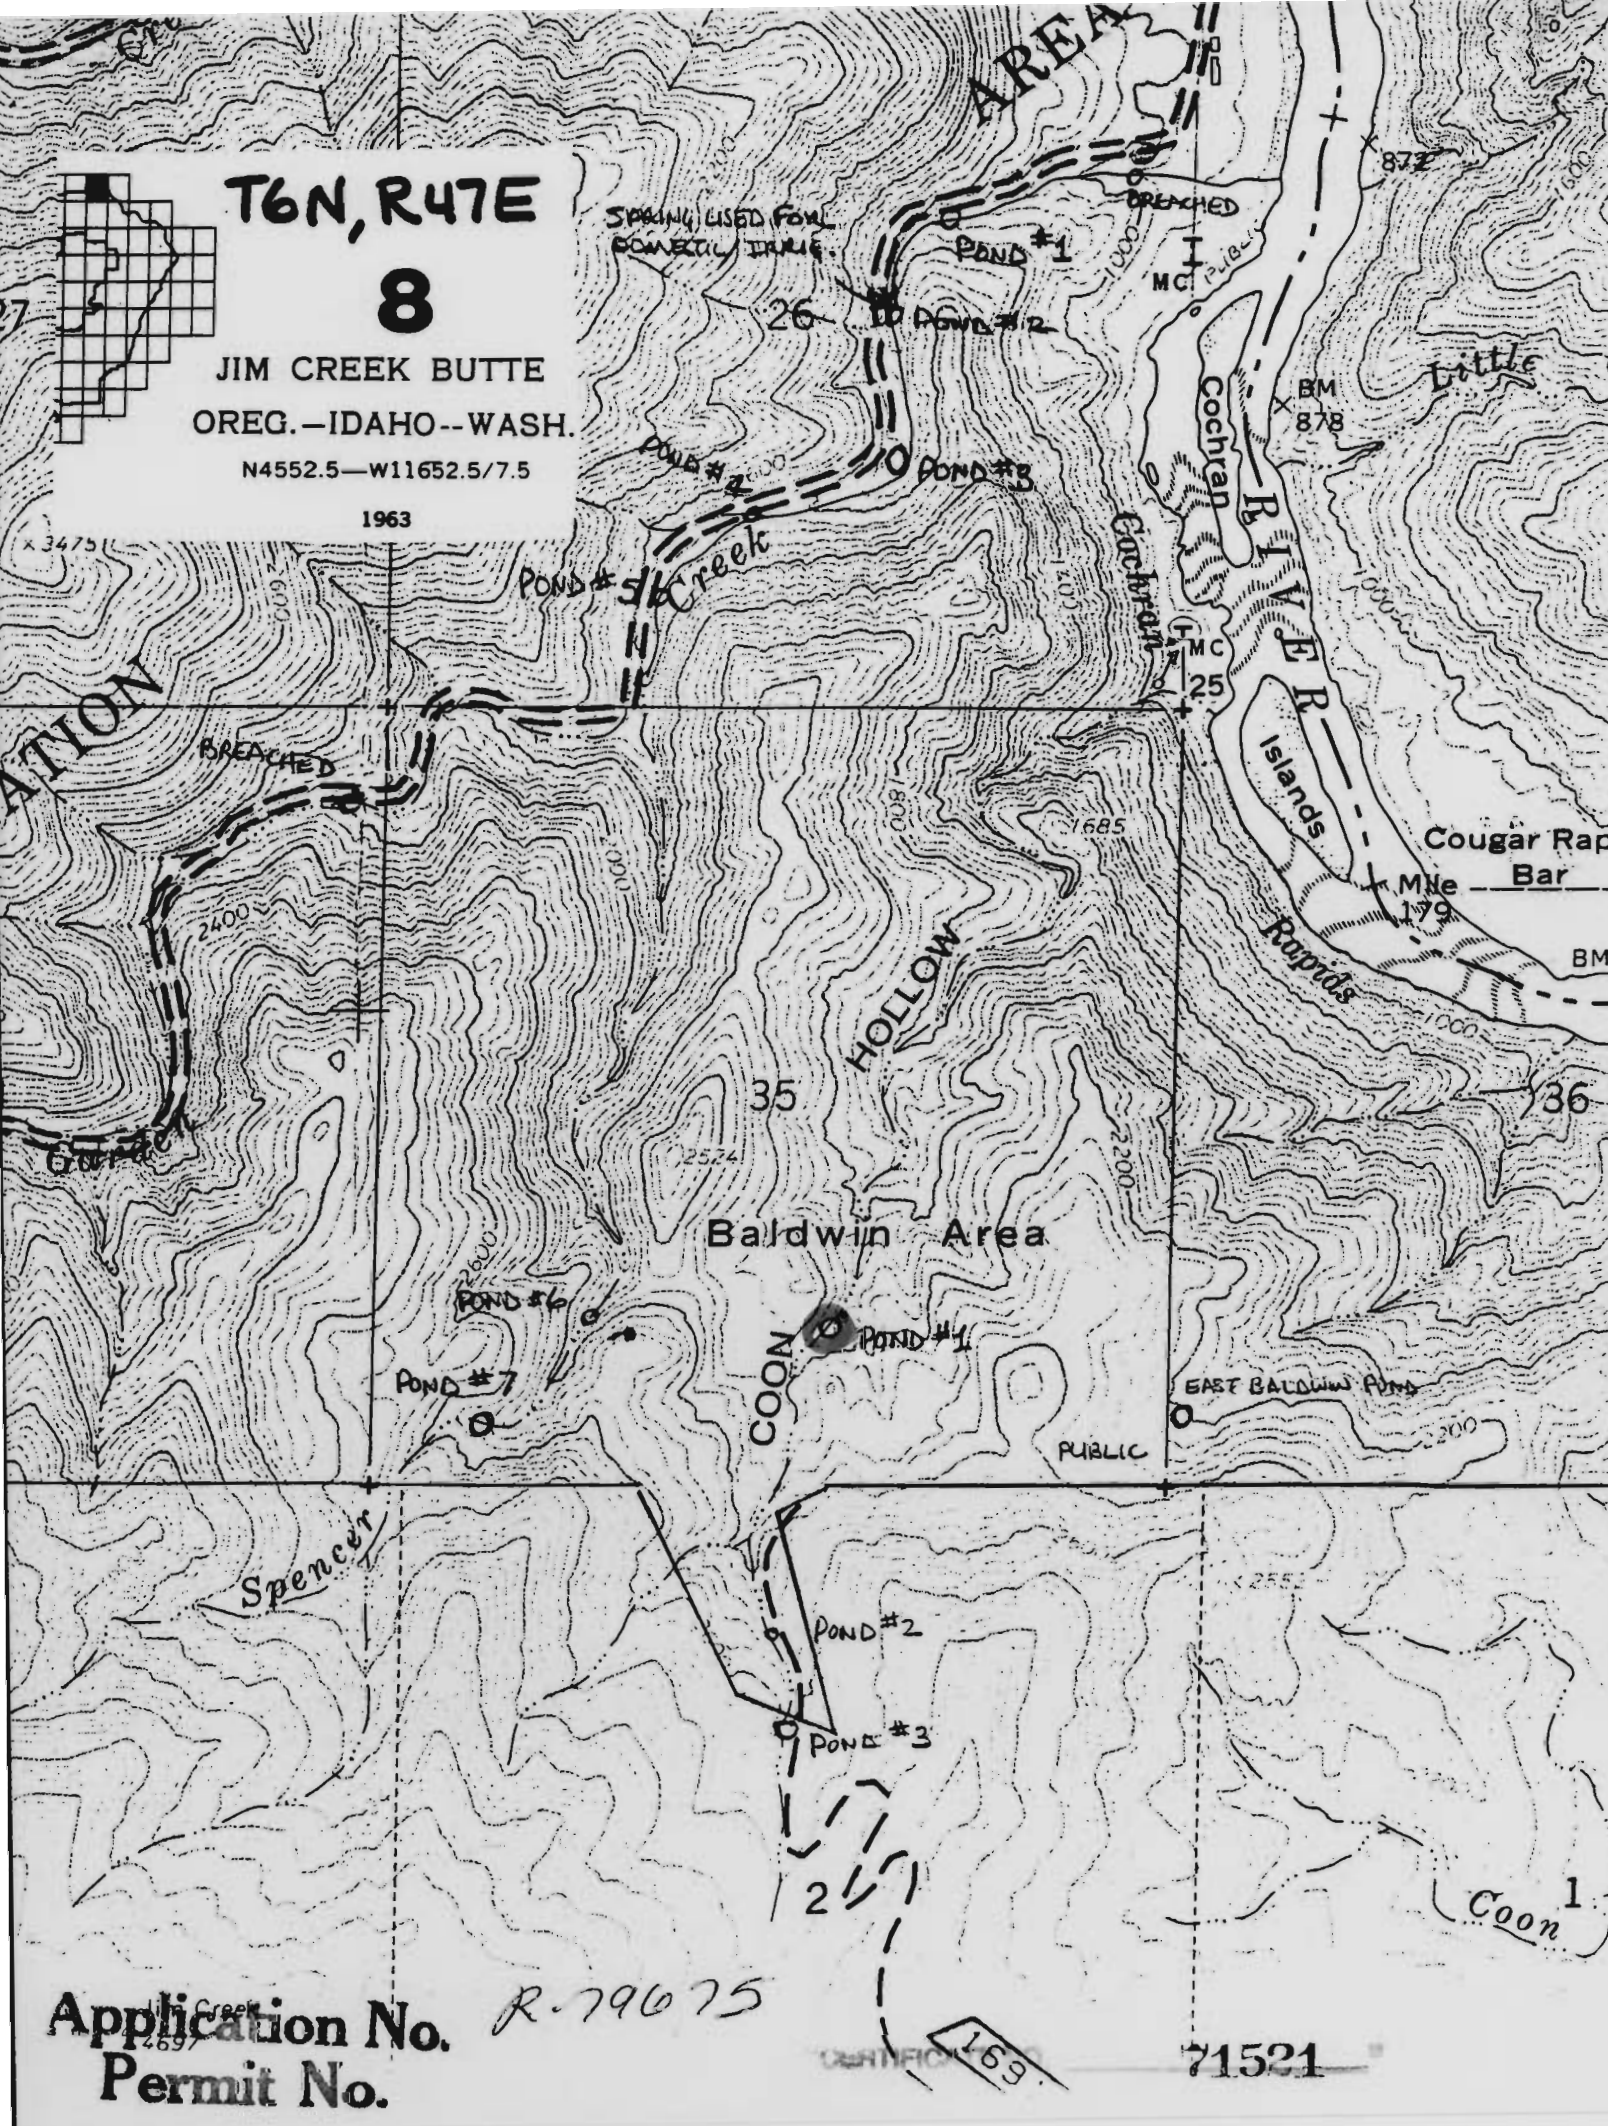

Application No.
Permit No.

R-79675

169

71521