


T6N R47E

8

JIM CREEK BUTTE
OREG. - IDAHO - WASH.

N4552.5 - W11652.5 / 7.5

1963

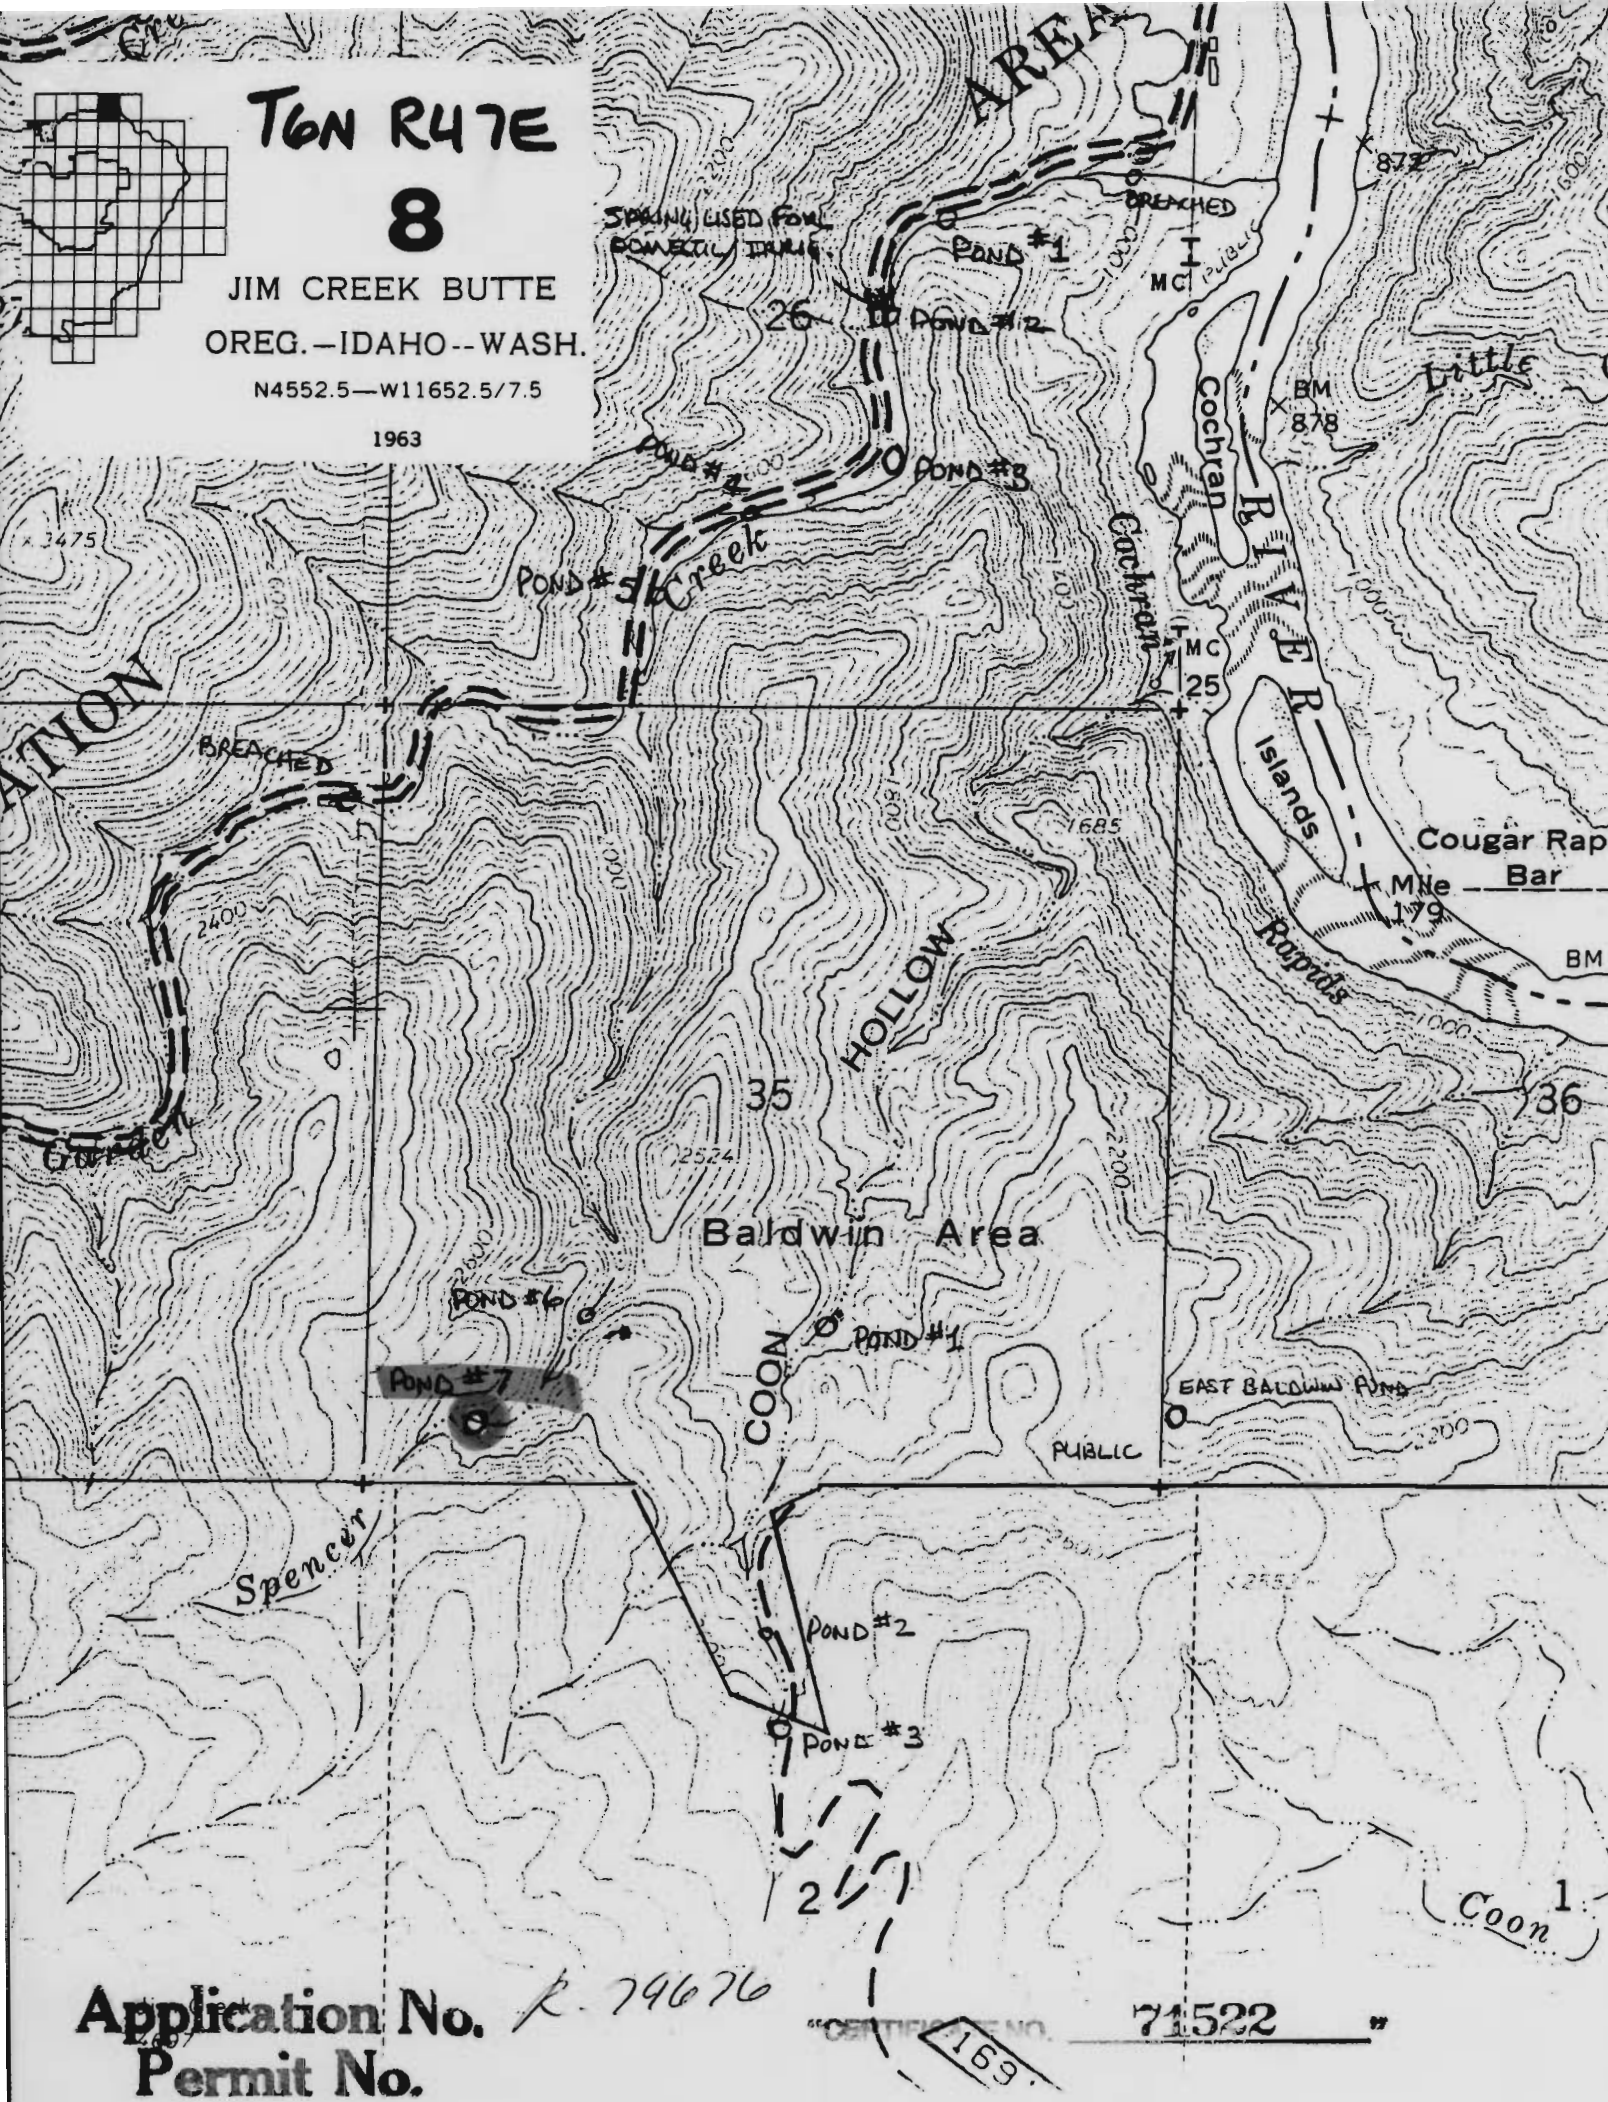

Application No.

R. 74676


Permit No.

CERTIFICATE NO.

169

71522

"

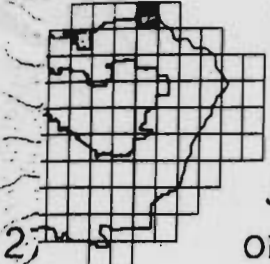


TGN RUTE 8

JIM CREEK BUTTE
OREG. - IDAHO - WASH.

N4552.5 - W11652.5/7.5

1963

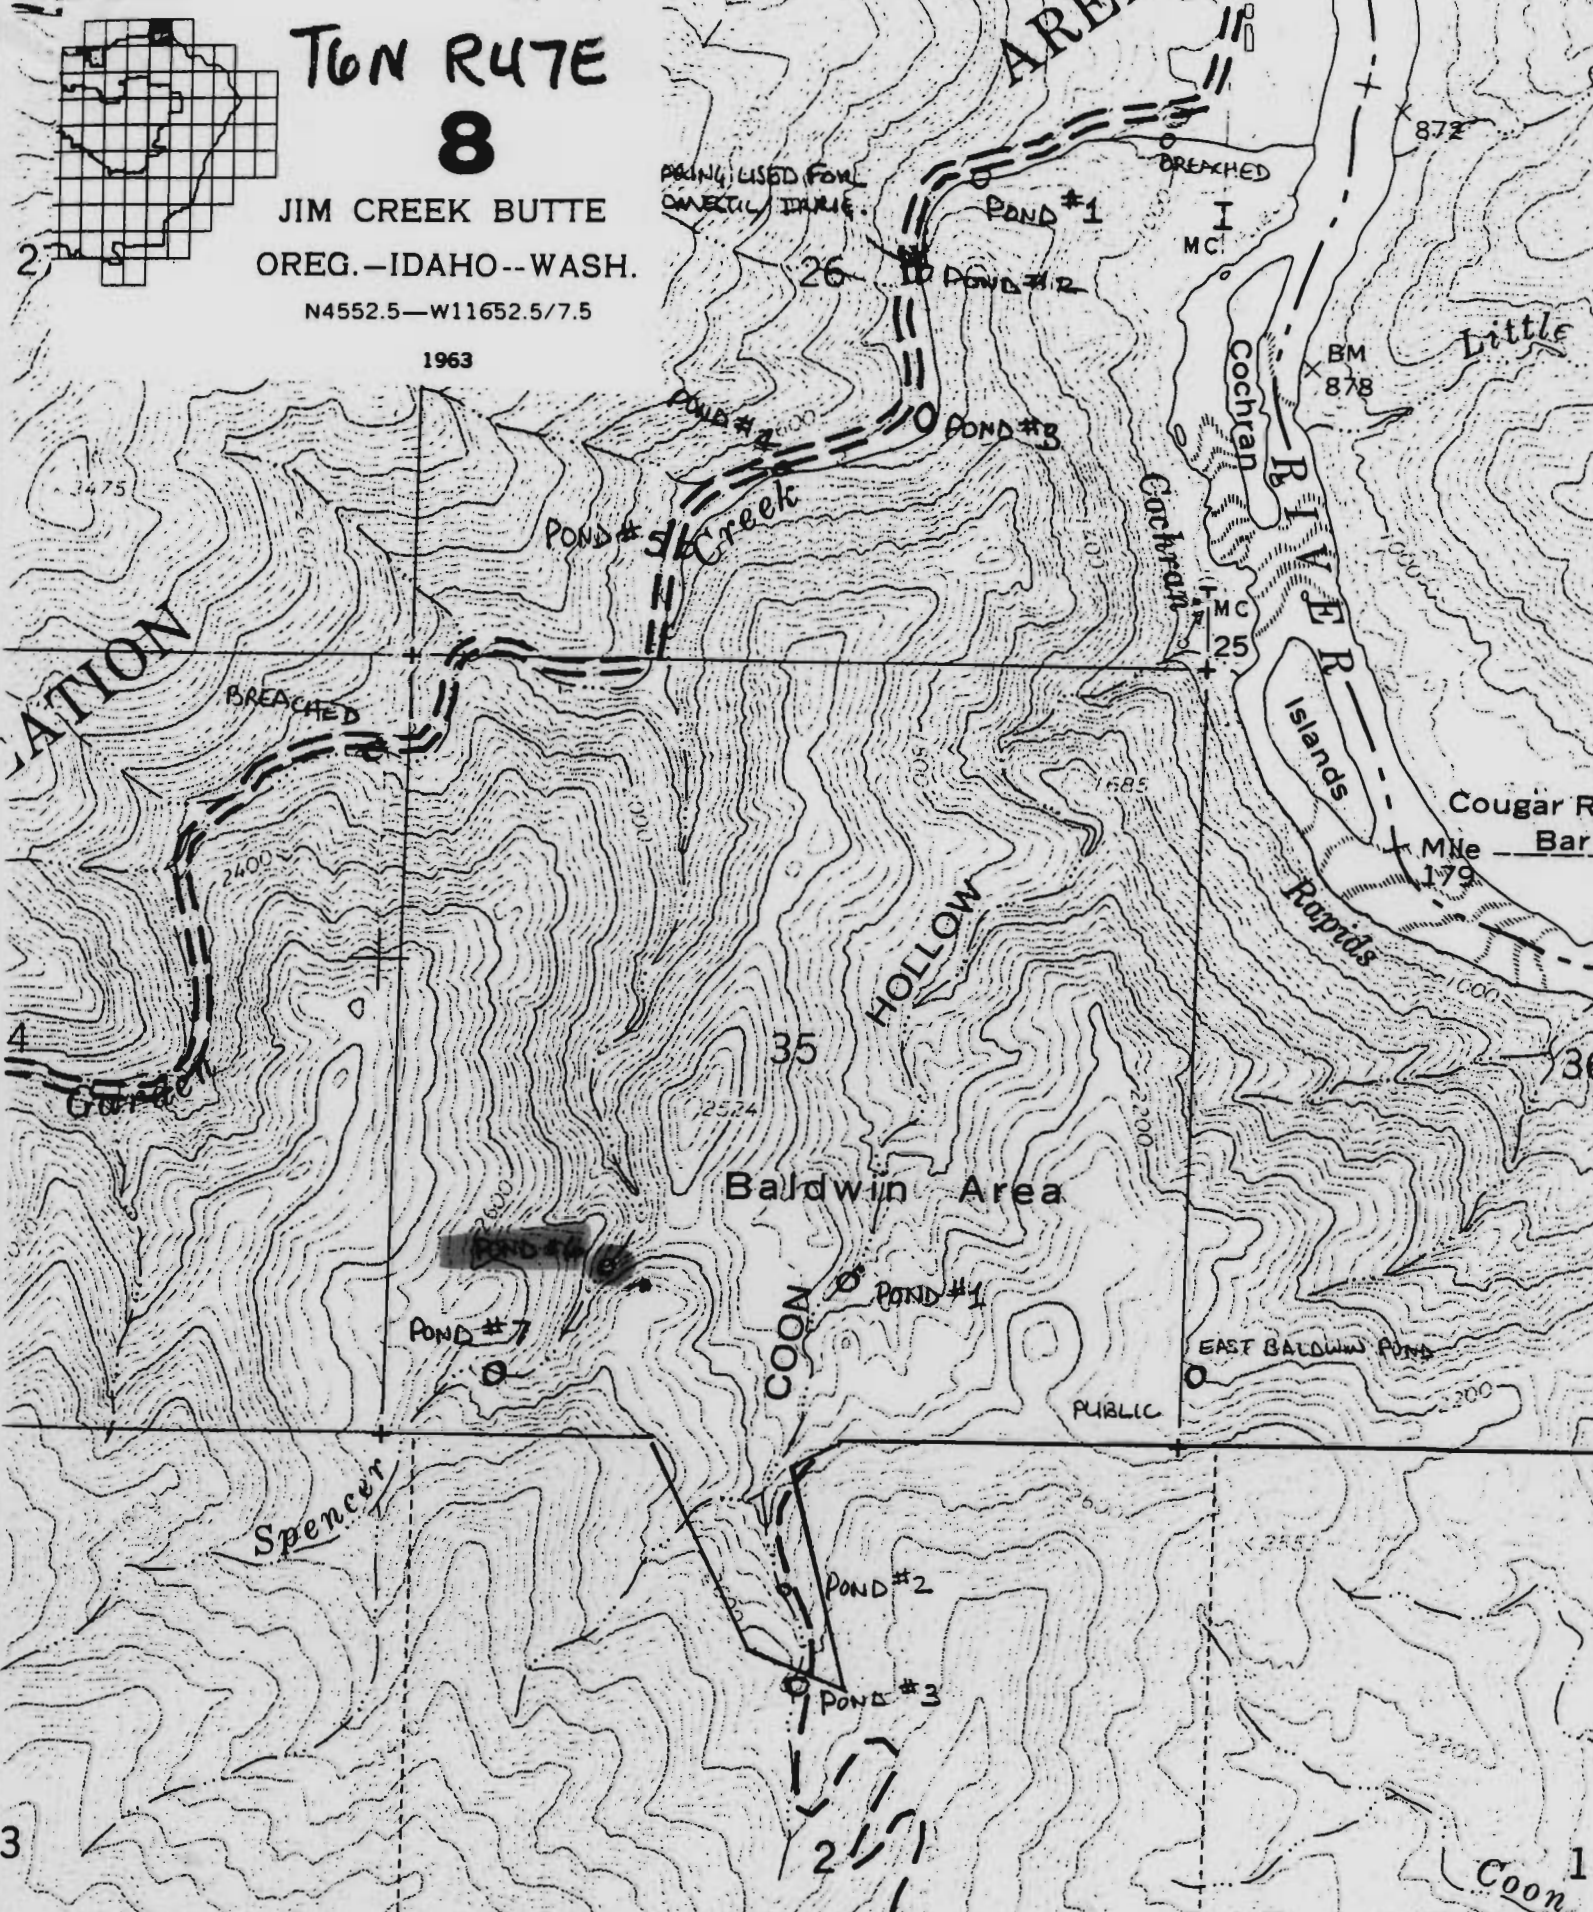

Application No. *R-79676*
Permit No. *4697*

71522

CERTIFICATE NO.

1691




T6N R47E

8

JIM CREEK BUTTE
OREG. - IDAHO - WASH.

N4552.5 - W11652.5/7.5

1963

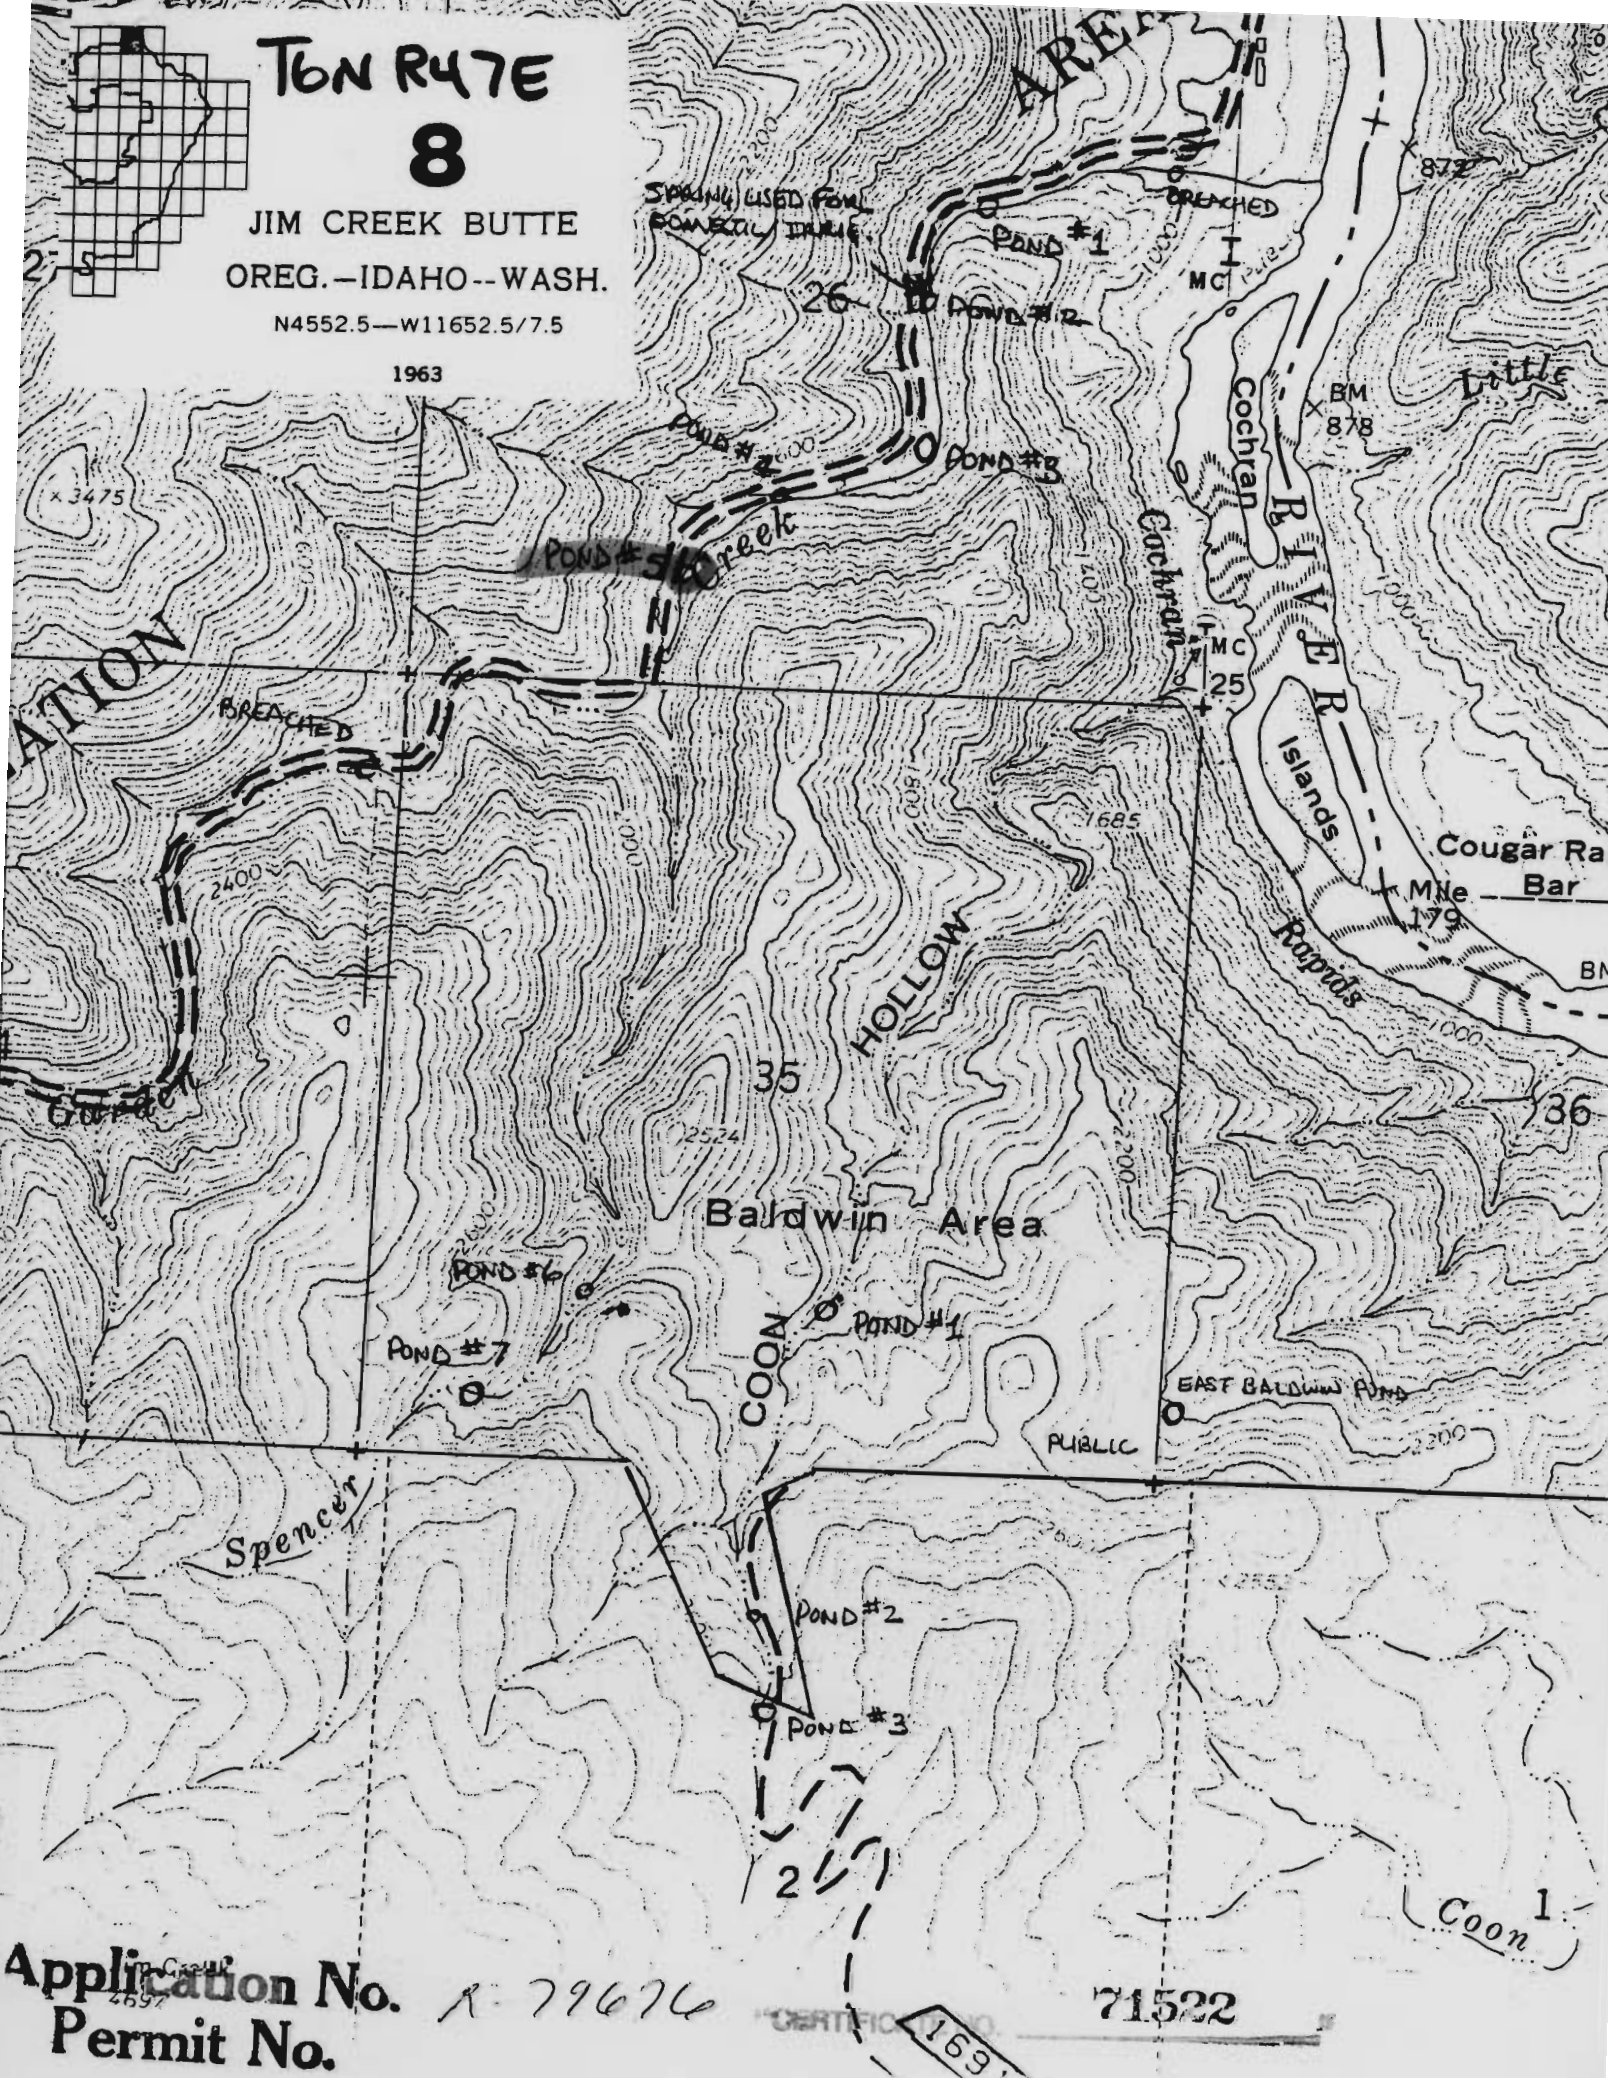

Application No. 79676
Permit No.

71522

169



T6N R47E

8

JIM CREEK BUTTE
OREG.-IDAHO--WASH.

N4552.5--W11652.5/7.5

1963

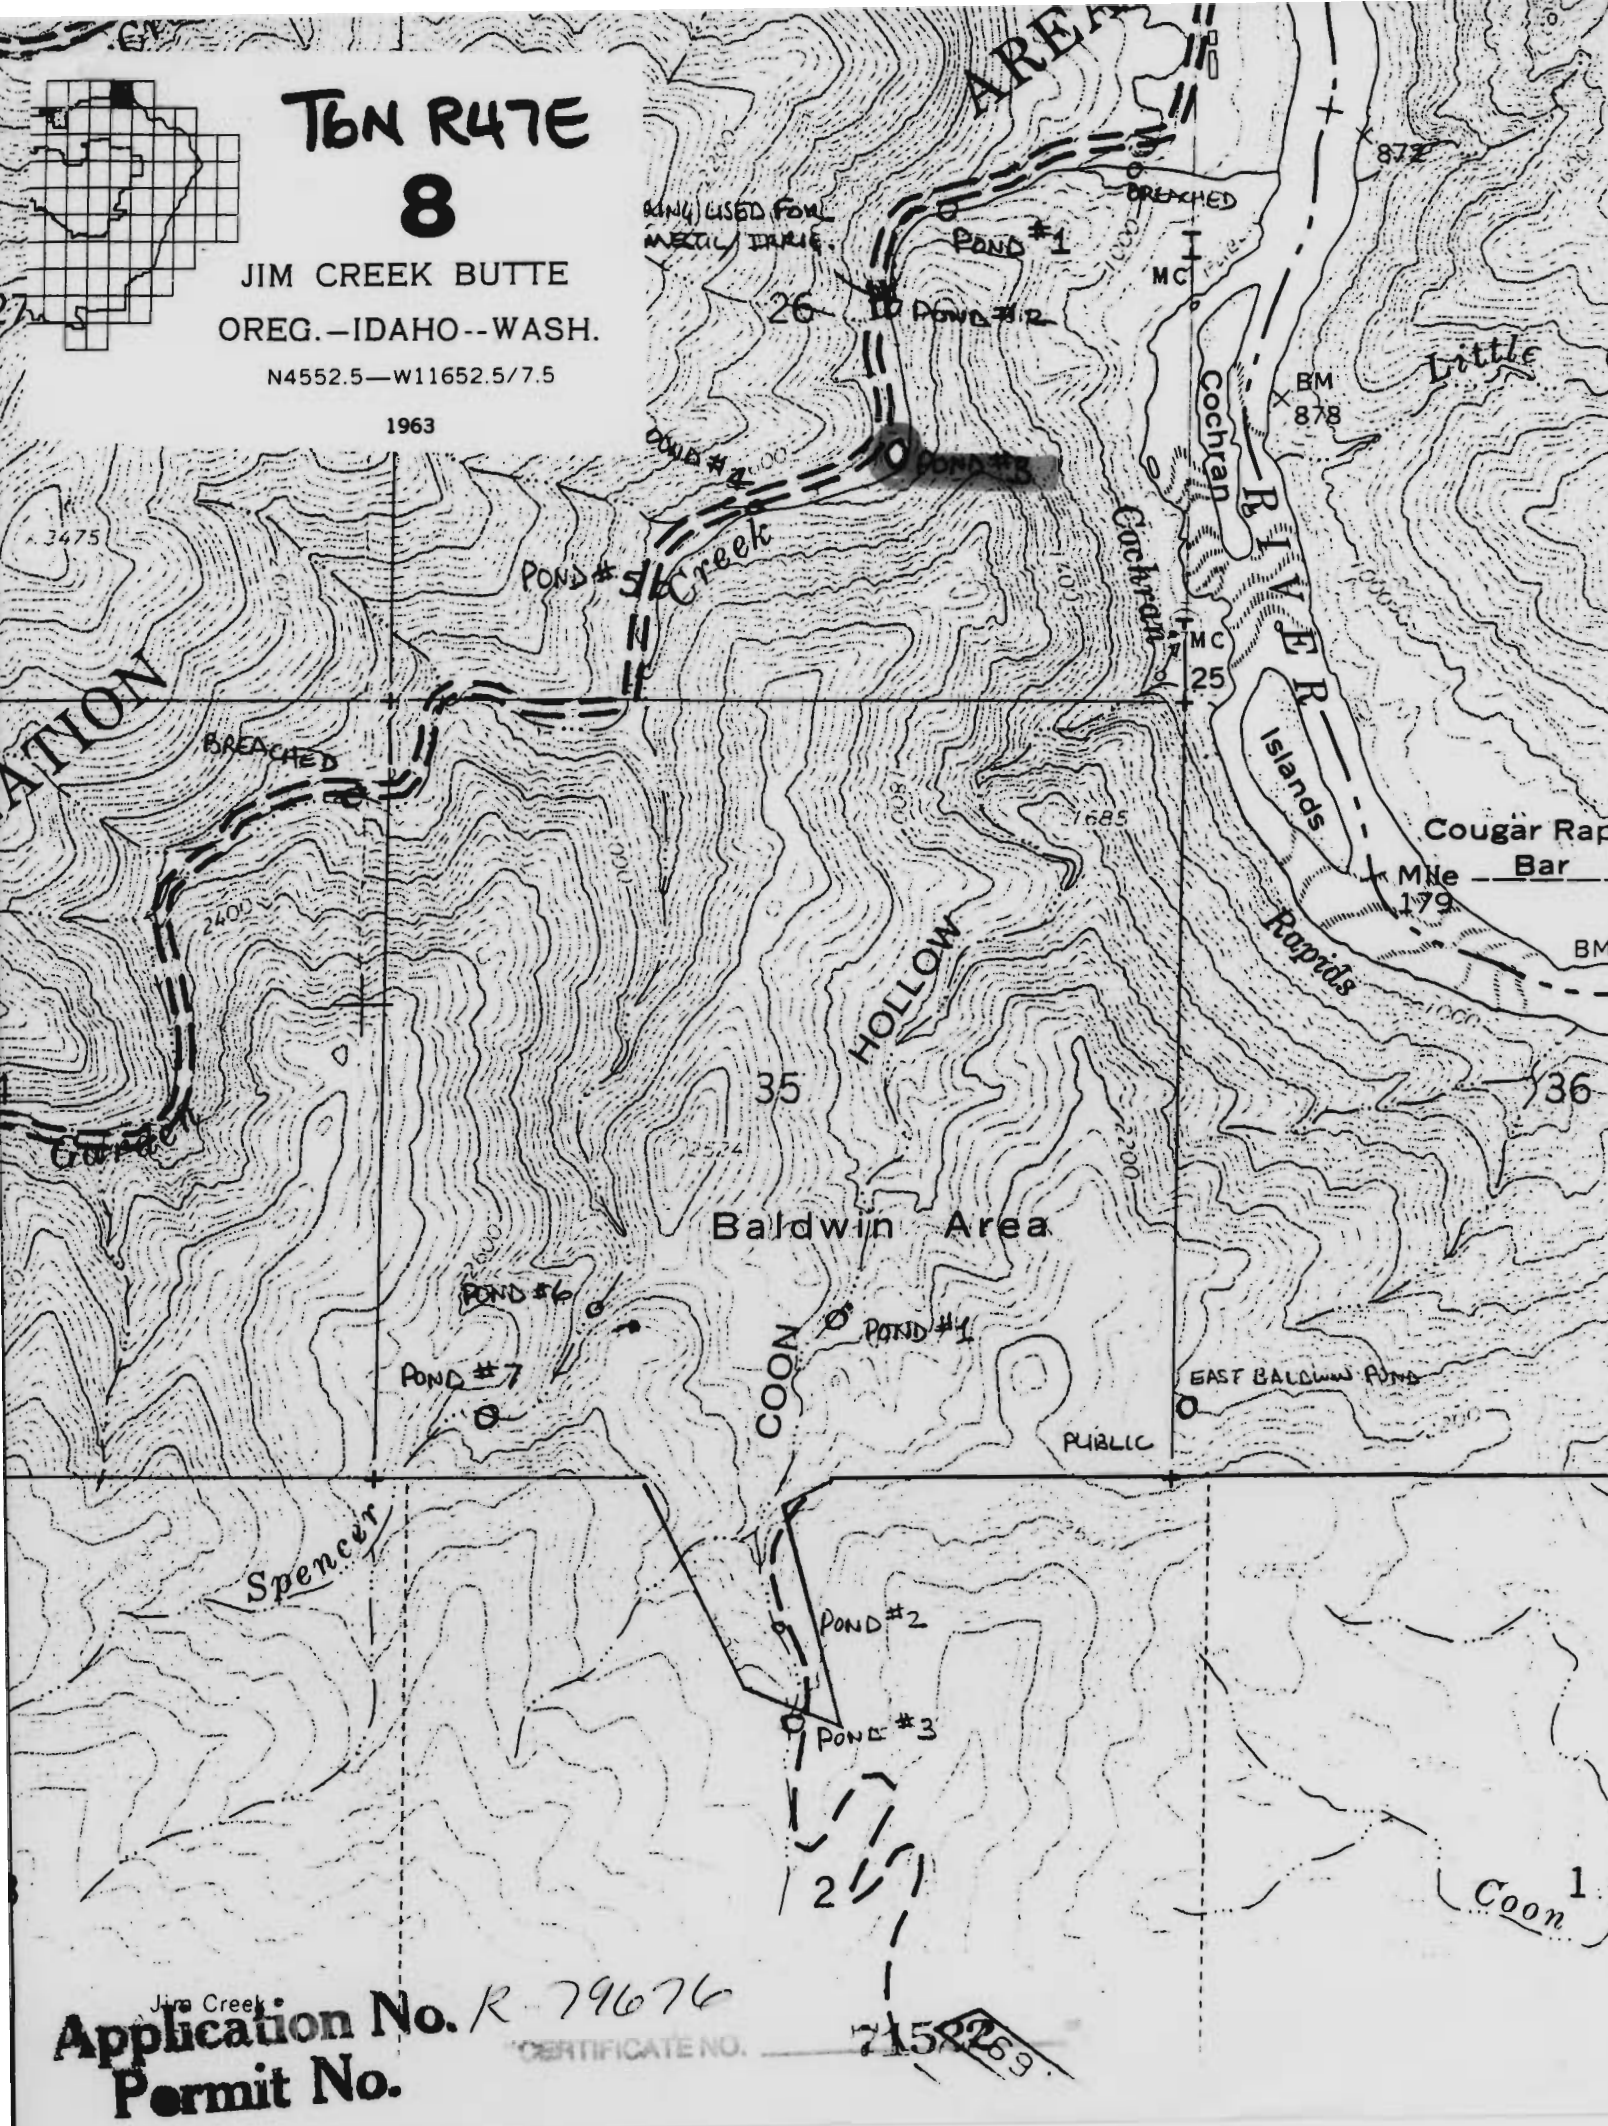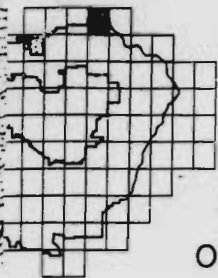


POND #1

POND #2

POND #3

POND #4

BREACHED

2400

35

Baldwin Area

POND #6

POND #7

POND #4

EAST BALDWIN POND

Spencer

POND #2

POND #3

25

Coon 1

Jim Creek
Application No. R-79676
Permit No.

CERTIFICATE NO.

7152269


T6N R47E

8

JIM CREEK BUTTE
OREG.-IDAHO--WASH.

N4552.5--W11652.5/7.5

1963

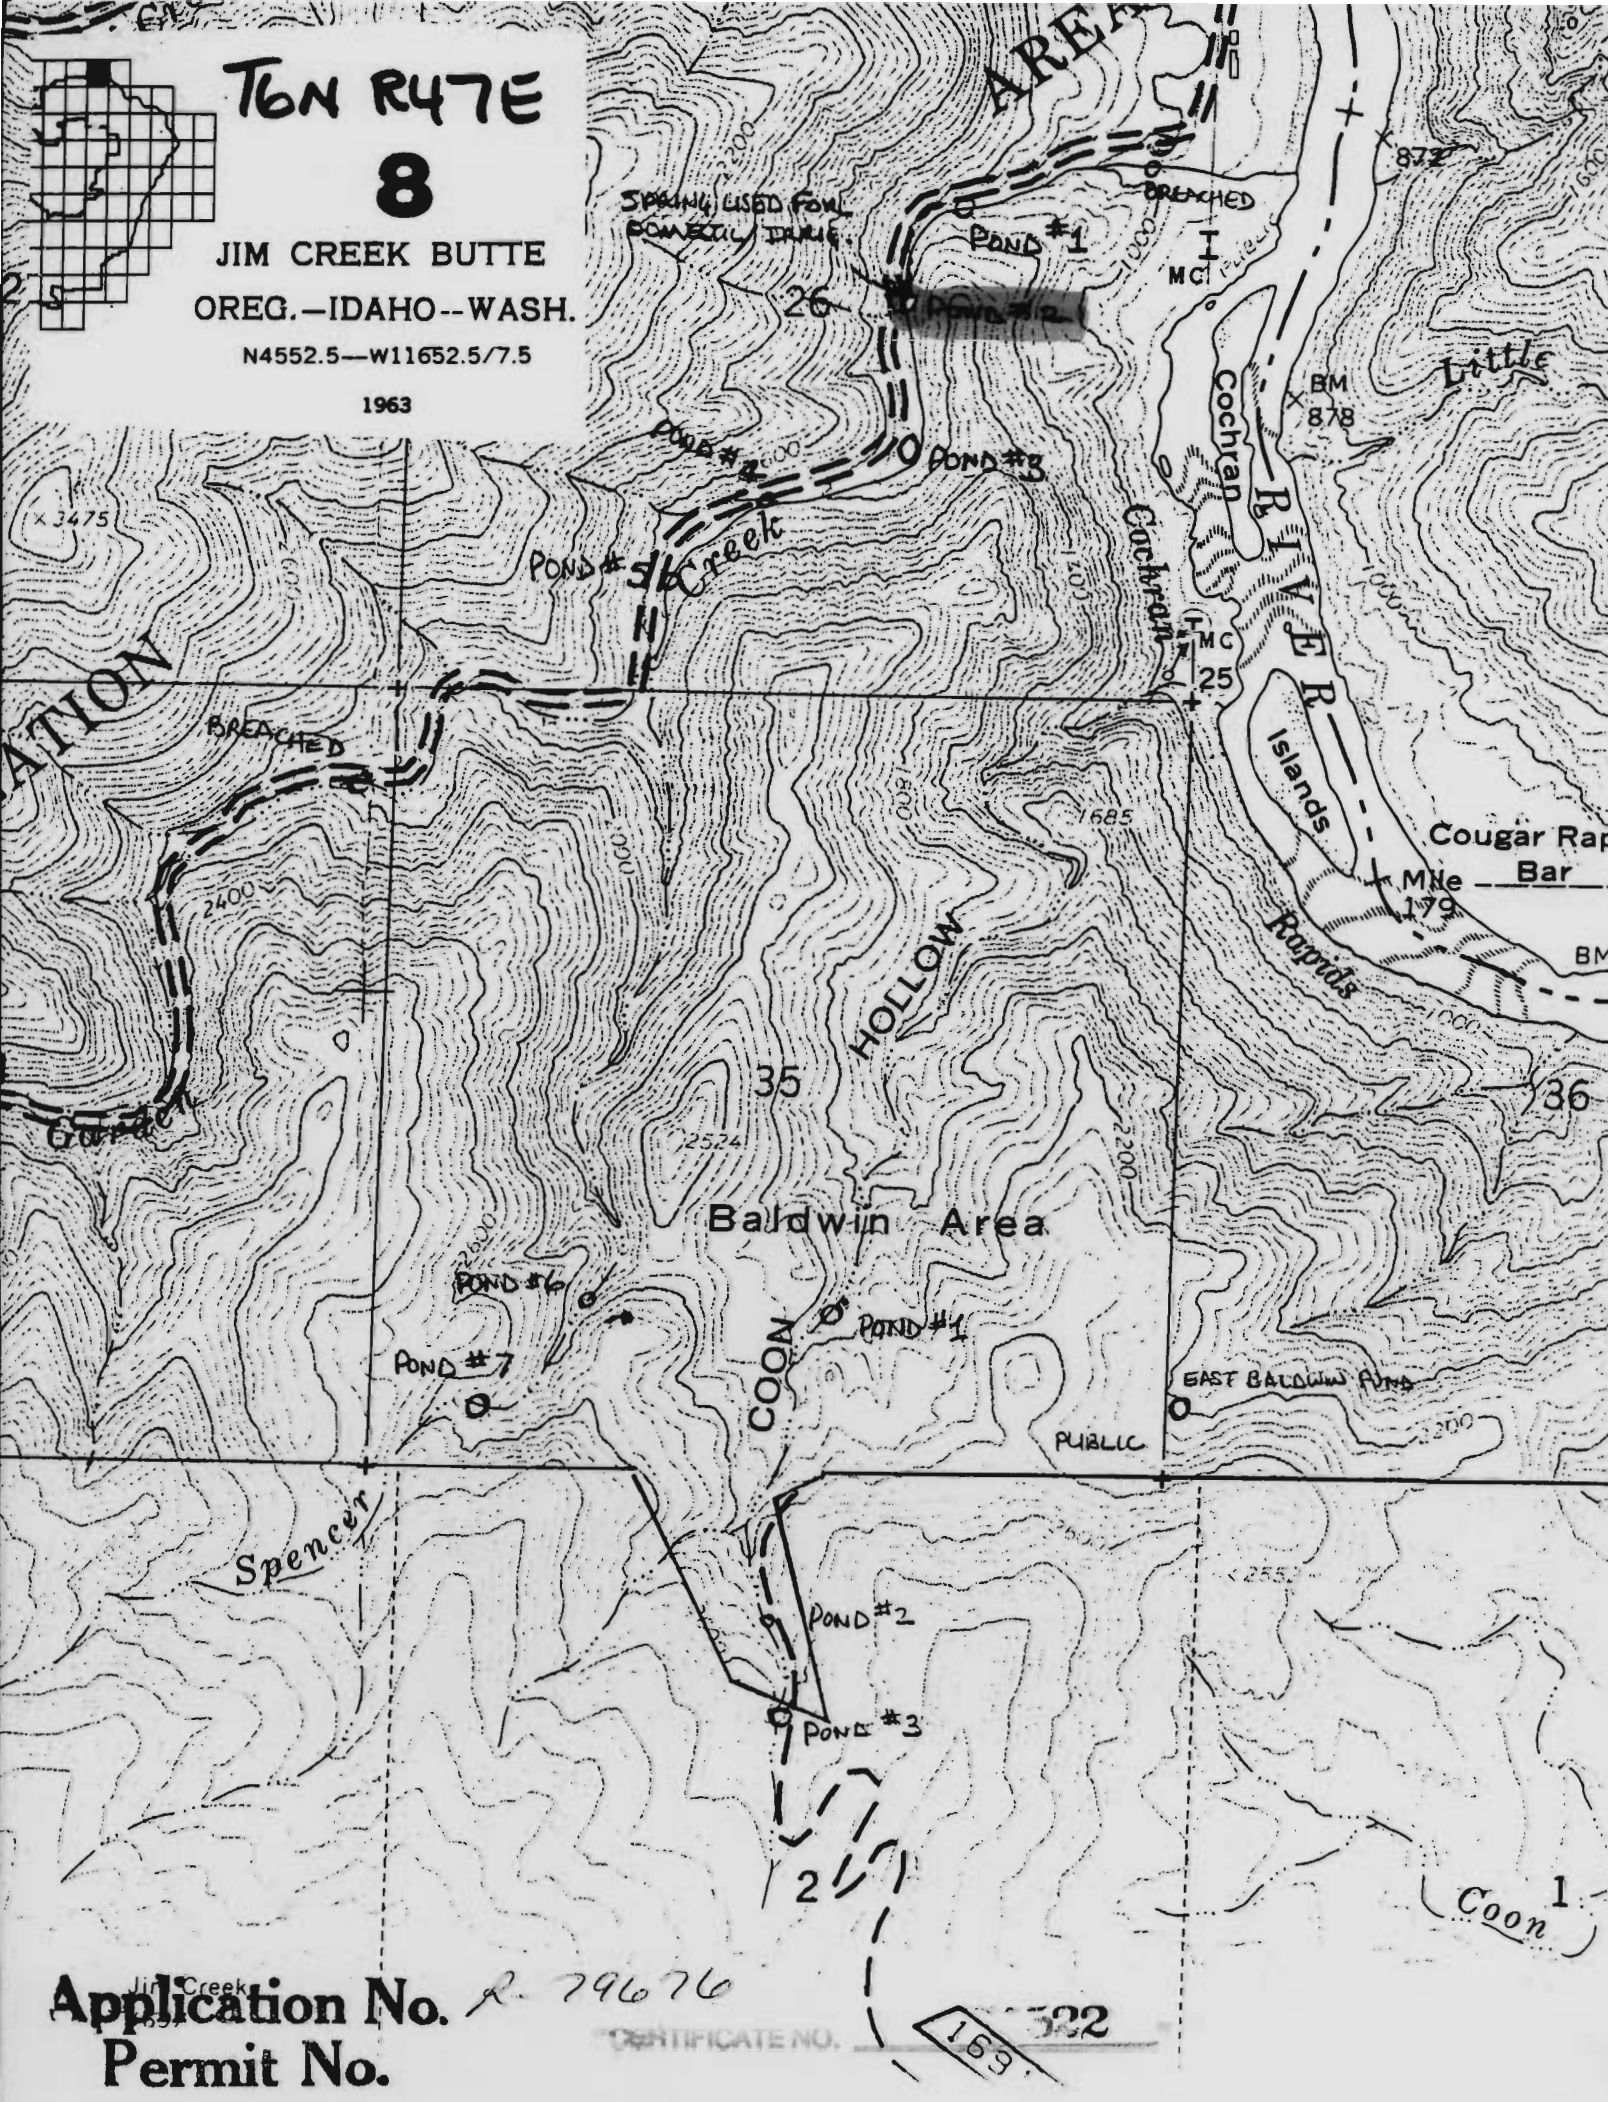

Application No. *2-79676*
Permit No.

CERTIFICATE NO. *169* *322*


T6N R47E

8

**JIM CREEK BUTTE
OREG.-IDAHO--WASH.**

N4552.5--W11652.5/7.5

1963

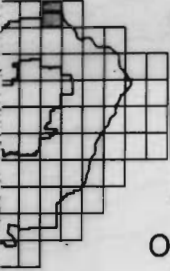

AREA

SPRING USED FOR DOMESTIC DRINK.

POND #1

POND #2

POND #3

POND #4

POND #5

POND #6

POND #7

POND #1

POND #2

POND #3

BREACHED

BREACHED

EAST BALDWIN POND

Cochran RIVER

HOLLOW

Baldwin Area

COON

Spencer

Application No. R-79676

Permit No.

"CERT. NO. 71592"

169

872

BM 878

MC 25

Cougar Ra Bar

MNe 179

3475

1685

35

36

2324


2200

2200

2250

3

Coon 1

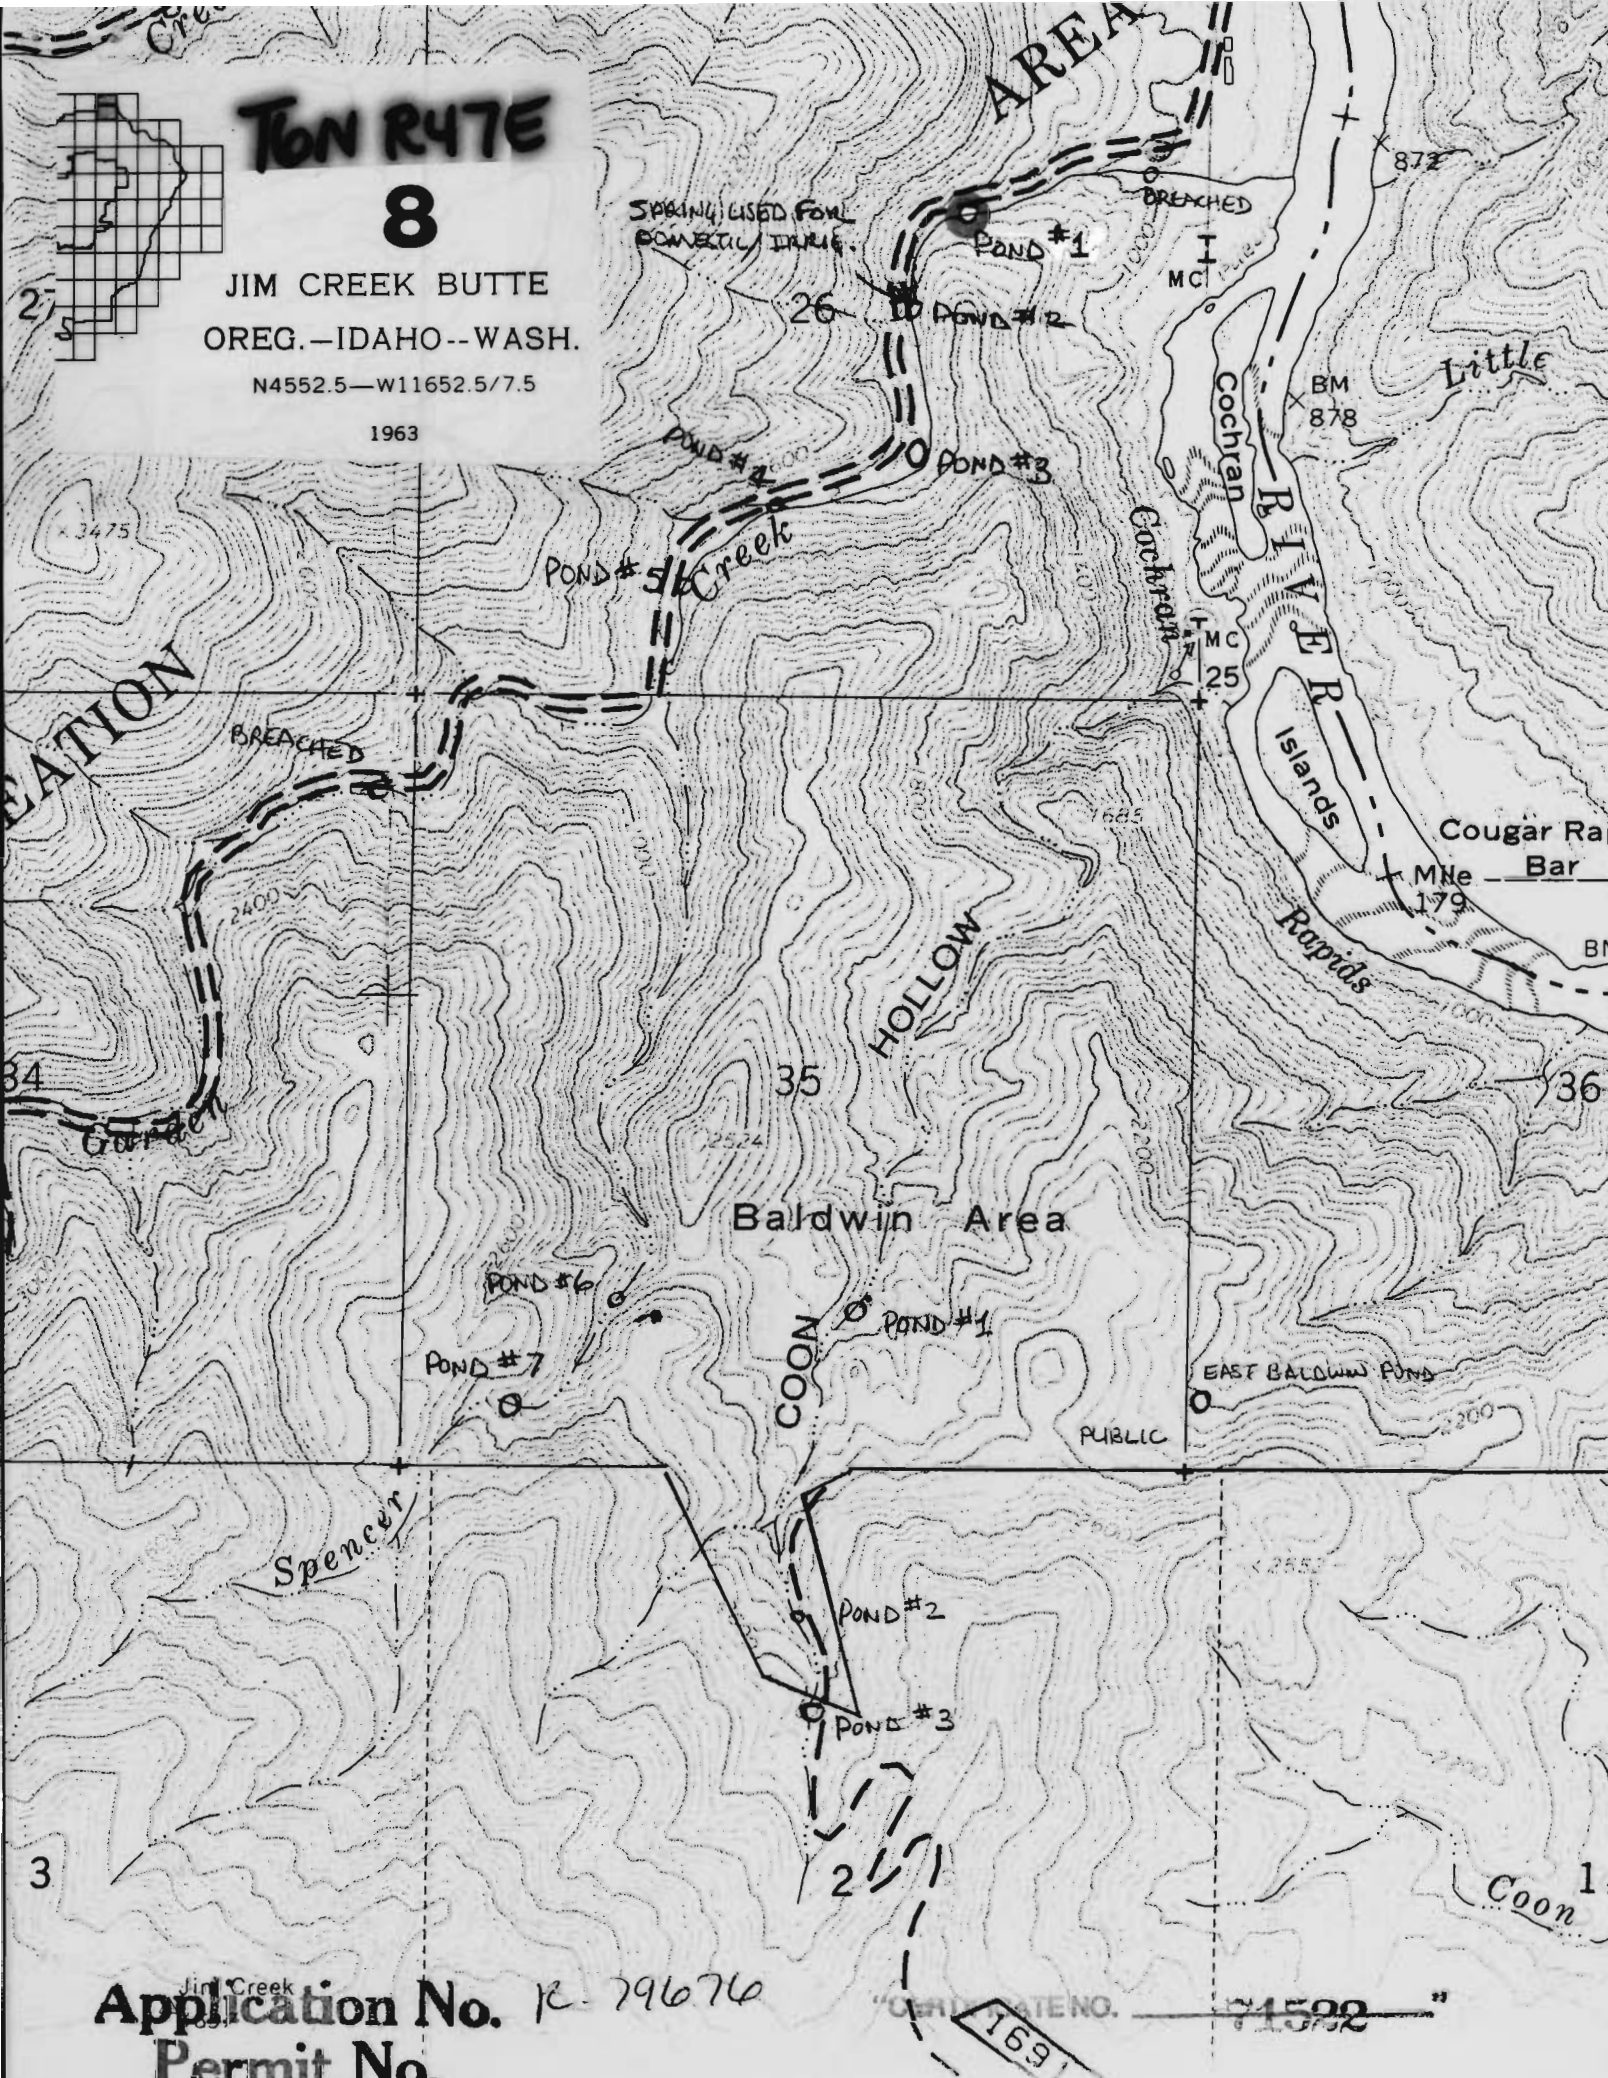

Application No. R. 79674




T6N R47E




8

JIM CREEK BUTTE
OREG.-IDAHO--WASH.

N4552.5--W11652.5/7.5

1963

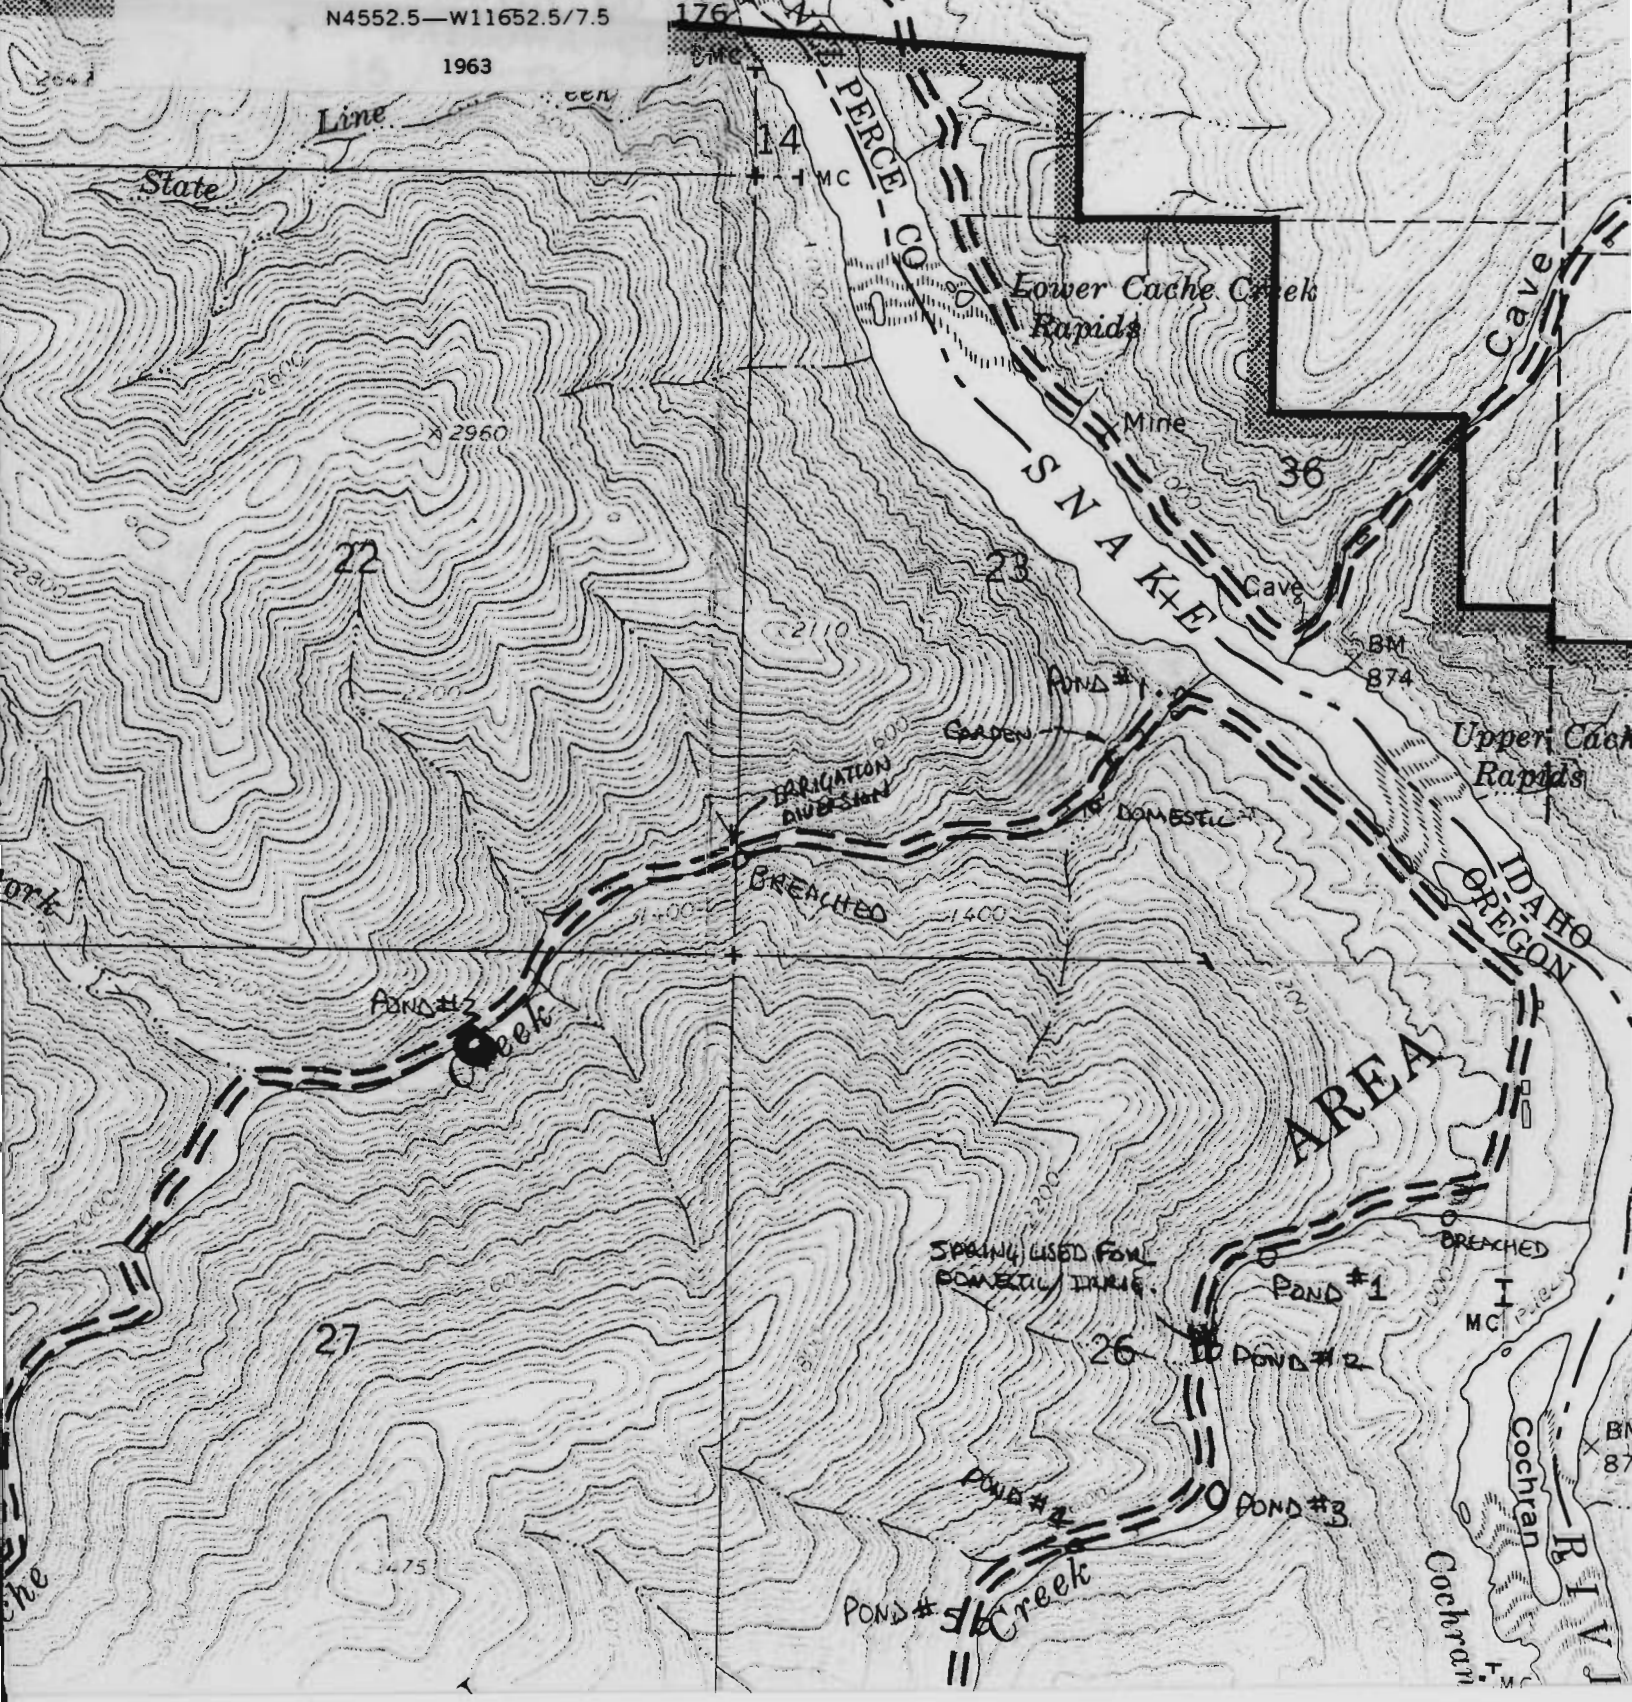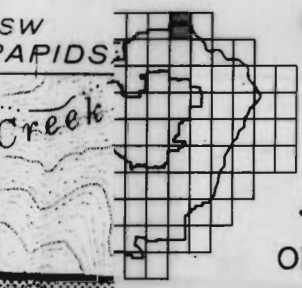

China Garden
China Garden
Creek
55
22
22
864
176
PERCE CO
MILE

Lower Cache Creek Rapids

SNAKE

BM 874

Upper Cache Rapids

IRRIGATION DIVERSION

BRENCHED

Pond #1
Creek

AREA

SPRING USED FOR DOMESTIC PURPOSE

POND #1

POND #2

POND #2

POND #3

POND #5
Creek


Cochran

R. 1 W. J

Cochran

BM 87

CERTIFICATE NO. ⁷¹⁵²² Application No. R 7967B Jim C. 7.5 MII
 T6N, R47E Permit No. 0610 R.5 W. F

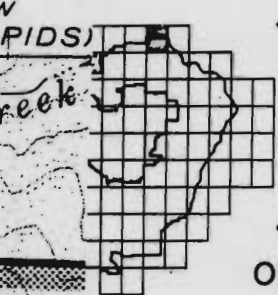

8

JIM CREEK BUTTE
 OREG.-IDAHO--WASH.
 N4552.5--W11652.5/7.5

1963

