


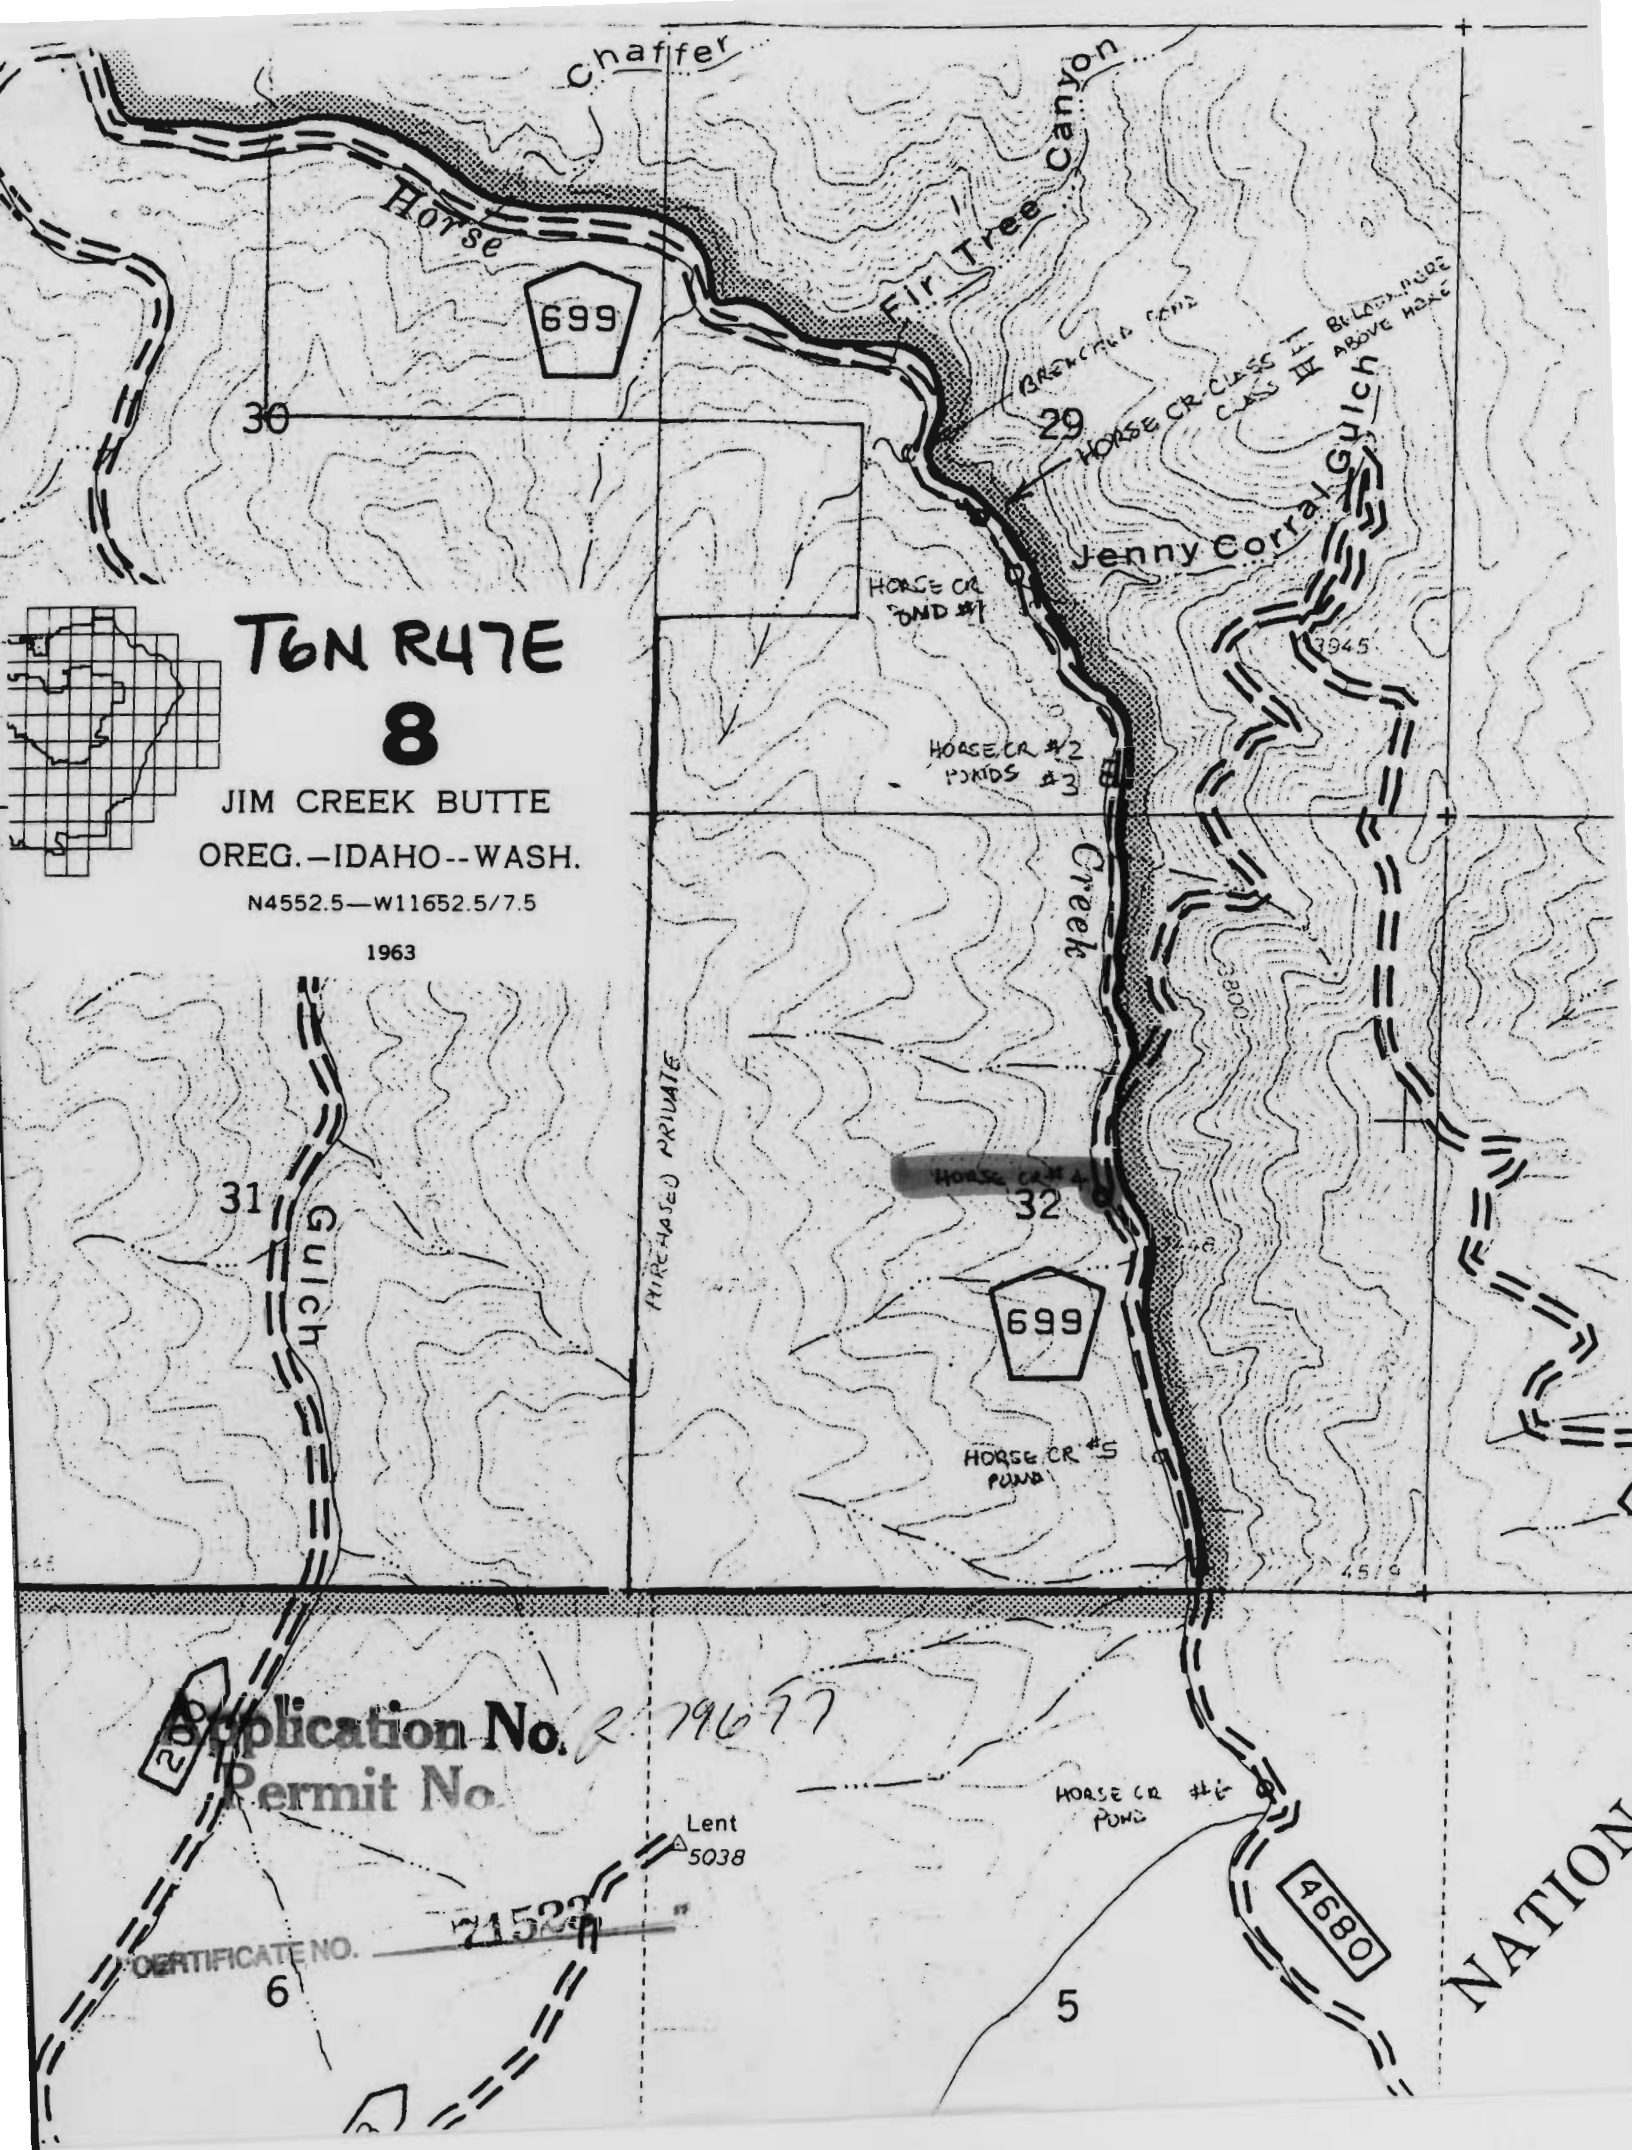

Chaffier

Horse

699

30

Fir Tree Canyon


29

HORSE CR. CLASS II
CLASS III BELOW HORSE
CR. ABOVE HORSE

Jenny Corral Gulch

HORSE CR. POND #1

HORSE CR. #2
POND #3

Creek

3945

3800

HORSE CR. #4

32

699

HORSE CR. #5
POND

4510

31

Gulch

PURCHASED PRIVATE

Application No. 2-79677
Permit No.

Lent
5038

21523

CERTIFICATE NO.


6

HORSE CR. #6
POND

4680

5

NATION

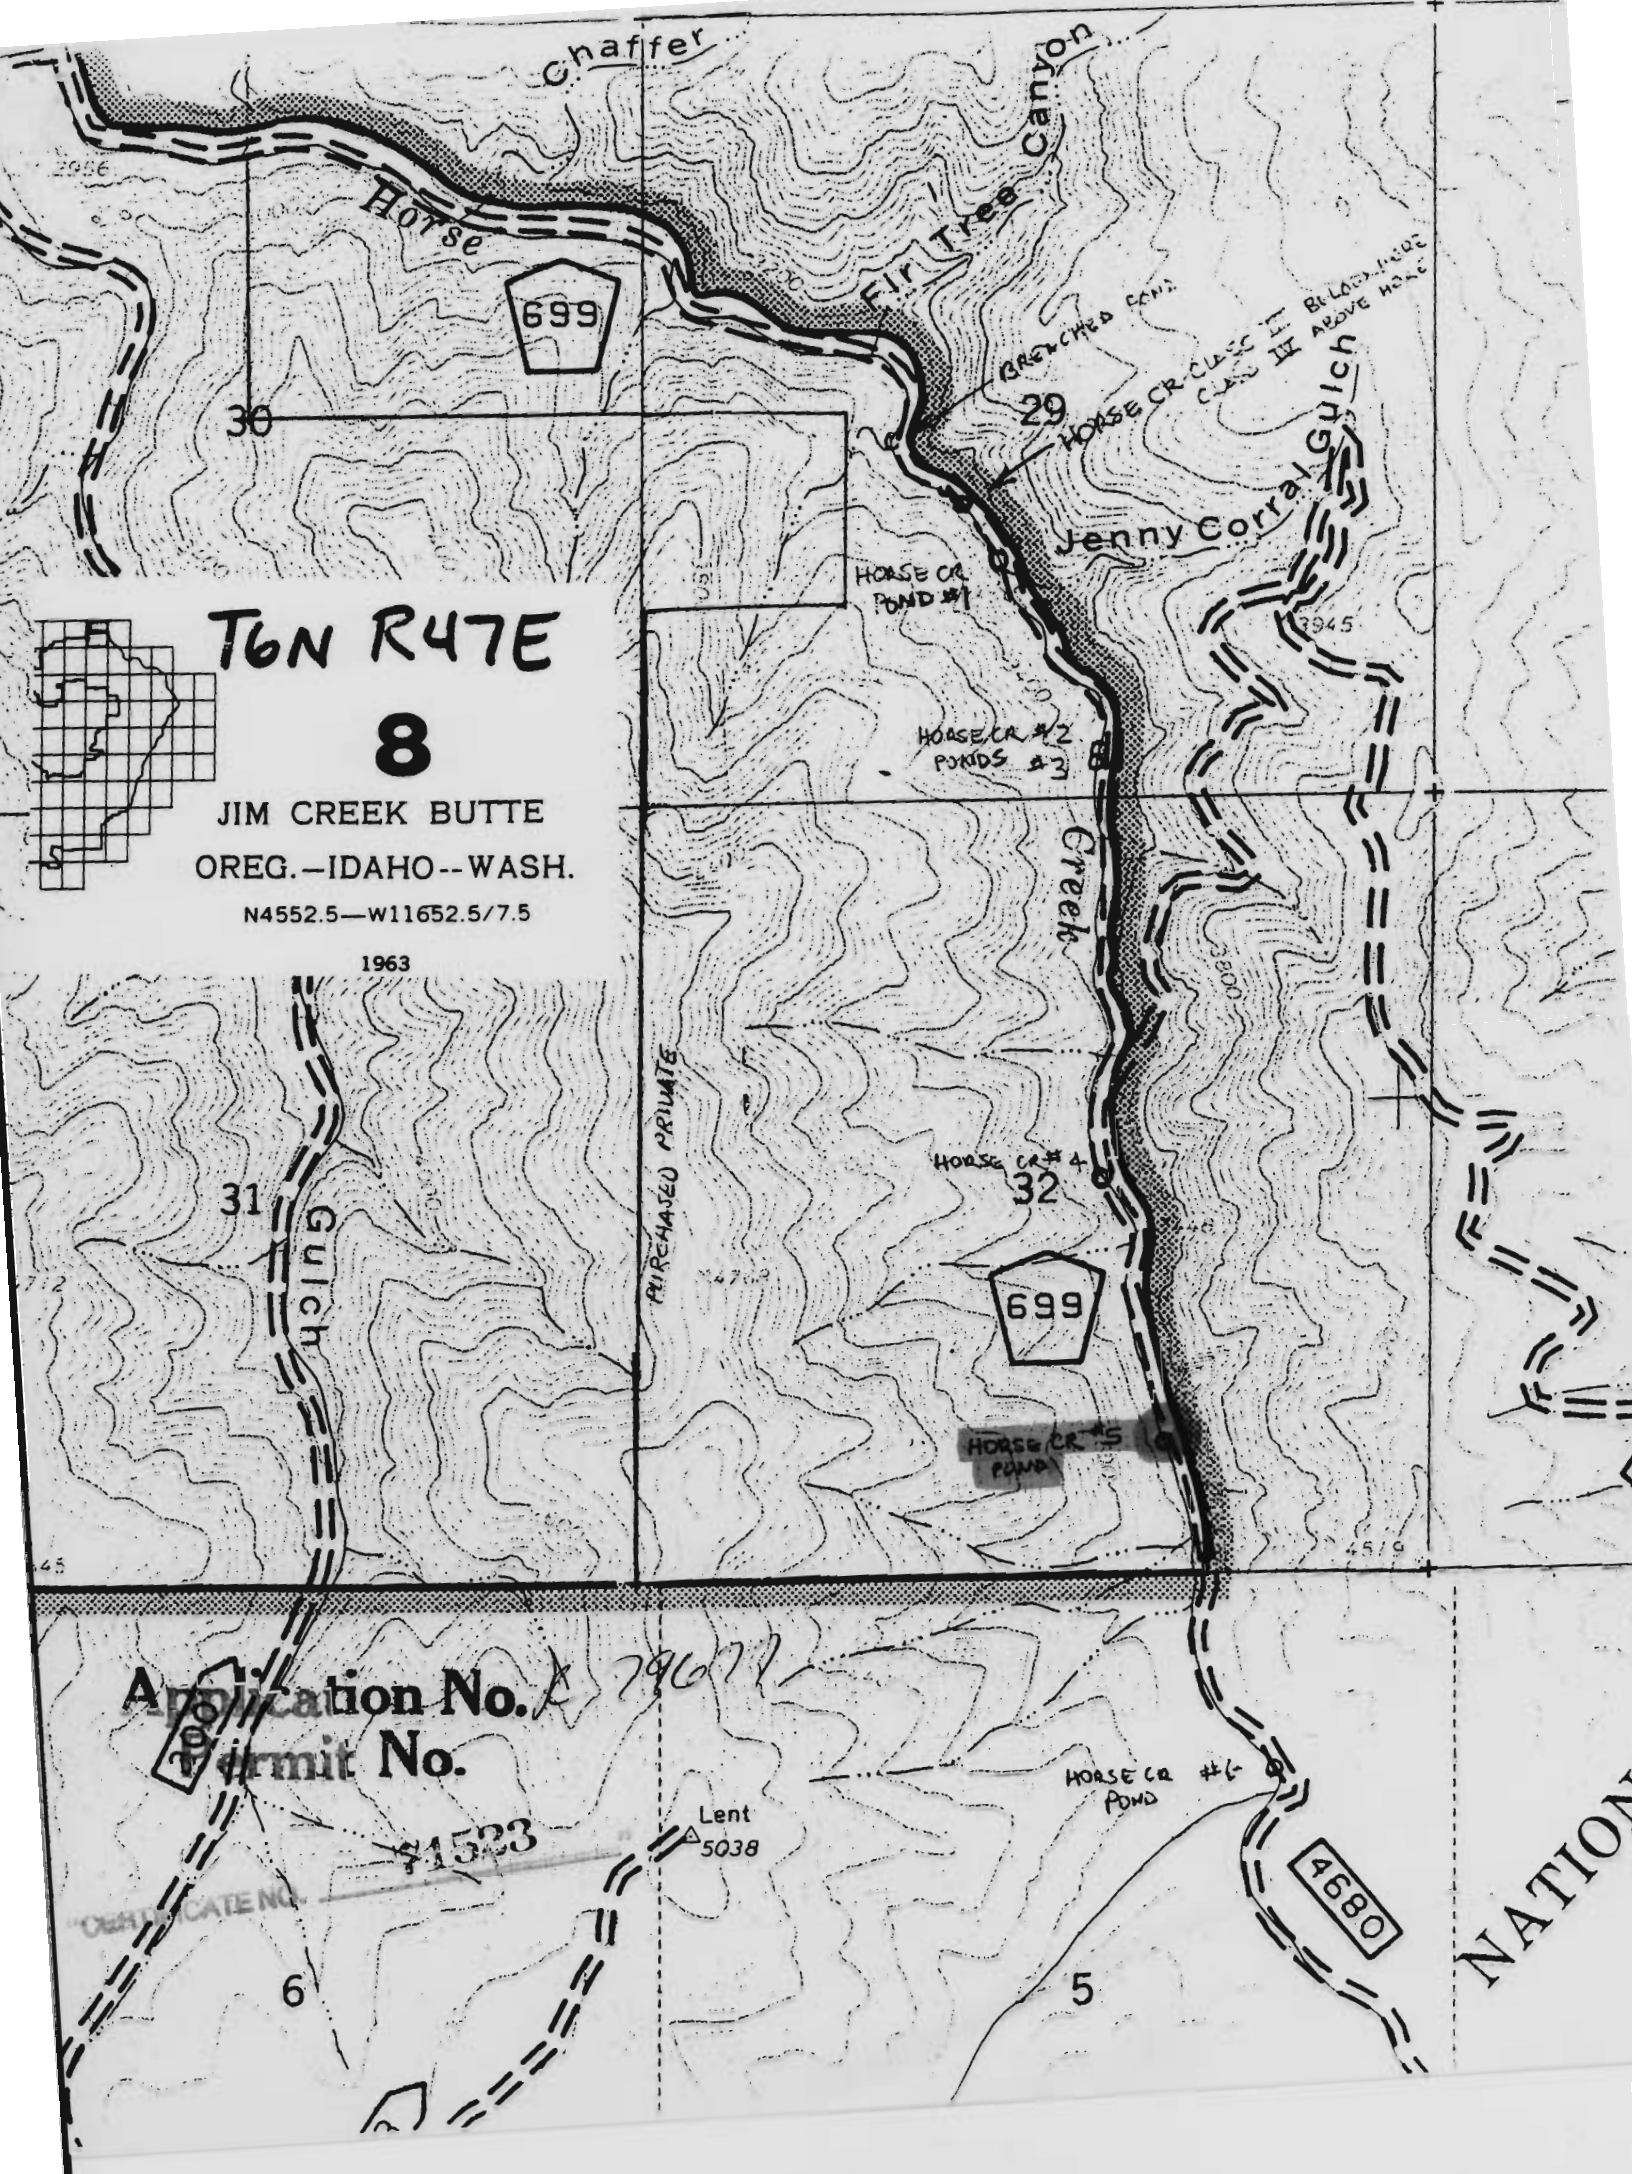

Chaffer

Horse

Fir Tree Canyon

699

30

BRENCHED CANYON

29

HORSE CR. CLASH I
CLASH II BELOW HORSE
ABOVE HORSE

Jenny Corral Gulch

HORSE CR. POND #1

HORSE CR. #2
POND #3

T6N R47E

8

JIM CREEK BUTTE
OREG.-IDAHO--WASH.

N4552.5--W11652.5/7.5

1963

PURCHASED PRIMATE

31

Gulch

HORSE CR. #4
32

699

HORSE CR. #5
POND

Application No. 79677

Lent
5038


HORSE CR. #6
POND

4680

5

6

NATION

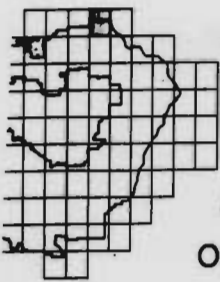


TSN R47E

8

JIM CREEK BUTTE
OREG.-IDAHO--WASH.

N4552.5—W11652.5/7.5

1963

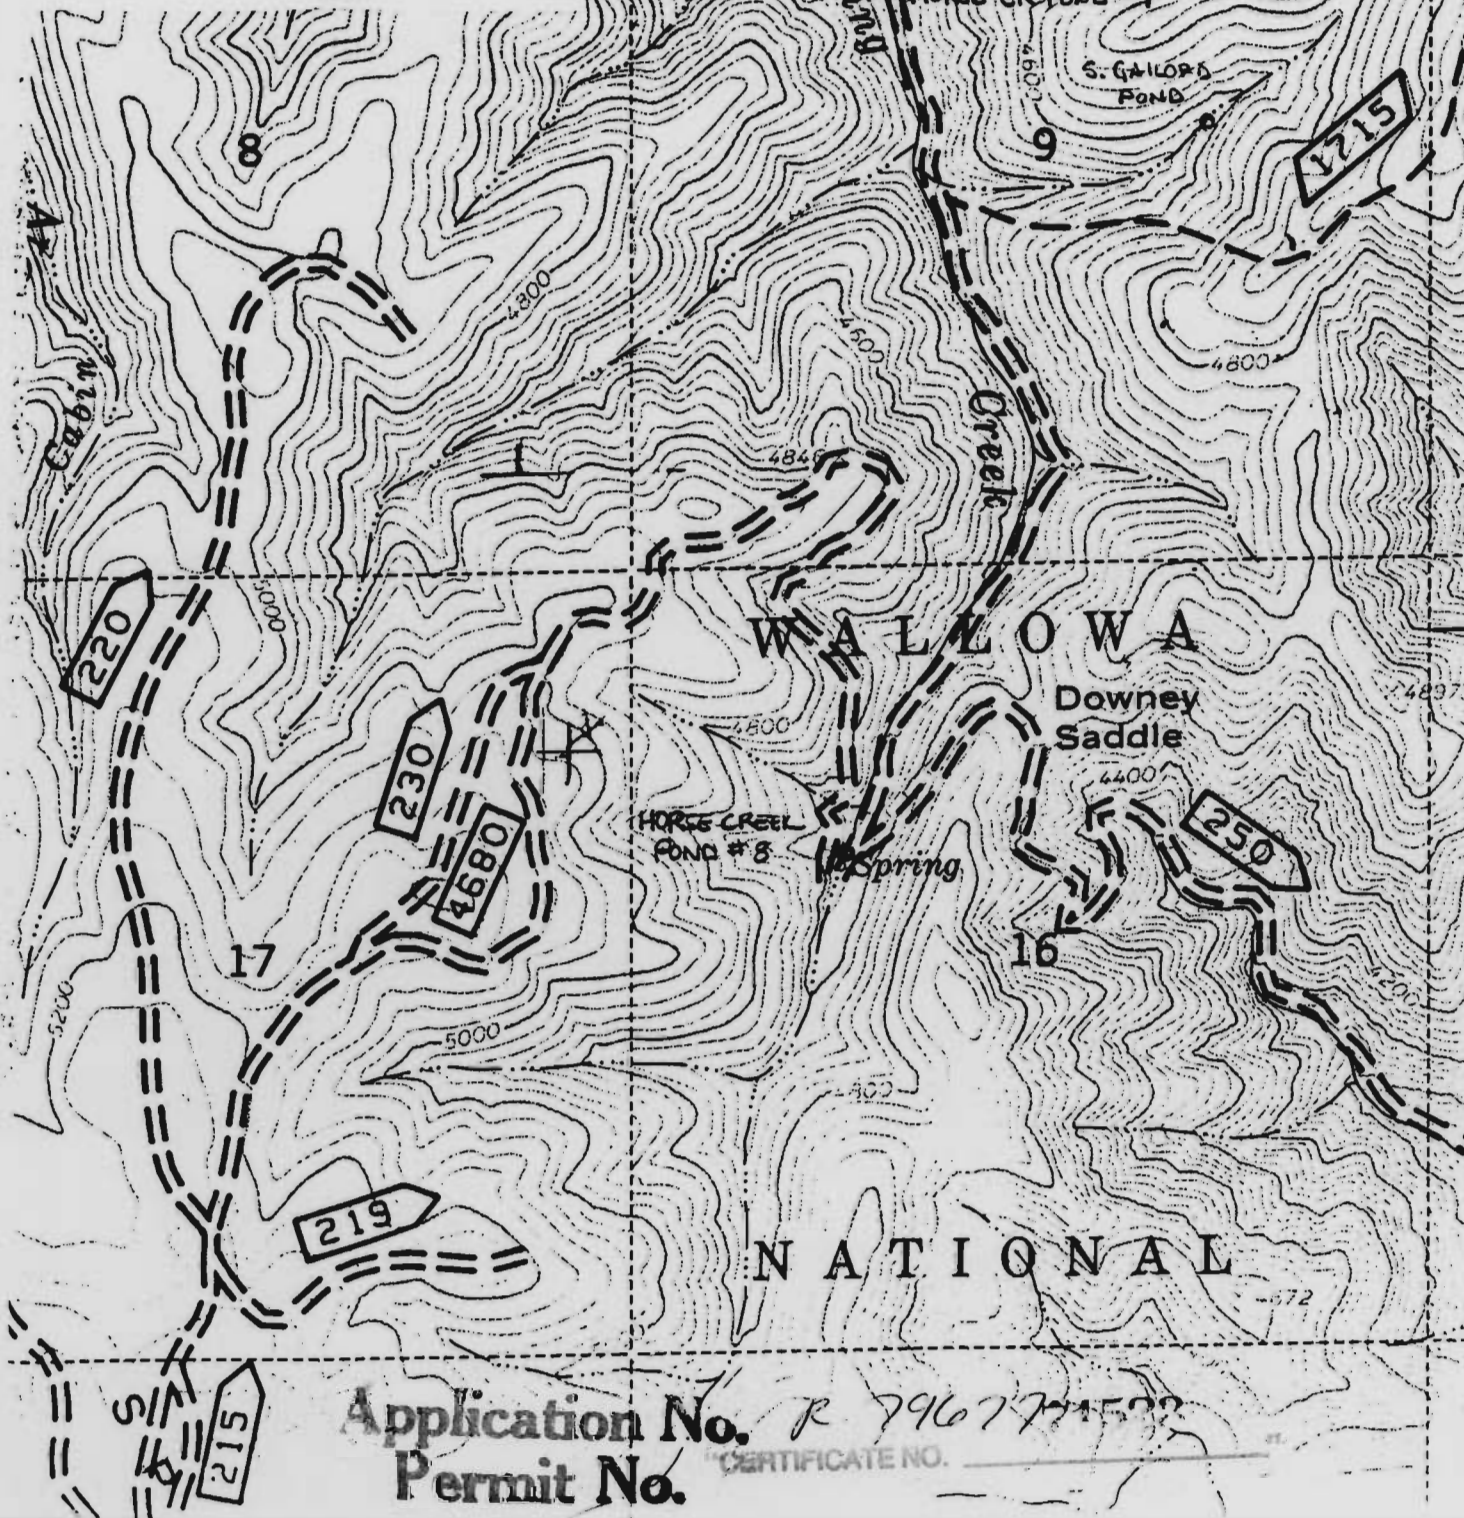

Application No. R 796771532

Permit No.

CERTIFICATE NO.


Application No. 29677
Permit No.

TSN R47E
8

JIM CREEK BUTTE
OREG.-IDAHO--WASH.

N4552.5—W11652.5/7.5

1963

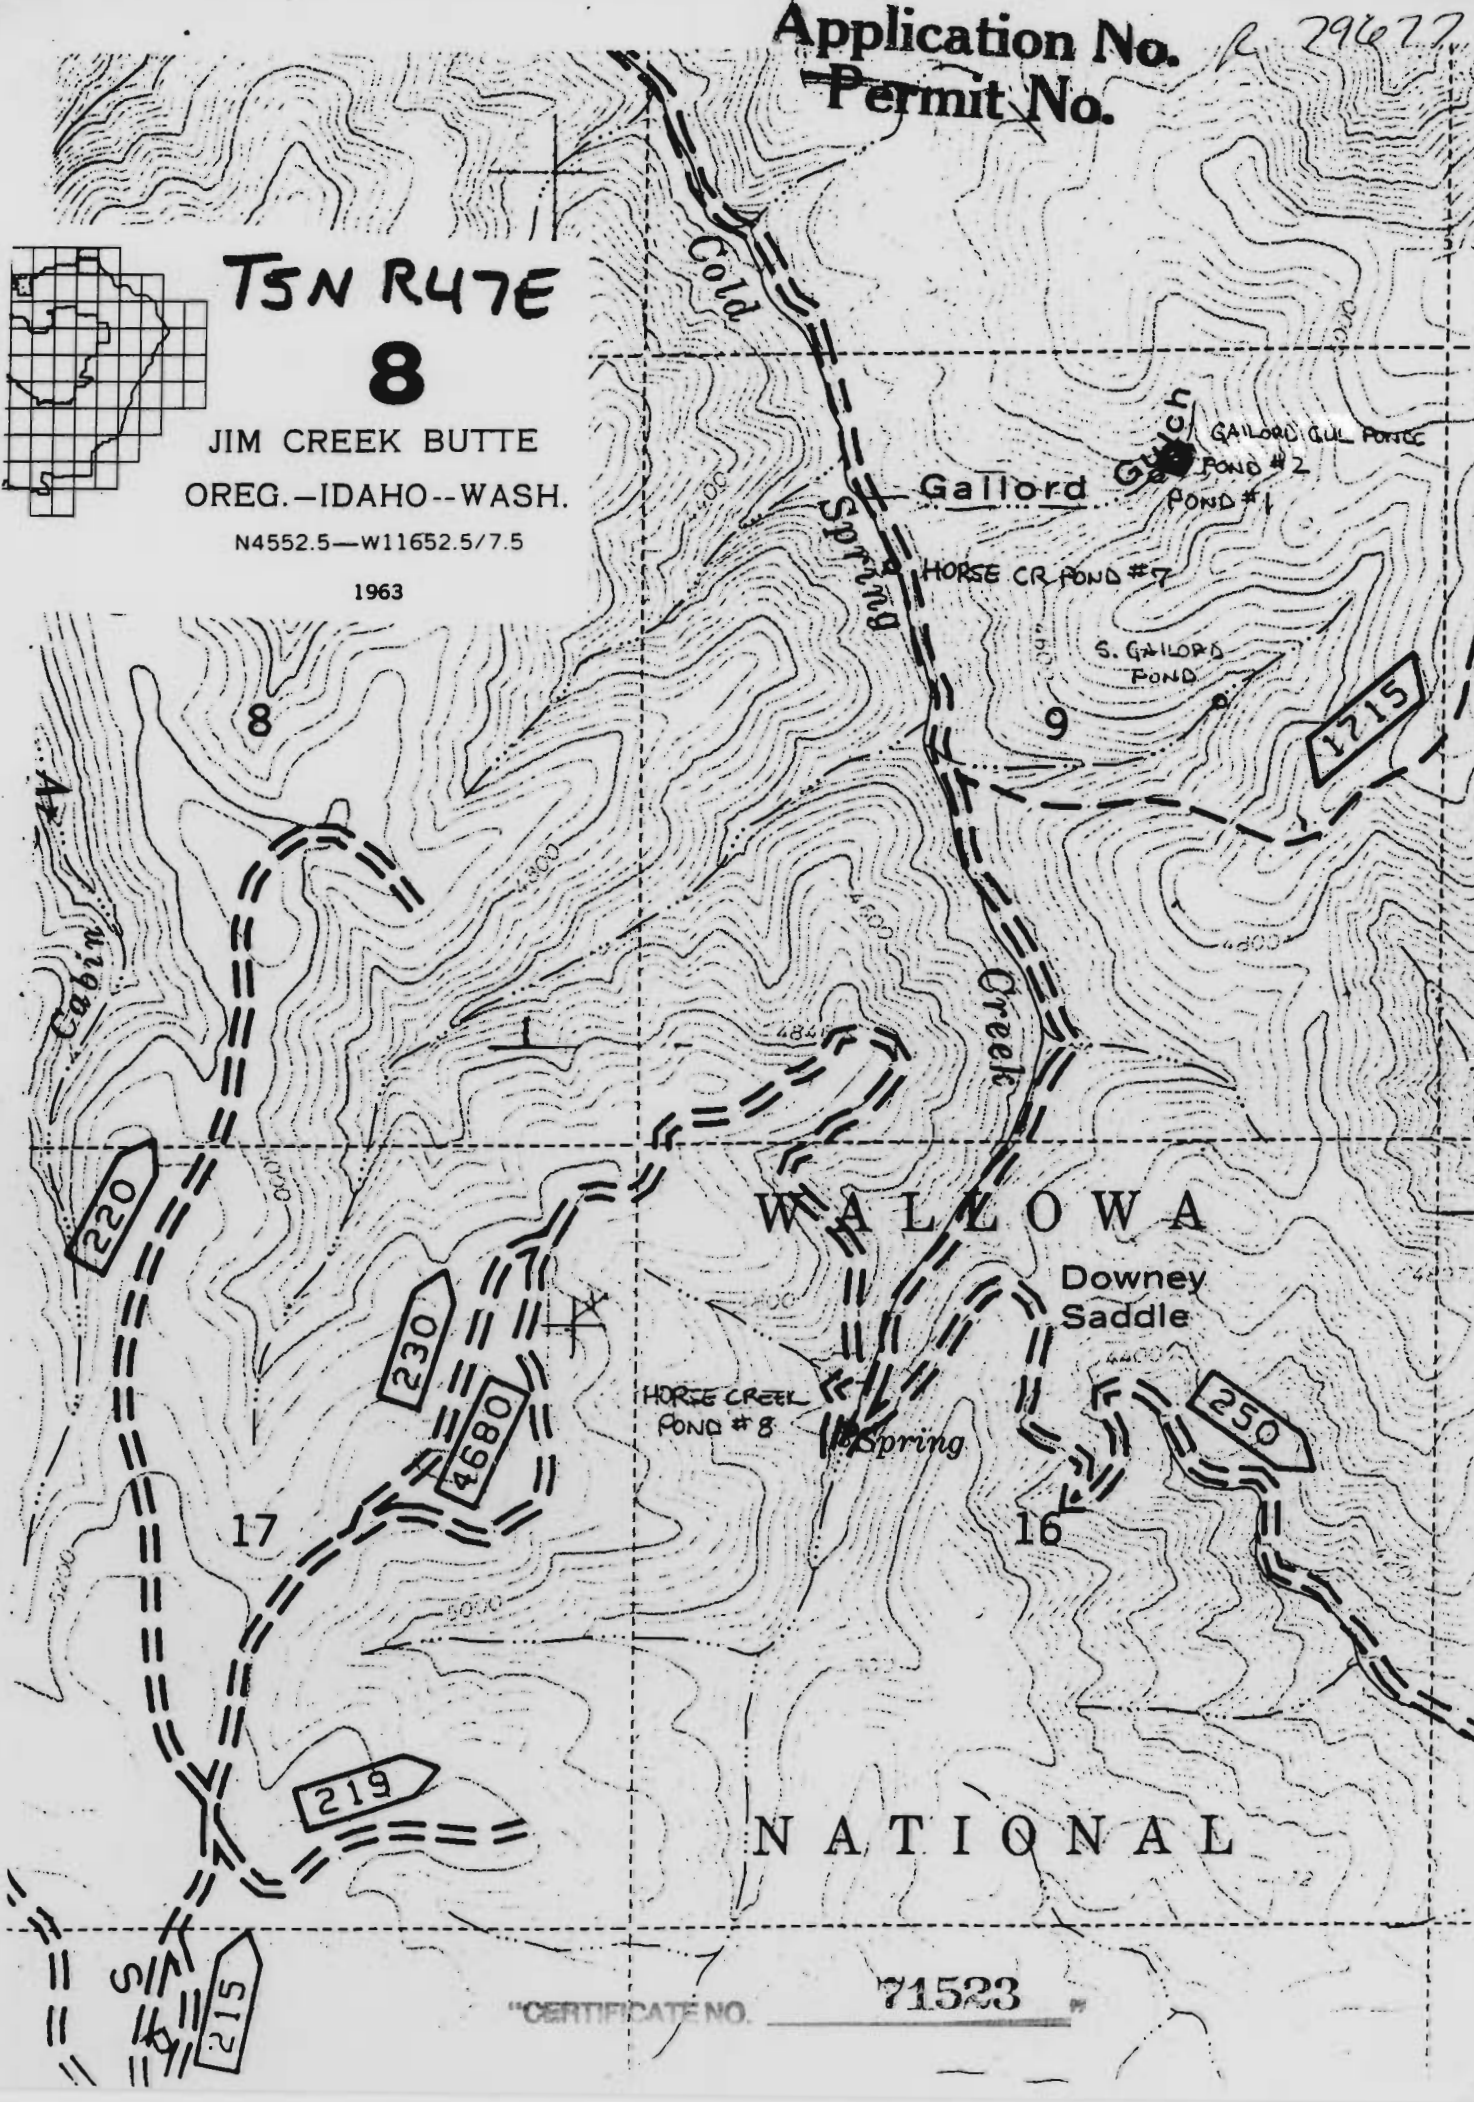

NATIONAL

"CERTIFICATE NO.

71523




TSN R47E

8

JIM CREEK BUTTE
OREG.-IDAHO--WASH.

N4552.5—W11652.5/7.5

1963

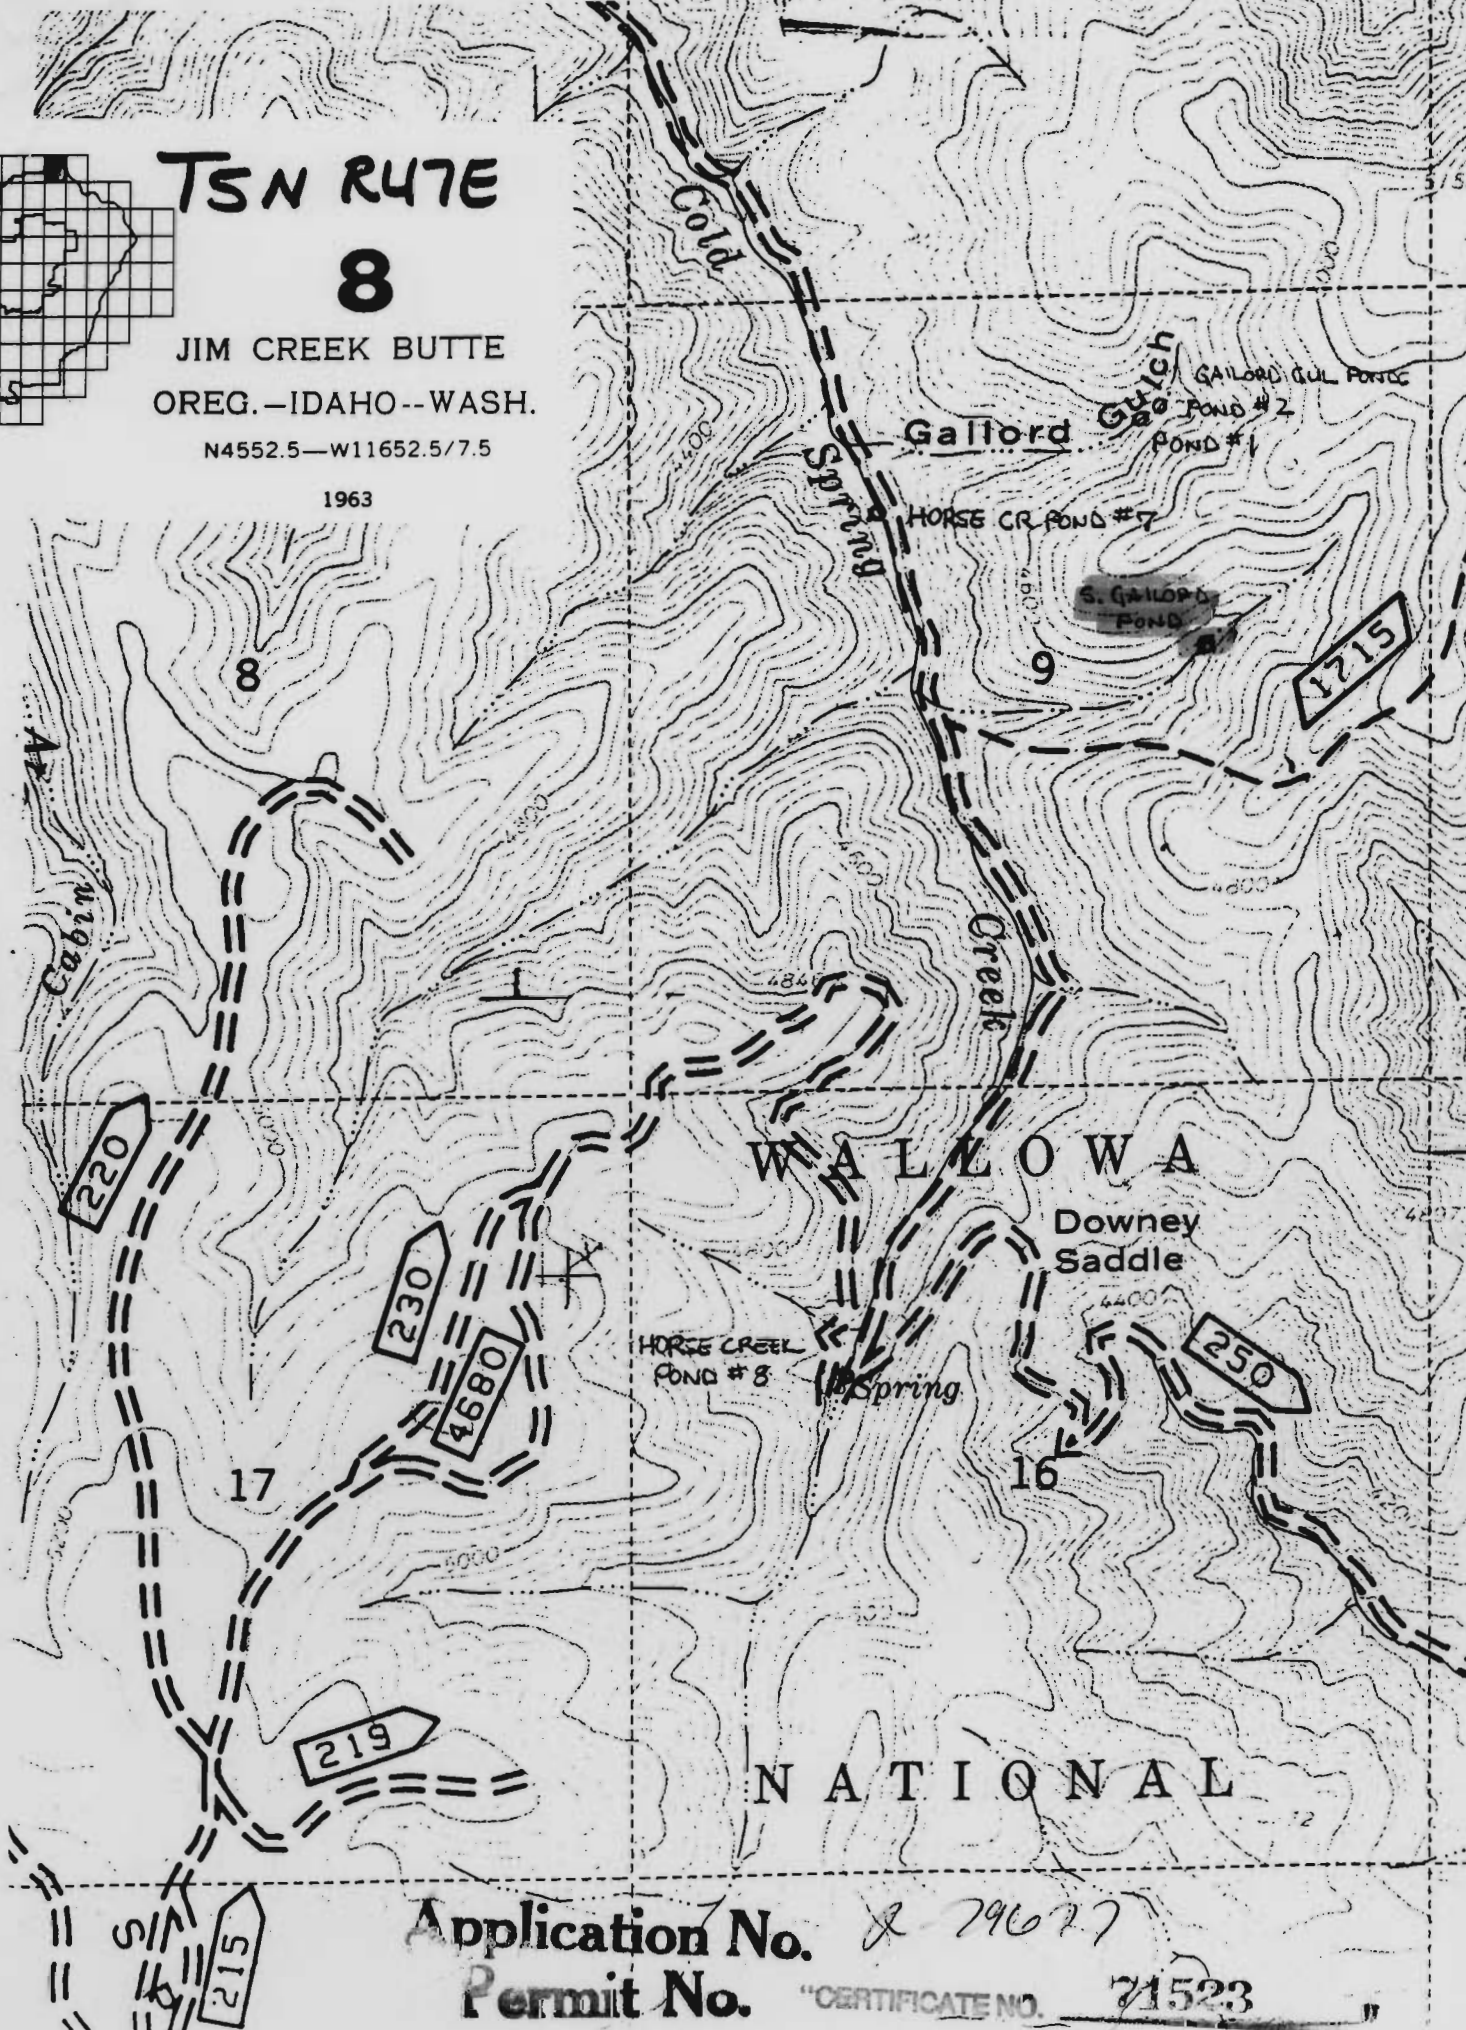

NATIONAL


Application No.

279677

Permit No.

"CERTIFICATE NO.

71523

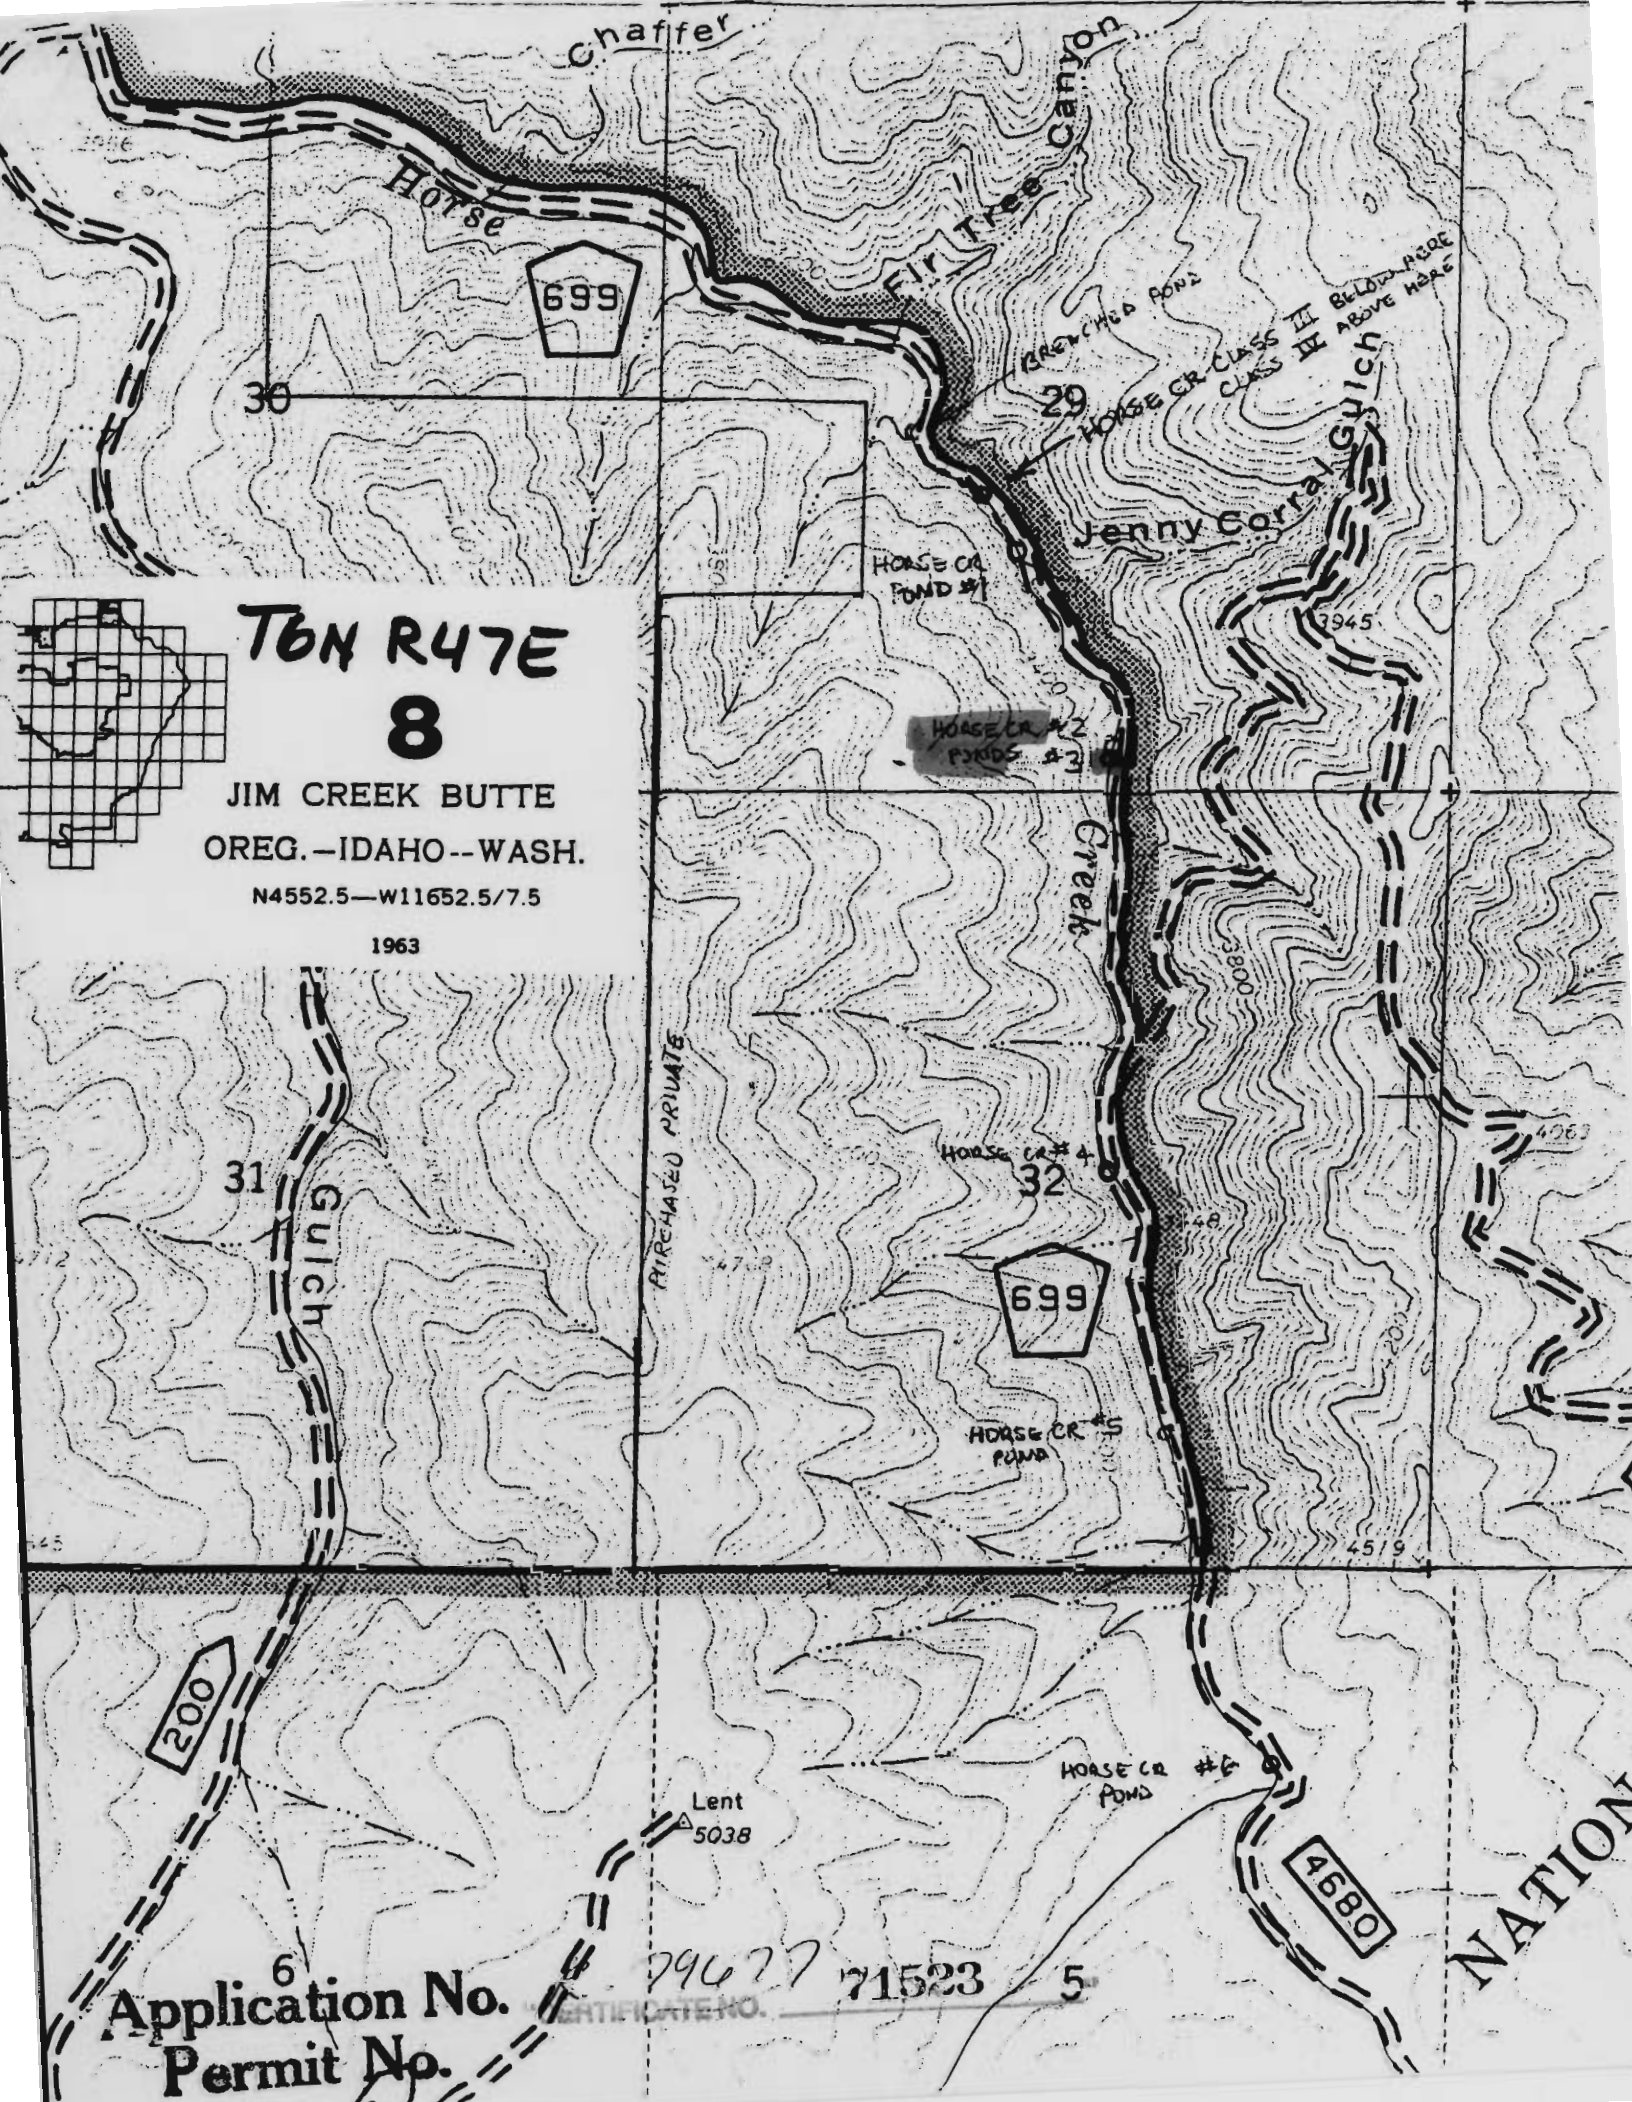

Gnaffer

Horse

699

Fir Tree Canyon



Jenny Corral Gulch

HOSE CR. POND #1

HOSE CR. #2 POND #2

Creek

HOSE CR. #4

699

HOSE CR. #5 POND

HOSE CR. #6 POND


4680

Lent 5038

Application No. 6
Permit No. 5

79677 71523

NATION

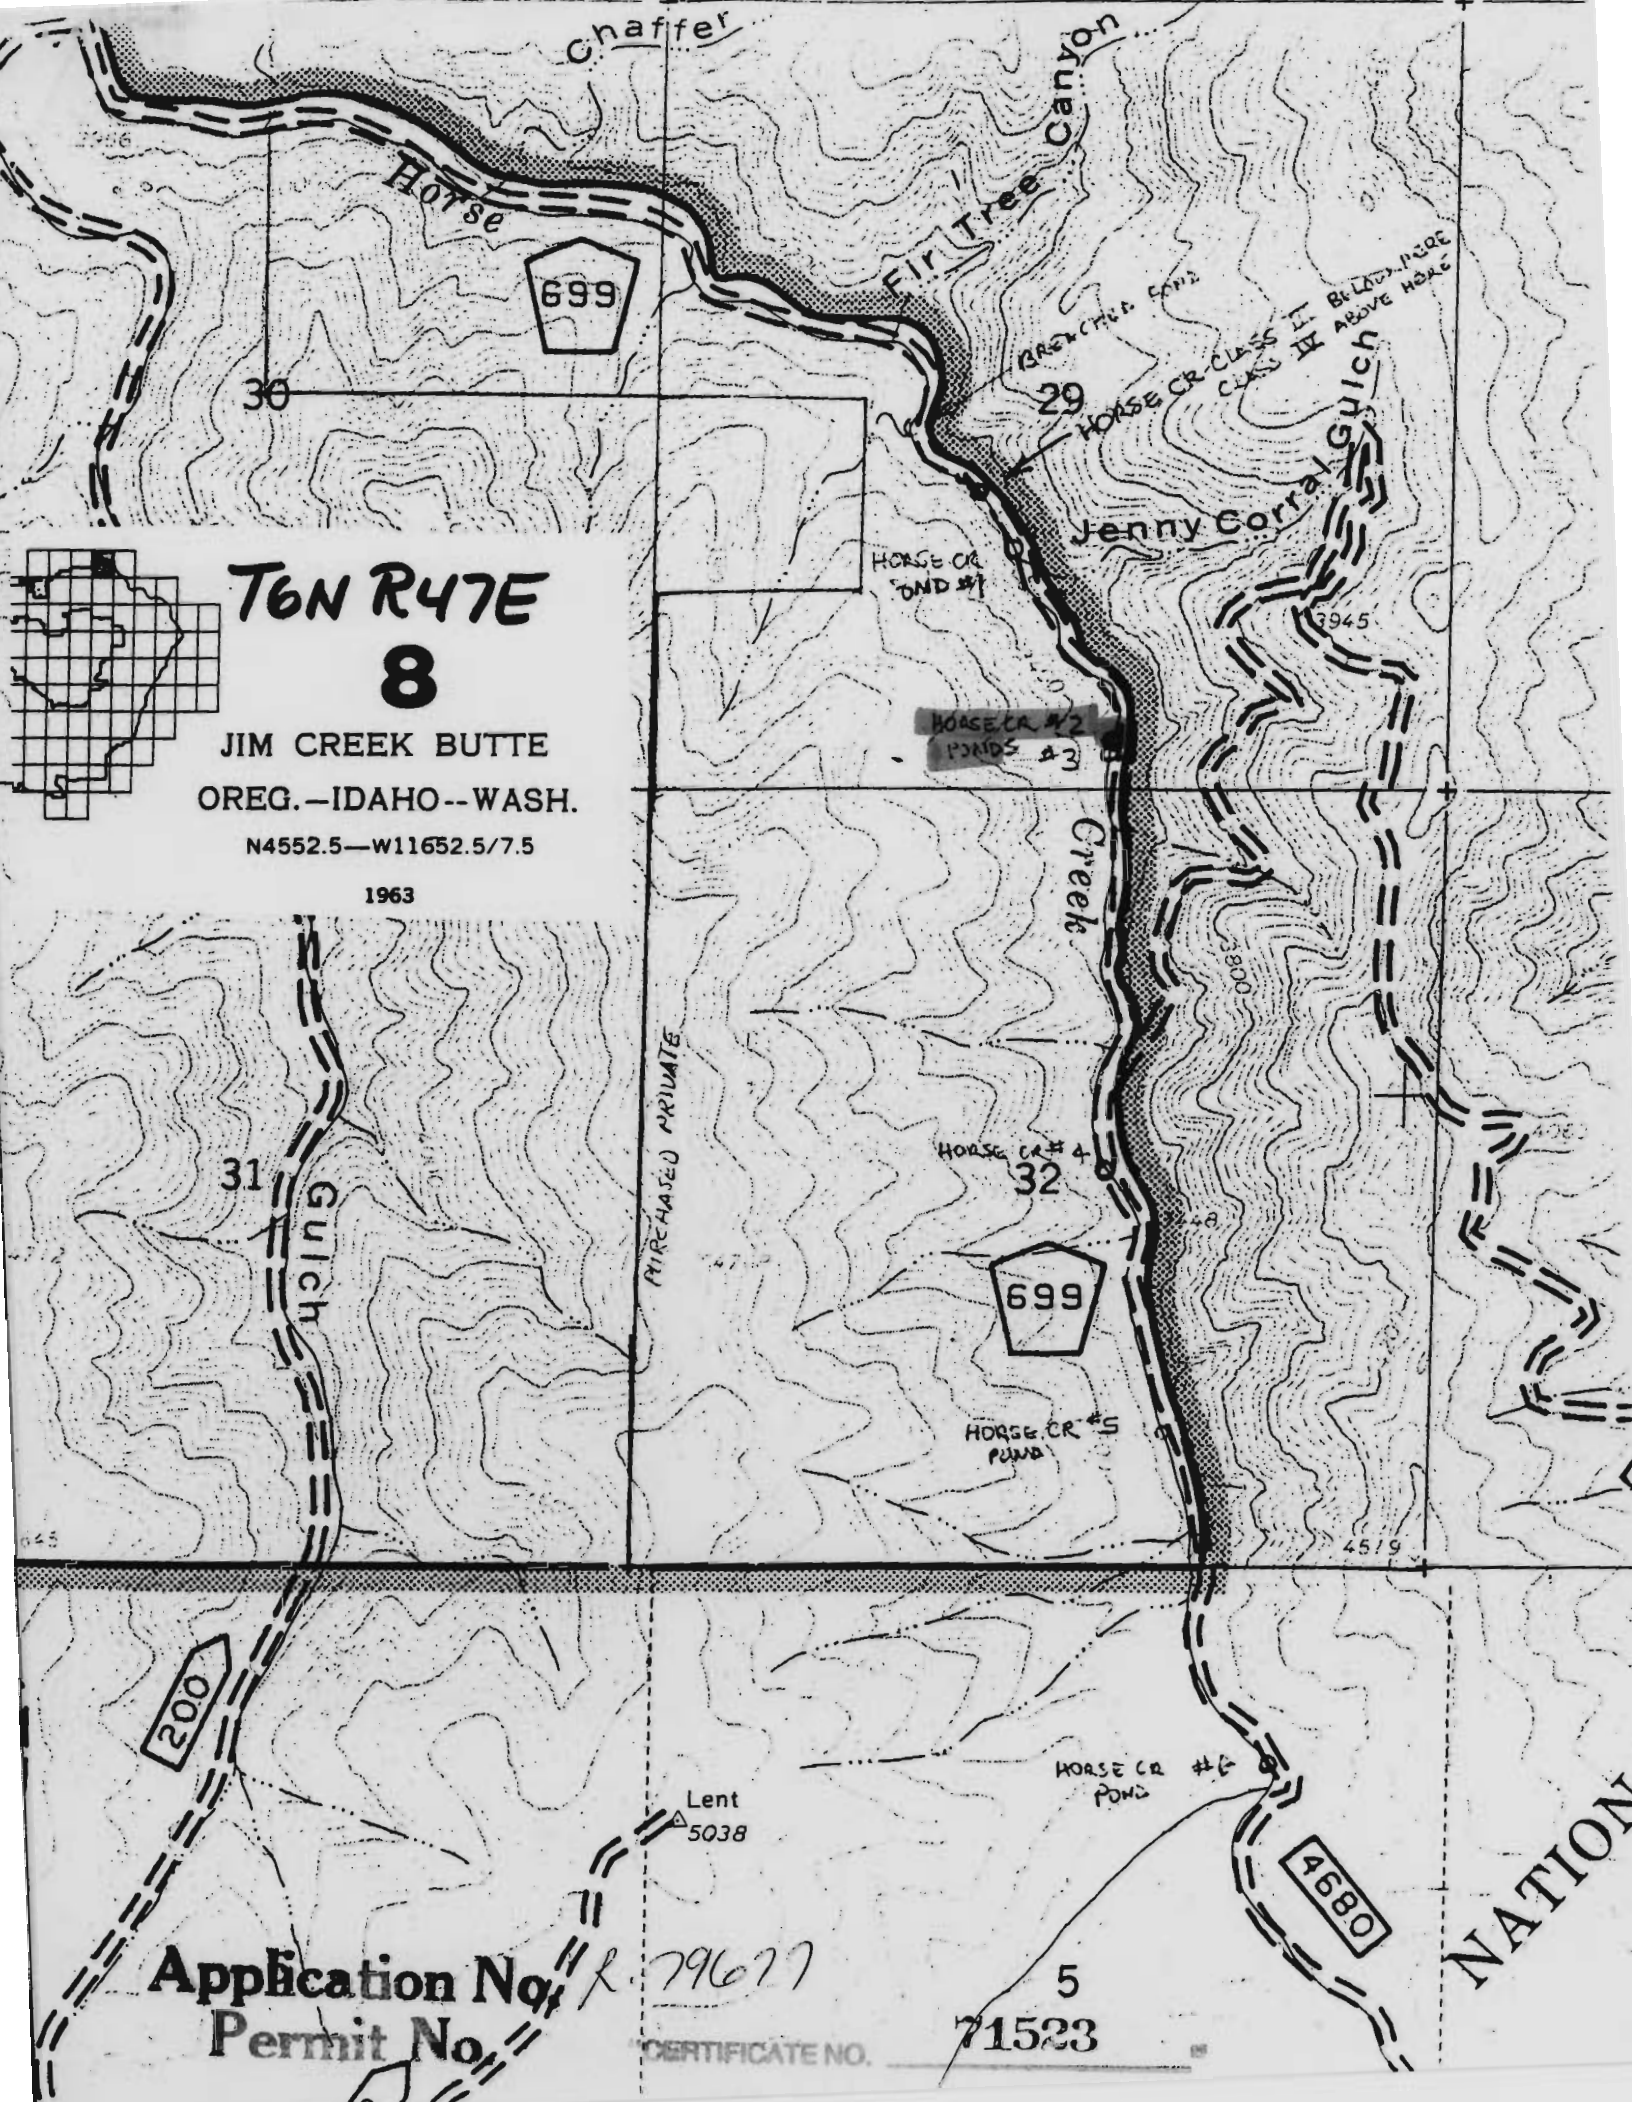

Chaffee

Fir Tree Canyon

Horse

699

30


29

HOSE CR. CLASS II


Jenny Corral Gulch

HOSE CR. POND #1

HOSE CR. #2 POND #3

Creek

3945

3800

HOSE CR. #4

32

699

HOSE CR. #5 POND

31

Gulch

PURCHASED PRIVATE

200

Lent 5038

HOSE CR. #6 POND


4680

Application No. 79677
Permit No.

CERTIFICATE NO.

5
71523

NATION

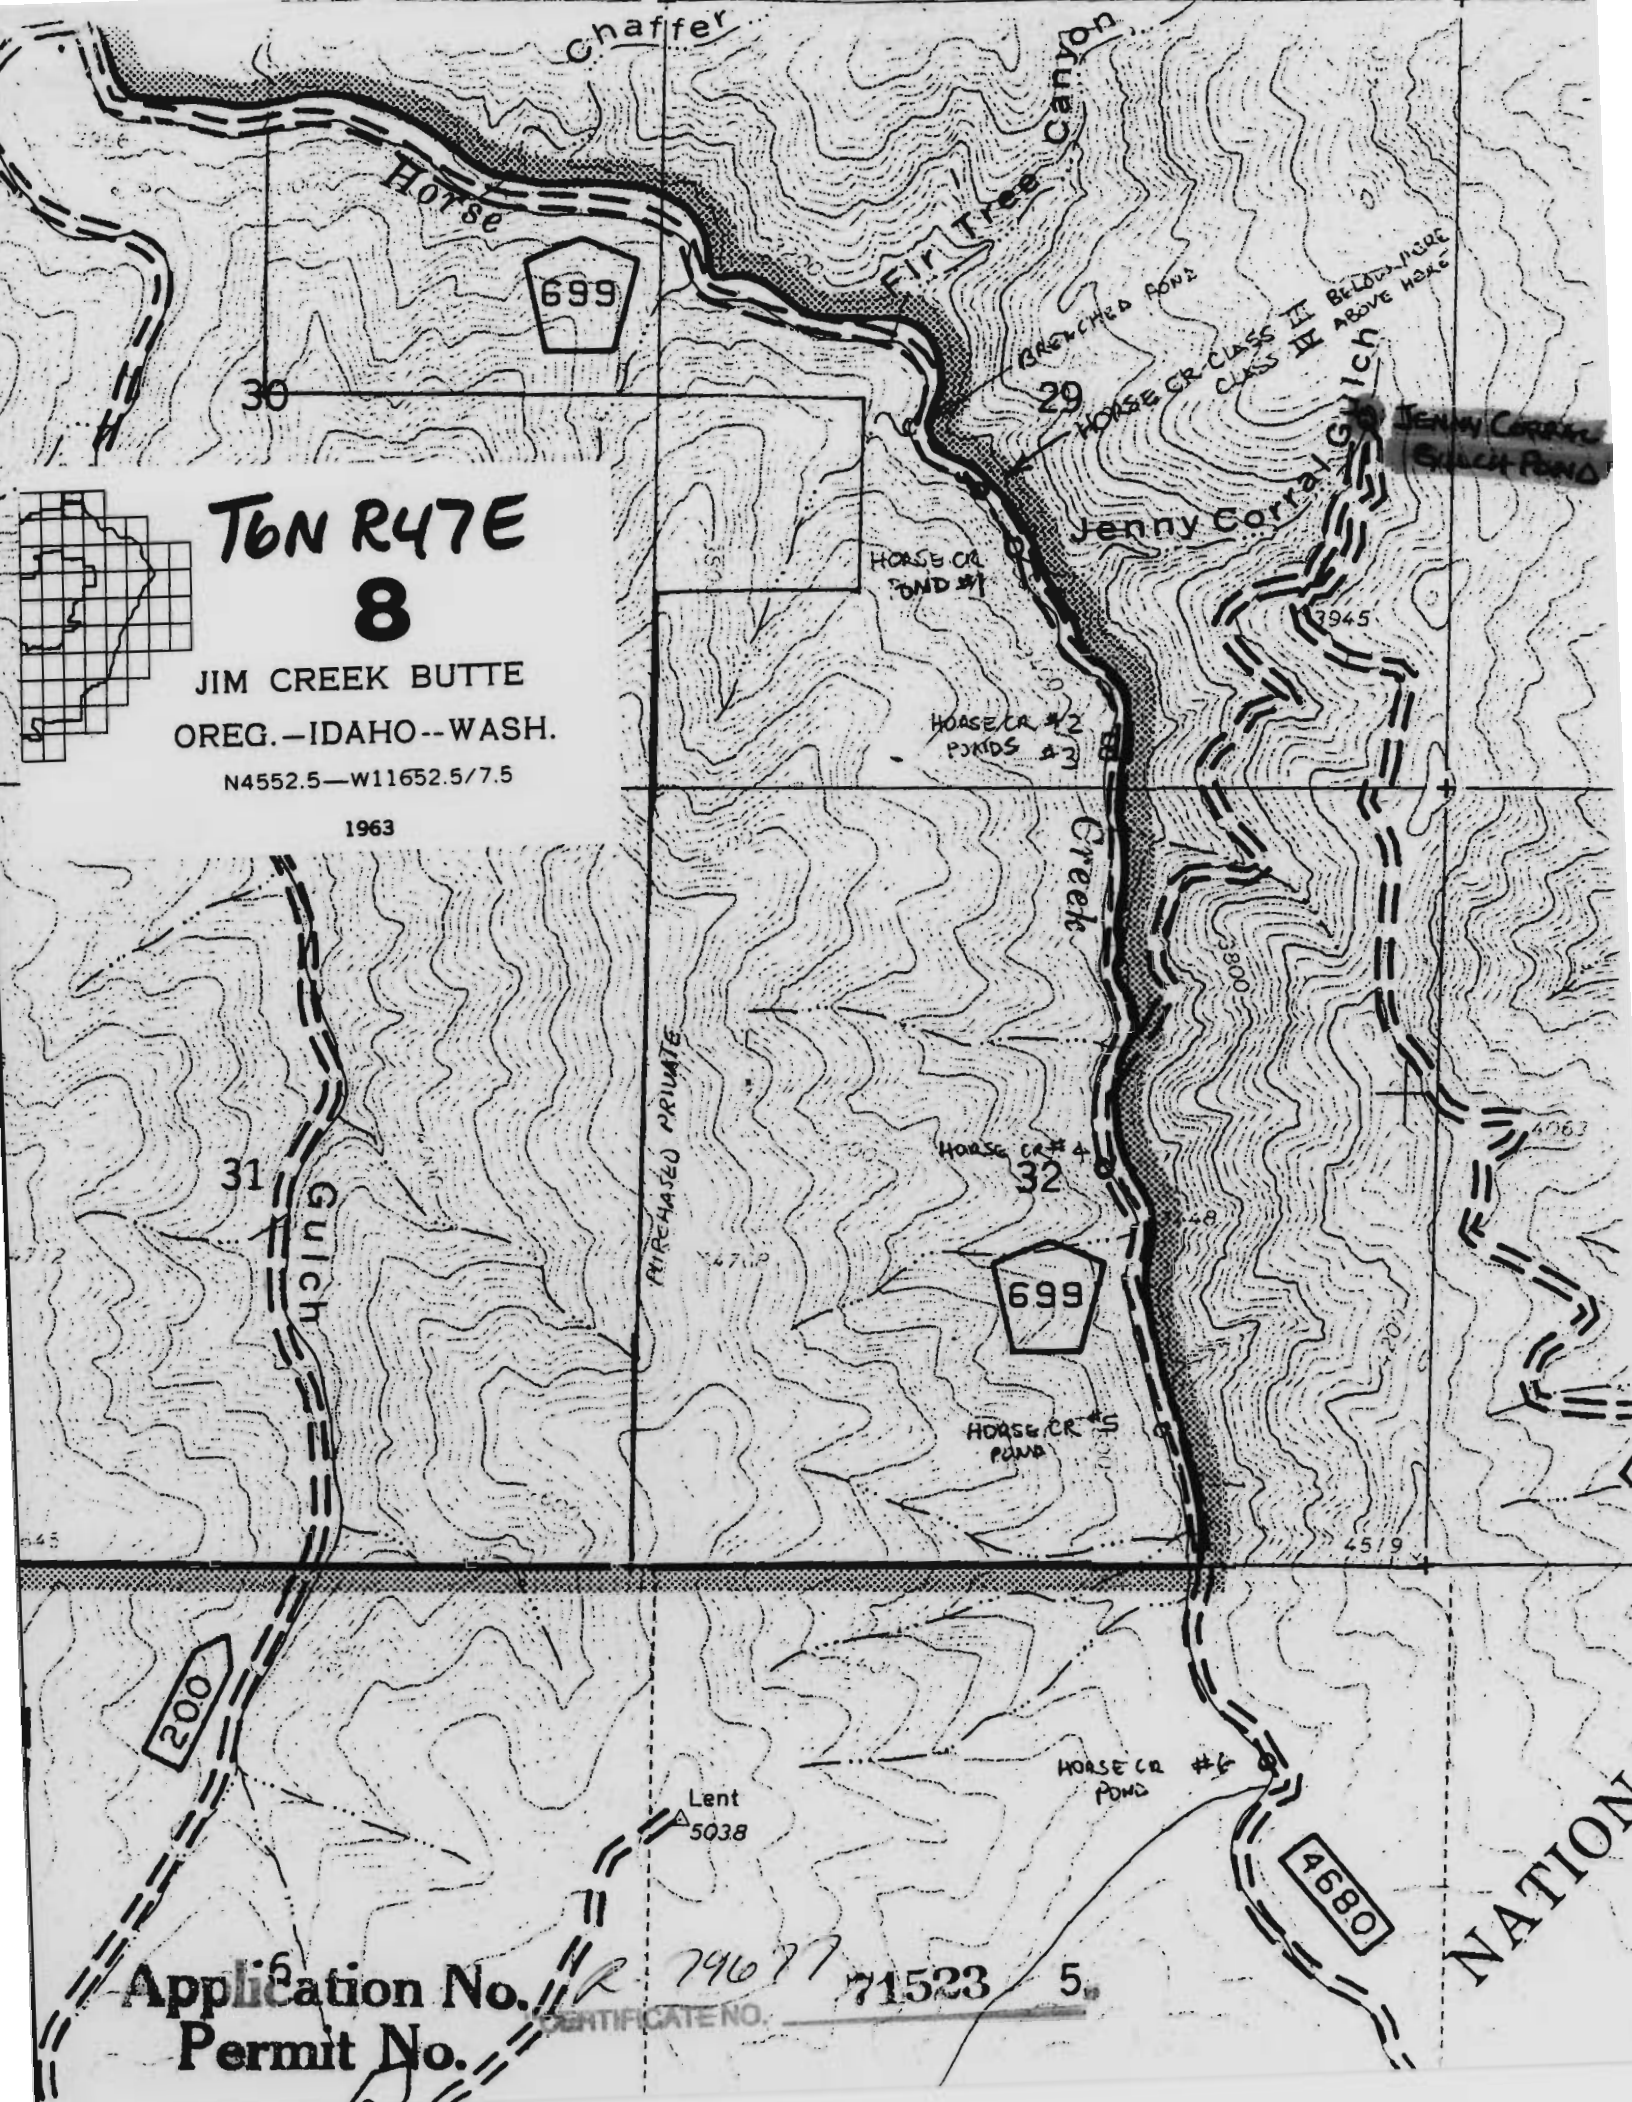

T6N R47E
8

JIM CREEK BUTTE
OREG.-IDAHO--WASH.

N4552.5—W11652.5/7.5

1963

Application No.
Permit No.

CERTIFICATE NO.

Lent
5038

79677

71523

5.

4680

NATION