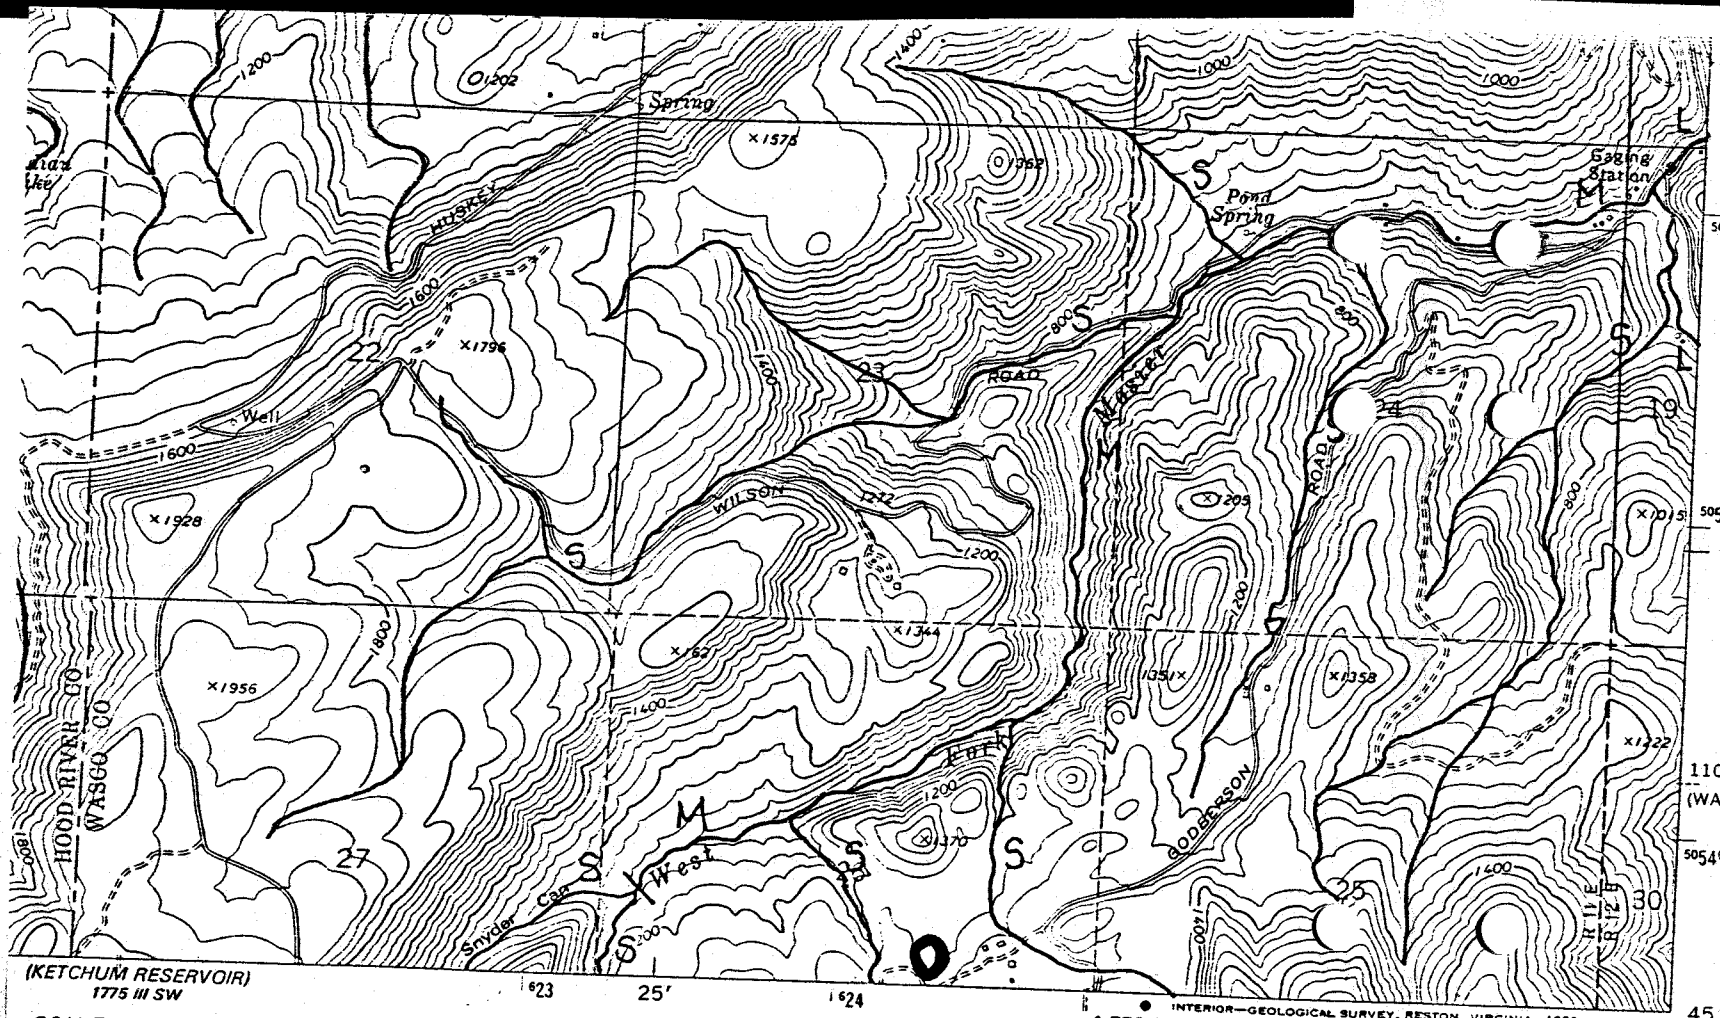

SCALE 1:24 000

0 1 MILE

2000 3000 4000 5000 6000 7000 FEET

0 1 KILOMETER

OUR INTERVAL 40 FEET
EODETIC VERTICAL DATUM OF 1929
T—DATUM IS BONNEVILLE NORMAL POOL ELEVATION 72 FEET

WITH NATIONAL MAP ACCURACY STANDARDS
EY, DENVER, COLORADO 80225, OR RESTON, VIRGINIA 22092
APHIC MAPS AND SYMBOLS IS AVAILABLE ON REQUEST

OREGON

QUADRANGLE LOCATION

ROAD CLASSIFICATION

Primary highway, hard surface

Light-duty road, hard or improved surface

Secondary highway, hard surface

Unimproved road

Interstate Route U. S. Route State Route

WHITE SALMON, WASH.—OREG.

NW/4 WHITE SALMON 15' QUADRANGLE
N4537.5—W12122.5/7.5

1978

RECEIVED
DEC 30 1994
WATER RESOURCES DEPT.
SALEM, OREGON

OREGON DEPT OF FORESTRY
AUG 30 1994