



ication No. R. 79804  
 rmit No.

71577

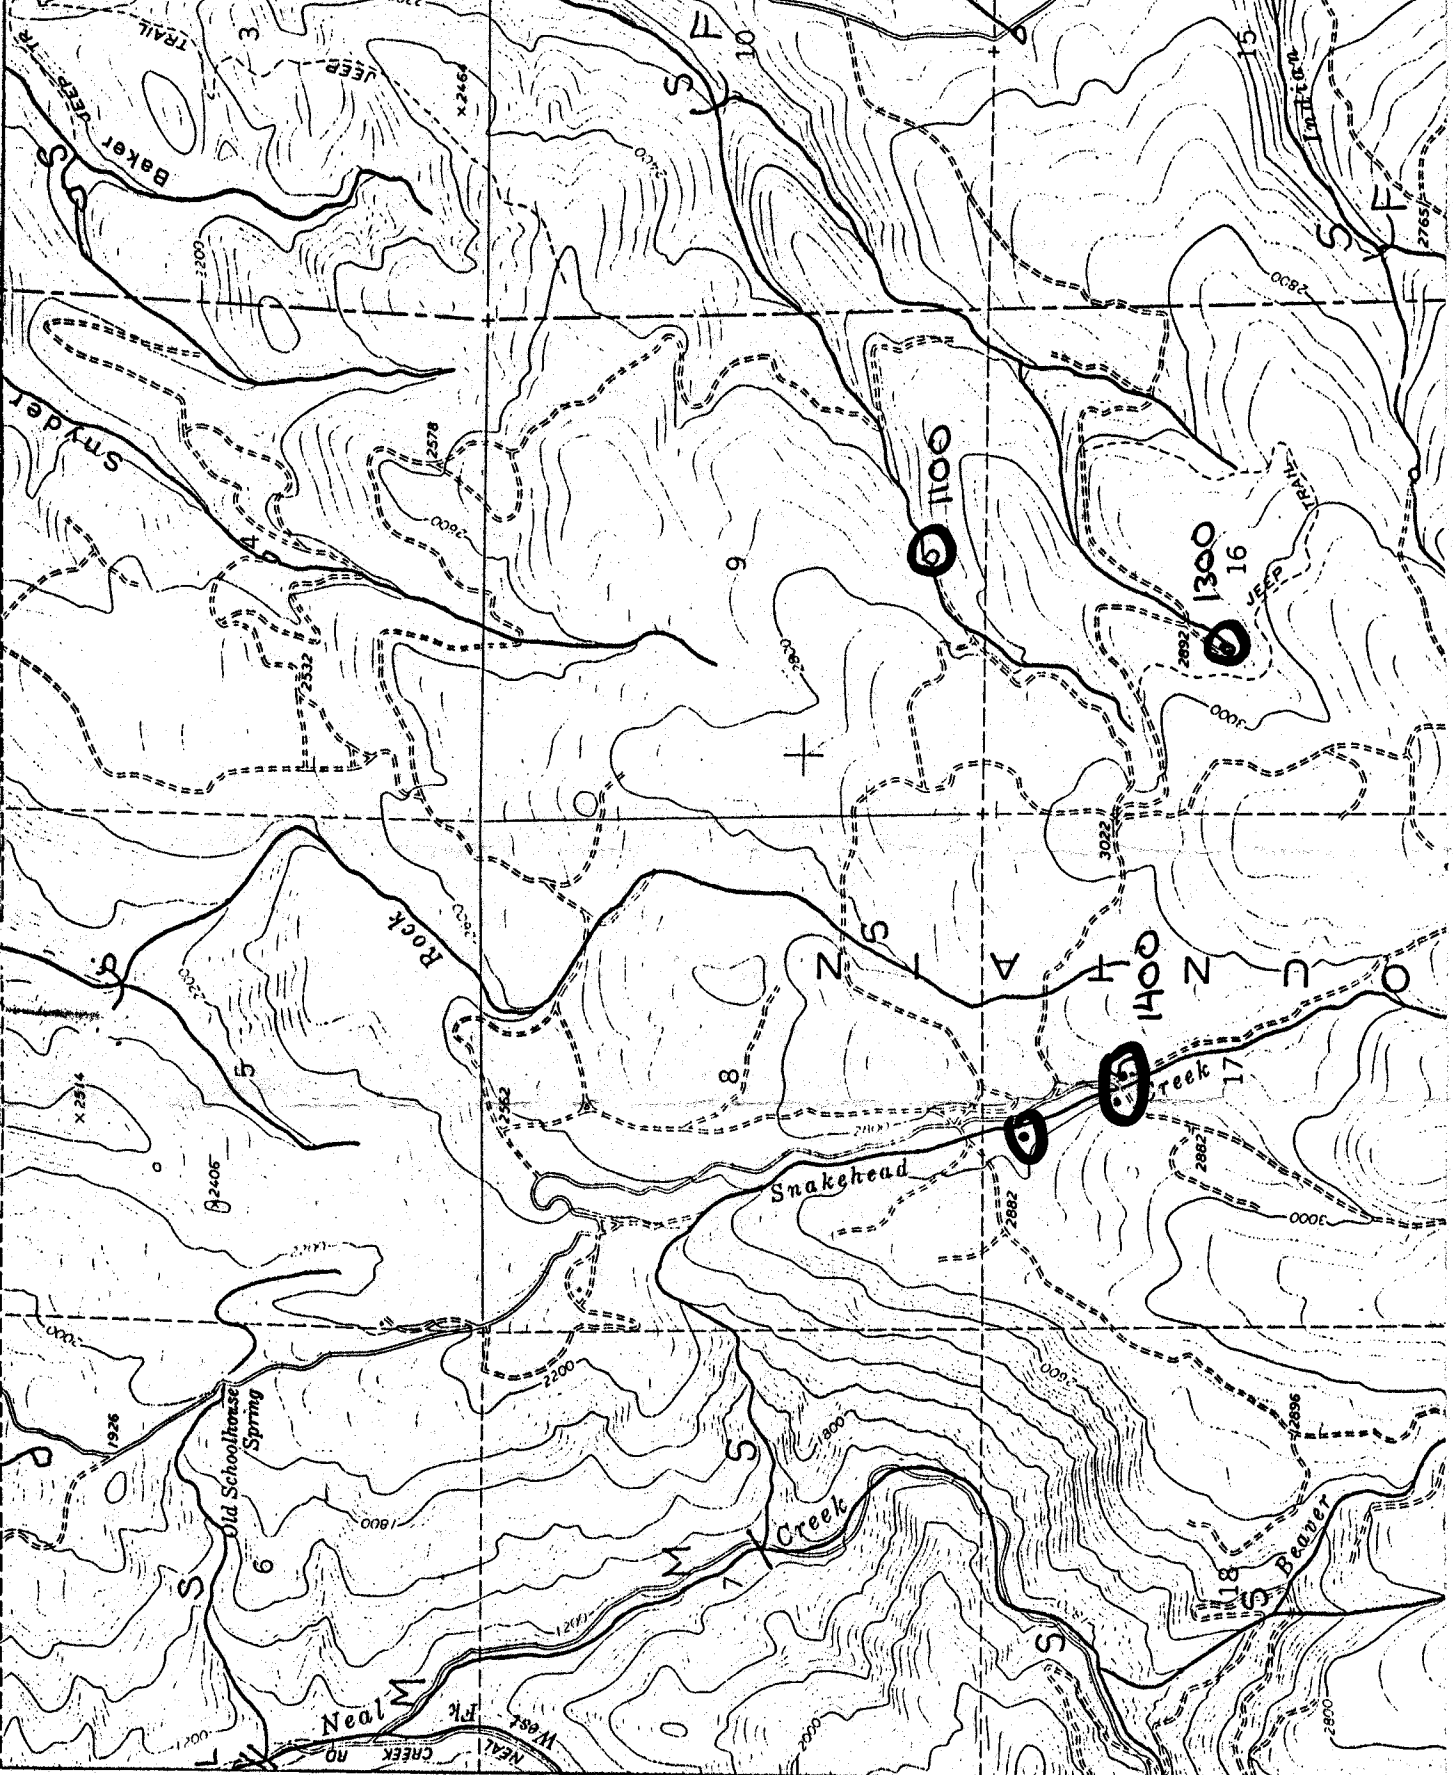

71577

tion No. R 79804  
u no.

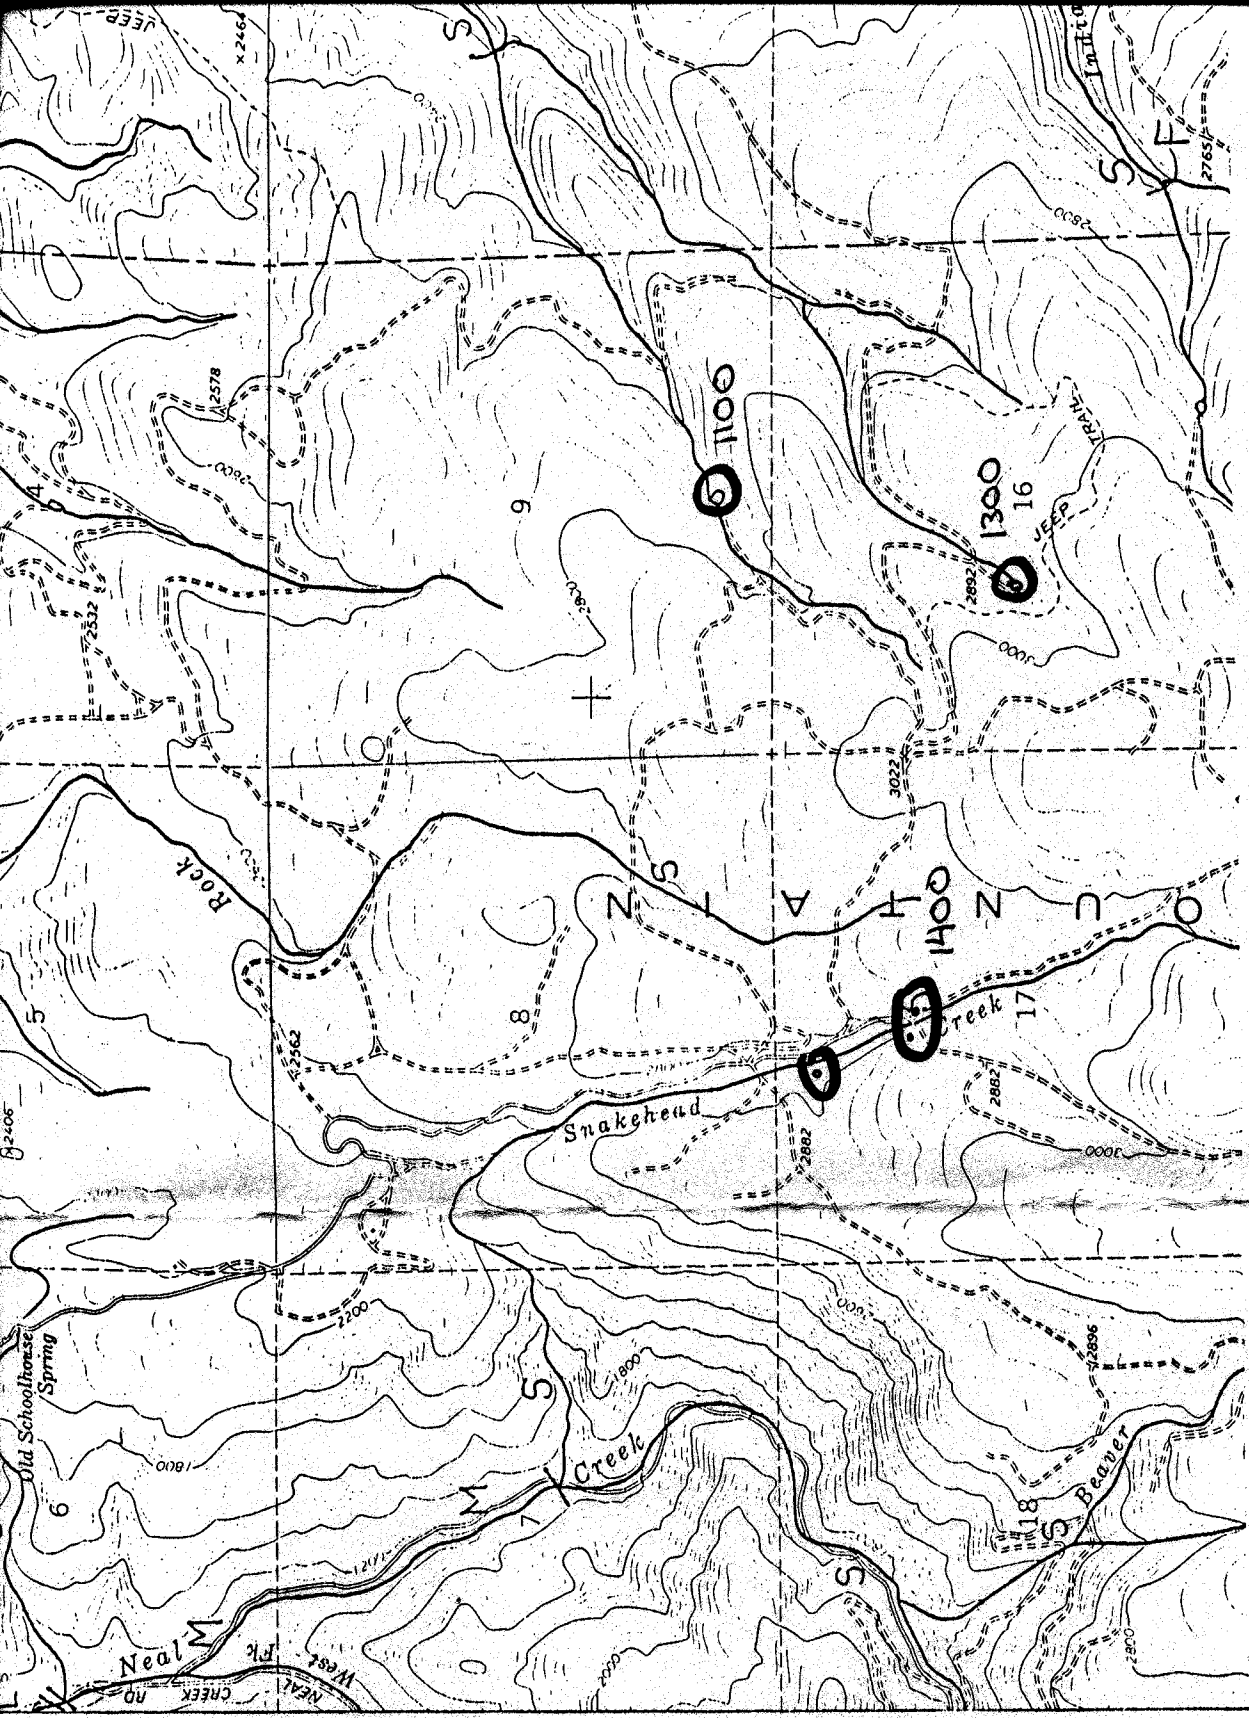

71577

Section No. R 79804  
 Permit No.

Section No. R. 79804  
T. No.

