


7-6-82

COOP-82

78-10-1

Exhibit "C"

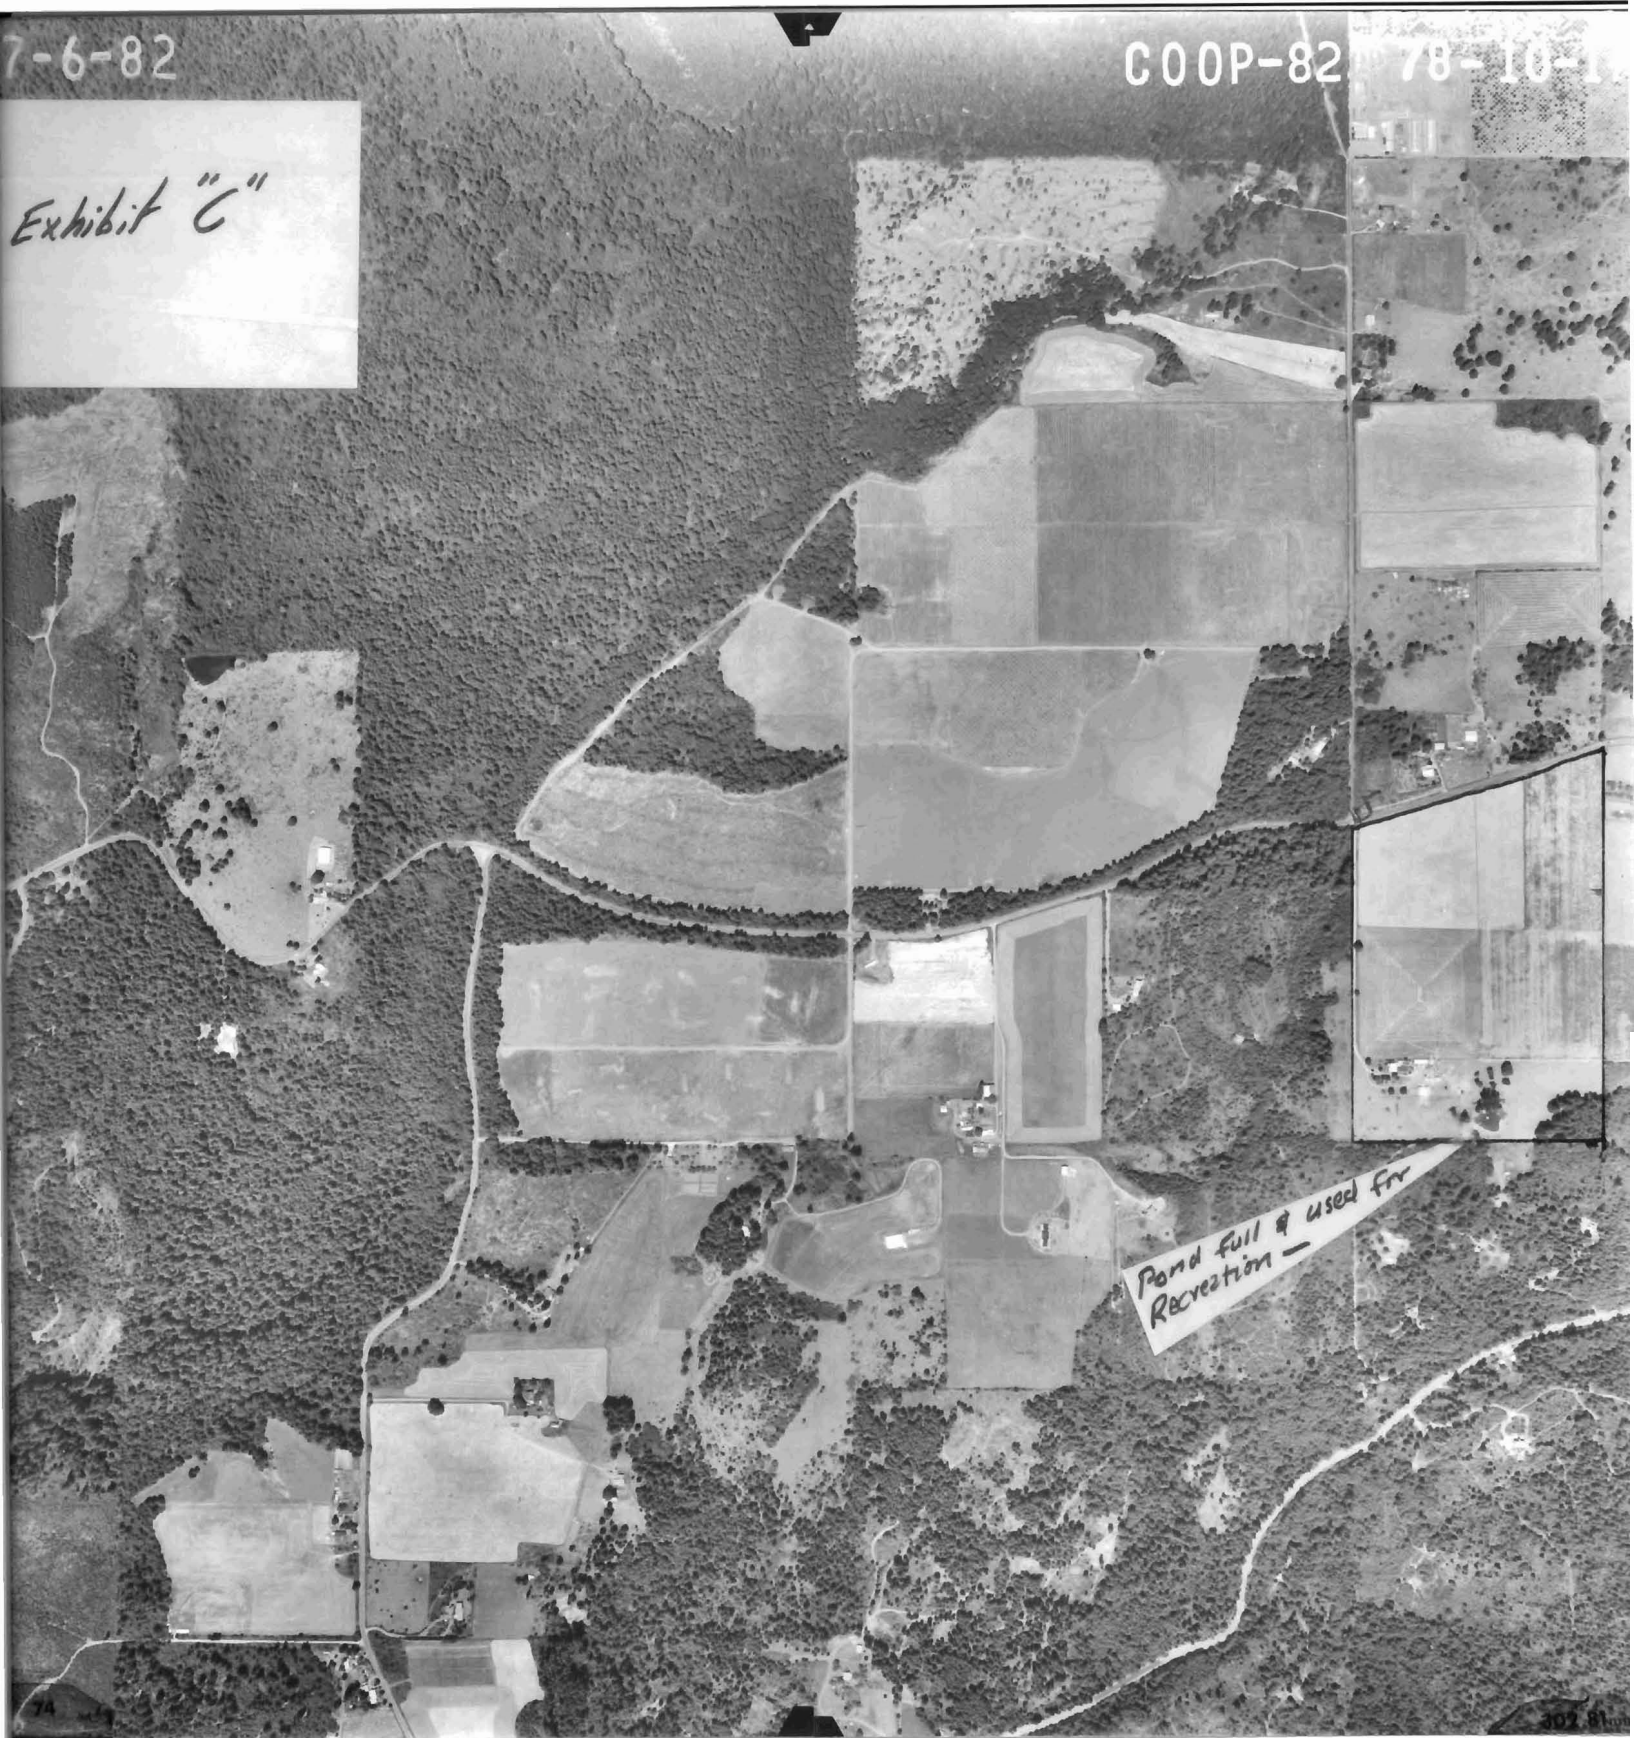

Pond full & used for
Recreation —

(OREGON CITY)

71529

↑ VIOLA 4.3 MI.

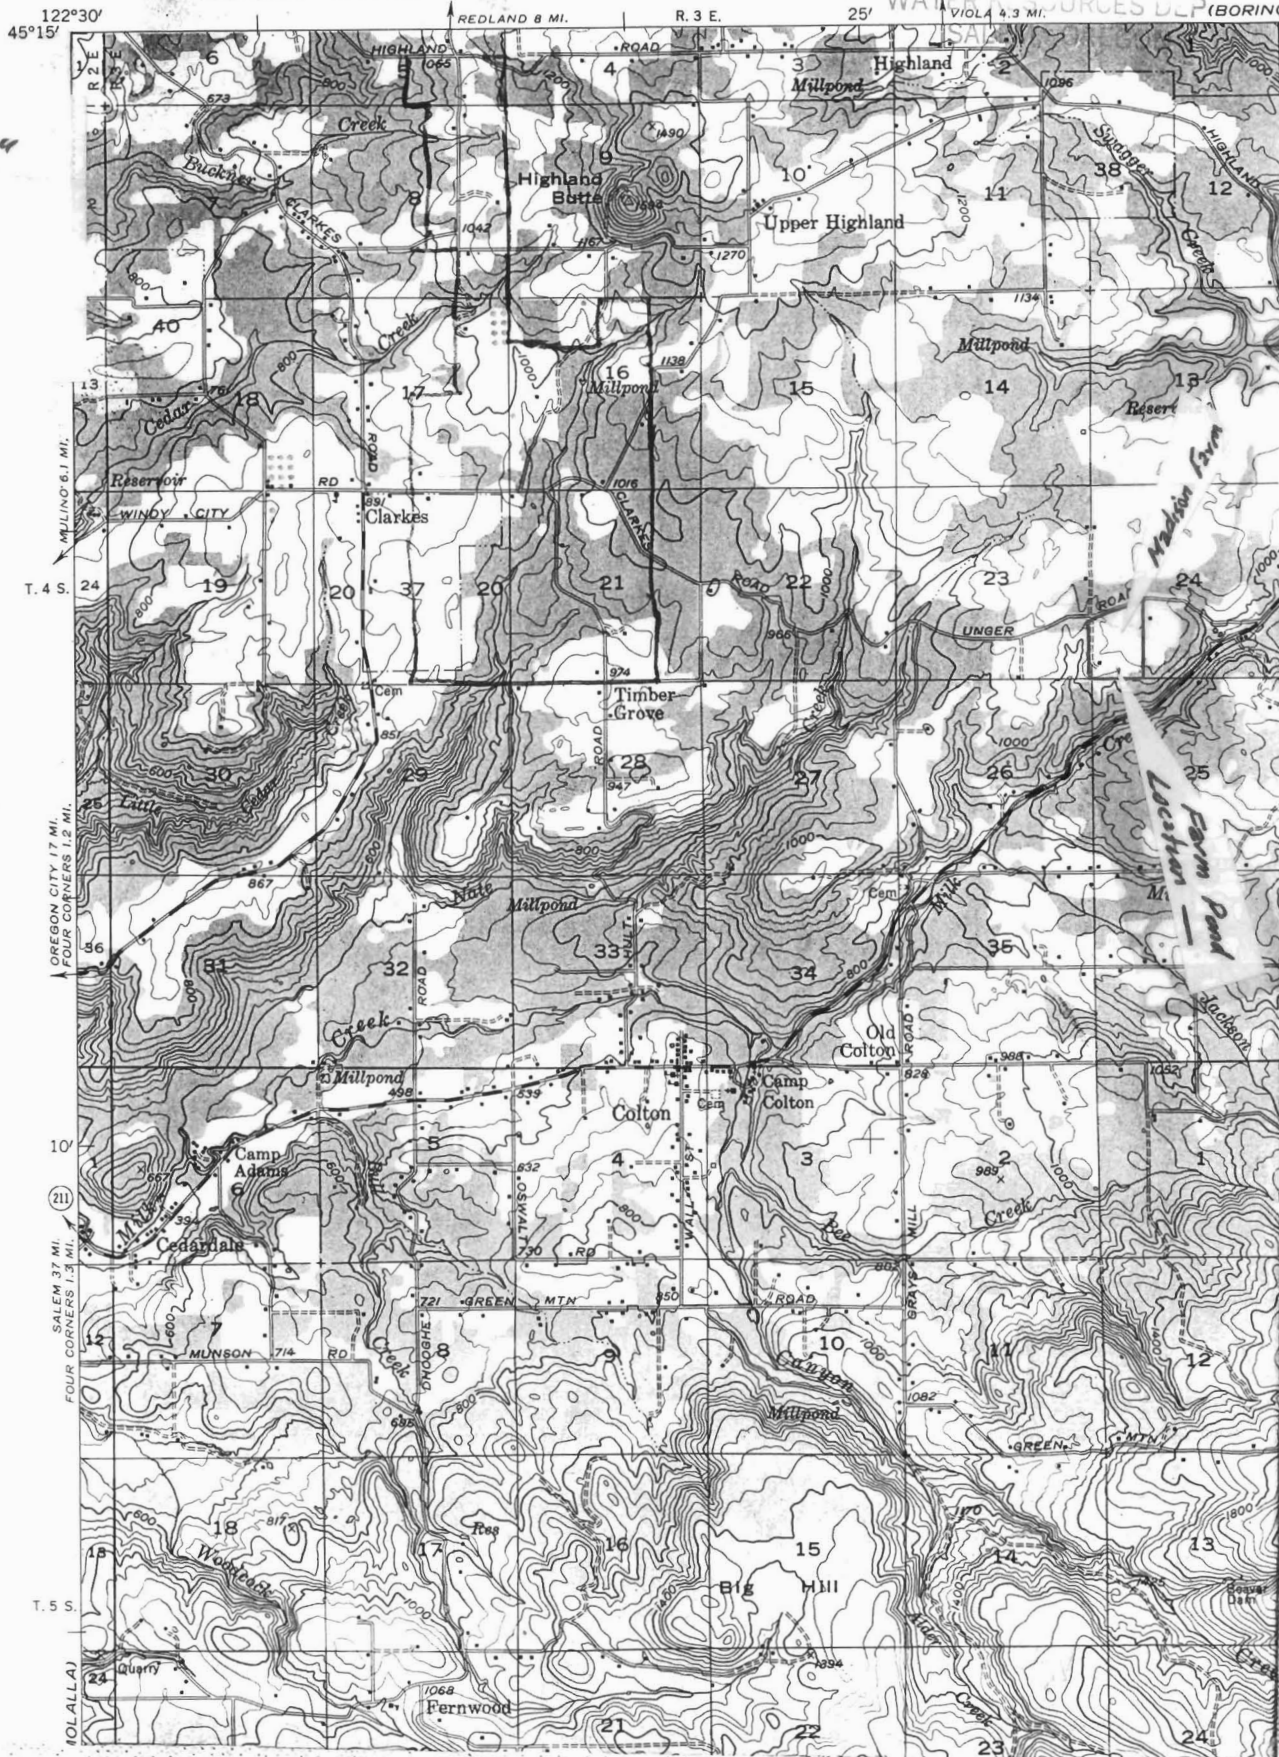


Exhibit "A"

12/27/94
Rum

Exhibit "G"

RECEIVED


DEC 30 1994

WATER RESOURCES LLC
SALEM, OREGON

MADISON FARM POND

W 1/2 S W 1/4, Sec. 24, T45, R3E, W. M.; South of Unger Road
Clackamas County, OR

Application No. R-79806
Permit No.

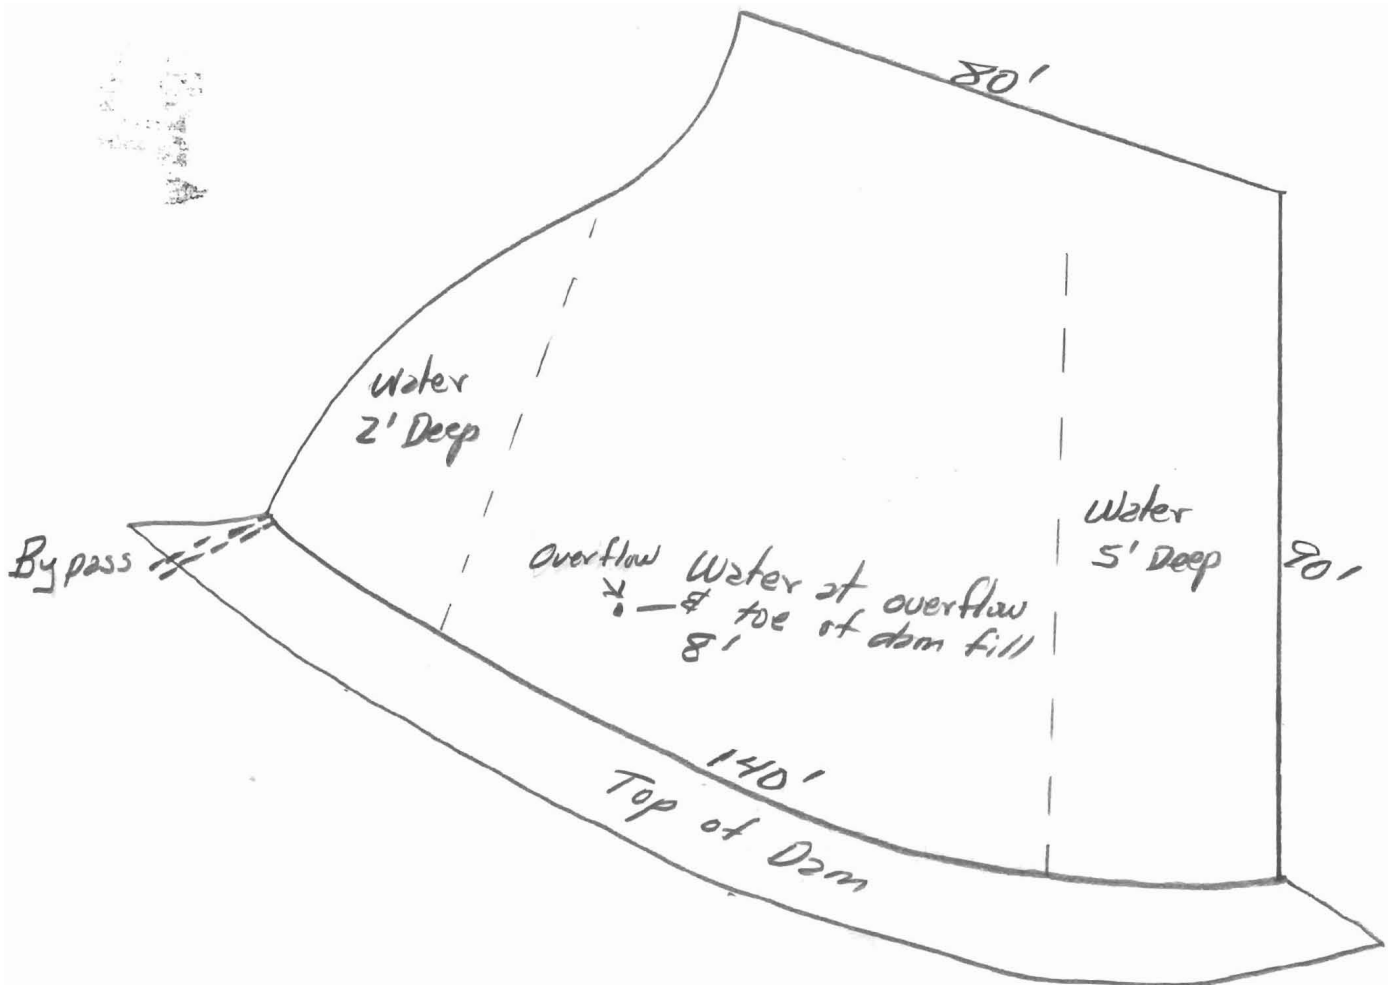

Scale 1" = 25'

12/27/94
Rum