


Application No. R. 79811
Permit No.

30 1994
WATER RESOURCES DEPT.
SALEM, OREGON

CERTIFICATE NO. 71584

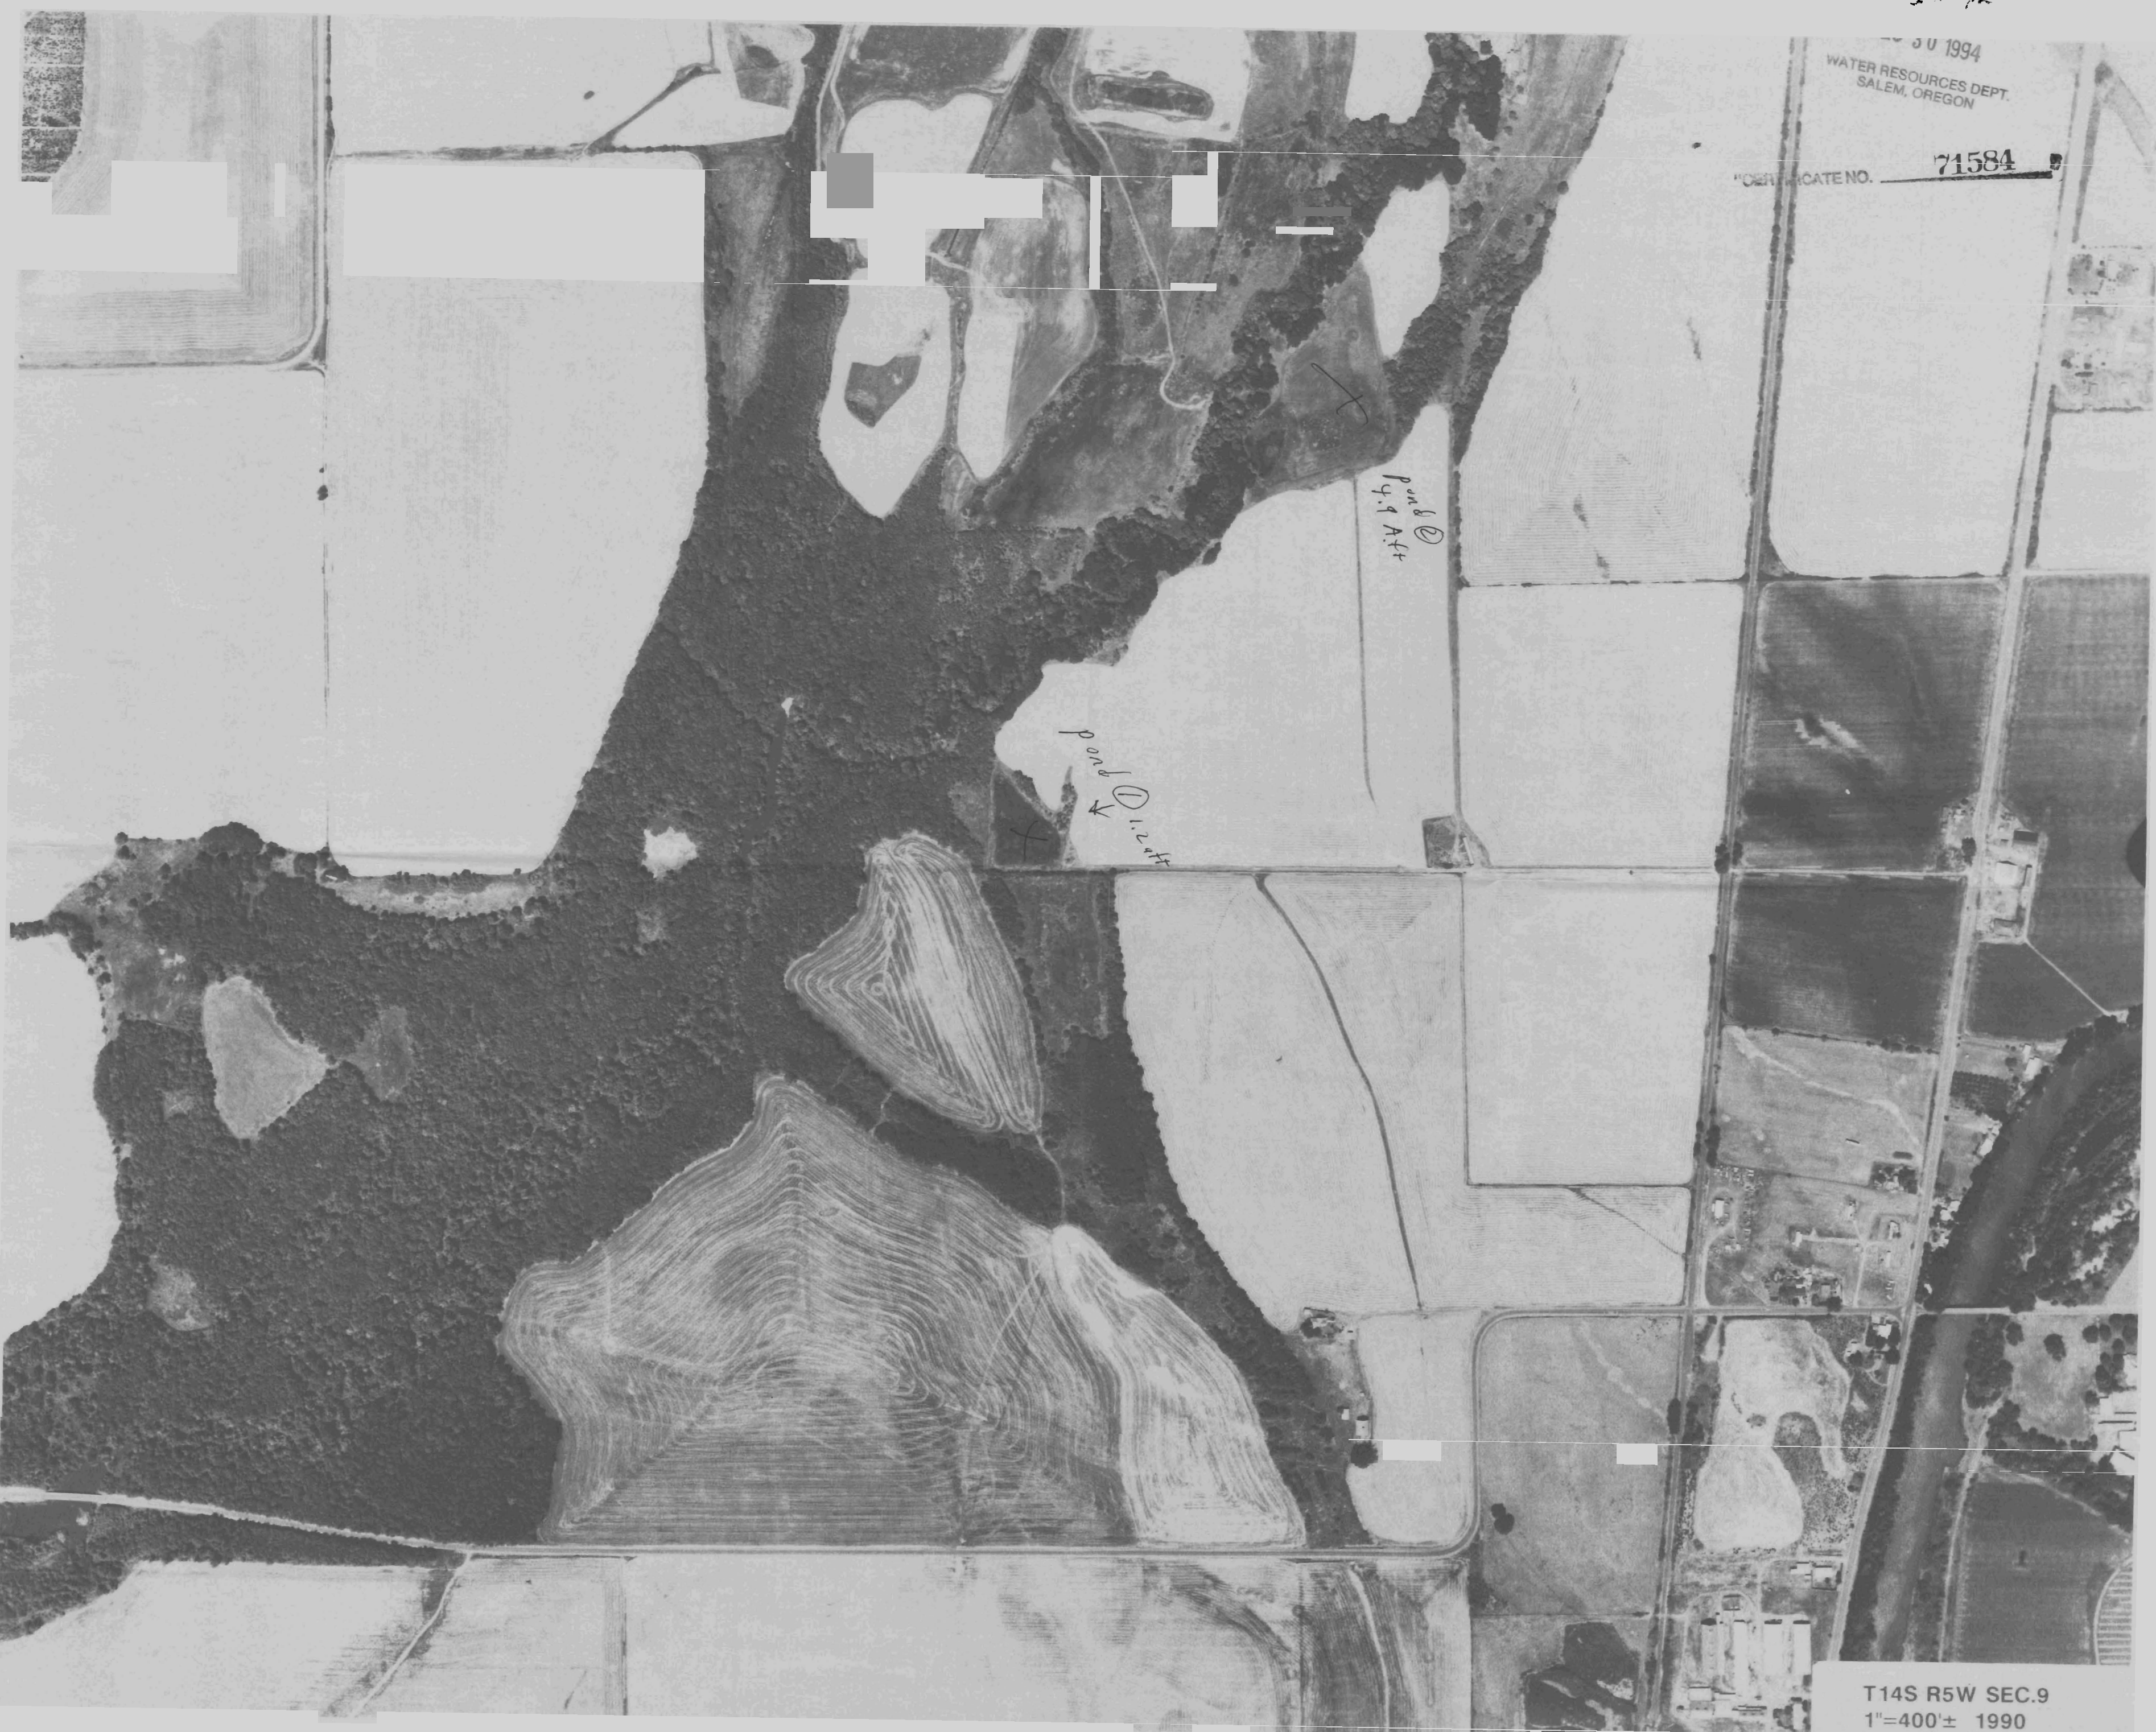

T14S R5W SEC.9
1"=400'± 1990