

TILLAMOOK COUNTY

1" = 2000'

8 & INDEX

This map was prepared for assessment purposes only

11587

ON THE...
ON THE...
h18166


CANCELLED

2600
1600
1170
1801
101
200

3900

SEE MAP 3S 8

PAID

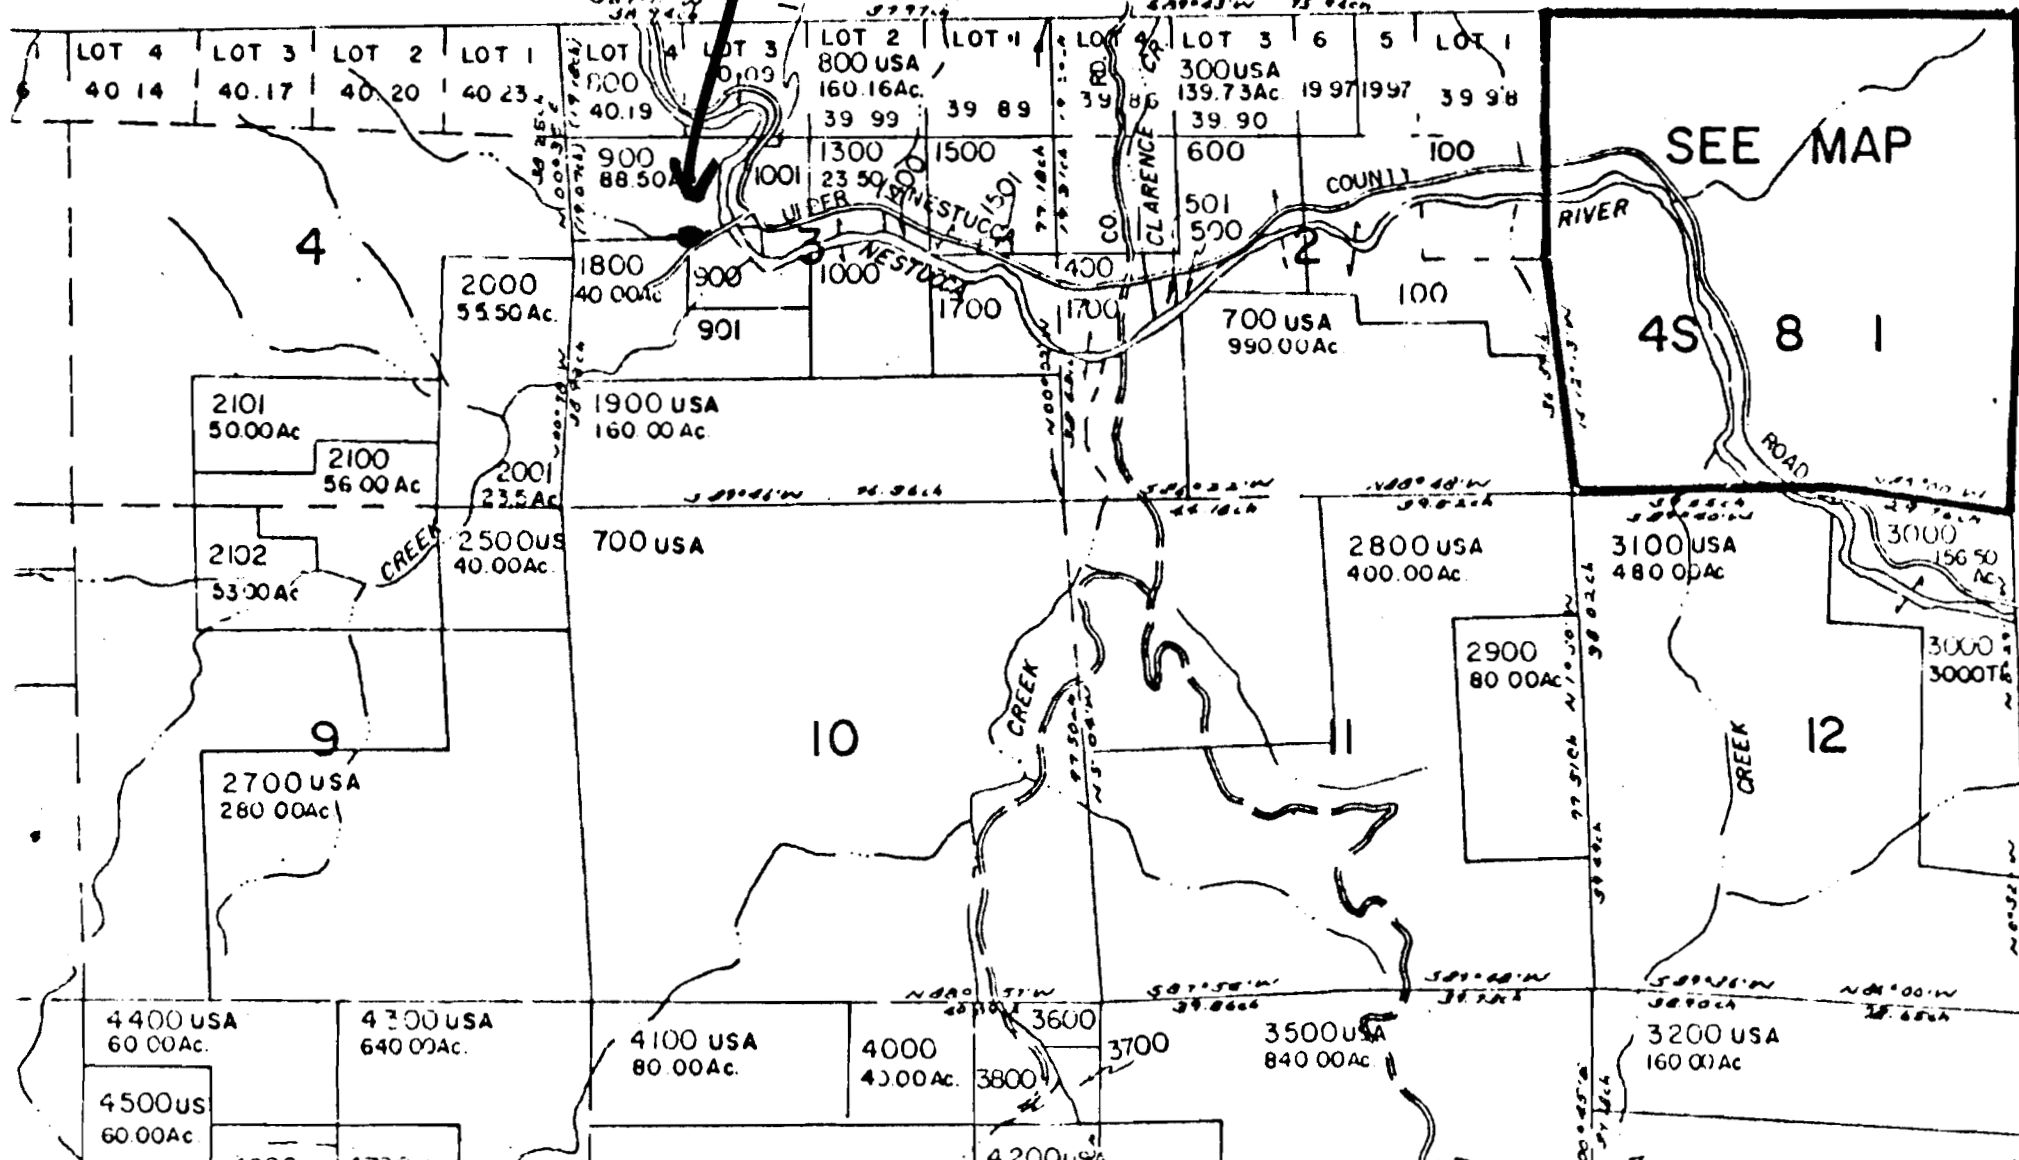

SEE MAP 4S 7