

Legal Description - Pond - Adonias & Donella Lucero
Section 1, Township 7, Range 6
Polk County - 16680 Brown RD, DALLAS, OR 97338

Application

79815

DALLAS QUADR
OREGON-POLK
7.5 MINUTE SERIES (TC
NE/4 DALLAS 15' QUADR

Permit No.


71588

CERTIFICATE NO.

UNITED STATES
DEPARTMENT OF THE INTERIOR
GEOLOGICAL SURVEY

1374 III SW
(SHERIDAN)

7
6
-
1
201

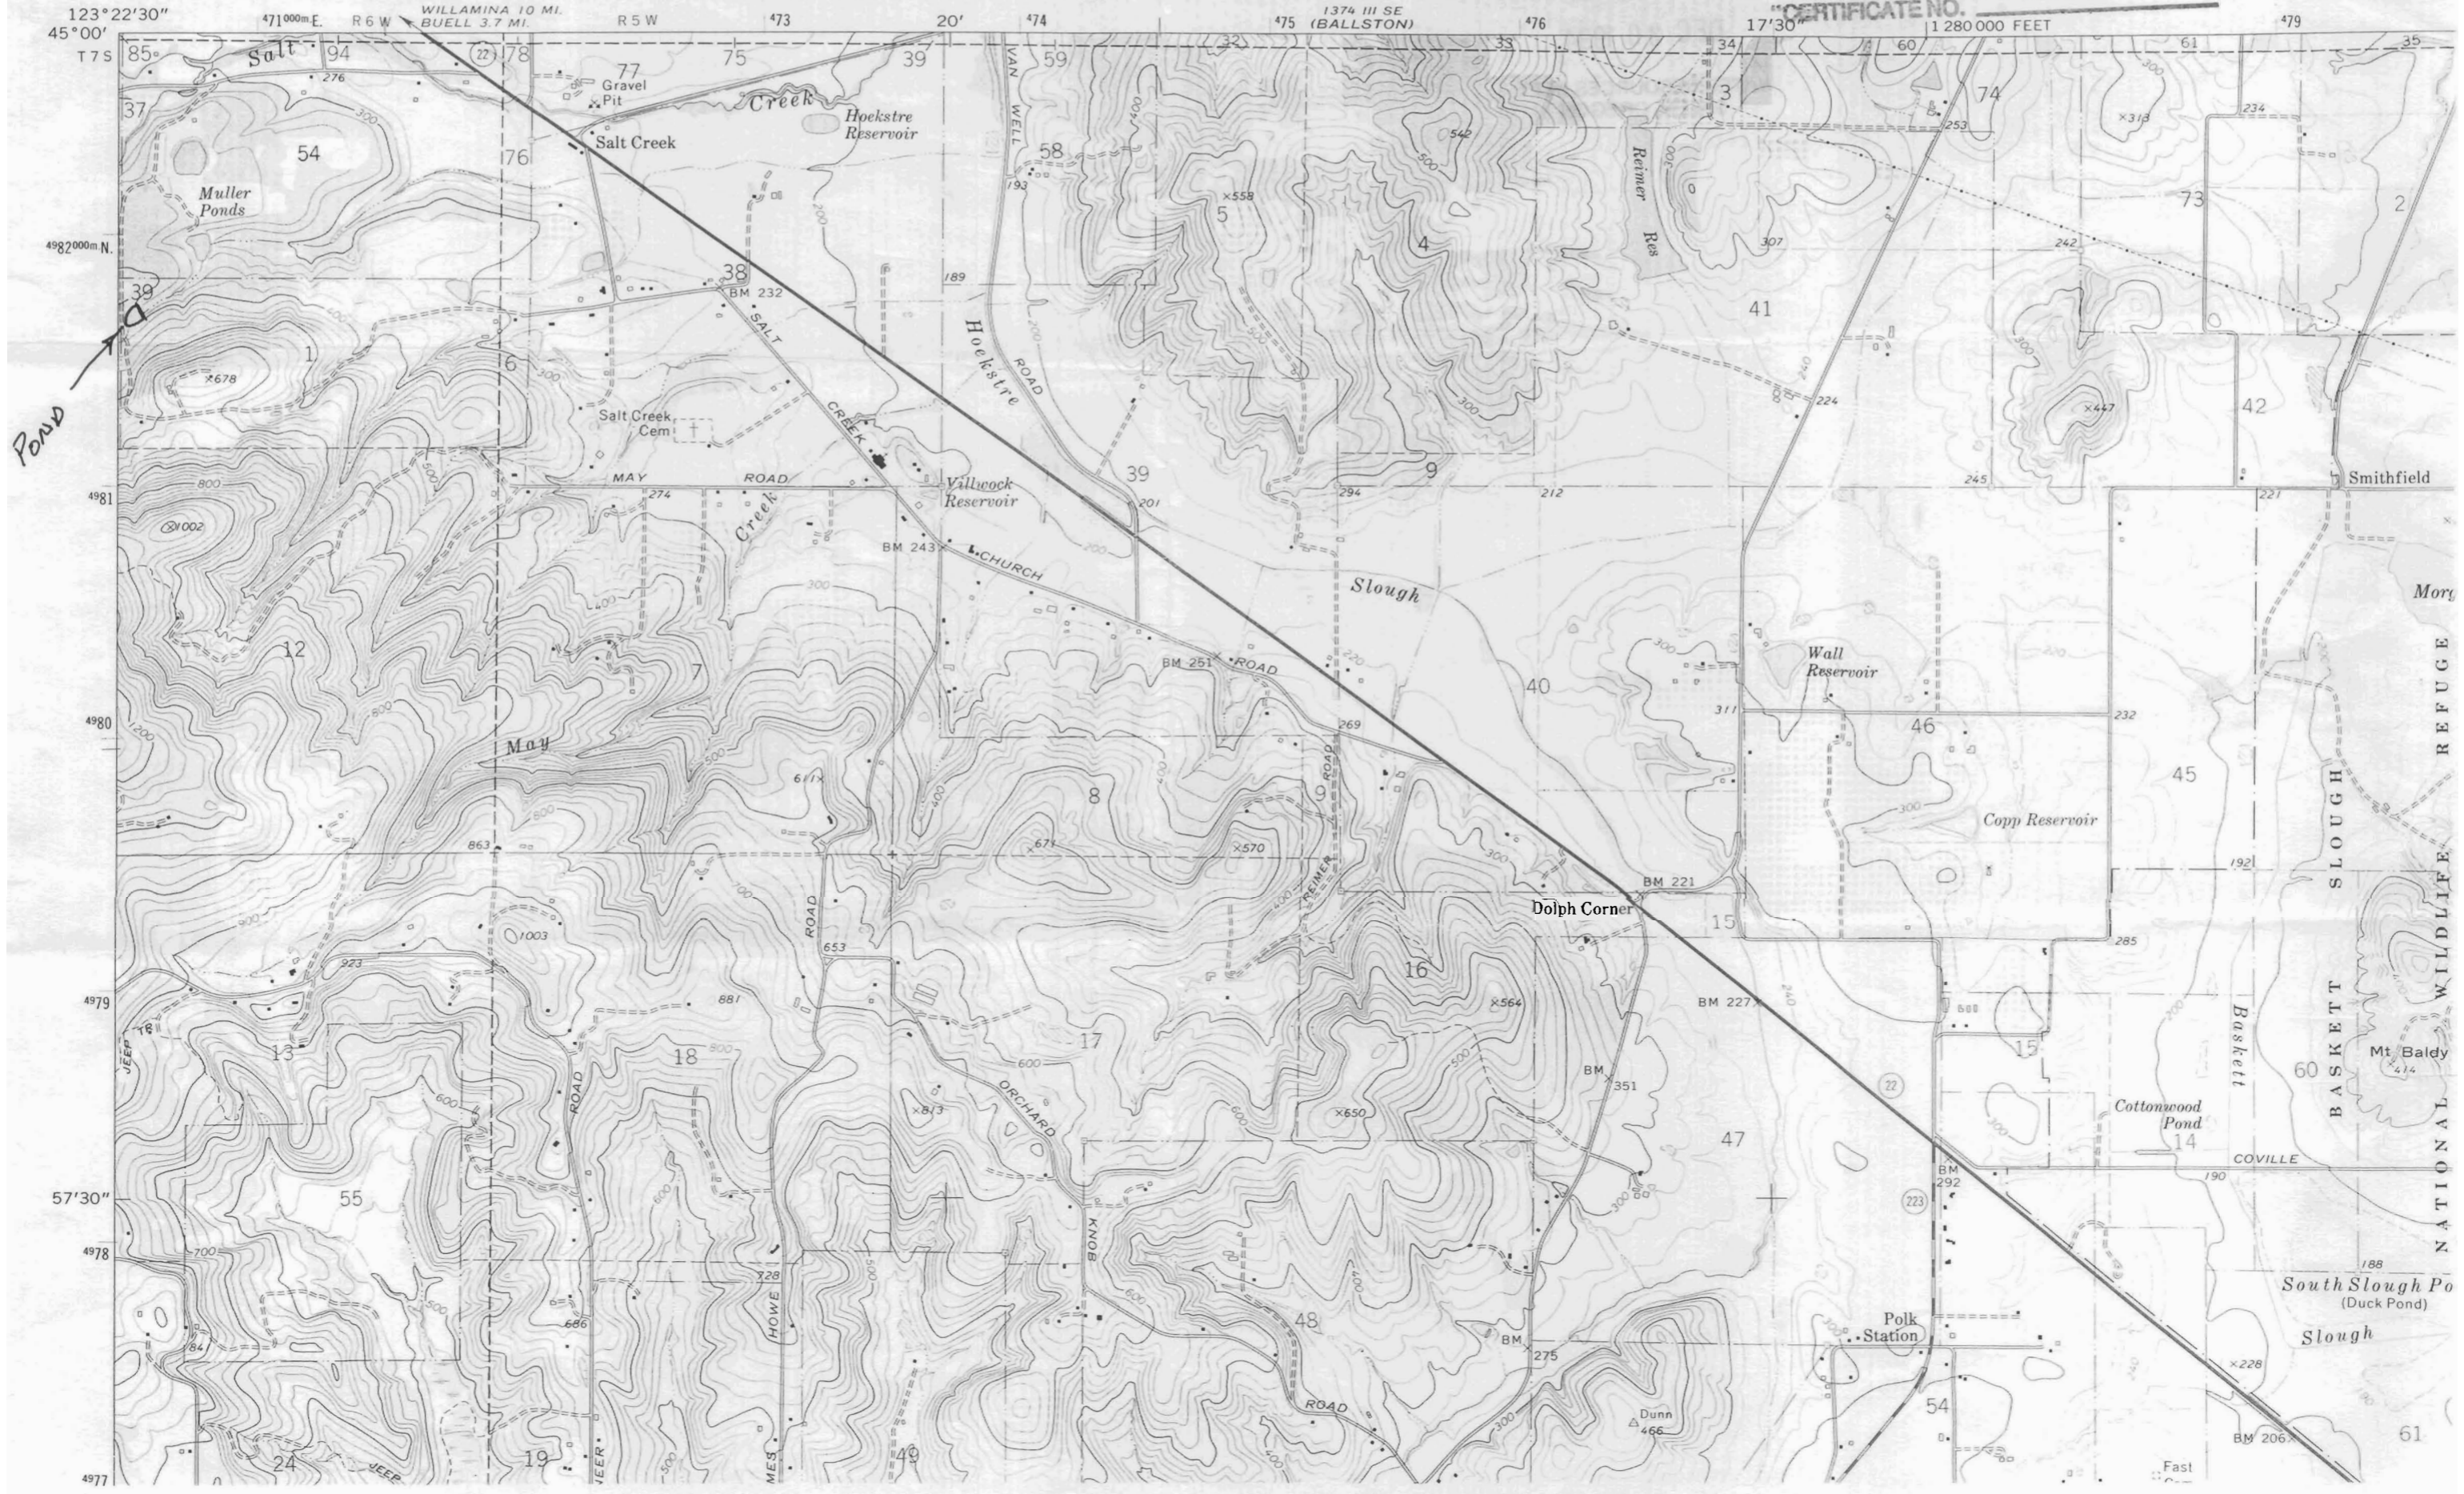

Pond

MORGAN
SLOUGH
BASKETT
SLOUGH
NATIONAL
WILDLIFE
REFUGE

South Slough Po
(Duck Pond)
Slough