

Application No. R-79823

Permit No.

APPLICATION FOR WATER RIGHT

- for -

DONALD J. WIDING

T. 3 S., R. 1 W., W.M.

"CERTIFICATE NO. 71596"


RECEIVED

MAR 22 1990
RECEIVED
WATER RESOURCES DEPT.
SALEM, OREGON
DEC 28 1994

WATER RESOURCES DEPT.
SALEM, OREGON



Scale 1" = 660'
FEB 1, 1990

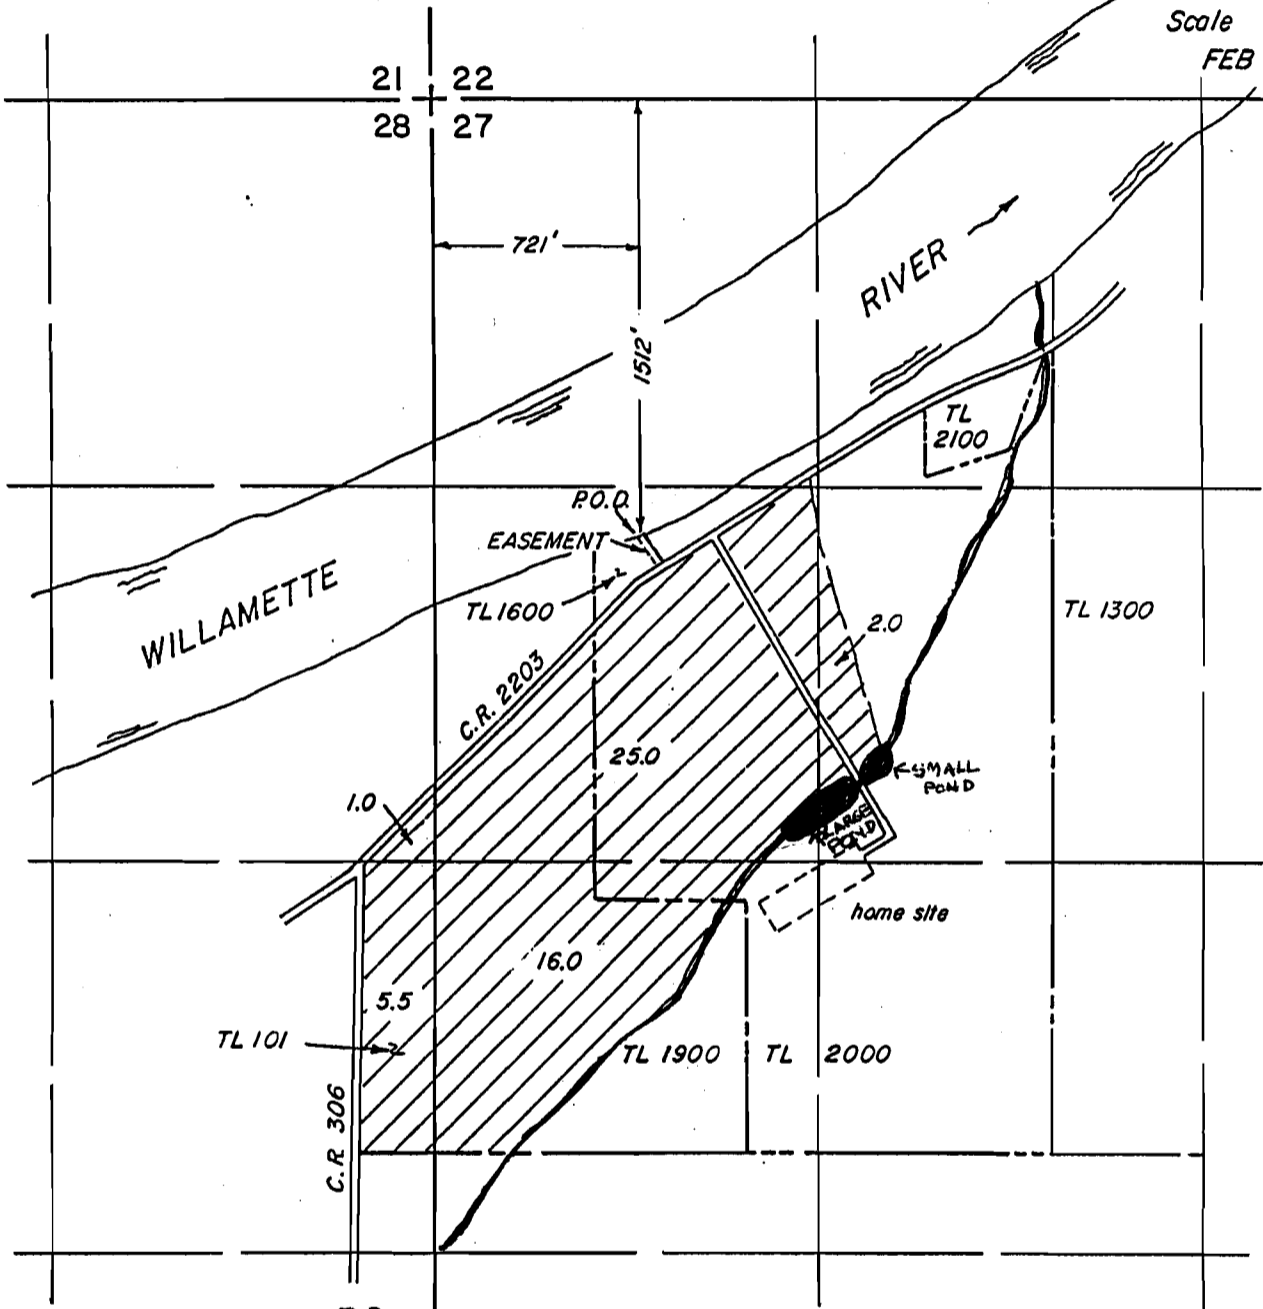

SEE ALSO SHOW

Application No. 70208
Permit No. 51048


Applicant:

DONALD J. WIDING
Route 2, Box 488
Aurora, OR 97002

Prepared By:

LAWRENCE ANDERSON
23881 Schultz Rd. NE
Aurora, OR 97002
Ph. 678-2786

NOTE: This map was prepared for the purpose of identifying the location of the proposed water right and is not intended to identify property lines.

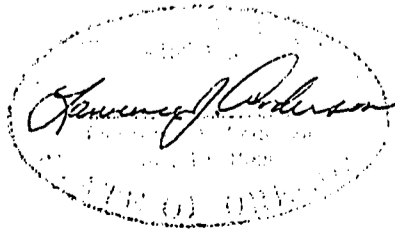

17-11111