


... hereby certify

, and that it correctly

ation of station, and

North

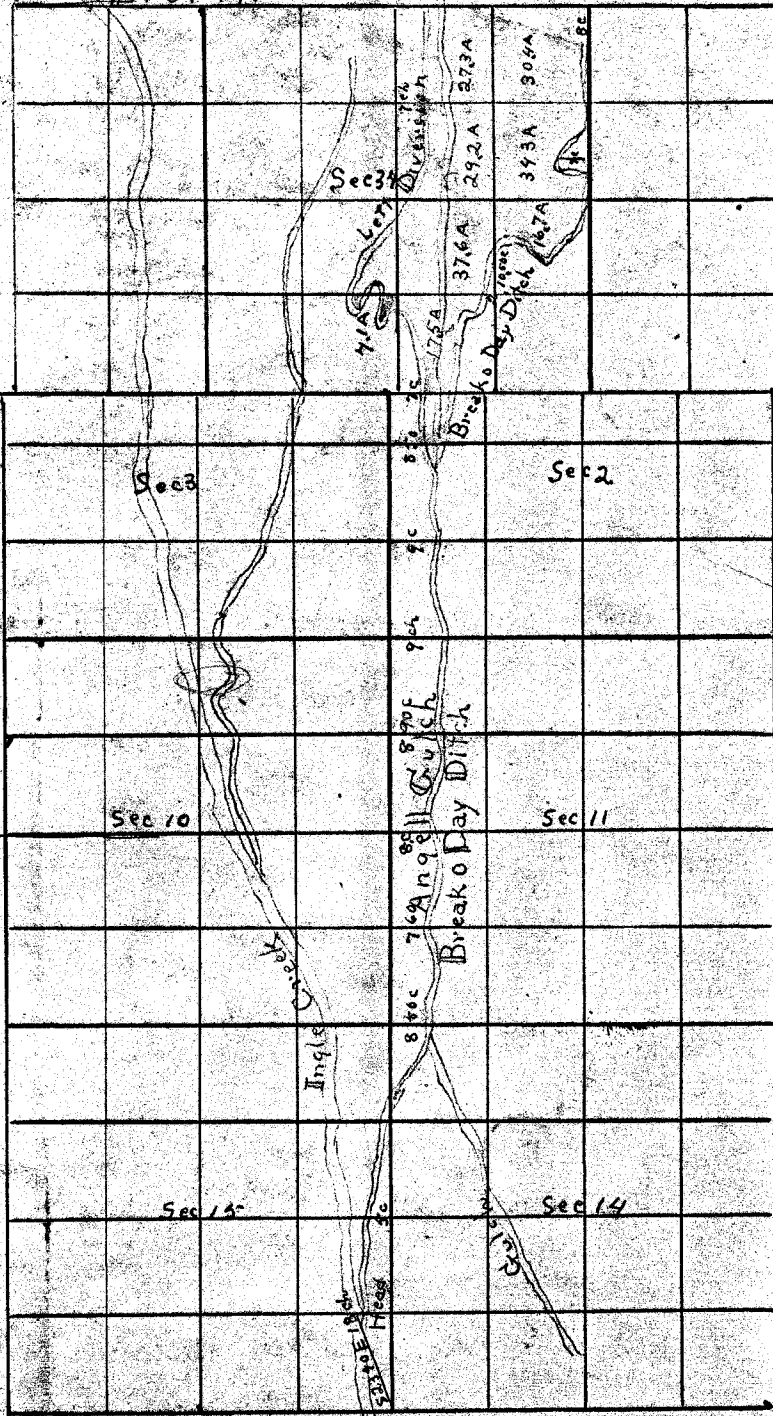

Twp 135R 30E

Twp 145 R 30E

App. # 300
Per # 86