


512  
15 12 E  
SEC 17

Application No. R. 79832

Permit No.

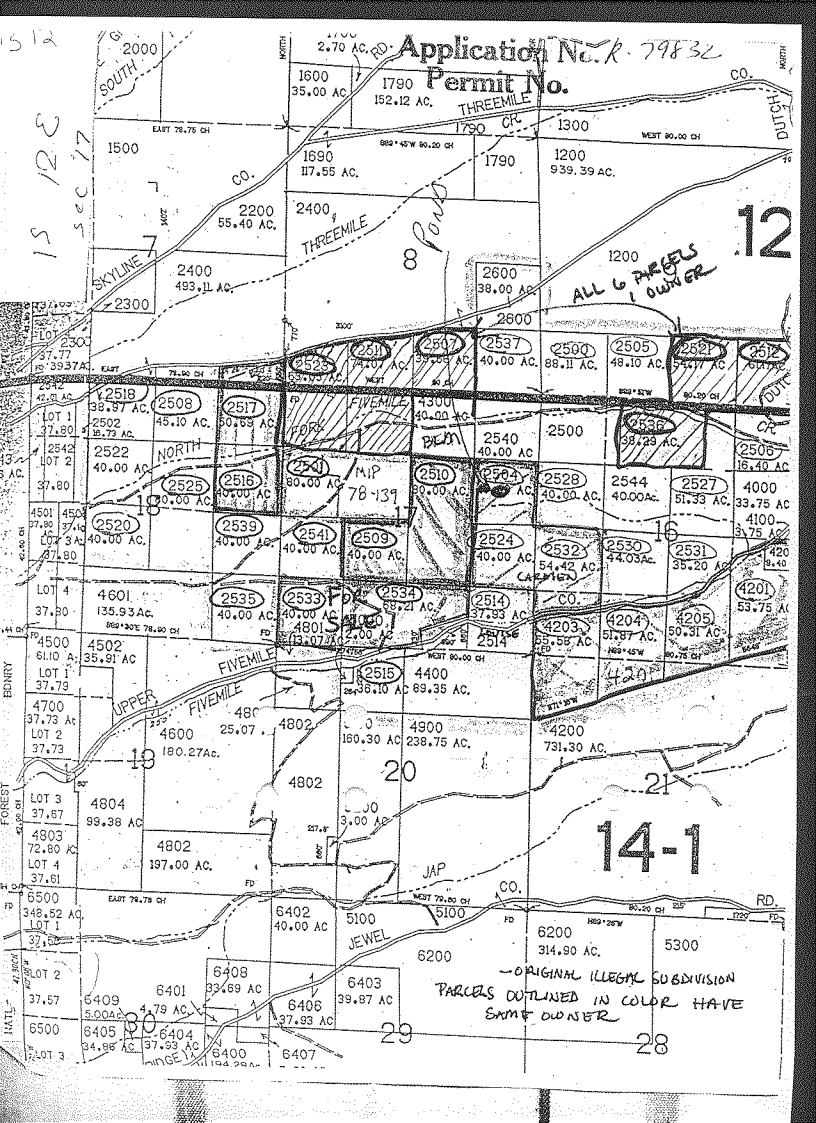

12

ALL 6 PARCELS  
1 OWNER

8 POND

14-1

- ORIGINAL ILLEGAL SUBDIVISION  
PARCELS OUTLINED IN COLOR HAVE  
SAME OWNER

29

28