

LINE TYPES

TAX LOT BOUNDARIES

OLD PROPERTY LINES

RIVERS, LAKES, ETC.

CREEKS, POND, ETC.

RAILROADS

TAX CODE BOUNDARIES

SUBDIVISION BOUNDARIES

SYMBOL TYPES

CONTROL POINTS

SURVEY MONUMENTS

G.L.O. CORNERS (APPROX) (FOUND)

SECTION
1/4 SEC
1/16 SEC
D.L.C.

OREGON STATE PLANE
COORDINATE SYSTEM
GRID MARKS - NAD 27

NUMBERS

TAX CODE NO.

000 00 00 0


ACREAGE - ALL ACREAGES EXCLUDE
ANY PORTION THAT MAY LIE
WITHIN THE INDICATED PUBLIC
RIGHT OF WAYS.

TICK MARKS - WHEN A TICK MARK IS
INDICATED ON THE EXTENSION OF
A LINE, THEN THE DIMENSION GOES
TO THE TICK MARK. GENERALLY THIS
IS USED WHEN DIMENSIONS GO INTO
PUBLIC RIGHT OF WAYS.

225.00
169.00

ARROWS ARE USED WITH DIMENSIONS
IN AREAS OF GREATER COMPLEXITY.

WARNING: This map was
created by digitizing
assorted existing maps.
NO Research was done.
Created for Assessor's
Office use ONLY.

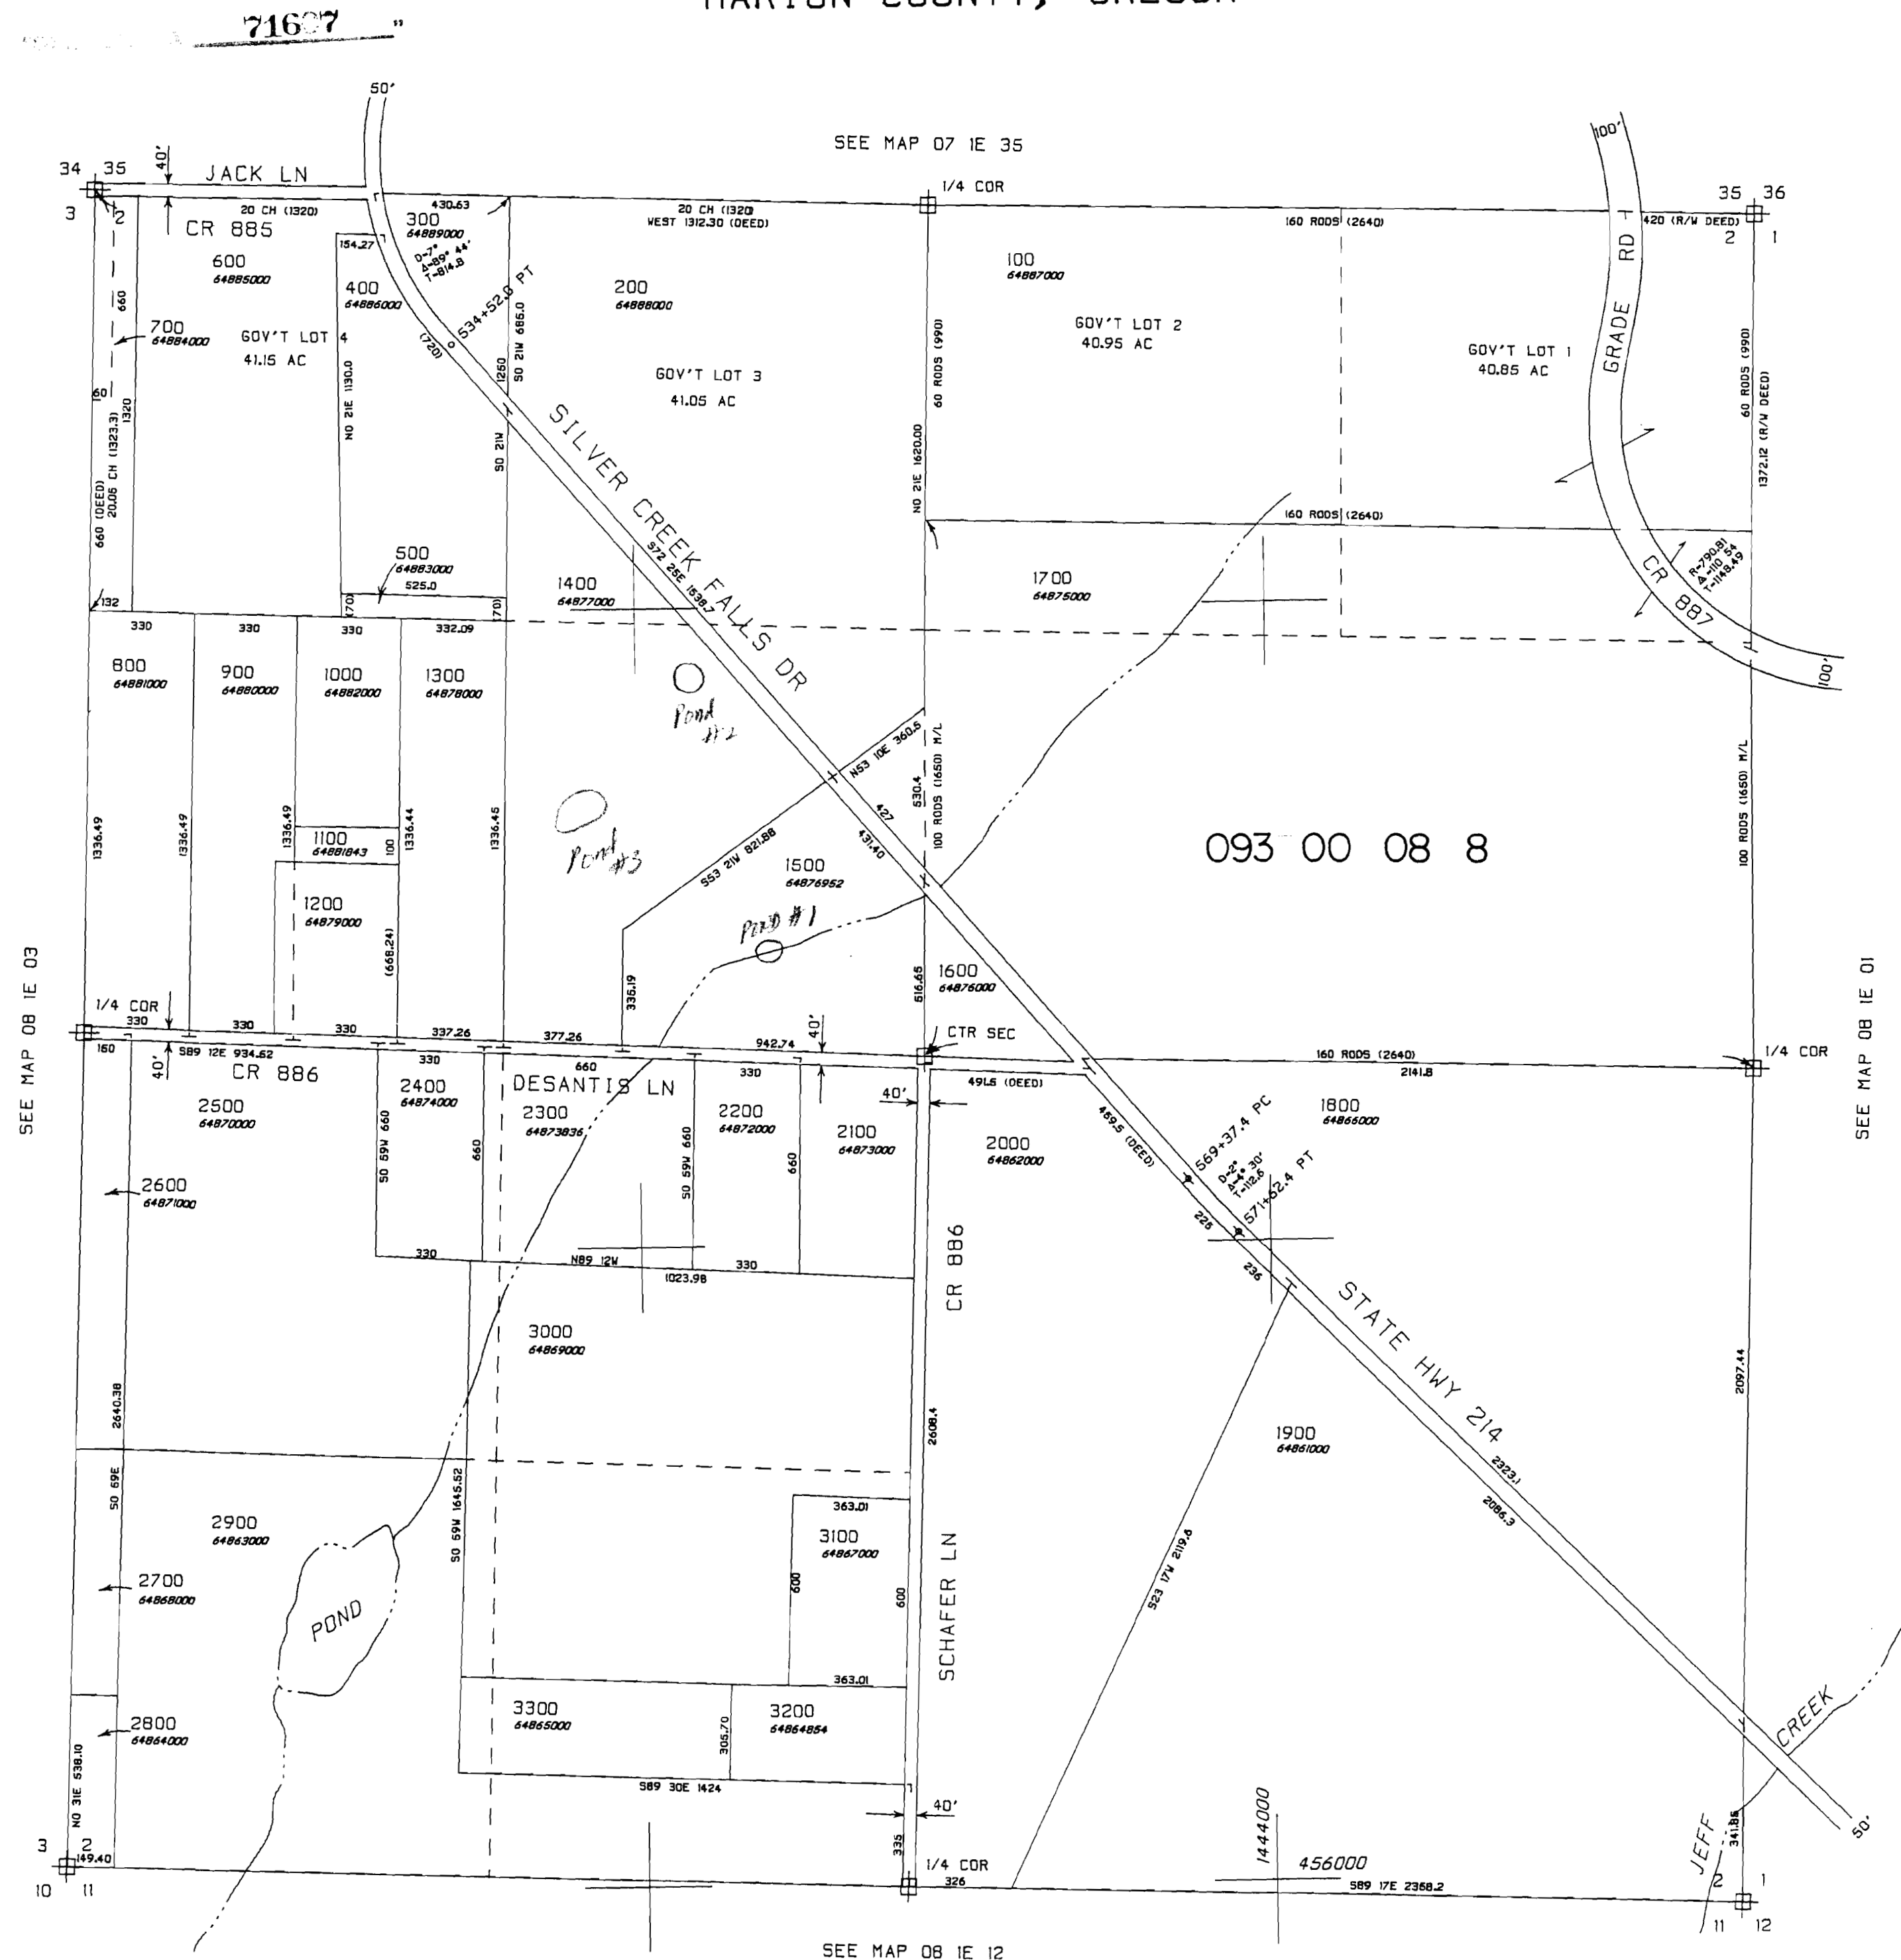

RECEIVED
JUN 11 1994
MARION COUNTY, OREGON
COUNTY CLERK'S OFFICE



1"=400'
06-JUN-89