


RECEIVED

DEC 30 1994

WATER RESOURCES DEPT  
SALEM, OREGON

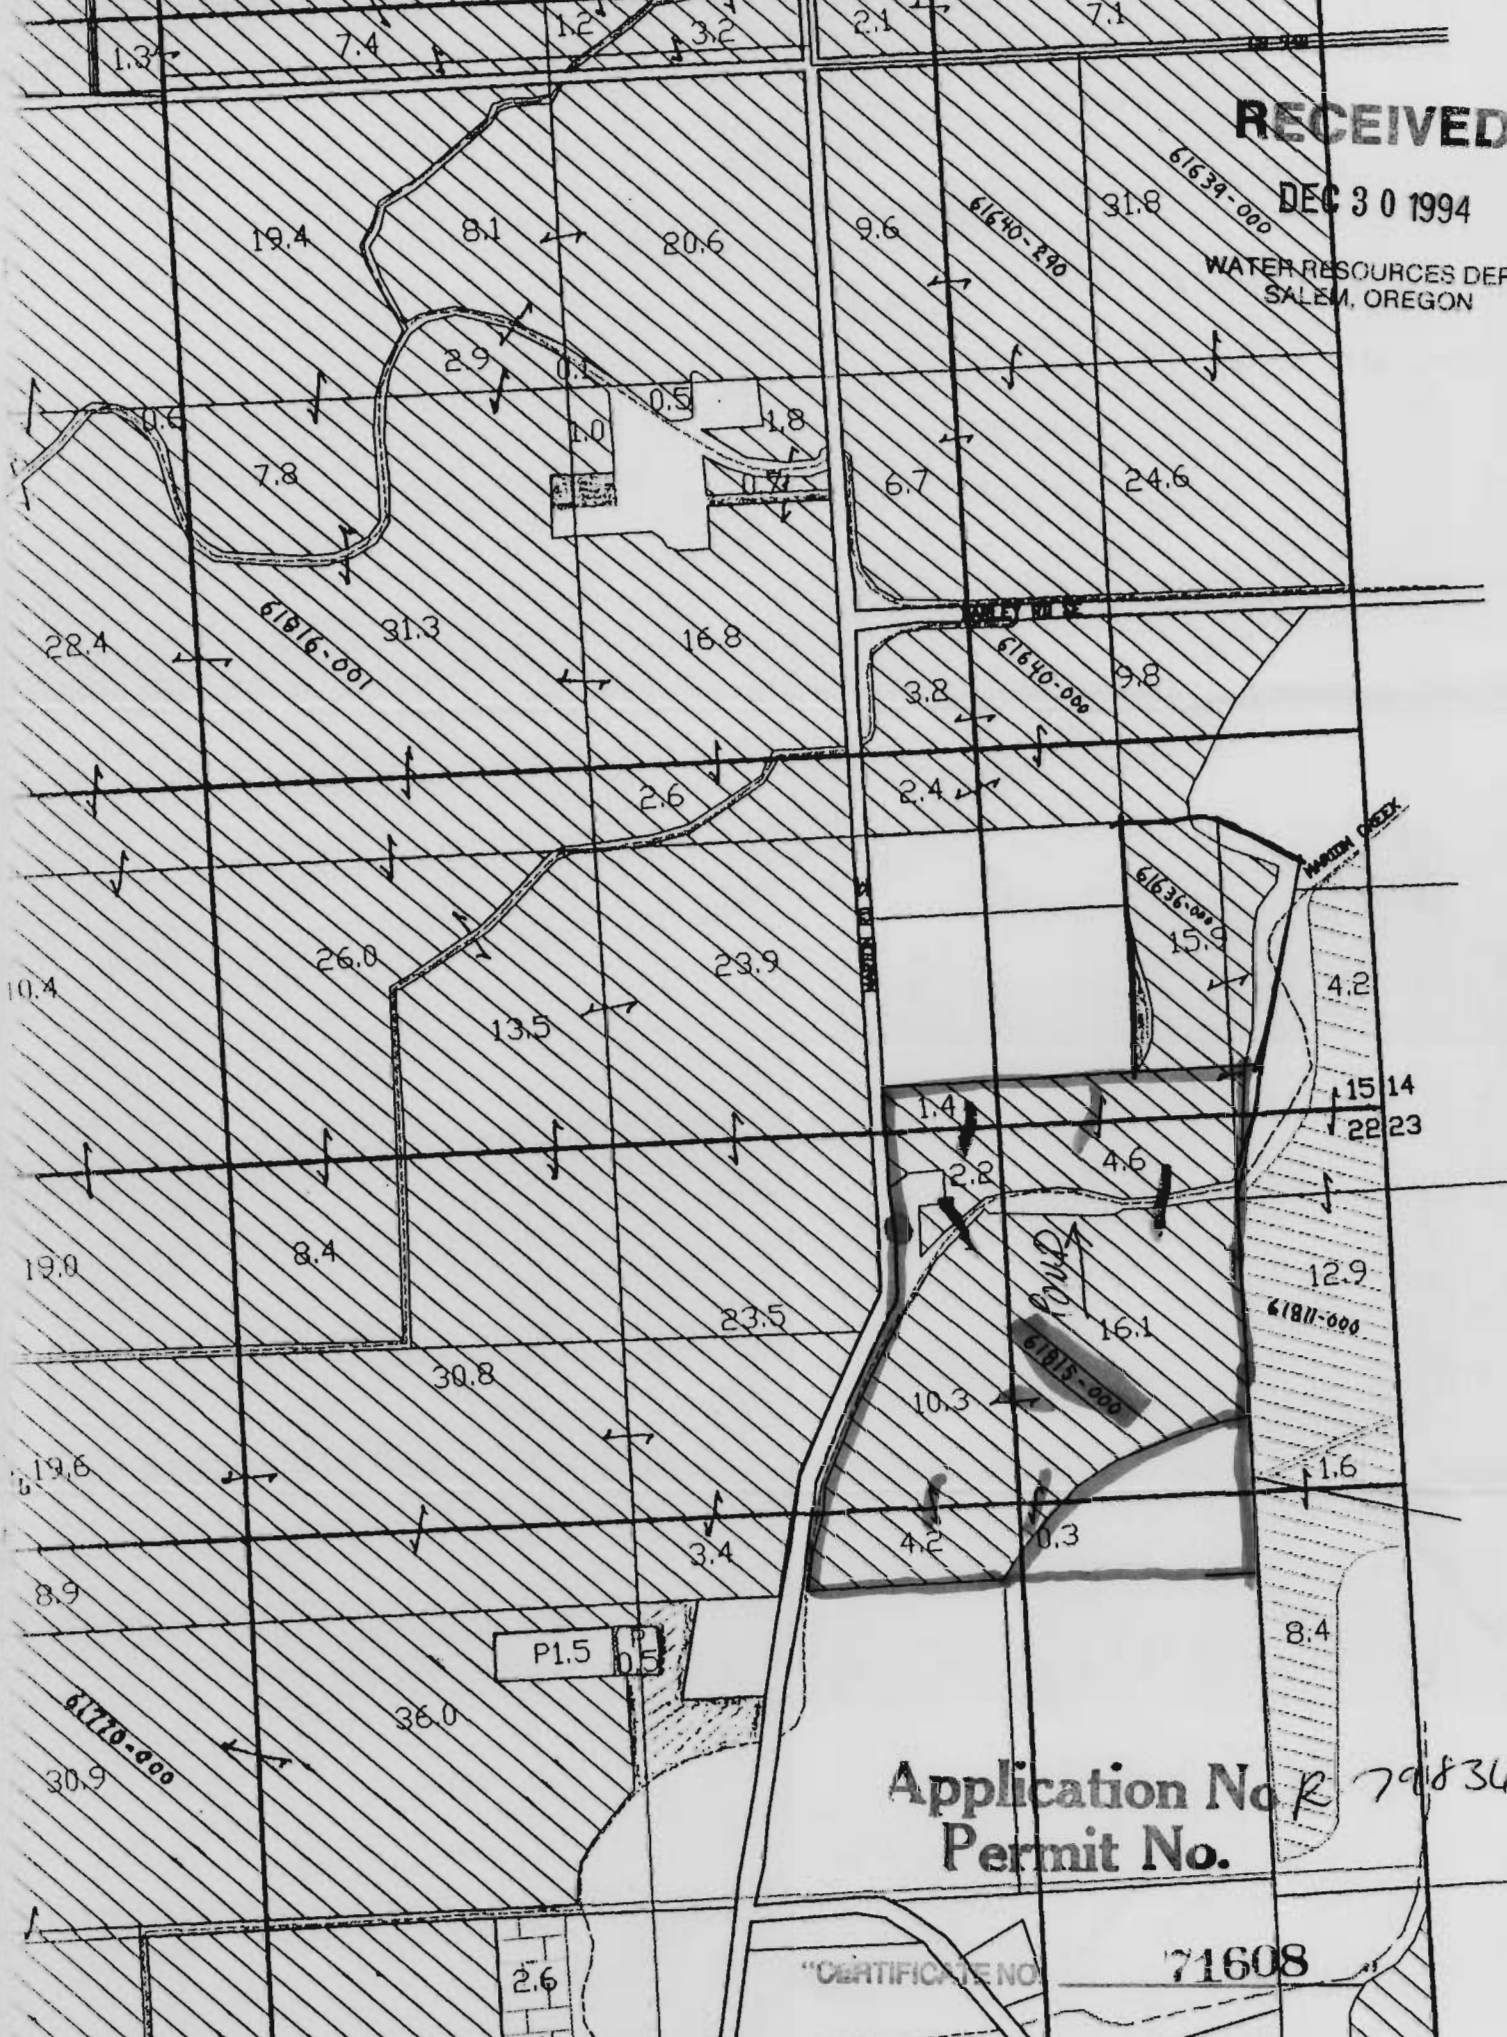

Application No. R 79836  
Permit No.

CERTIFICATE NO. 71608