

SECTION 21 T.27S. R.7W. W.M.  
DOUGLAS COUNTY

1"-400'


WATER RESOURCES DEPT  
SALEM OREGON

Application No. R. 79845  
Permit No.

THIS MAP WAS PREPARED FOR  
ASSESSMENT PURPOSE ONLY.

CERTIFICATE NO. 71617

SEE MAP 27 7 16

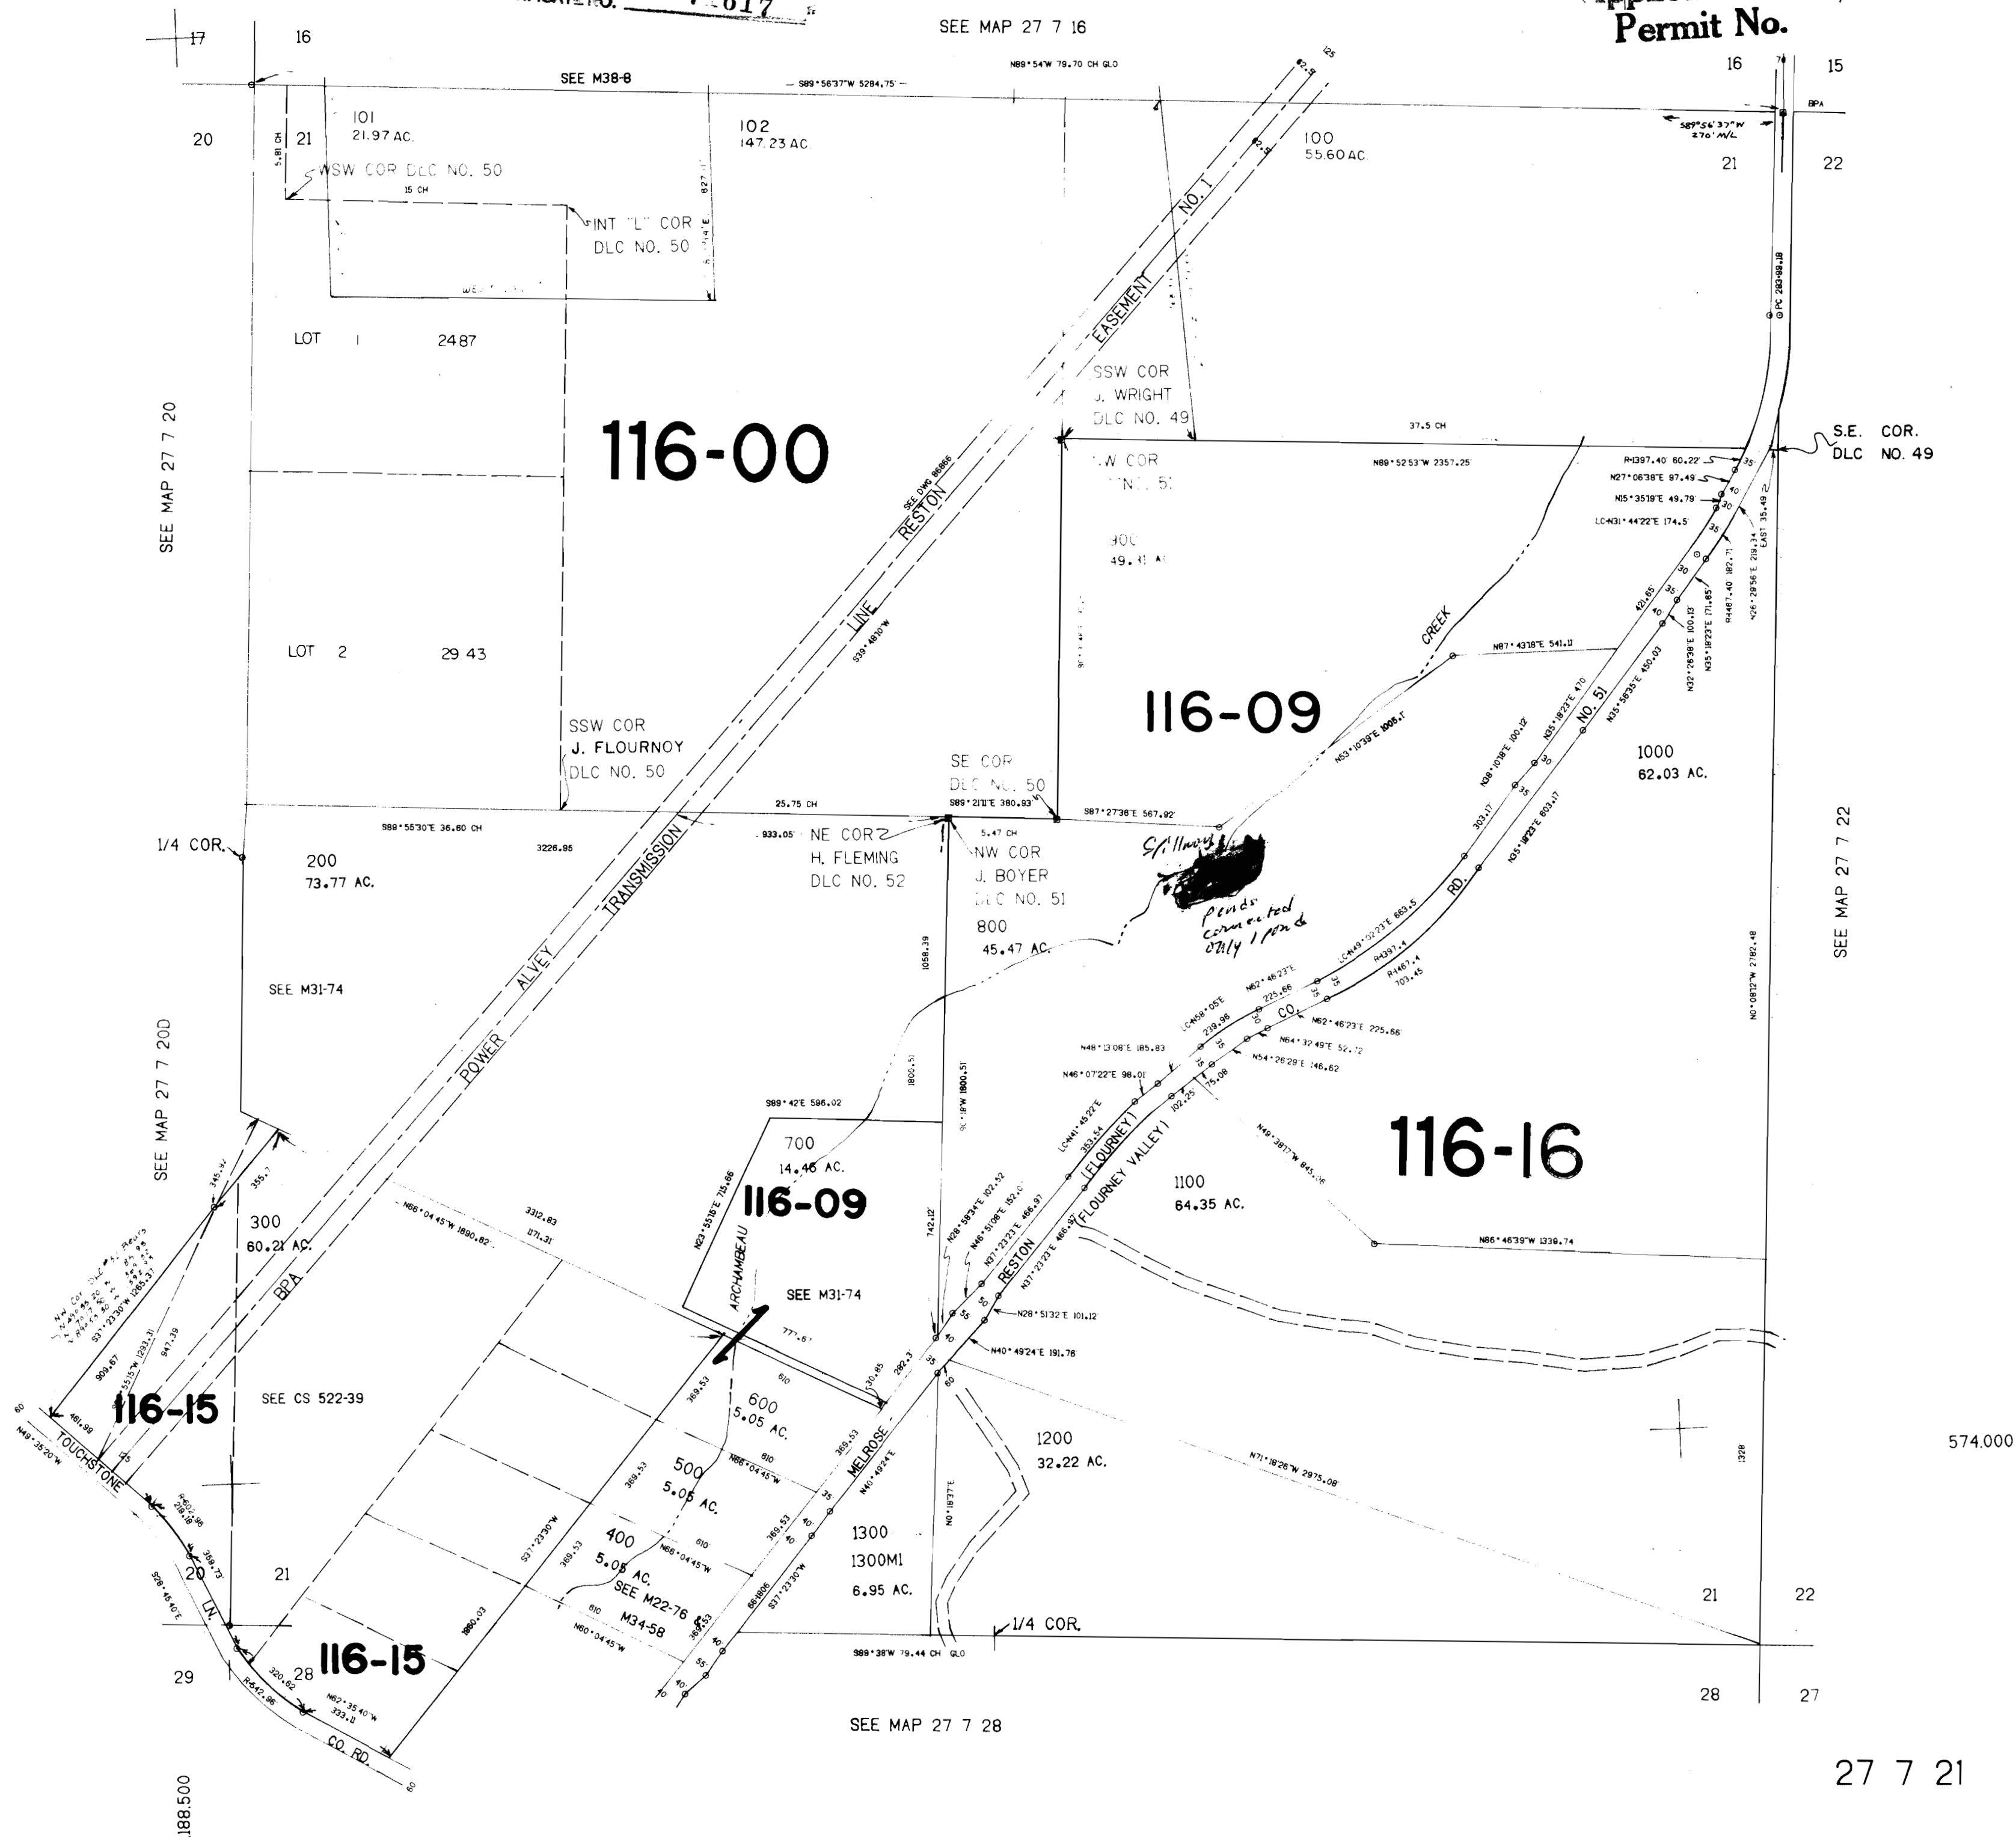

SEE MAP 27 7 22