


# T.6S., R. 2&3 W., W.M.

RECEIVED


DEC 29 1994

WATER RESOURCES DIVISION  
OREGON

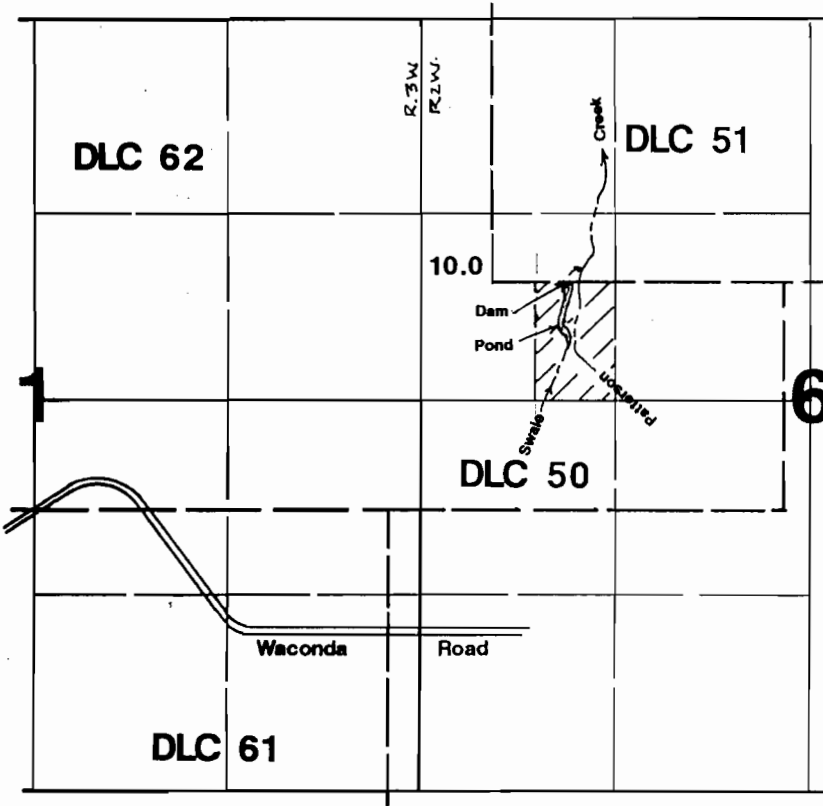

SW NE

1" = 1320'

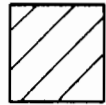

Supplemental Irrigation-Pond

Dam & POD located 40'S & 1500'W from NE corner DLC 50.

## Application Map

### Ted V. Bell

Application #: R-79851 Permit #:

