


Campbell / Bielby Parcel and Pond with Springs
T 45, R 7W, Sec 7, T. 4, 700
544 ft

RECEIVED

DEC 29 1994

WATER RESOURCES DEPT.
SALEM, OREGON

Application No. R 79854
Permit No.

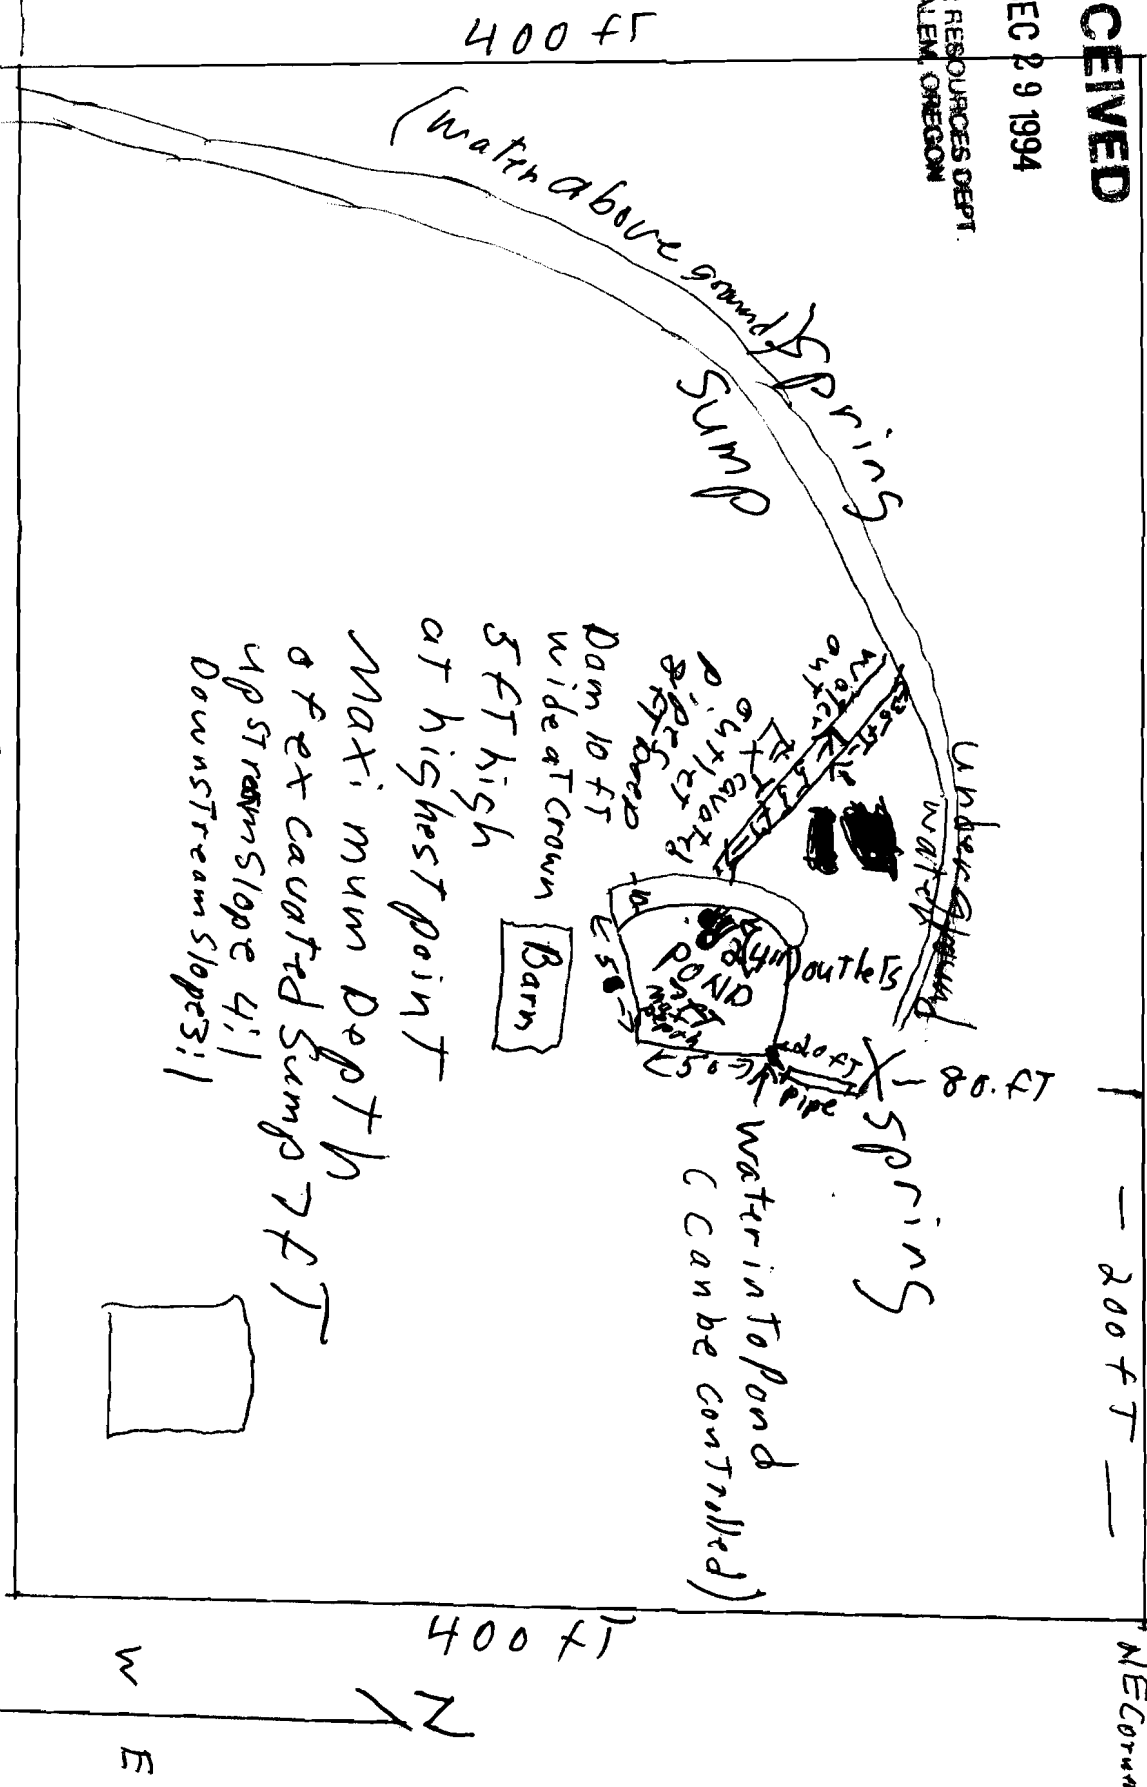

Brass
Capped
Pipe

Application No. 2791

Permit No.

Campbell
Bielby
Property

T2790

RECEIVED

DEC 29 1994

WATER RESOURCES DEPT.
SALEM, OREGON

1990
Aerial
map

C.F.S.A.

ly

ROAD

GILBERT CREEK

GILBERT

T2881

NOT TO SCALE

F 9 - 2B

T 5