

RECEIVED

DEC 30 1994


WATER RESOURCES DEPT.
SALEM, OREGON

T. 22 S. R. 29 E

CERTIFICATE NO.

71632


71

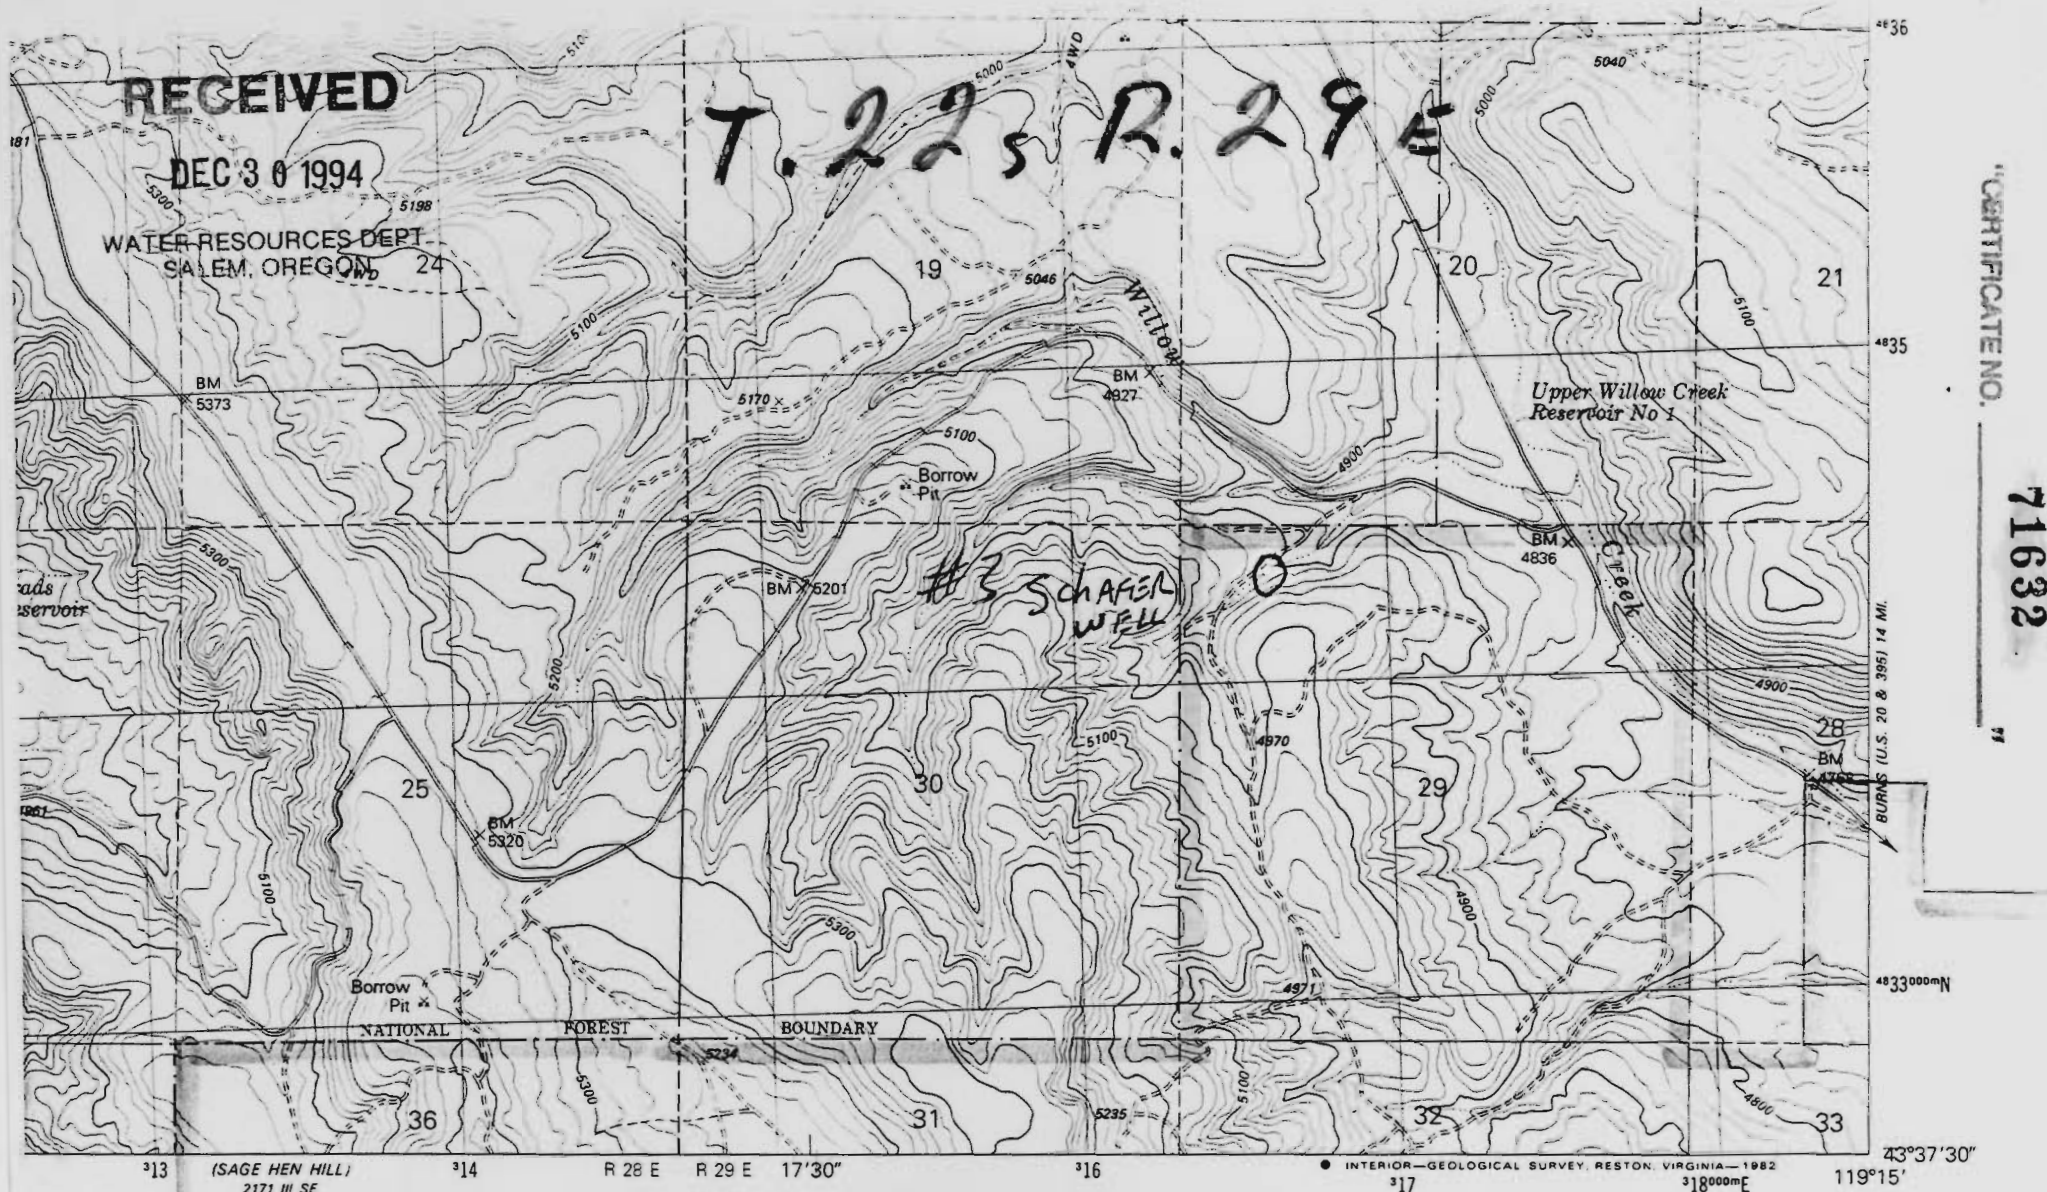

43°37'30"
119°15'

(BURNS 1:62 500)
2171 II

SCALE 1:24 000

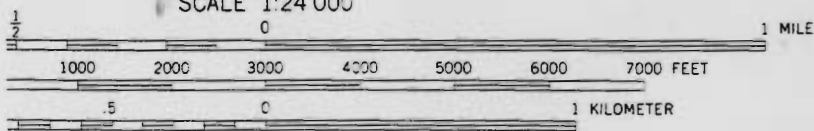

CONTOUR INTERVAL 20 FEET
NATIONAL GEODETIC VERTICAL DATUM OF 1929

HOLMES CANYON, OREG.
N4337.5-W11915/7.5

1981

DMA 2171 II'

S V892

ROAD CLASSIFICATION

ay. Light-duty road, hard or improved surface
rwy. Unimproved road
ate Route U. S. Route State Route

HOLMES CANYON, OREG.
N4337.5-W11915/7.5

1981

Application No. R-79861
Permit No.

MAP COMPILED WITH NATIONAL GEODETIC SURVEY, DENVER, COLORADO 80225, OR RESTON, VIRGINIA 22001
RIPING TOPOGRAPHIC MAPS AND OTHERS, WILLIAMSON, C. O.

CERTIFICATE NO.

UNITED STATES
DEPARTMENT OF THE INTERIOR
GEOLOGICAL SURVEY

By This Road **Application No.** R-79861
S **Permit No.**
INTERIOR #2

RECEIVED


DEC 30 1994

WATER RESOURCES DEPT.
SALEM, OREGON

T. 22 S. R. 29³ E.

BURNS BUTTE, OREGON
PROVISIONAL EDITION 1990

43119-E2-TF-024

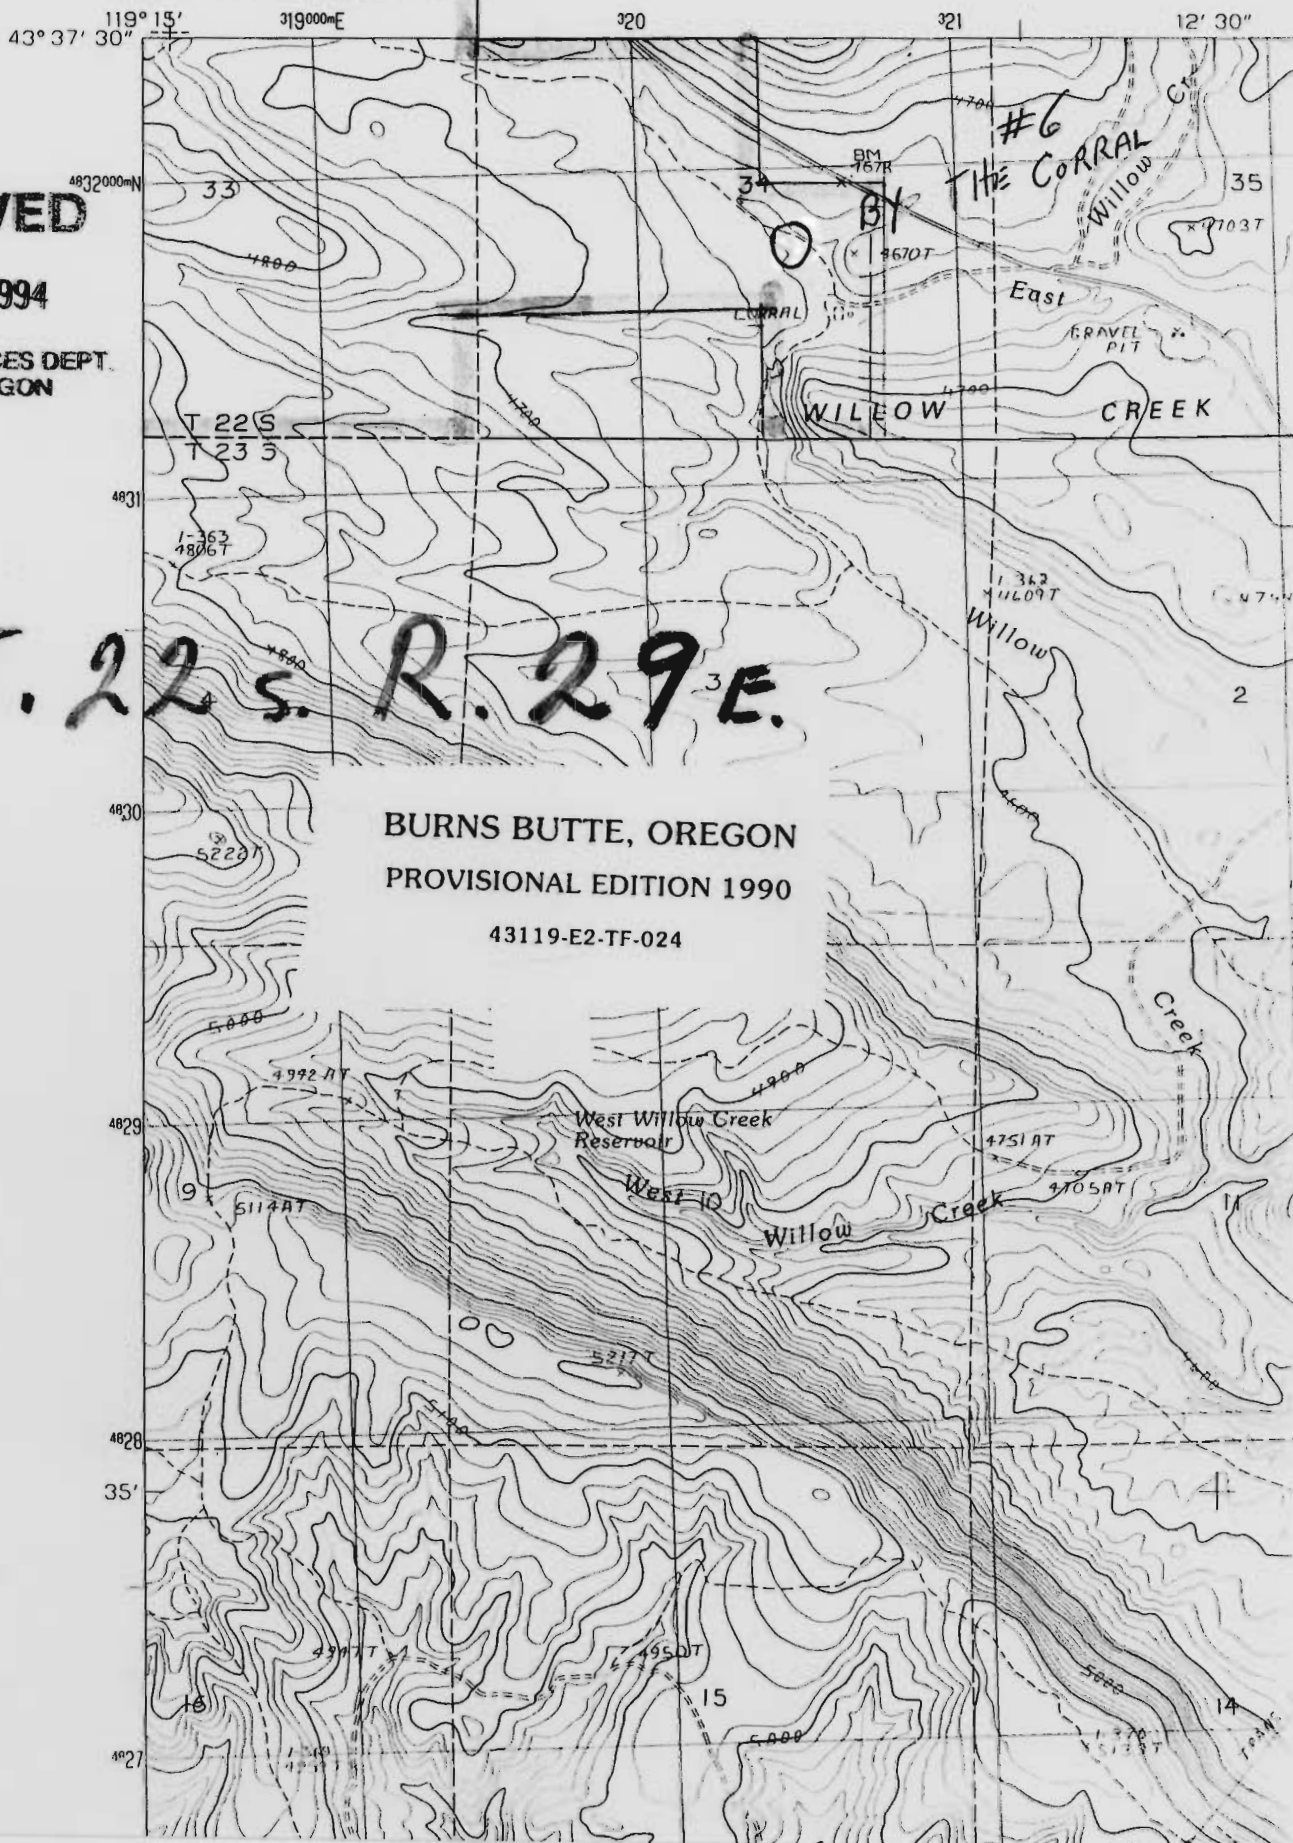

RECEIVED

DEC 30 1994

CERTIFICATE NO.

71832

Application No. R. 79841

SAGE HEN HILL QUADRANGLE
OREGON HARNEY CO.

7.5 MINUTE SERIES (TOPOGRAPHIC)

2171 III
(BURNS 1:62,500)

T. 22 S. R. 29 E.

WATER RESOURCES DEPT
SALEM, OREGON

