


SCALE 1:9600

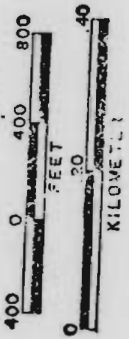


CERTIFICATE NO.

71636

SCALE 1" = 400'

SEE MAP NO. 6 5 2

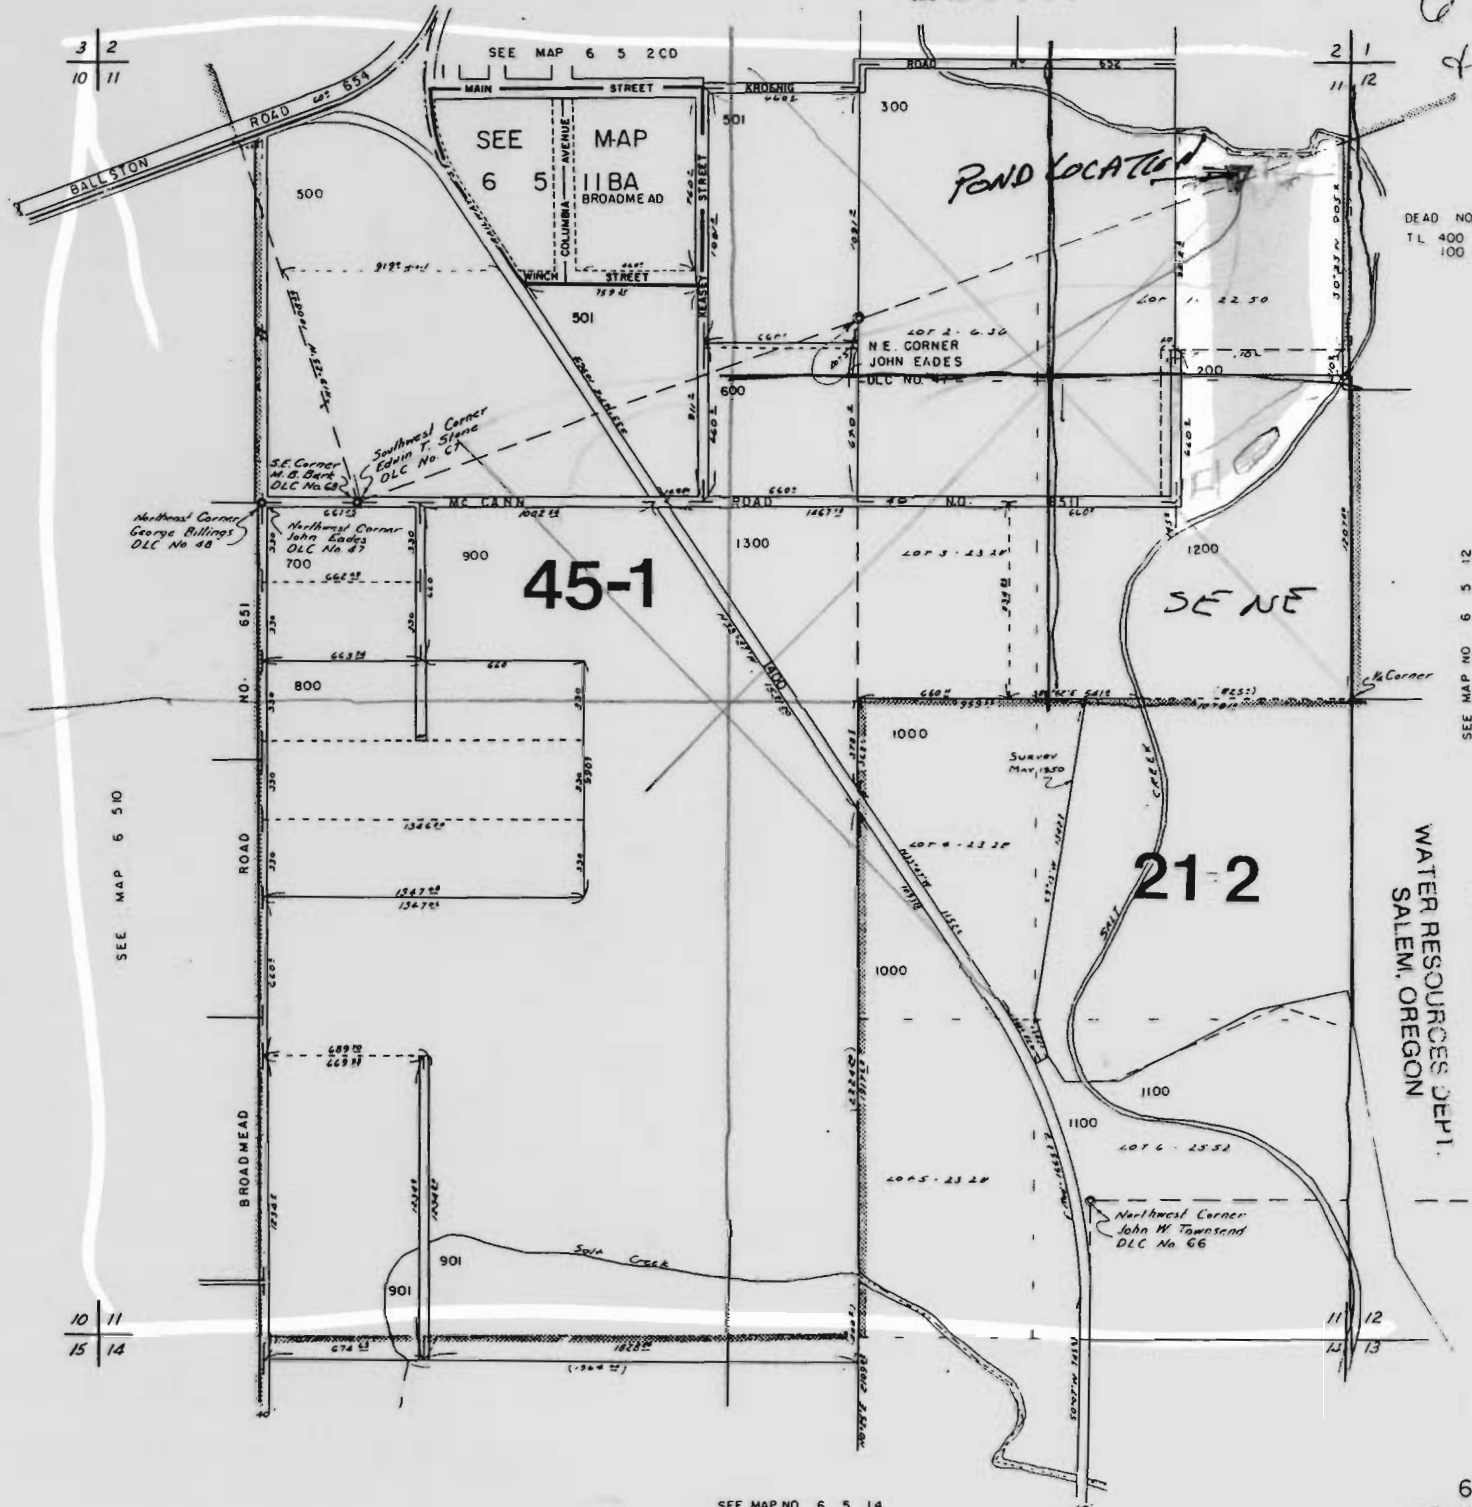

SEE MAP NO 6 5 14

6 5 11
& INDEX