

SILVER FALLS DR SE STATE

1442
466000
ARV

RECEIVED

DEC 29 1994


WATER RESOURCES DEPT.
SALEM, OREGON

Map 36
R-57361
MC-8260

APPLICATION FOR
WATER RIGHT
MILDRED KASER
TAX LOT 700, PORTION OF
SE4 NW4 SEC 35, T7S, R1EWM
MARION COUNTY, OREGON
EXISTING POND, BUILT ~ 1950
12-26-94 SVK

ROAD SE
N64 68W

SEE MAP 07 IE 35A

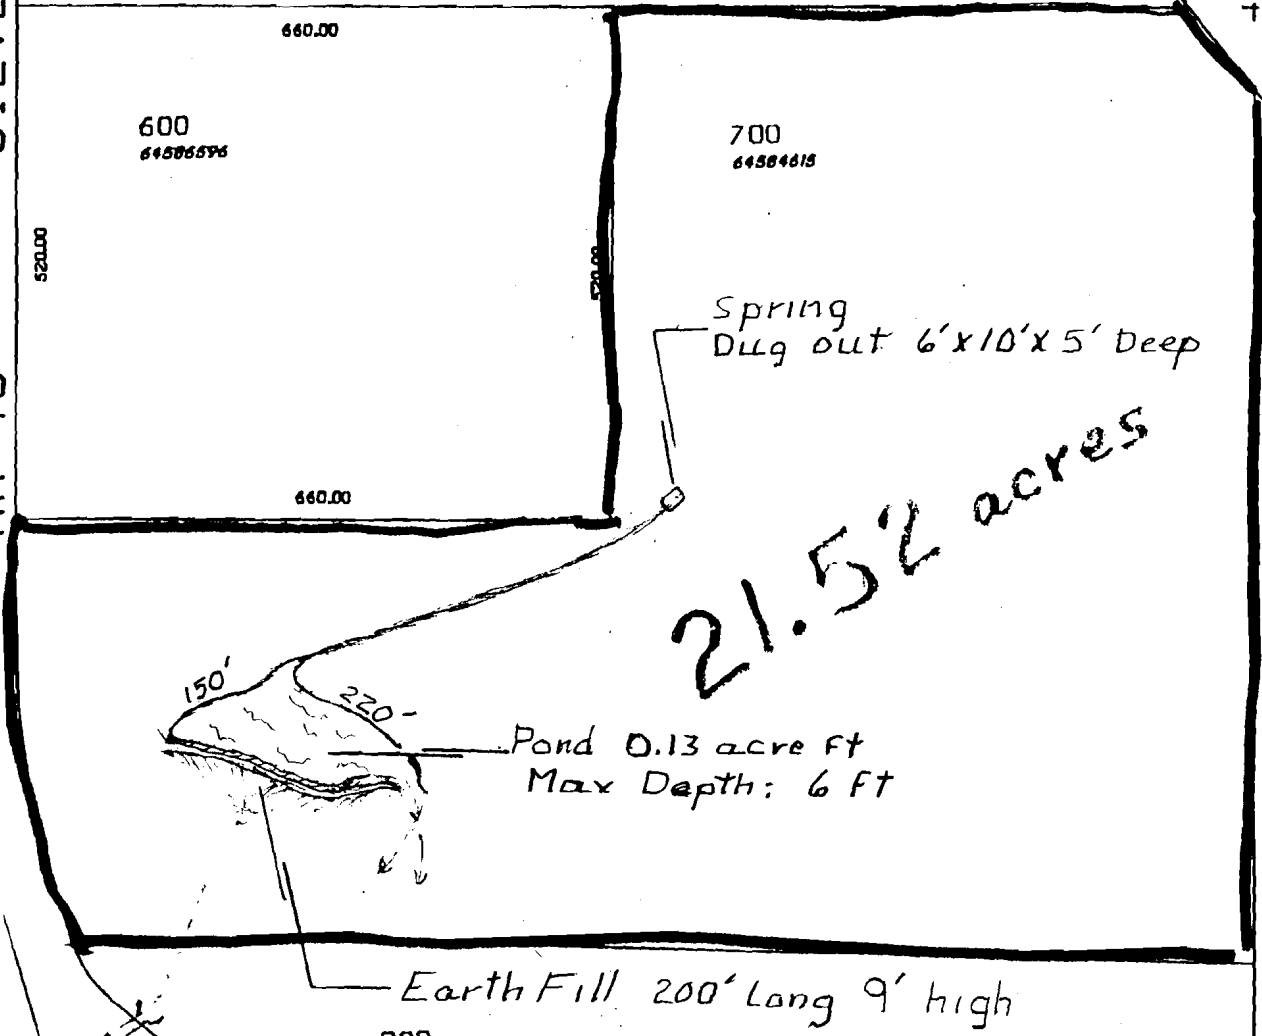

21.52 acres

Application No. R 79870
Permit No.

800
64580001

WINTER

