

RECEIVED

Application No. R-79874

Parcel No.

MOUNT ANGEL ABBEY TREE FARM
MARION COUNTY, OREGON


77912

LEGEND:


- Rock Road
- Dirt Road
- GATE
- Stream

-
-
-
-

SCALE:
1" = 2000 Ft.

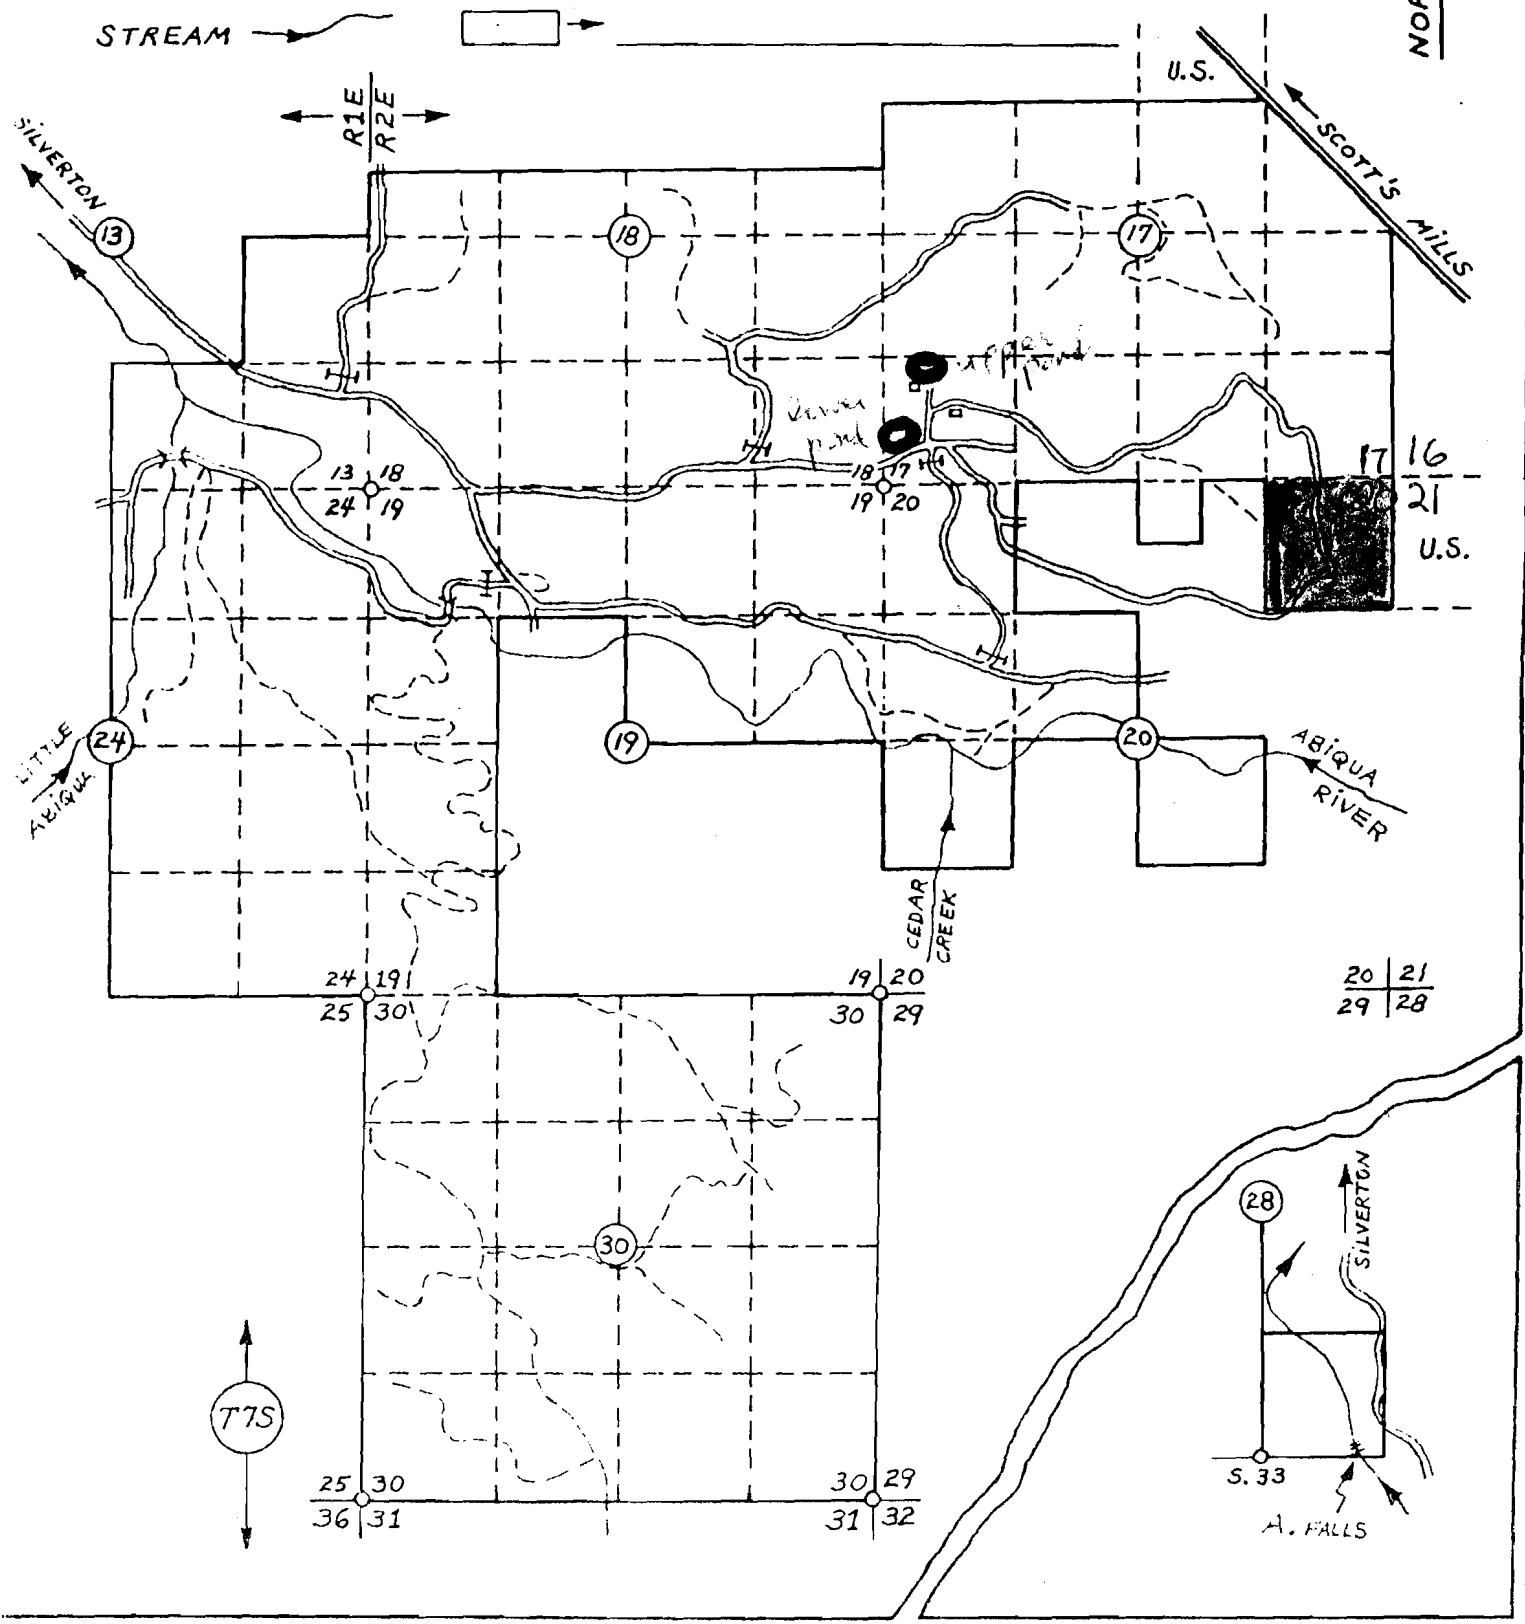

Description of Area in Red
40 Acres i.e. NE $\frac{1}{4}$ NE $\frac{1}{4}$ Sec 20 T7S R2E
that is the NE 40 of the NE quarter ($\frac{1}{4}$)
of Section 20 R2E T7S W.M.

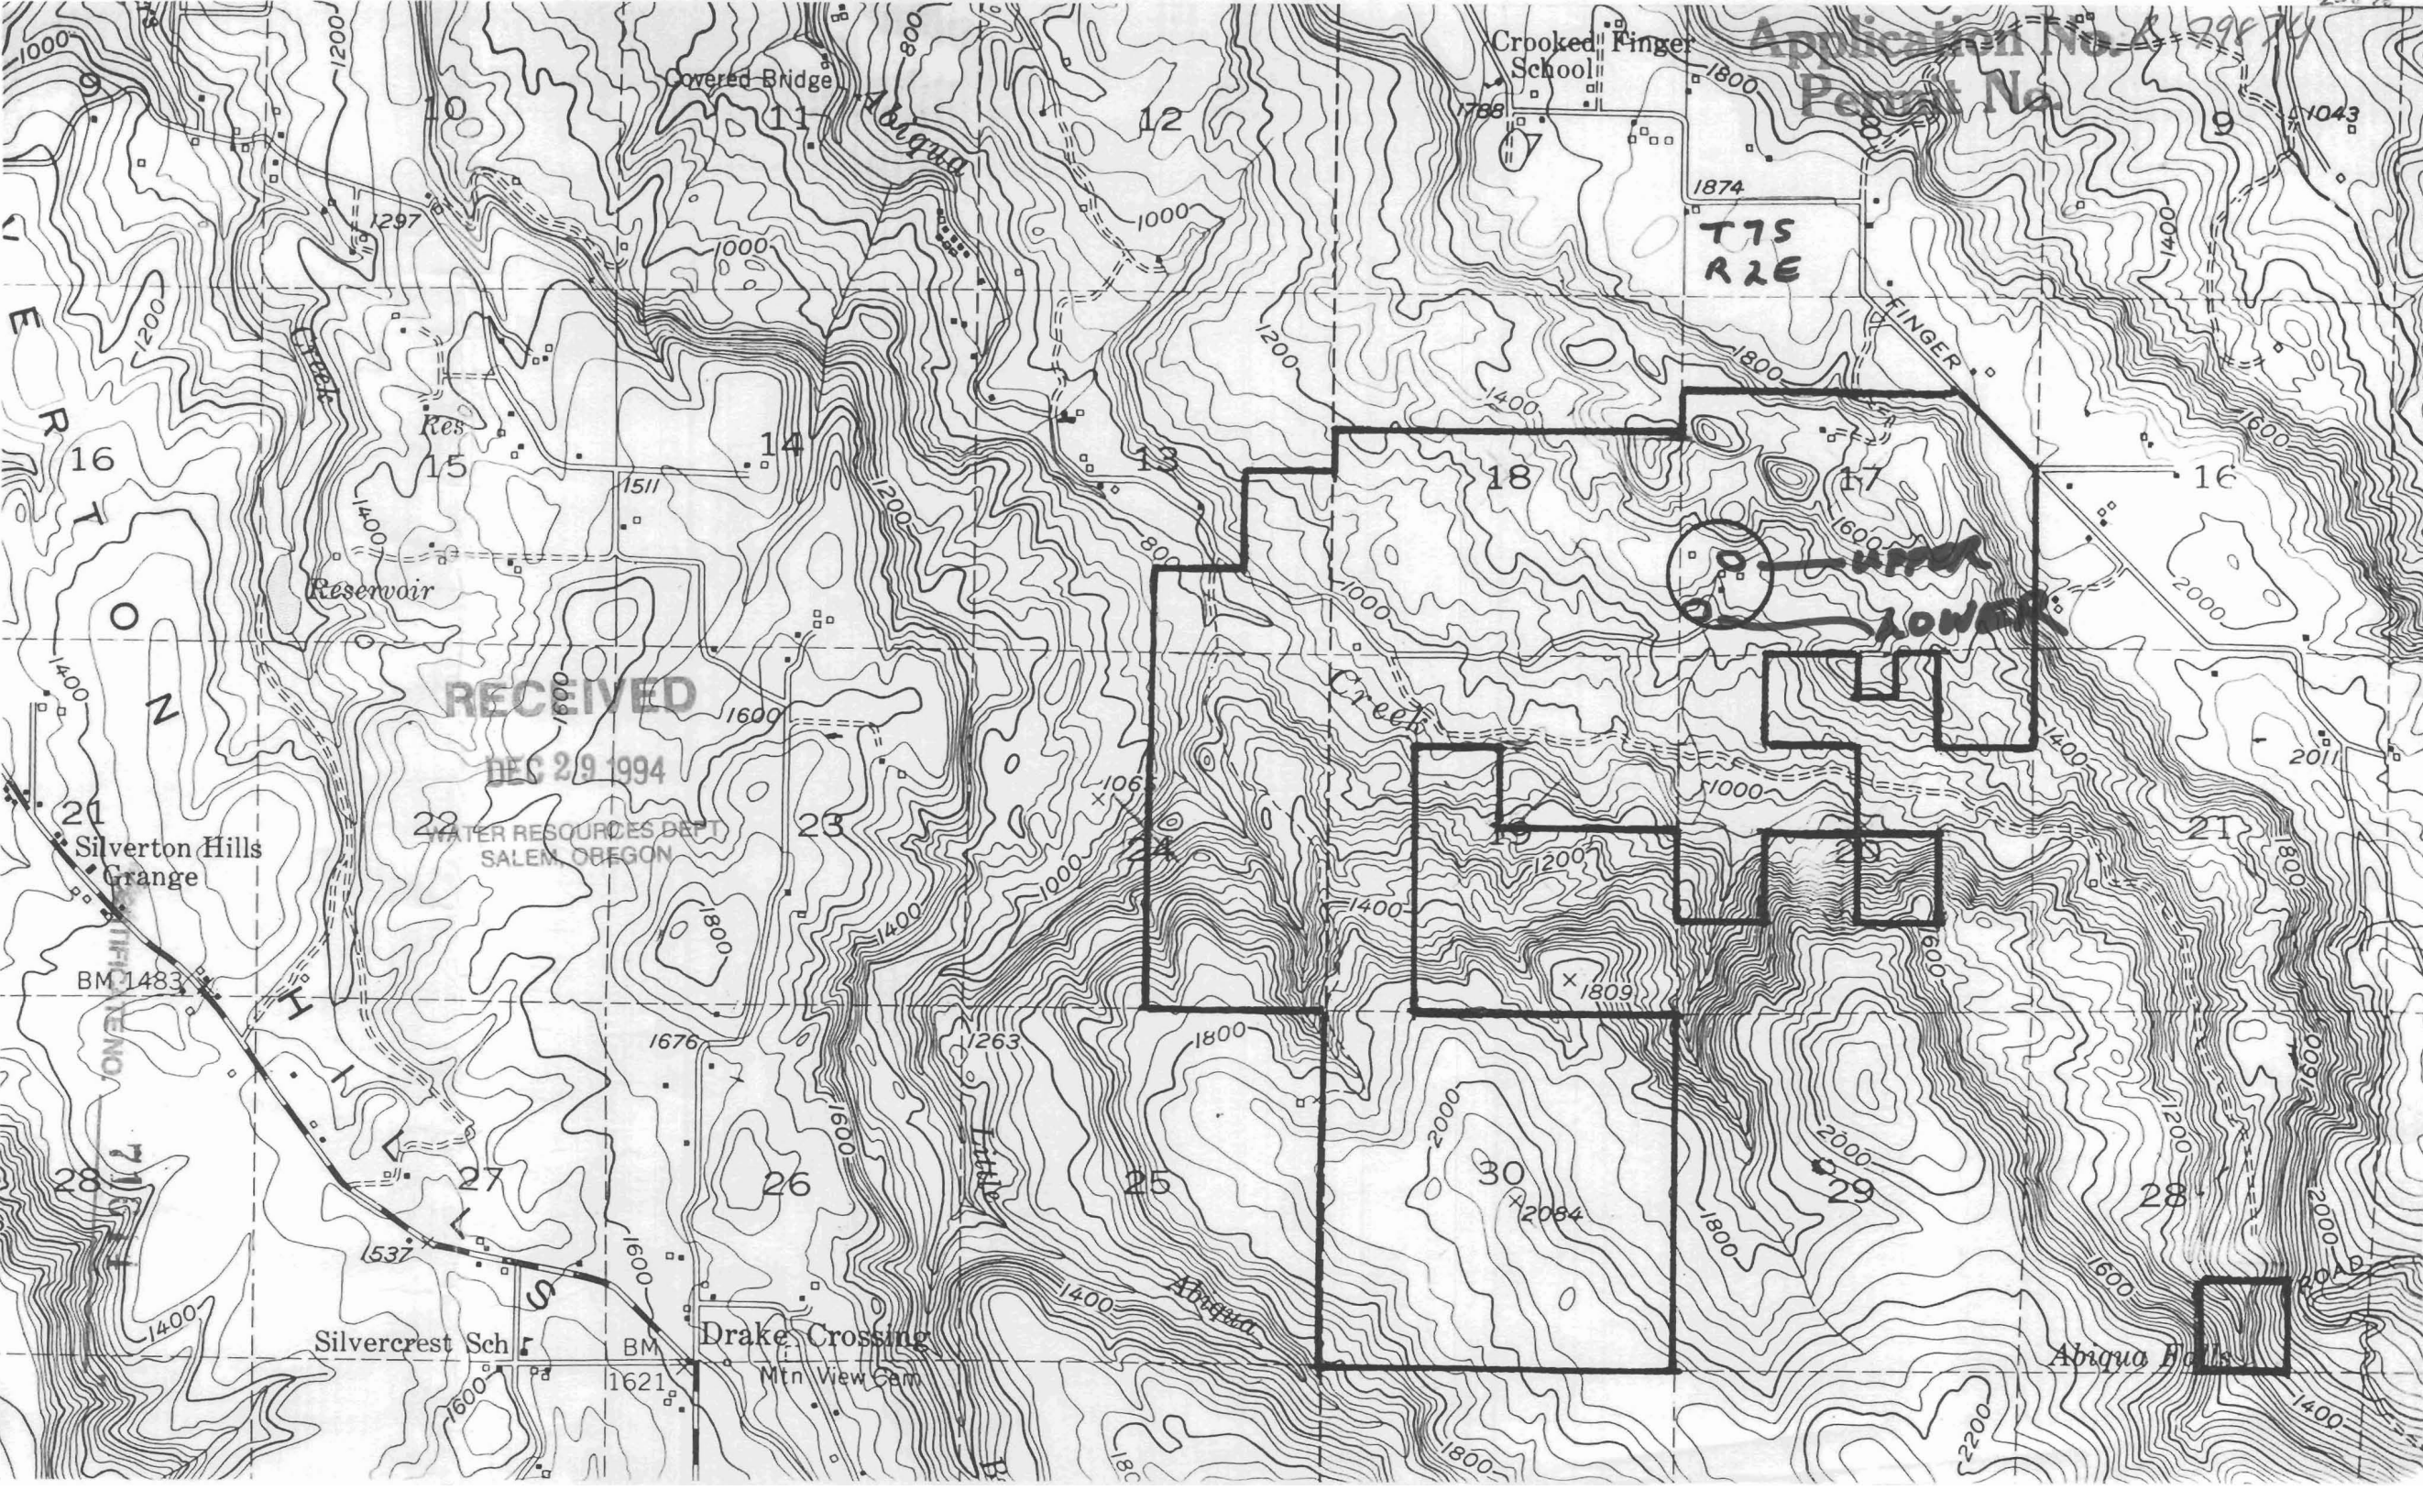

Application No. 8-298 JK
Permit No.

T75
R2E

RECEIVED
DEC 29 1994
WATER RESOURCES DEPT
SALEM, OREGON

UPPER
LOWER

Abiqua Falls