
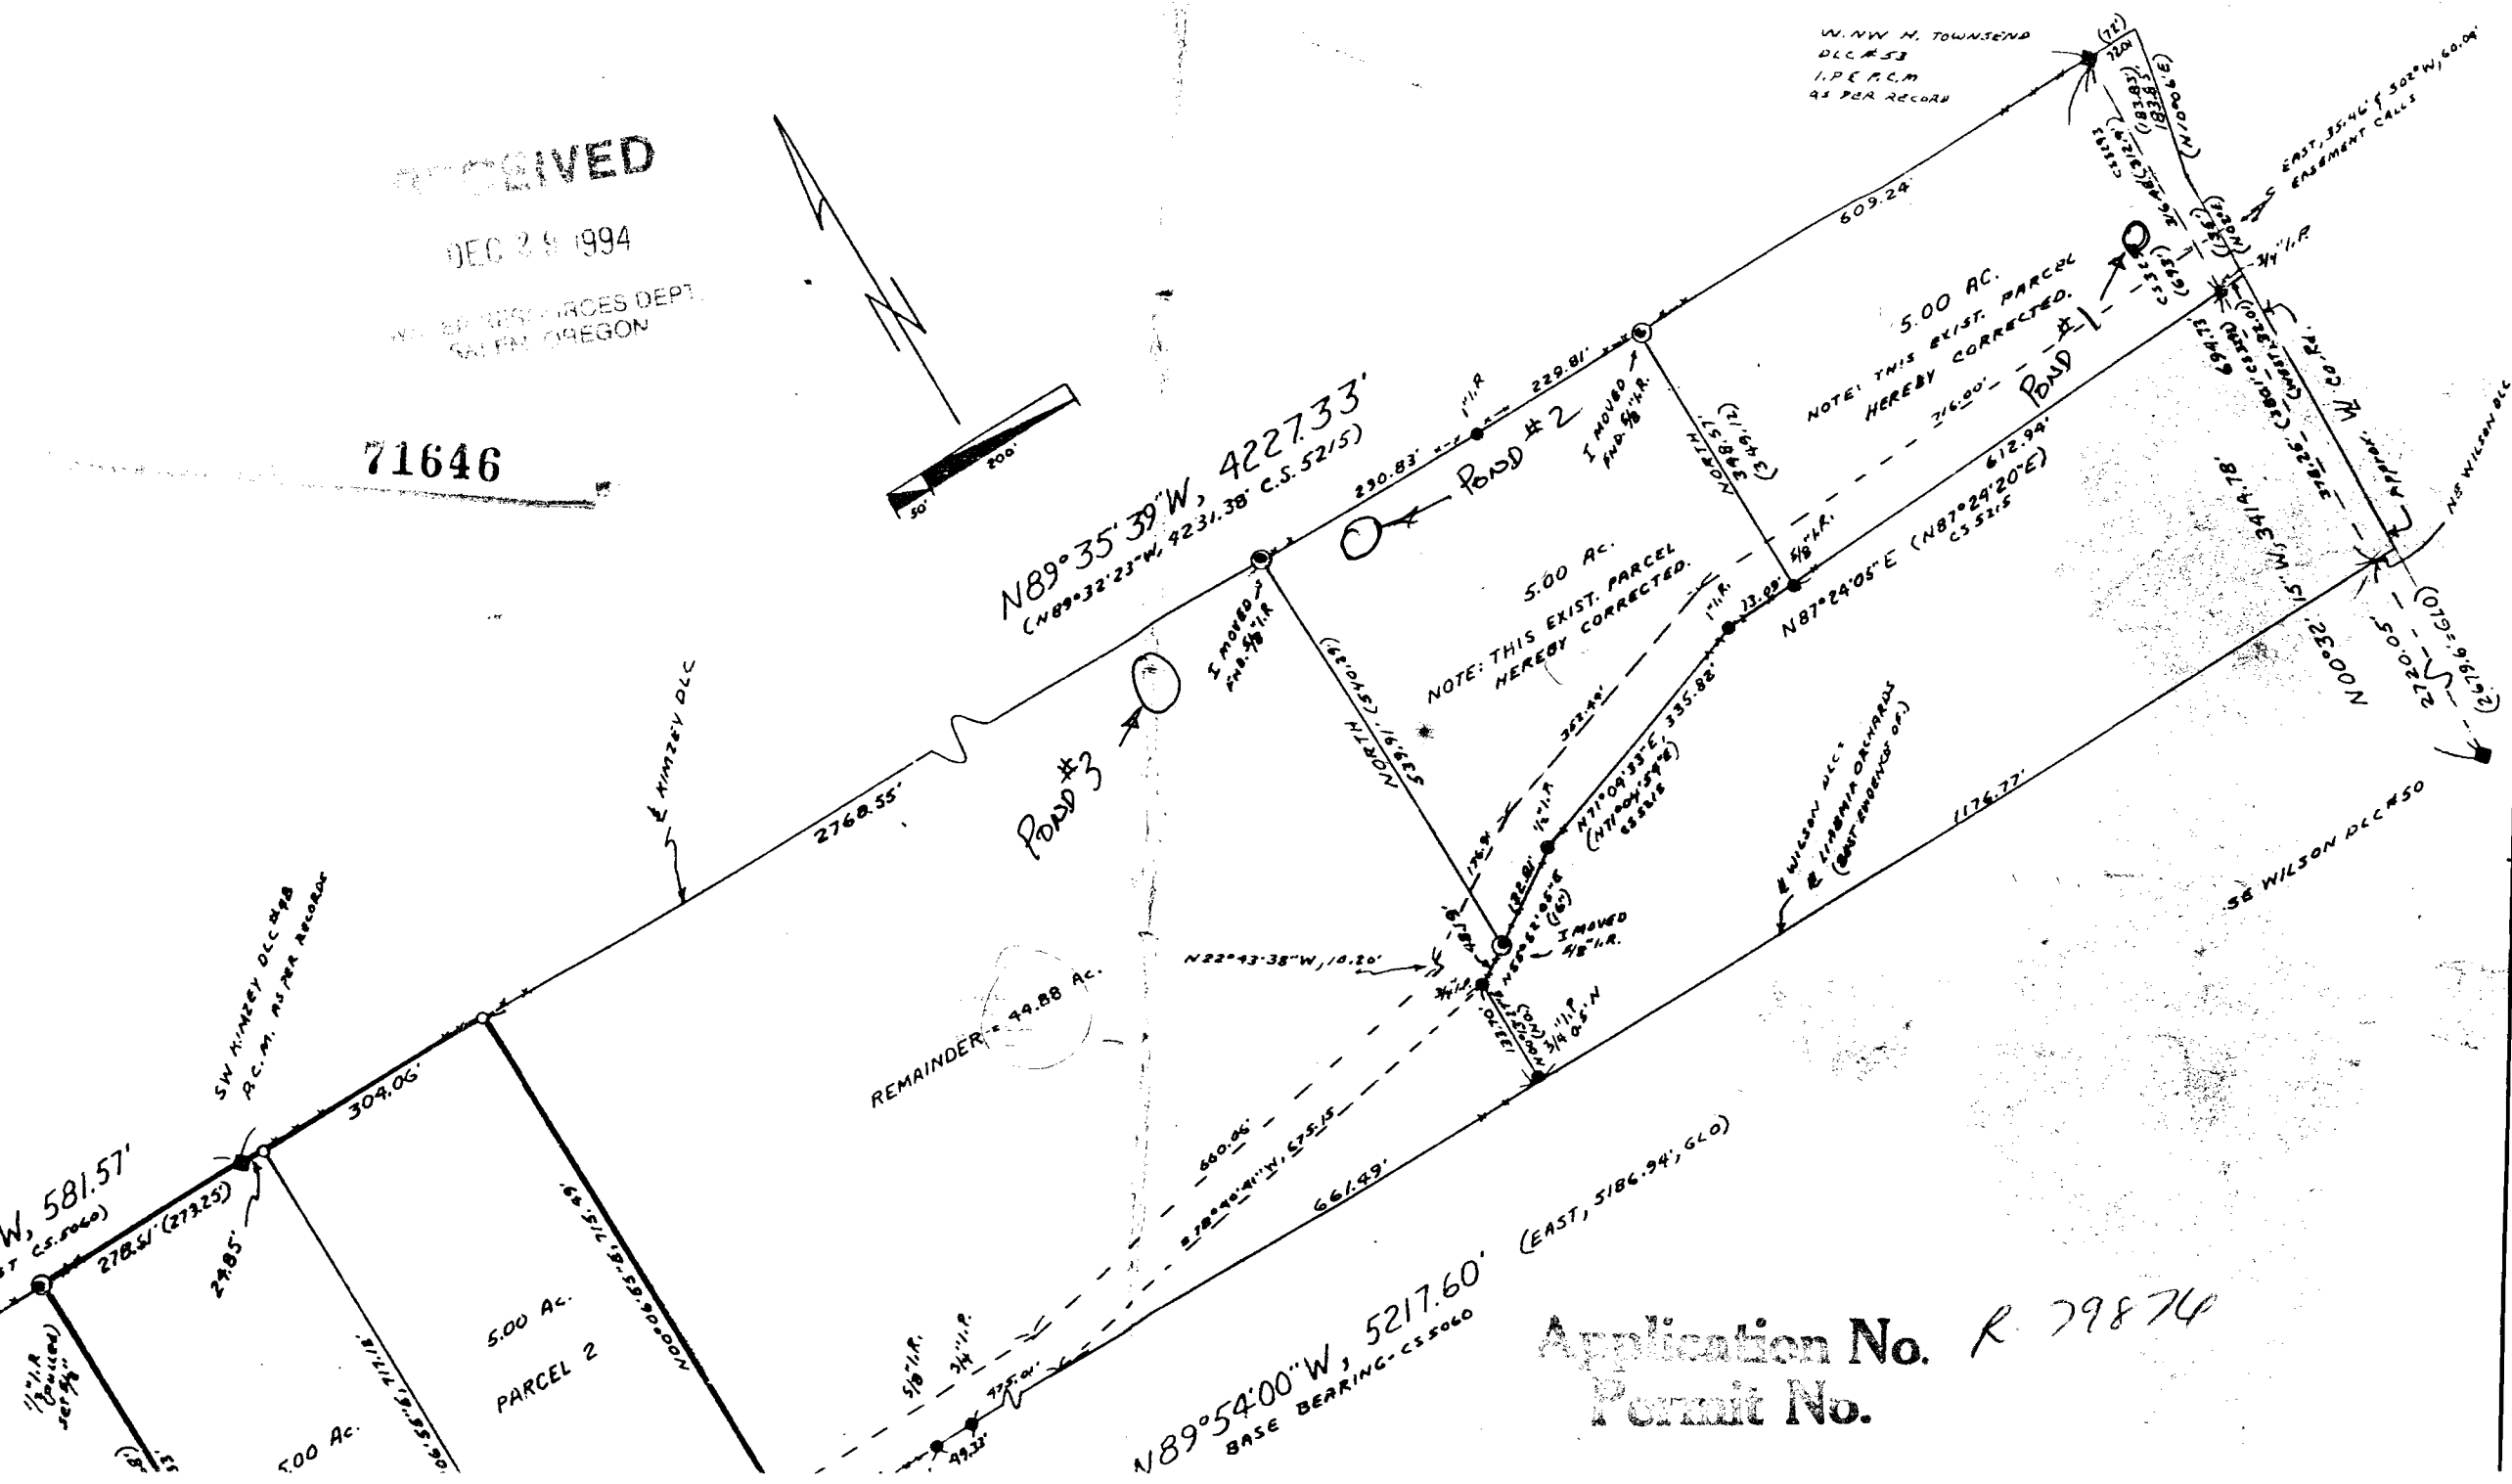


RECEIVED

DEC 29 1994


71646

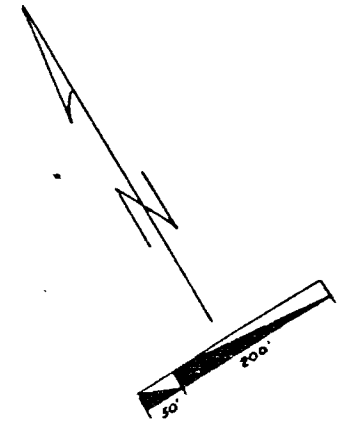

N89°54'00\"W, 5217.60'  
BASE BEARING-SS5060 (EAST, 5186.94', 610)

Application No. R. 79874  
Permit No.