


RECEIVED

DEC 29 1994

WATER RESOURCES DEPT.
SALEM, OREGON

Application No. R 79879
Permit No.

CERTIFICATE NO. 71649

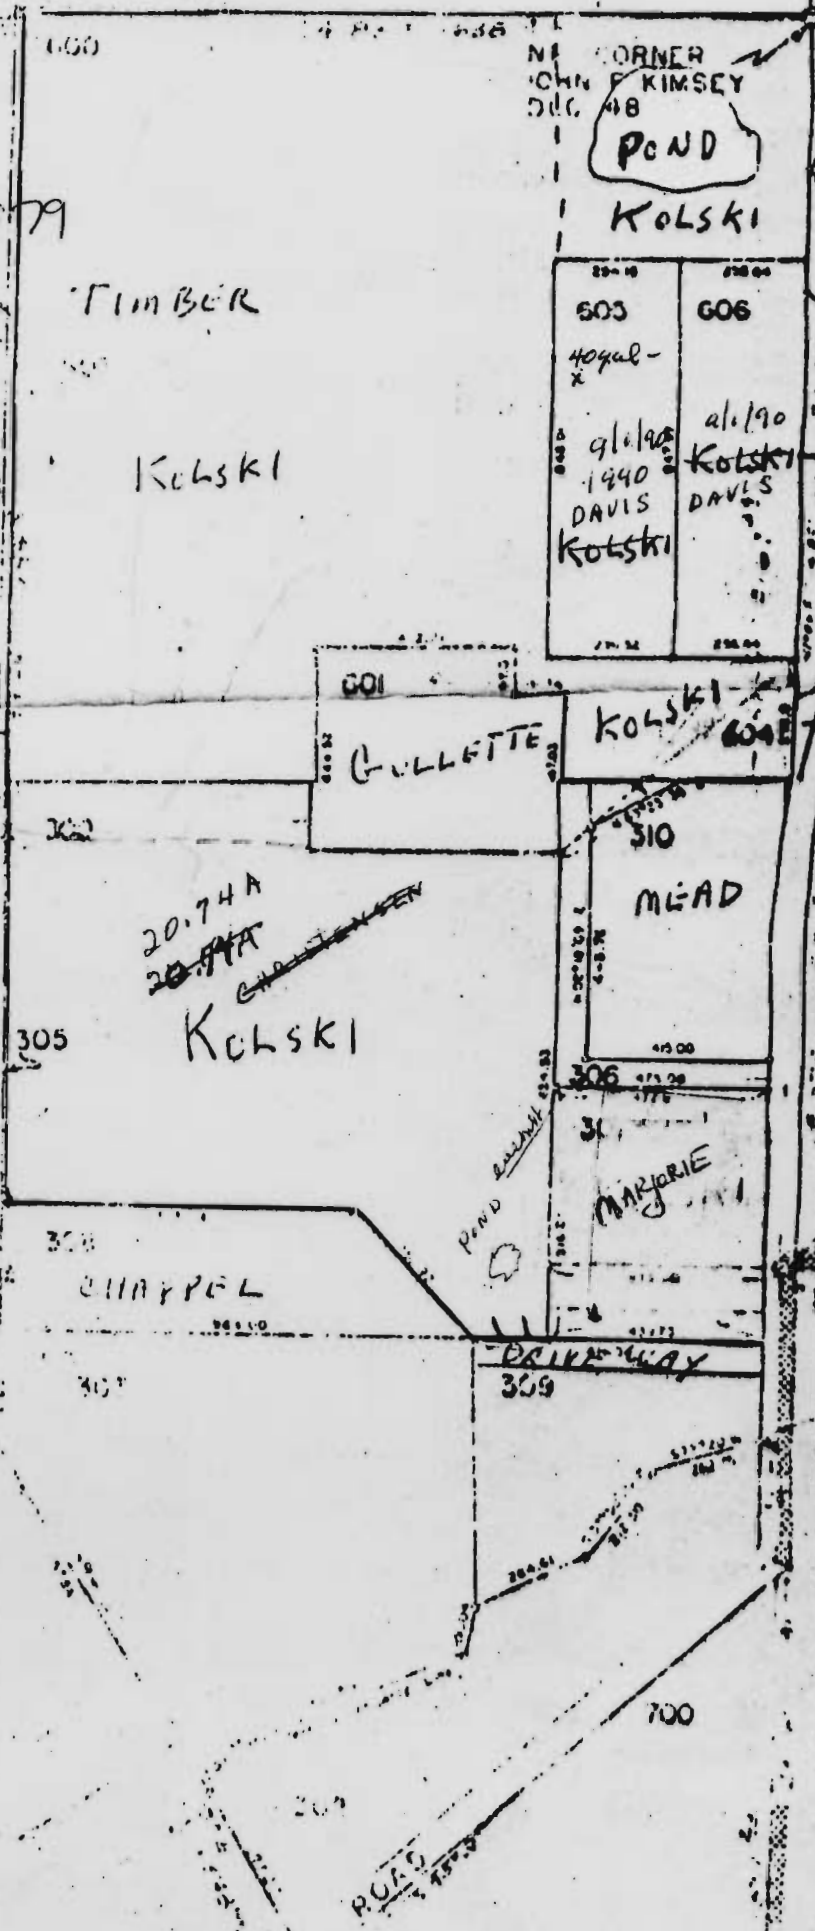

28

ROAD

700

SW 1/4

NE 1/4

SE 1/4

NW 1/4

SW 1/4

NE 1/4

SE 1/4

NW 1/4

SW 1/4

NE 1/4