


55 R27E

MORROW COUNTY

1 - 2000'

SEE MAP 4S 27

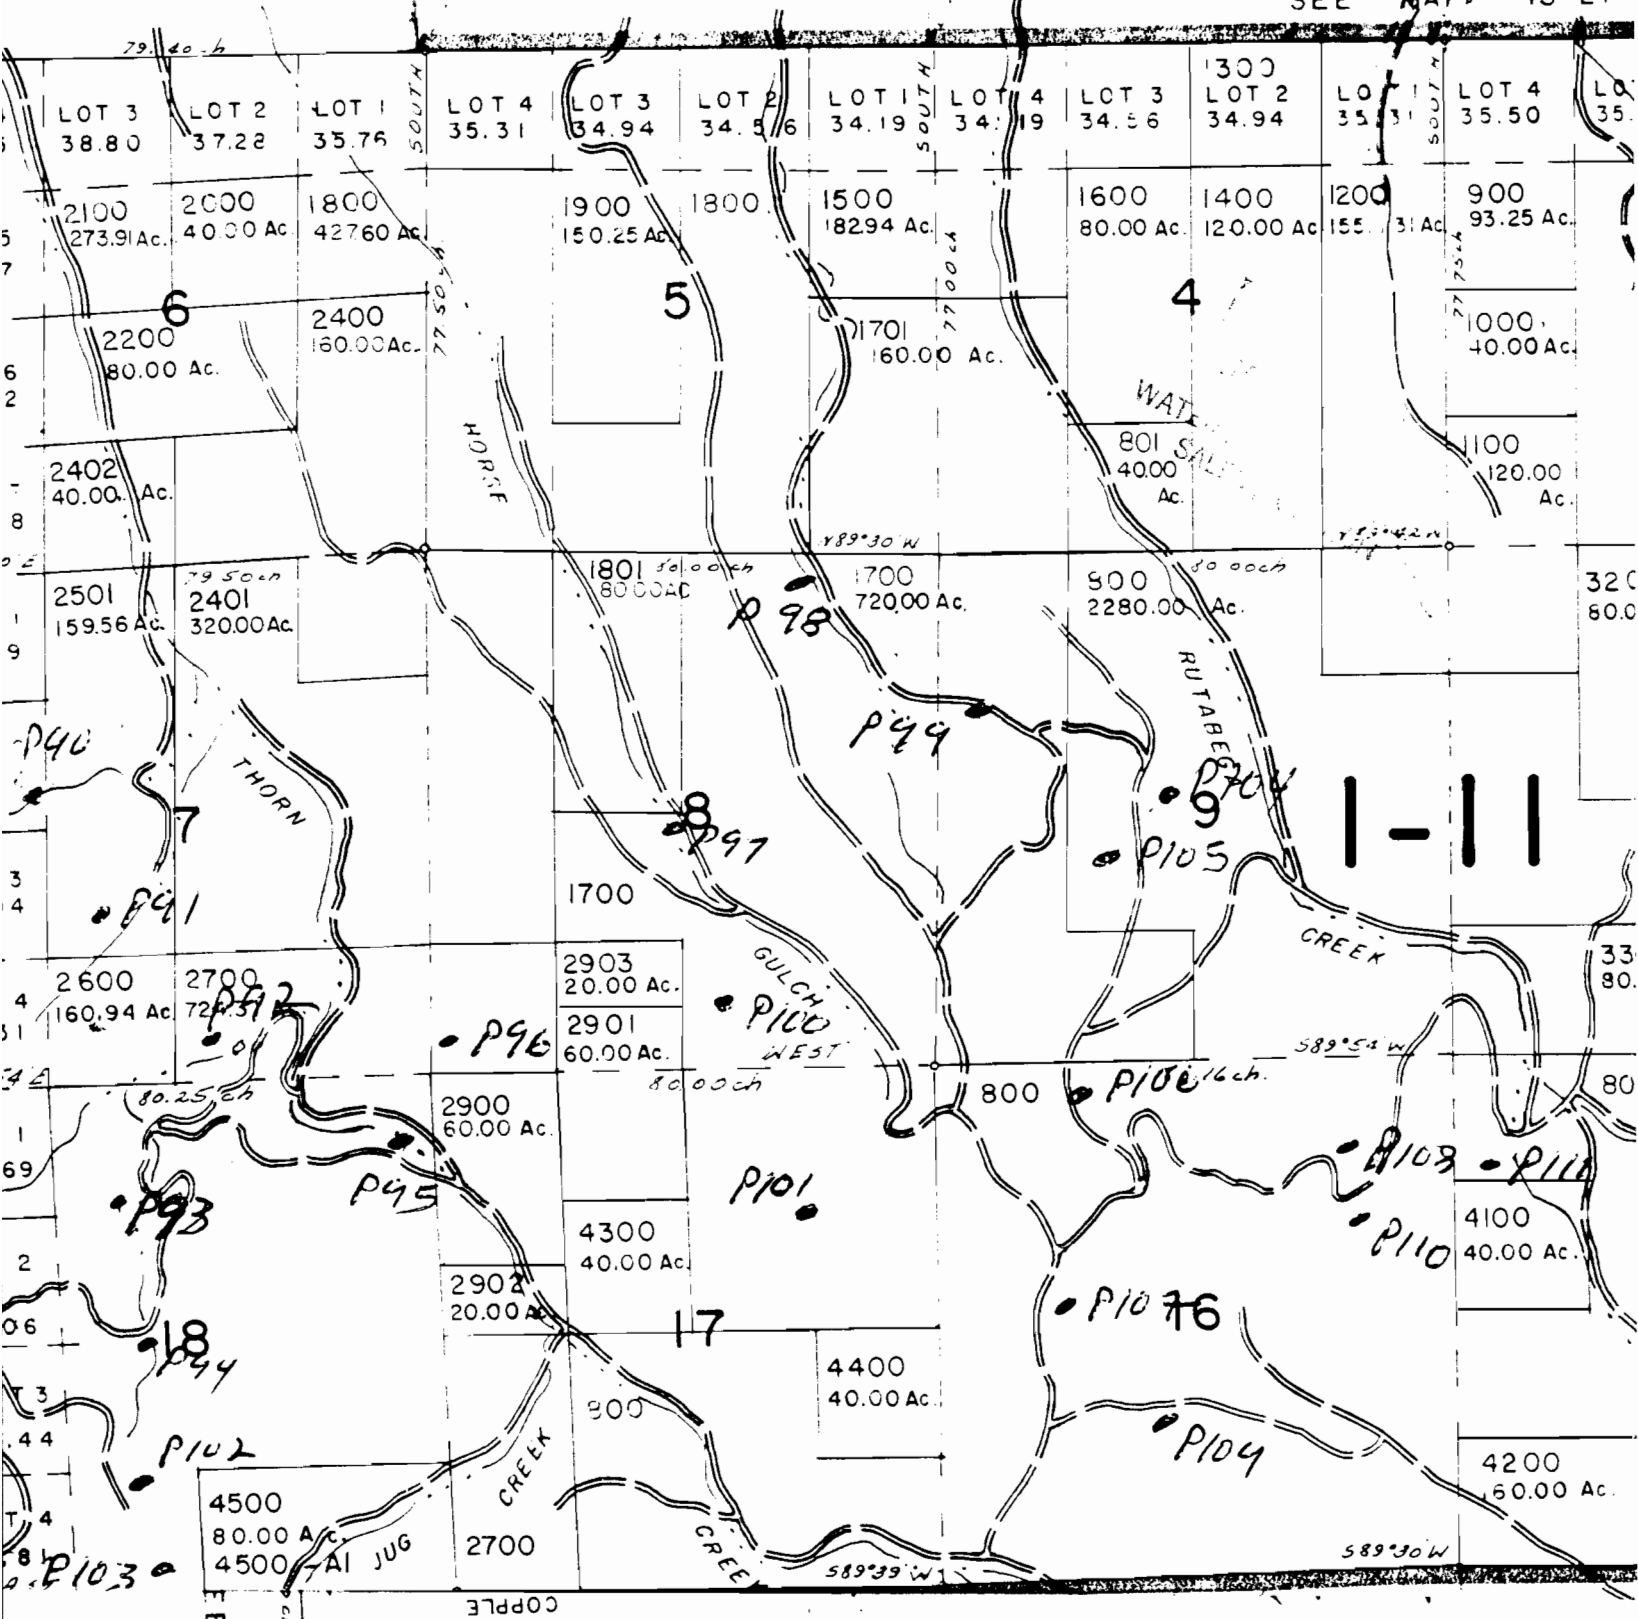

Application No. R. 79886
 Permit No.

71656