



65 R 26 E

~~71-80~~

Application No. R79889
Permit No. 71659

WATER RESOURCES DIVISION
SALEM, OREGON

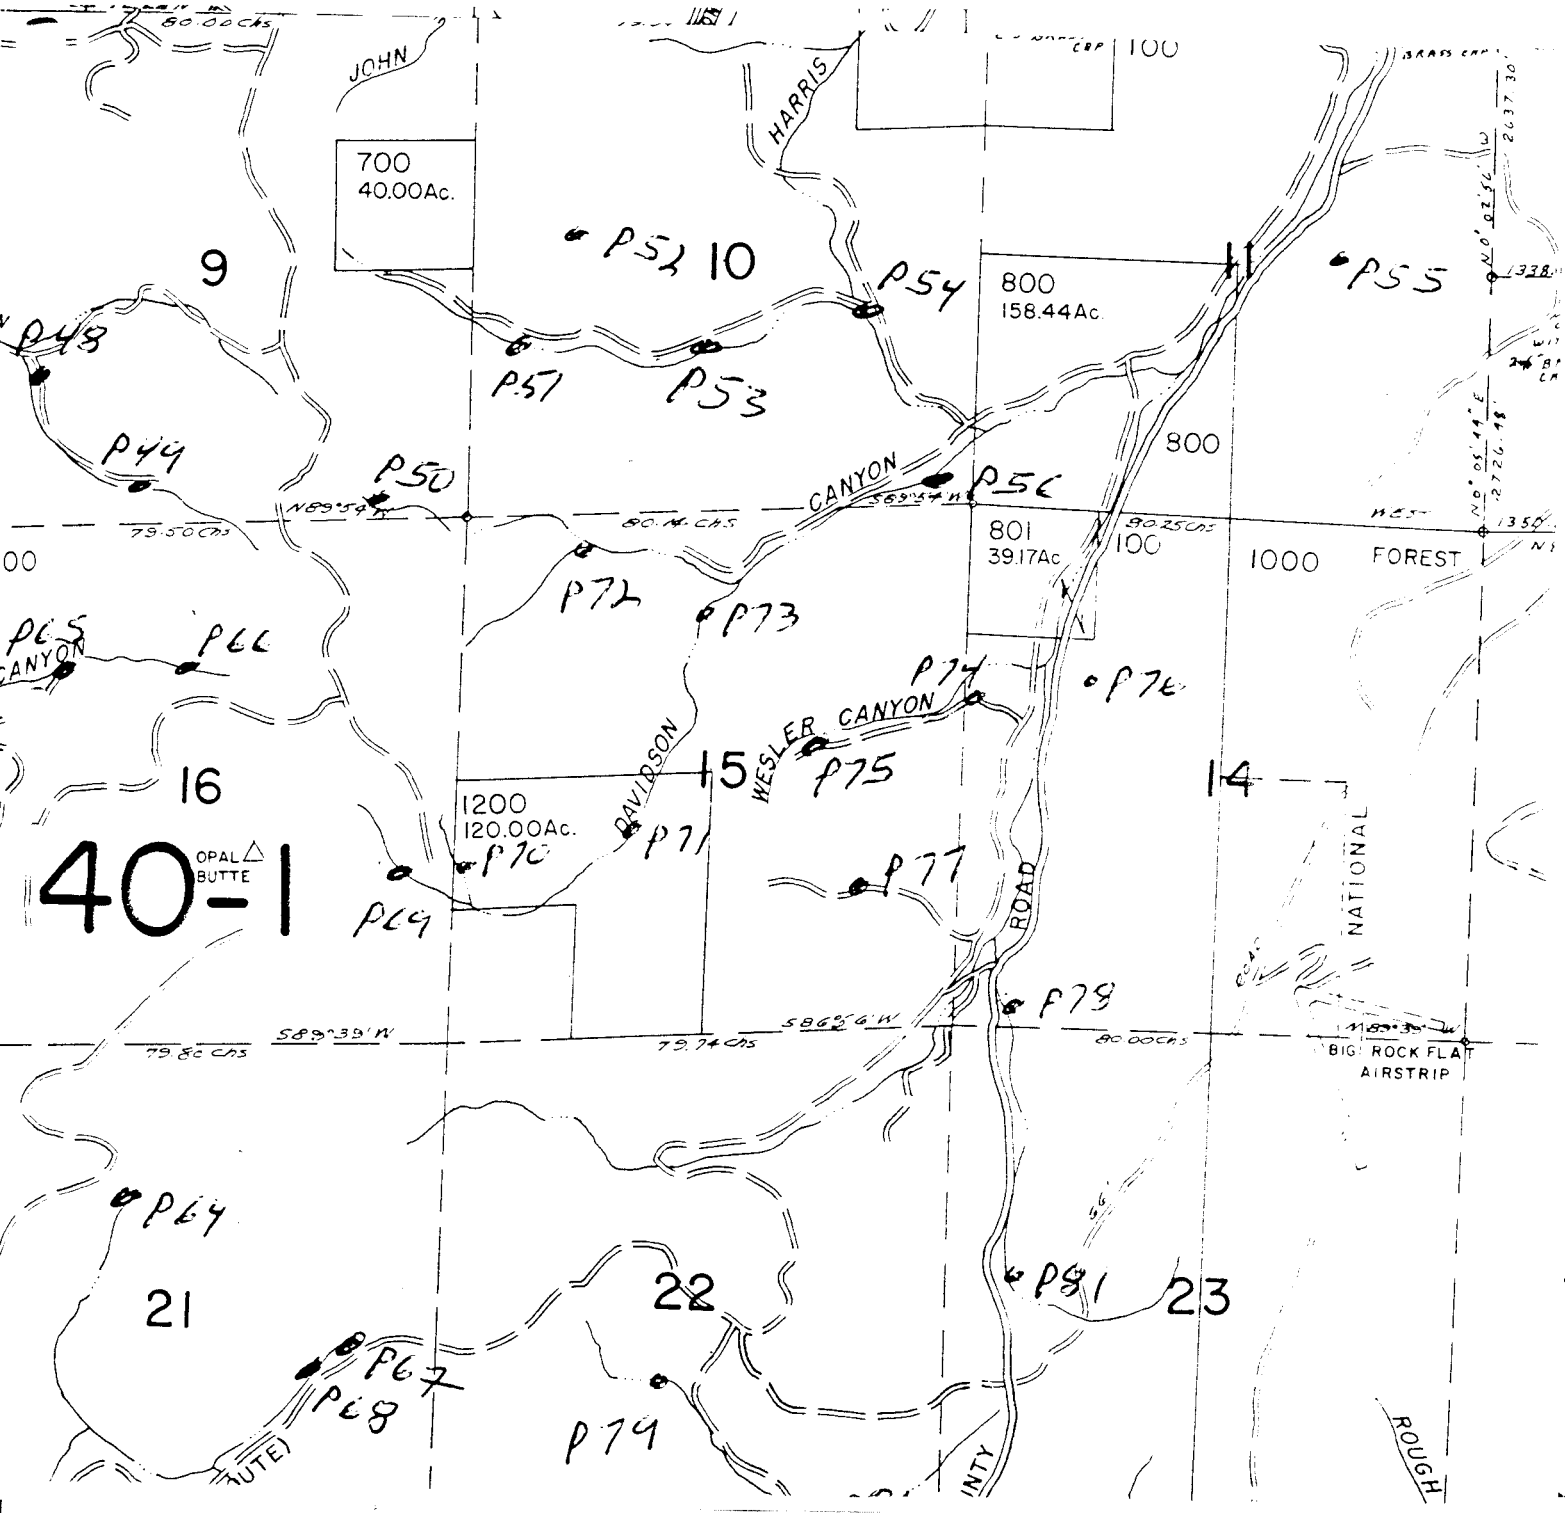

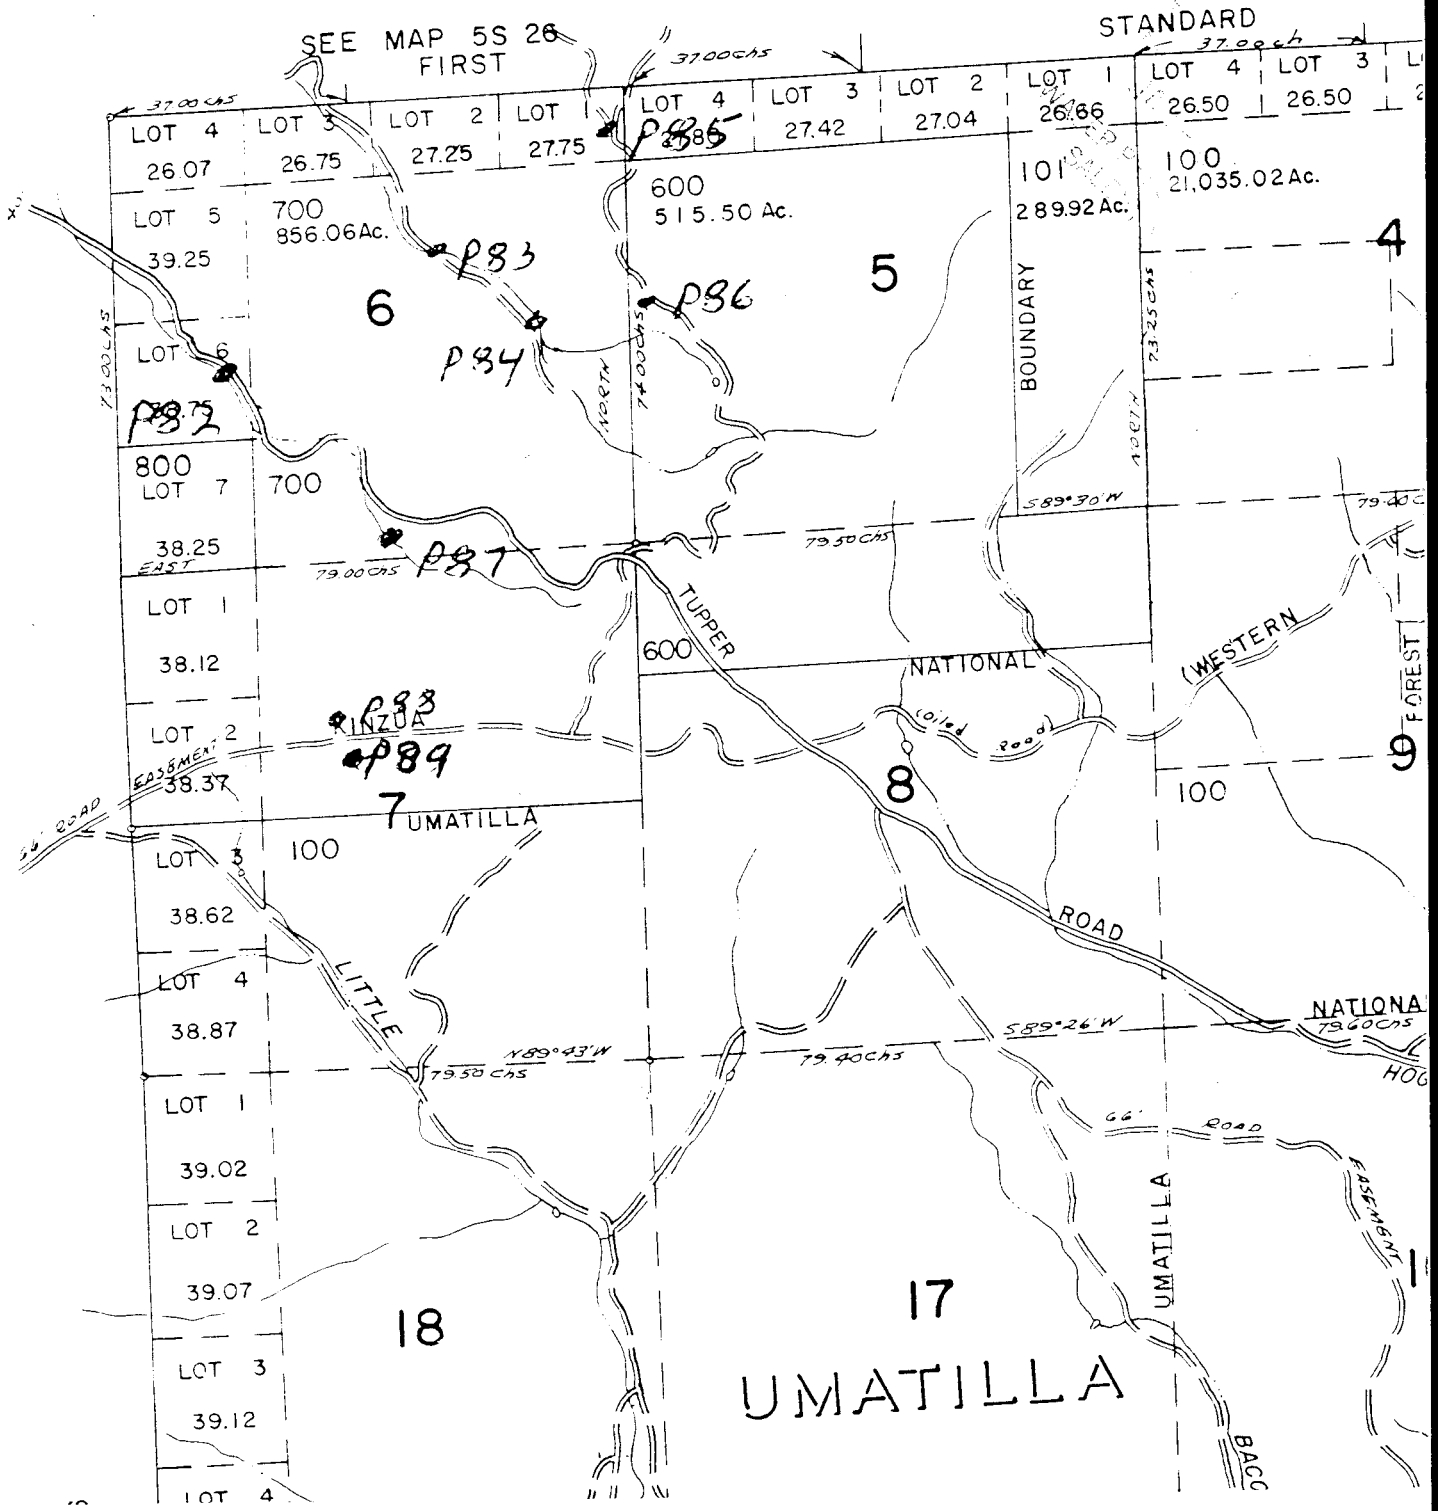

Application No. R. 79889
 Permit No.

71659