


JAN - 4 1935  
SOURCES D  
SOURCES D

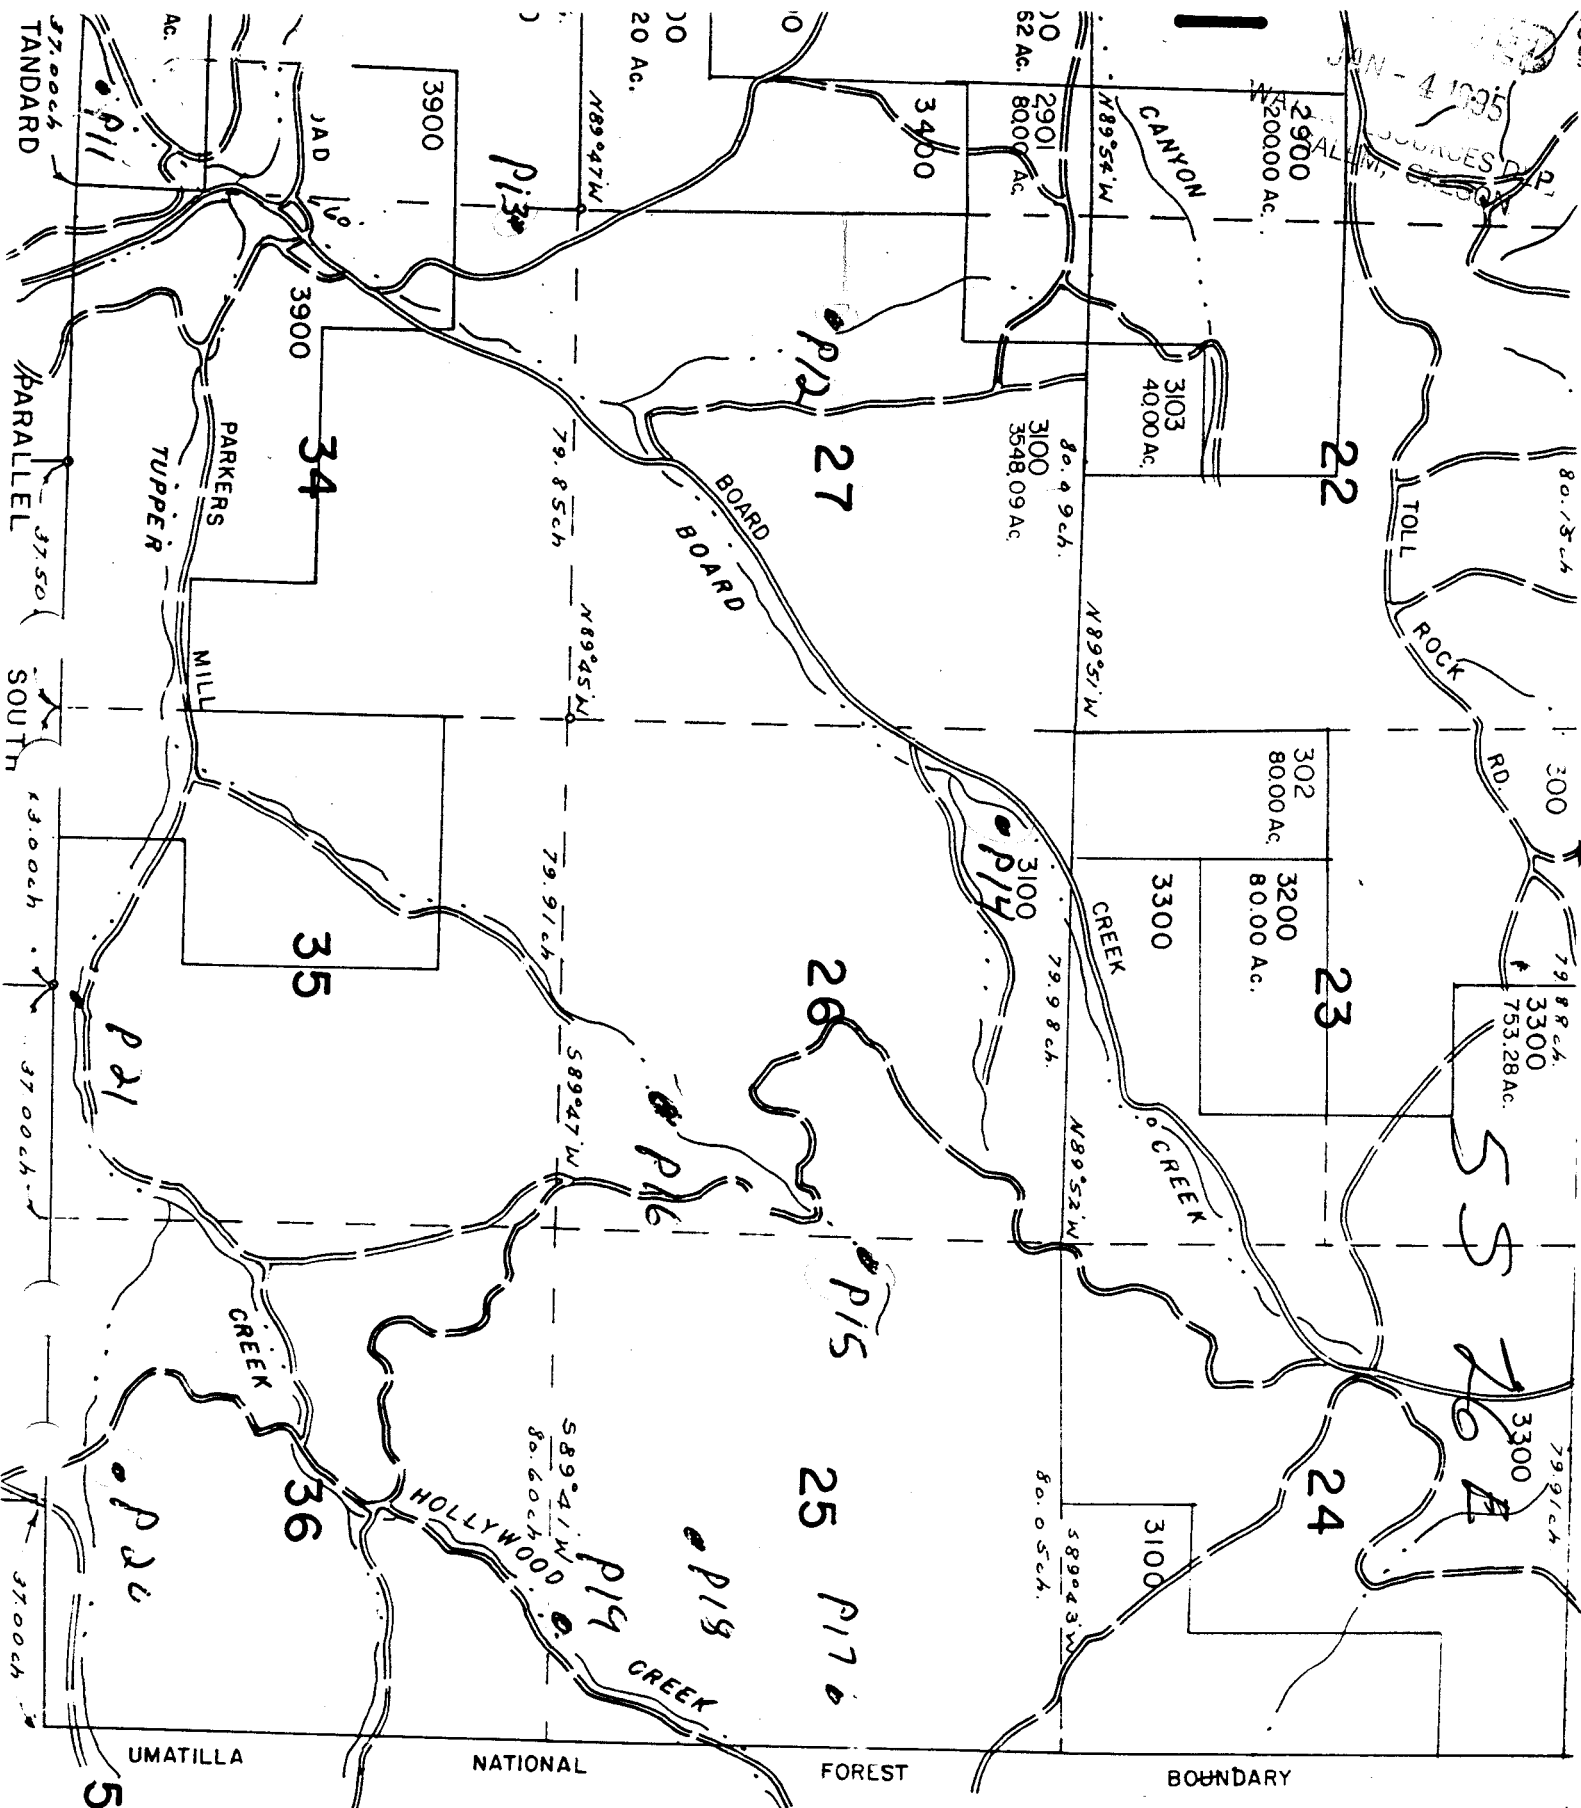

SEE MAP

Application No. R. 79894  
Permit No.

55 26 8  
INDEX