


REG
FEB
VED
1993
ALL OR CASH
ASSISTANCE

WAT JAN


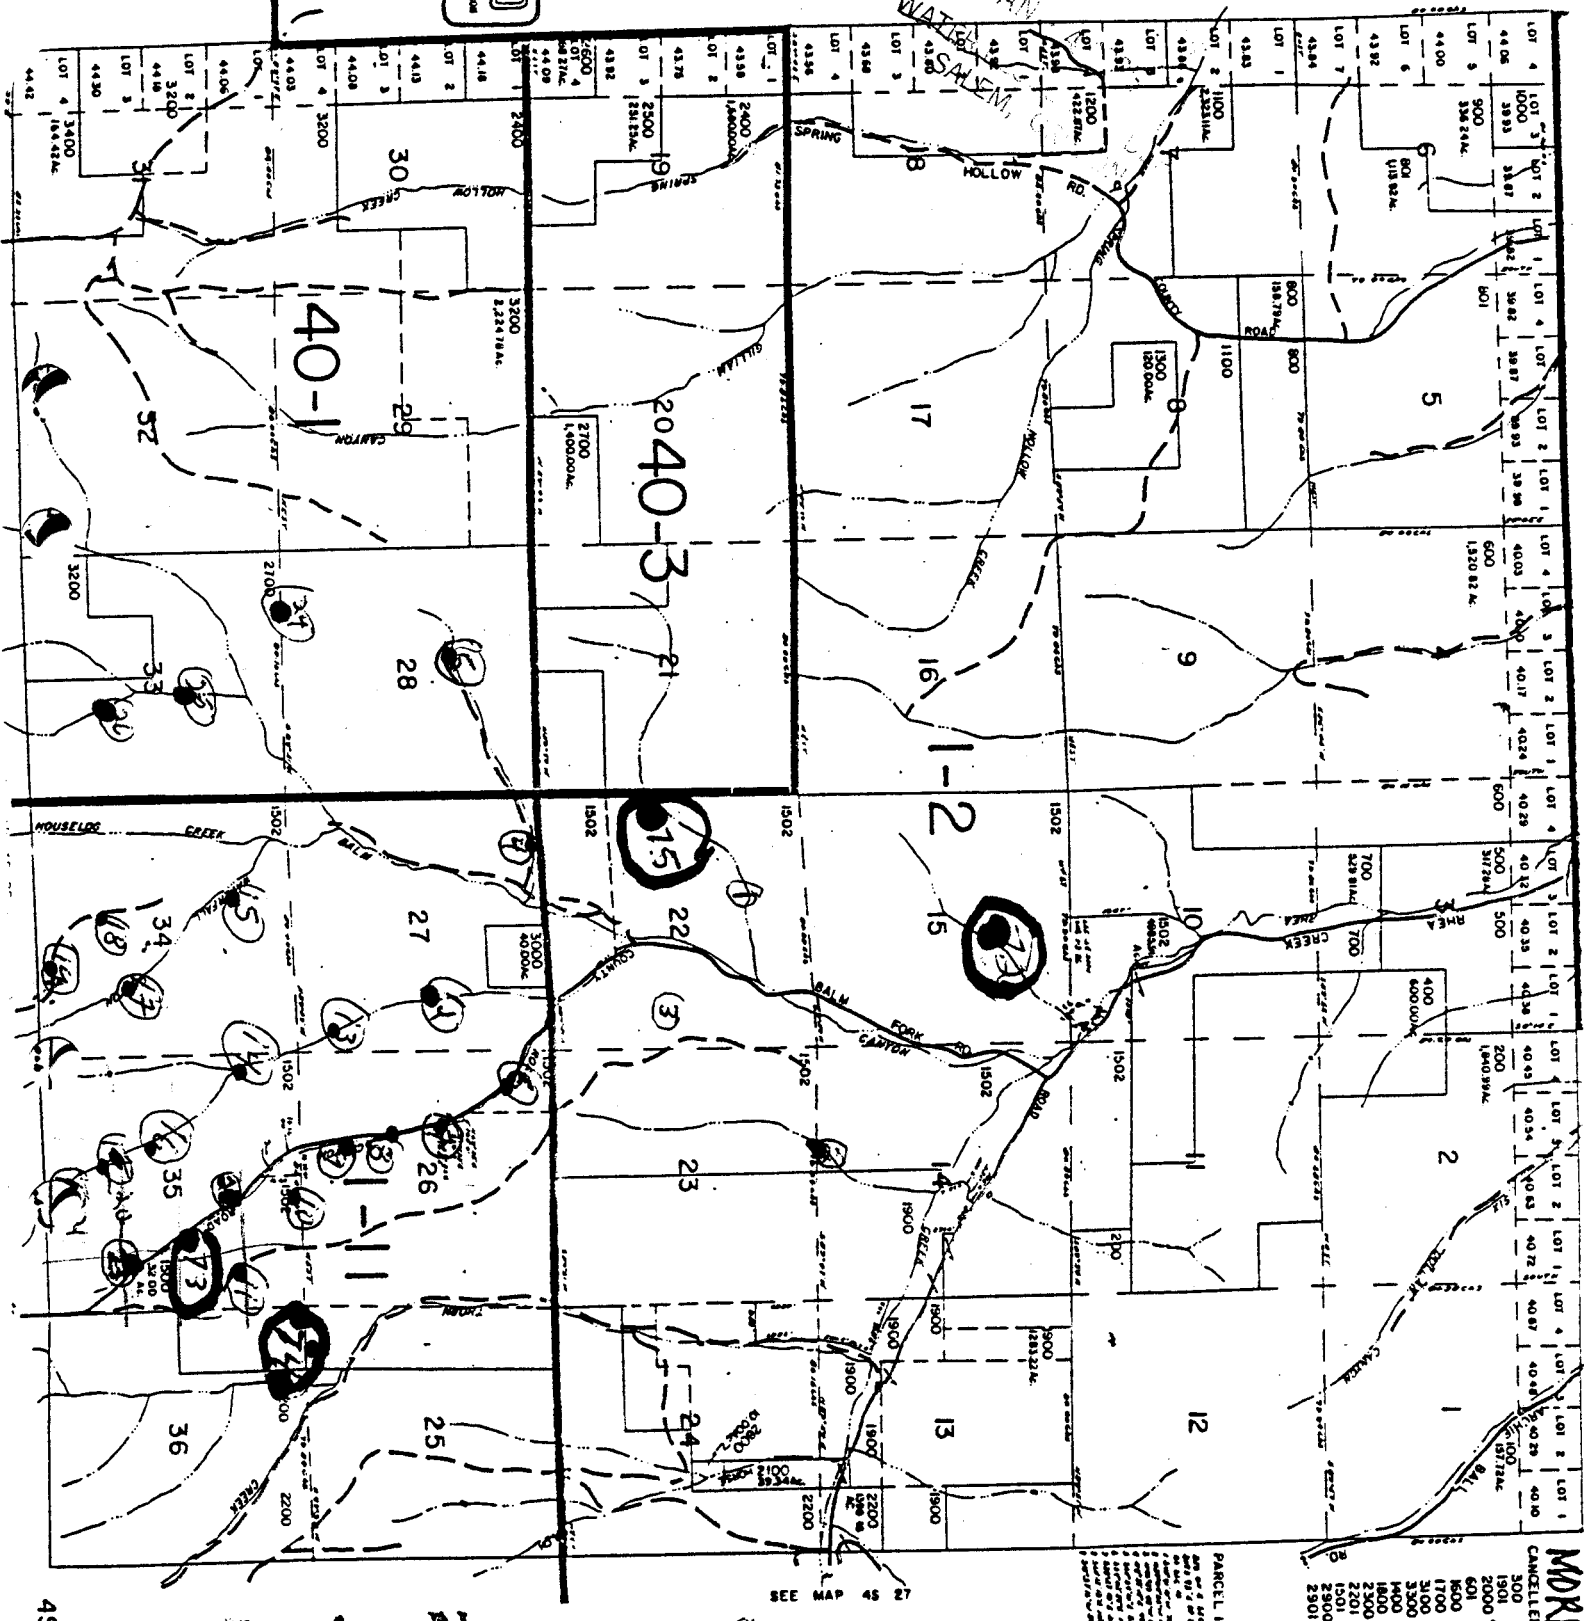


MOORAU
CANCELLED NOS
300
1901
2000
45 26
601
8500
1700
3100
3300
3400
1400
2500
2301
1501
2300
2901

Application No. R-79899
Permit No. _____

45 26

A graphic scale bar for feet, showing a total length of 4000 feet, divided into two 2000-foot segments. Below it is a graphic scale bar for kilometers, showing a total length of 2 kilometers, divided into two 1-kilometer segments.

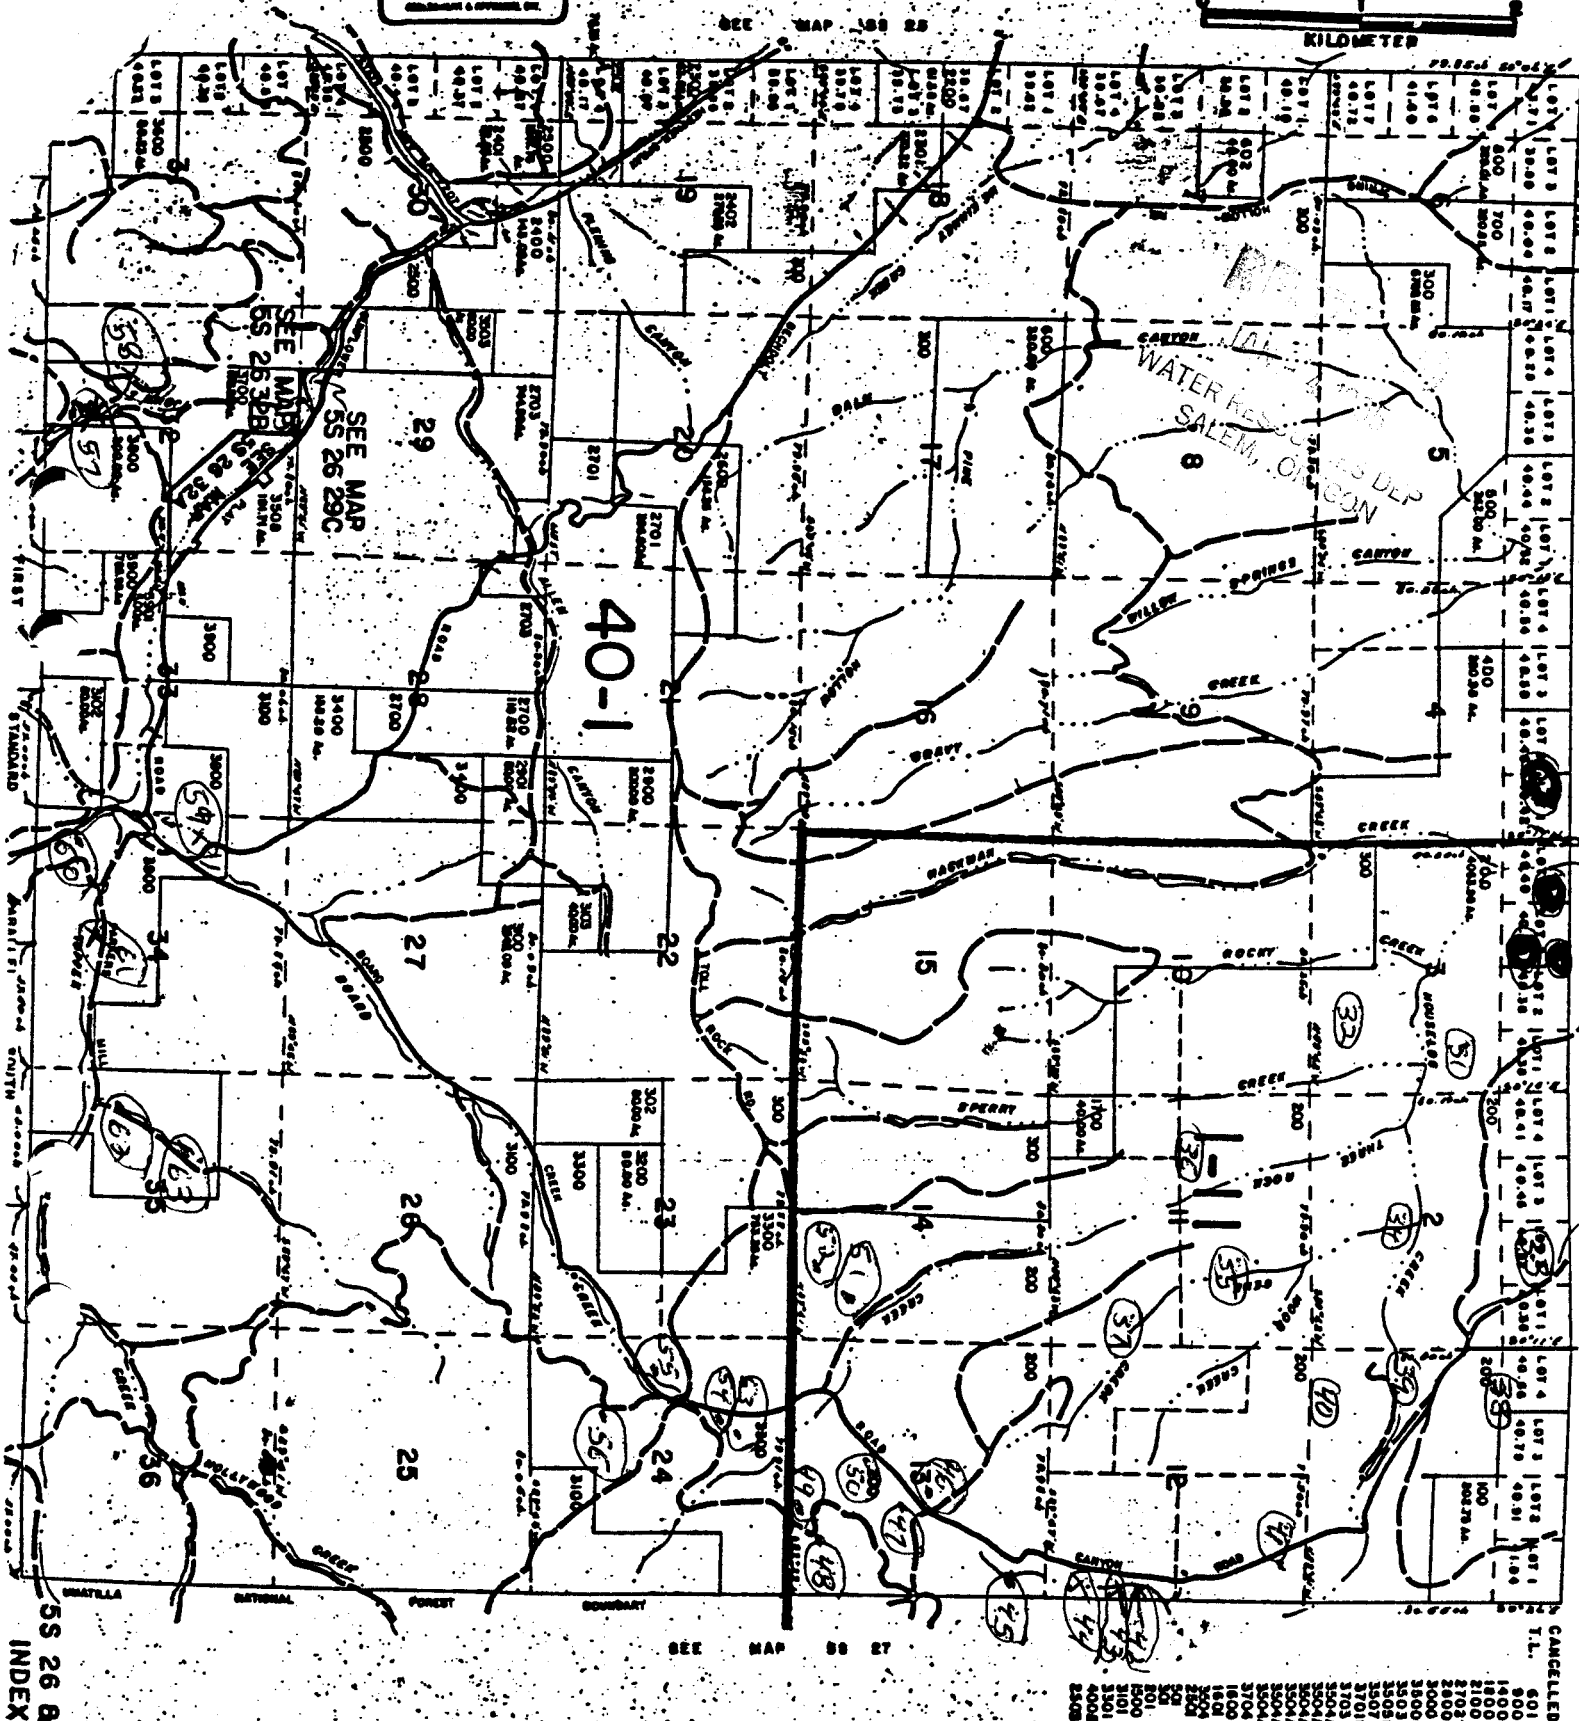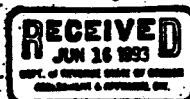

Application No. K-79899
Permit No. _____

T.L. 601
 900 hrs
 1400
 1800 hrs
 2100
 2703
 2800
 2803
 2804
 32