



SCALE 1:48000

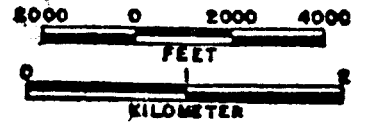

JAN - 4 1975
WATER RESOURCES
SALEM, OREGON

SEE MAP 45 25

RECEIVED
FEB 22 1975
U.S. GEOLOGICAL SURVEY
WASHINGTON, D.C.

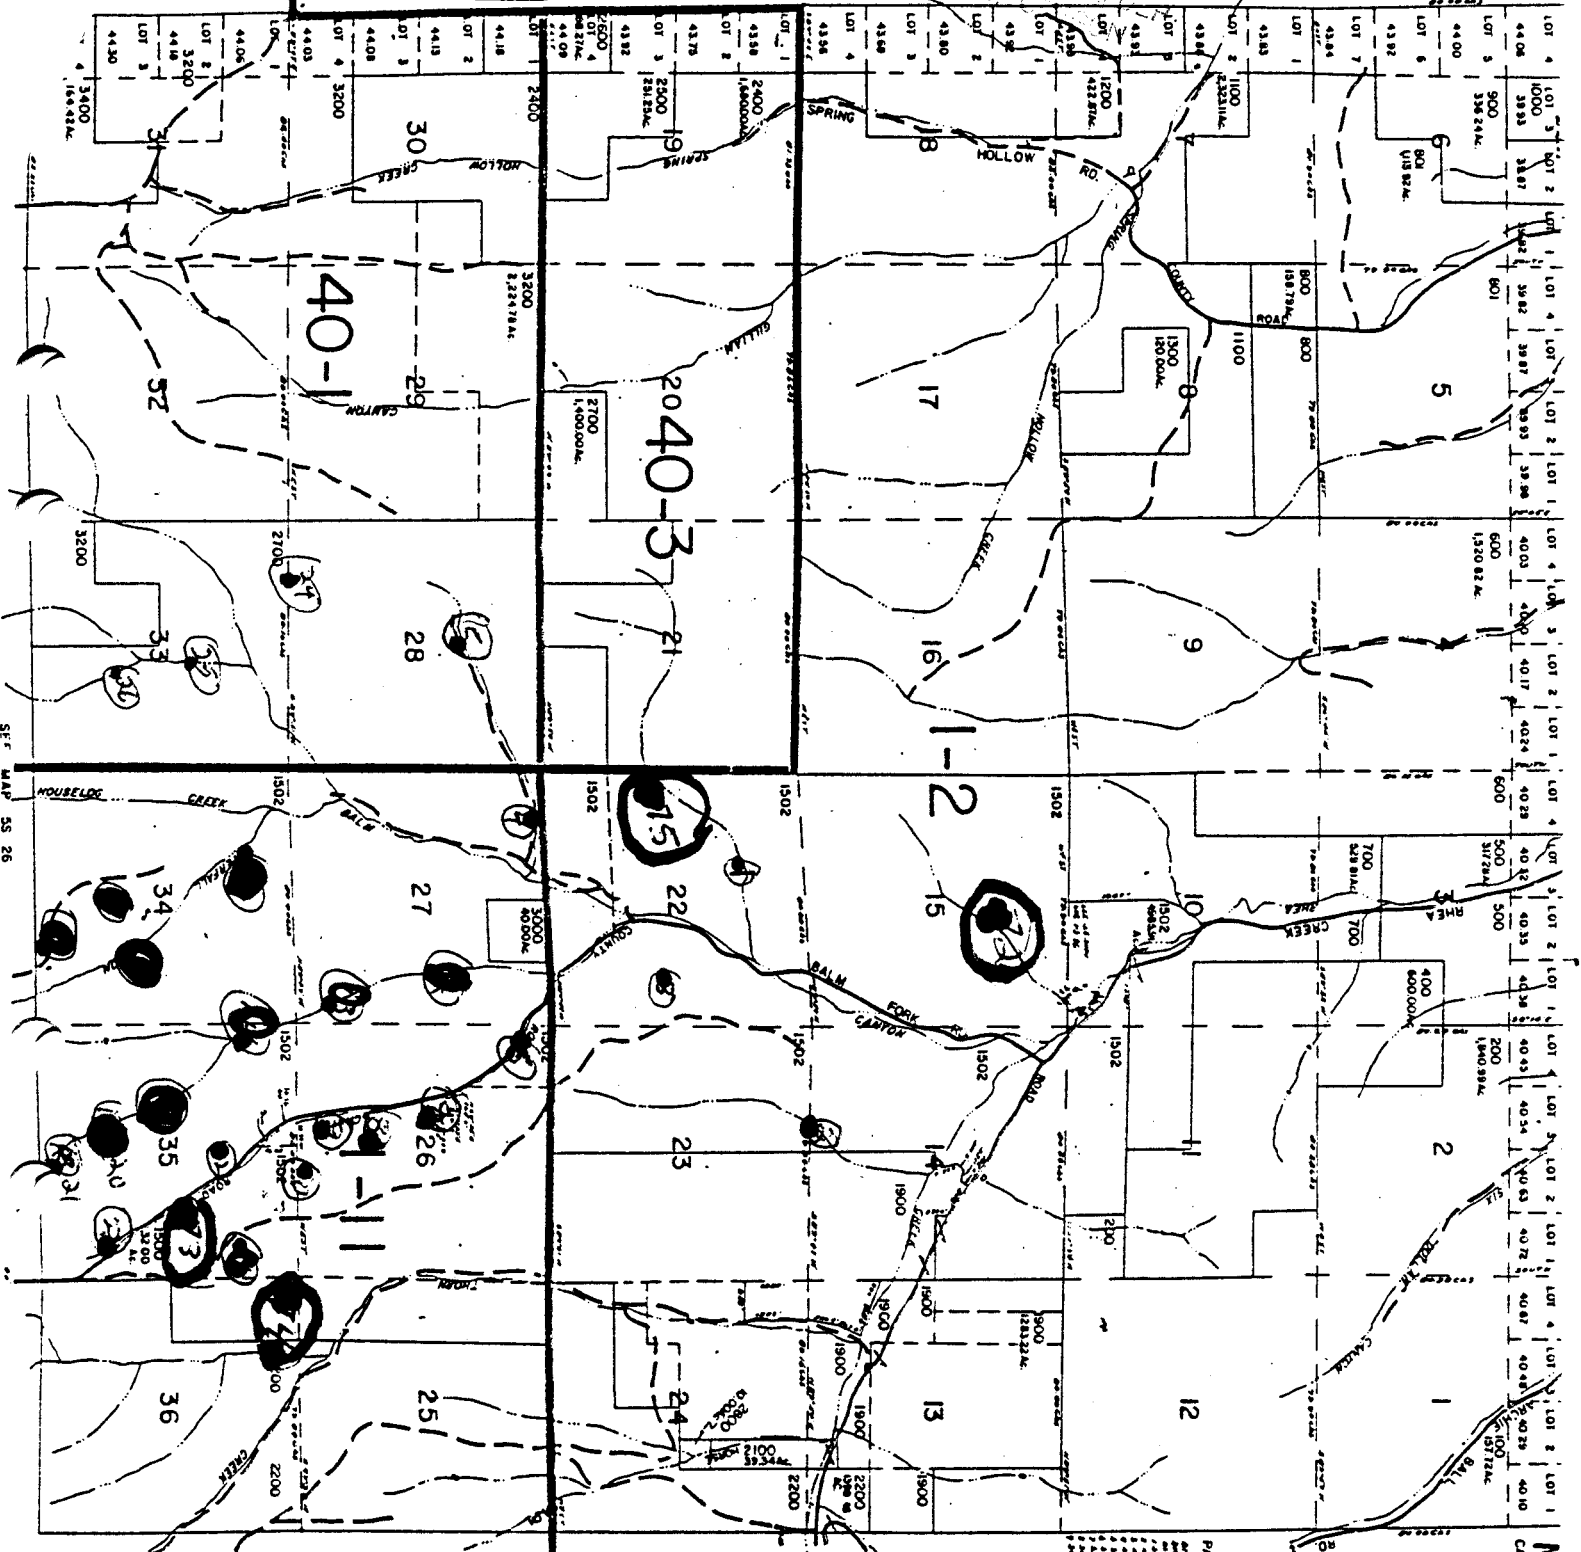

SEE MAP 45 27

Application No. K. 79901
Permit No.

Certified

MURKIN
CANCELLED NOS
300
1901
2000
45 26
601
1700
3100
3400
1800
2300
2201
1501
2801