


ion No. R 79902  
ait No.

RECEIVED  
FEB 2 1933  

SCALE 1:48000

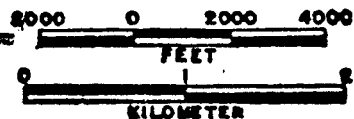


SEE MAP 45 25

RECEIVED

APR 28 1937

WATER RESOURCES DEPT.  
SALEM, OREGON

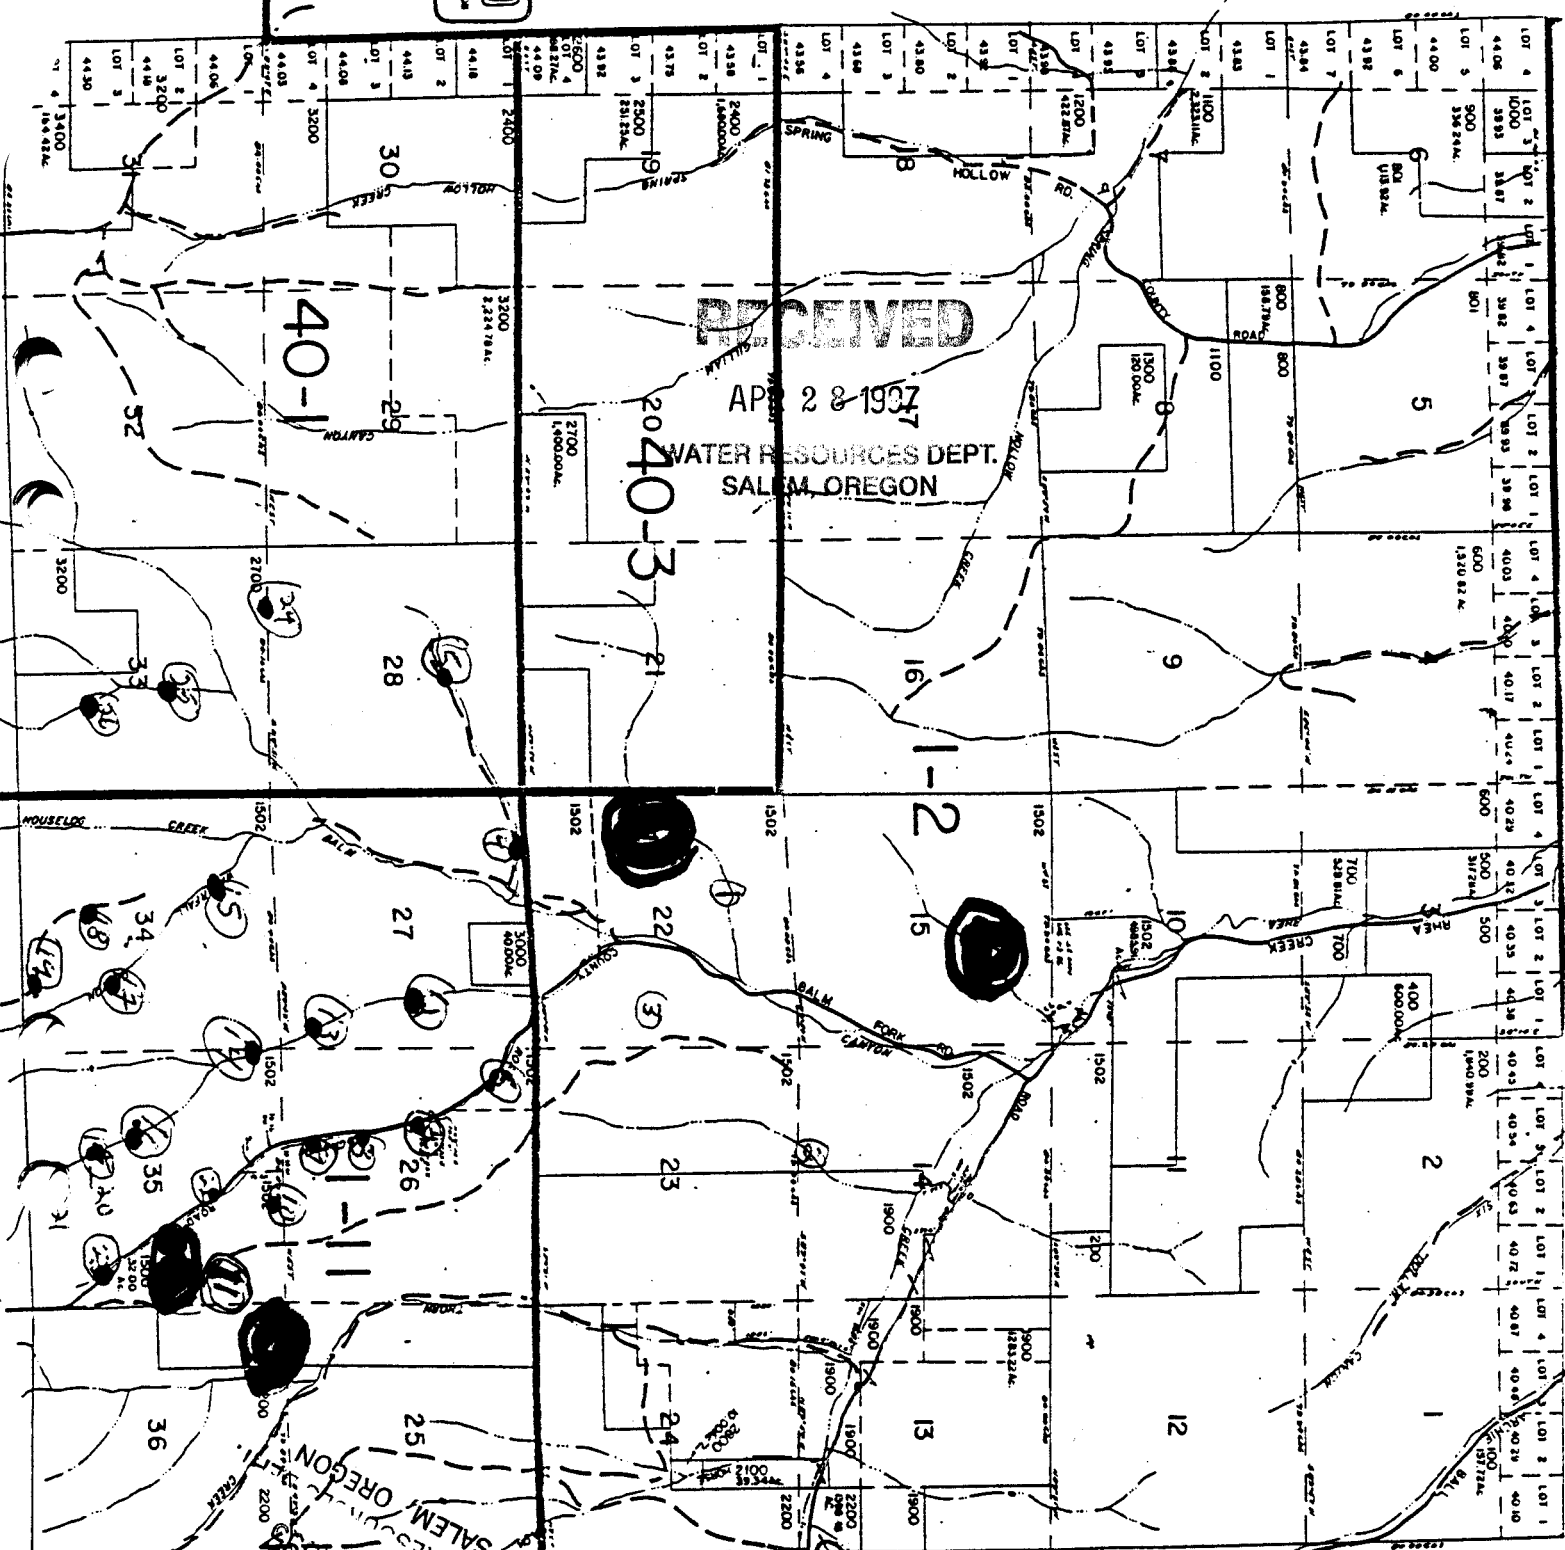

SEE MAP 45 27

RECEIVED  
JAN - 4 1938  
WATER RESOURCES DEPT.  
SALEM, OREGON

MORROW  
CANCELLED NOS  
300  
1901  
2000  
601  
1800  
1700  
3300  
3400  
1800  
2300  
2201  
1501  
2300  
2301

45 26


Application No. K 79902

Permit No.

SCALE 1:48000

RECEIVED


RECEIVED  
SEP 04 1993  

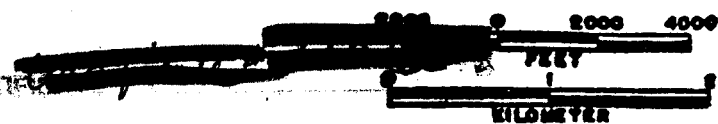

APR 28 1997

WATER RESOURCES DEPT.

SEE MAP 65 25

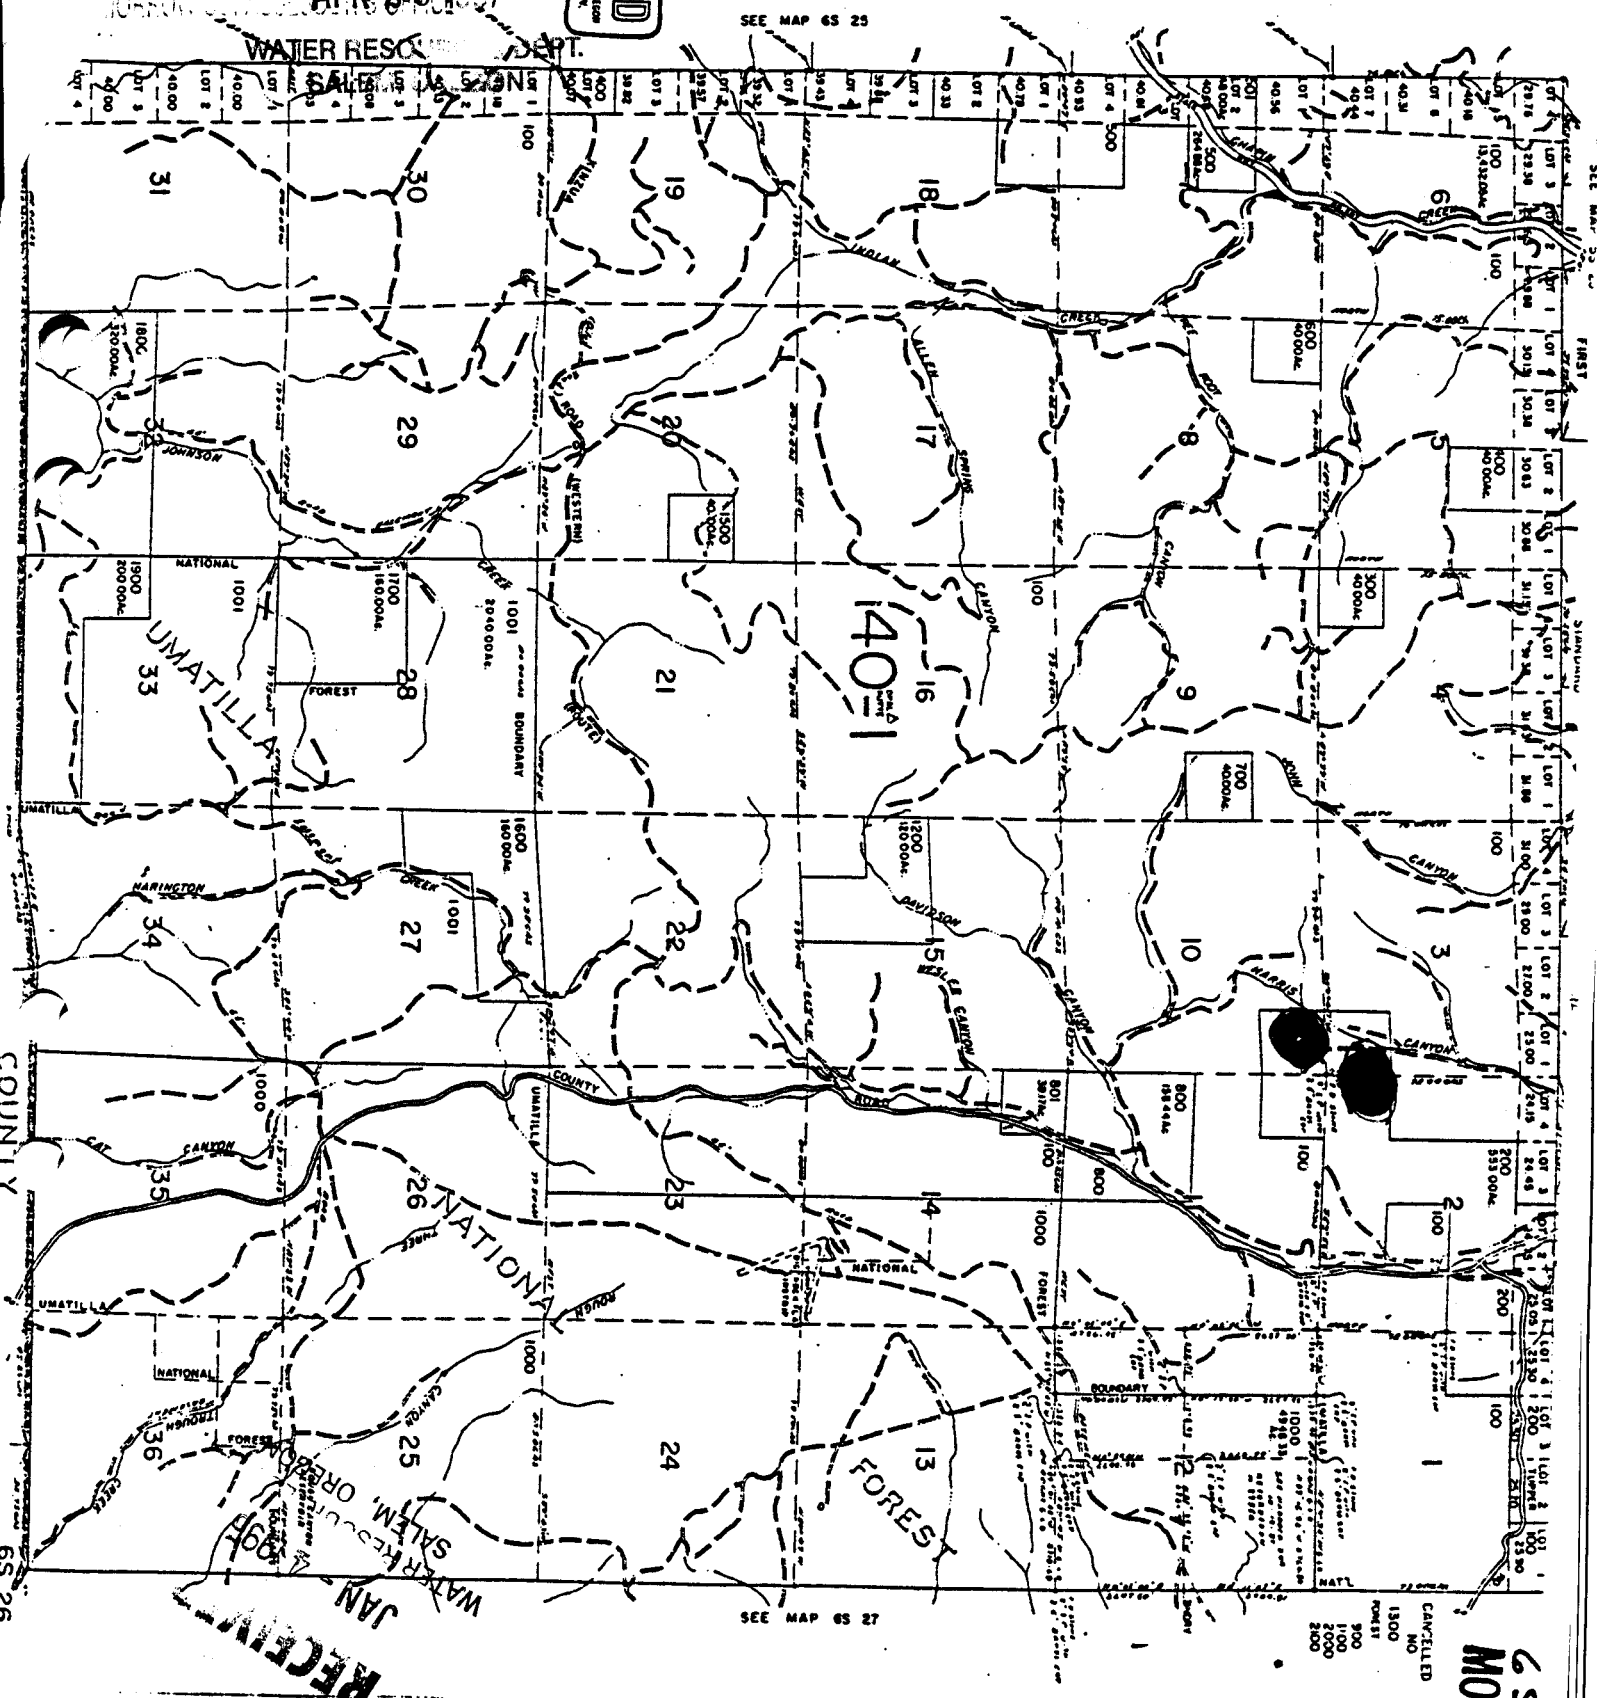

SEE MAP 65 27

RECEIVED  
JAN 4 1998  
WATER RESOURCES DEPT.  
SALMON, OREGON

65 26  
MORROW