


SEE MAP 45 26

- CANCELLED NOS.  
T.L. 601  
800 thru 855 26  
1800 thru 2100  
2702 MORROW  
2800  
3000  
3500 thru 3503  
3503 thru 3507  
3701 thru 3703  
3504A1  
3504A2  
3504A3  
3504A4  
3504A5  
3504A6  
3704  
1800  
1801  
3504  
2801  
301  
301  
301  
3101  
3101  
4008  
2508

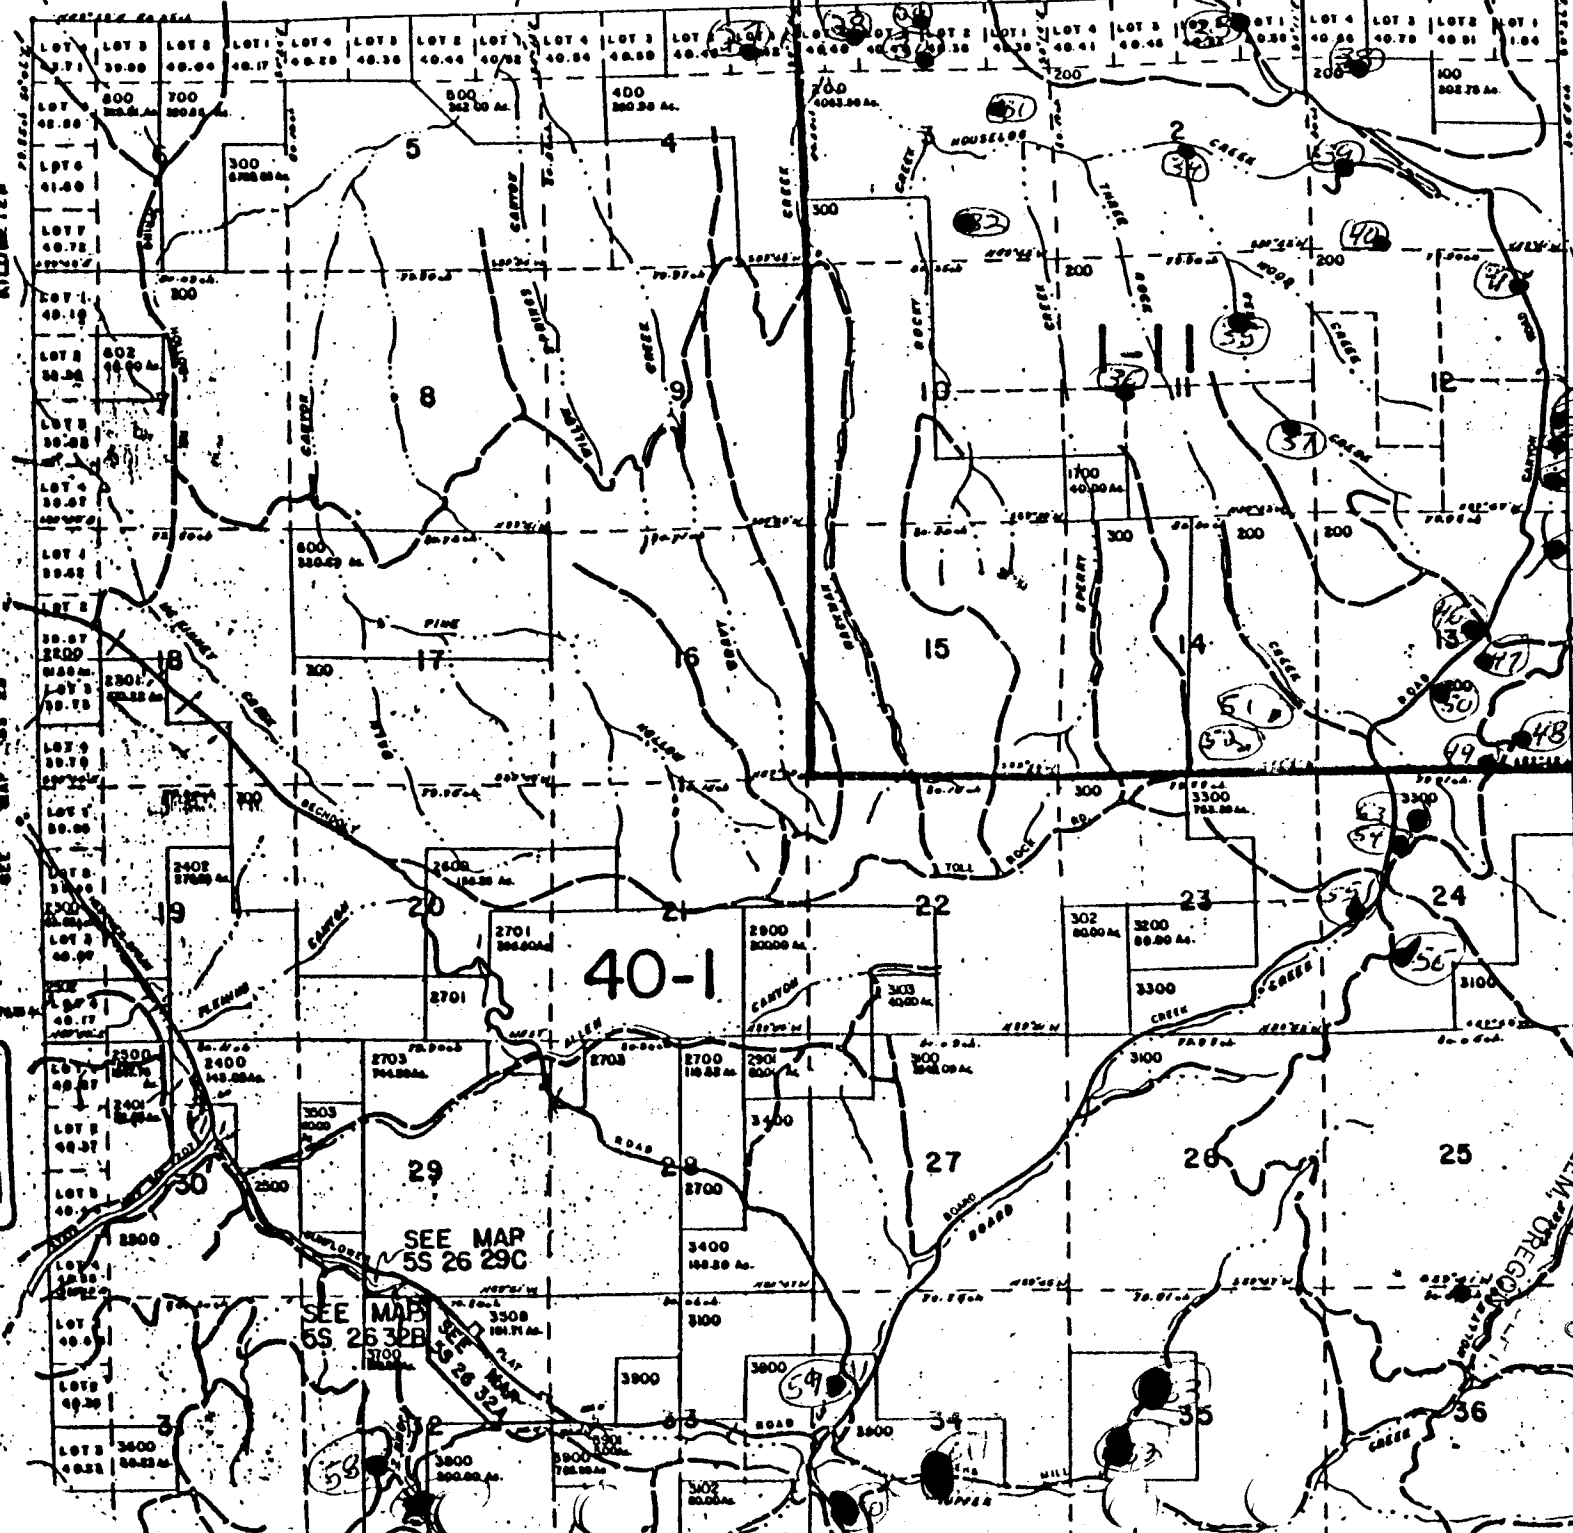

SEE MAP 55 25

SEE MAP 55 25

55 26 B INDEX

RECEIVED  
JAN 15 1953  
COUNTY CLERK  
WASCO, OREGON

Plat No. 2-7993  
Point No.

5S 27

CANCELLED NO.  
T.L. 2800  
2403  
2300  
2500  
4700  
4900  
5000  
5100

MORROW

SEE MAP 55 26  
No. 19903


ON TITLED

WATER SALEM, OREGON  
JAN 20 1995

RECEIVED

5S 27

SEE MAP 45 27

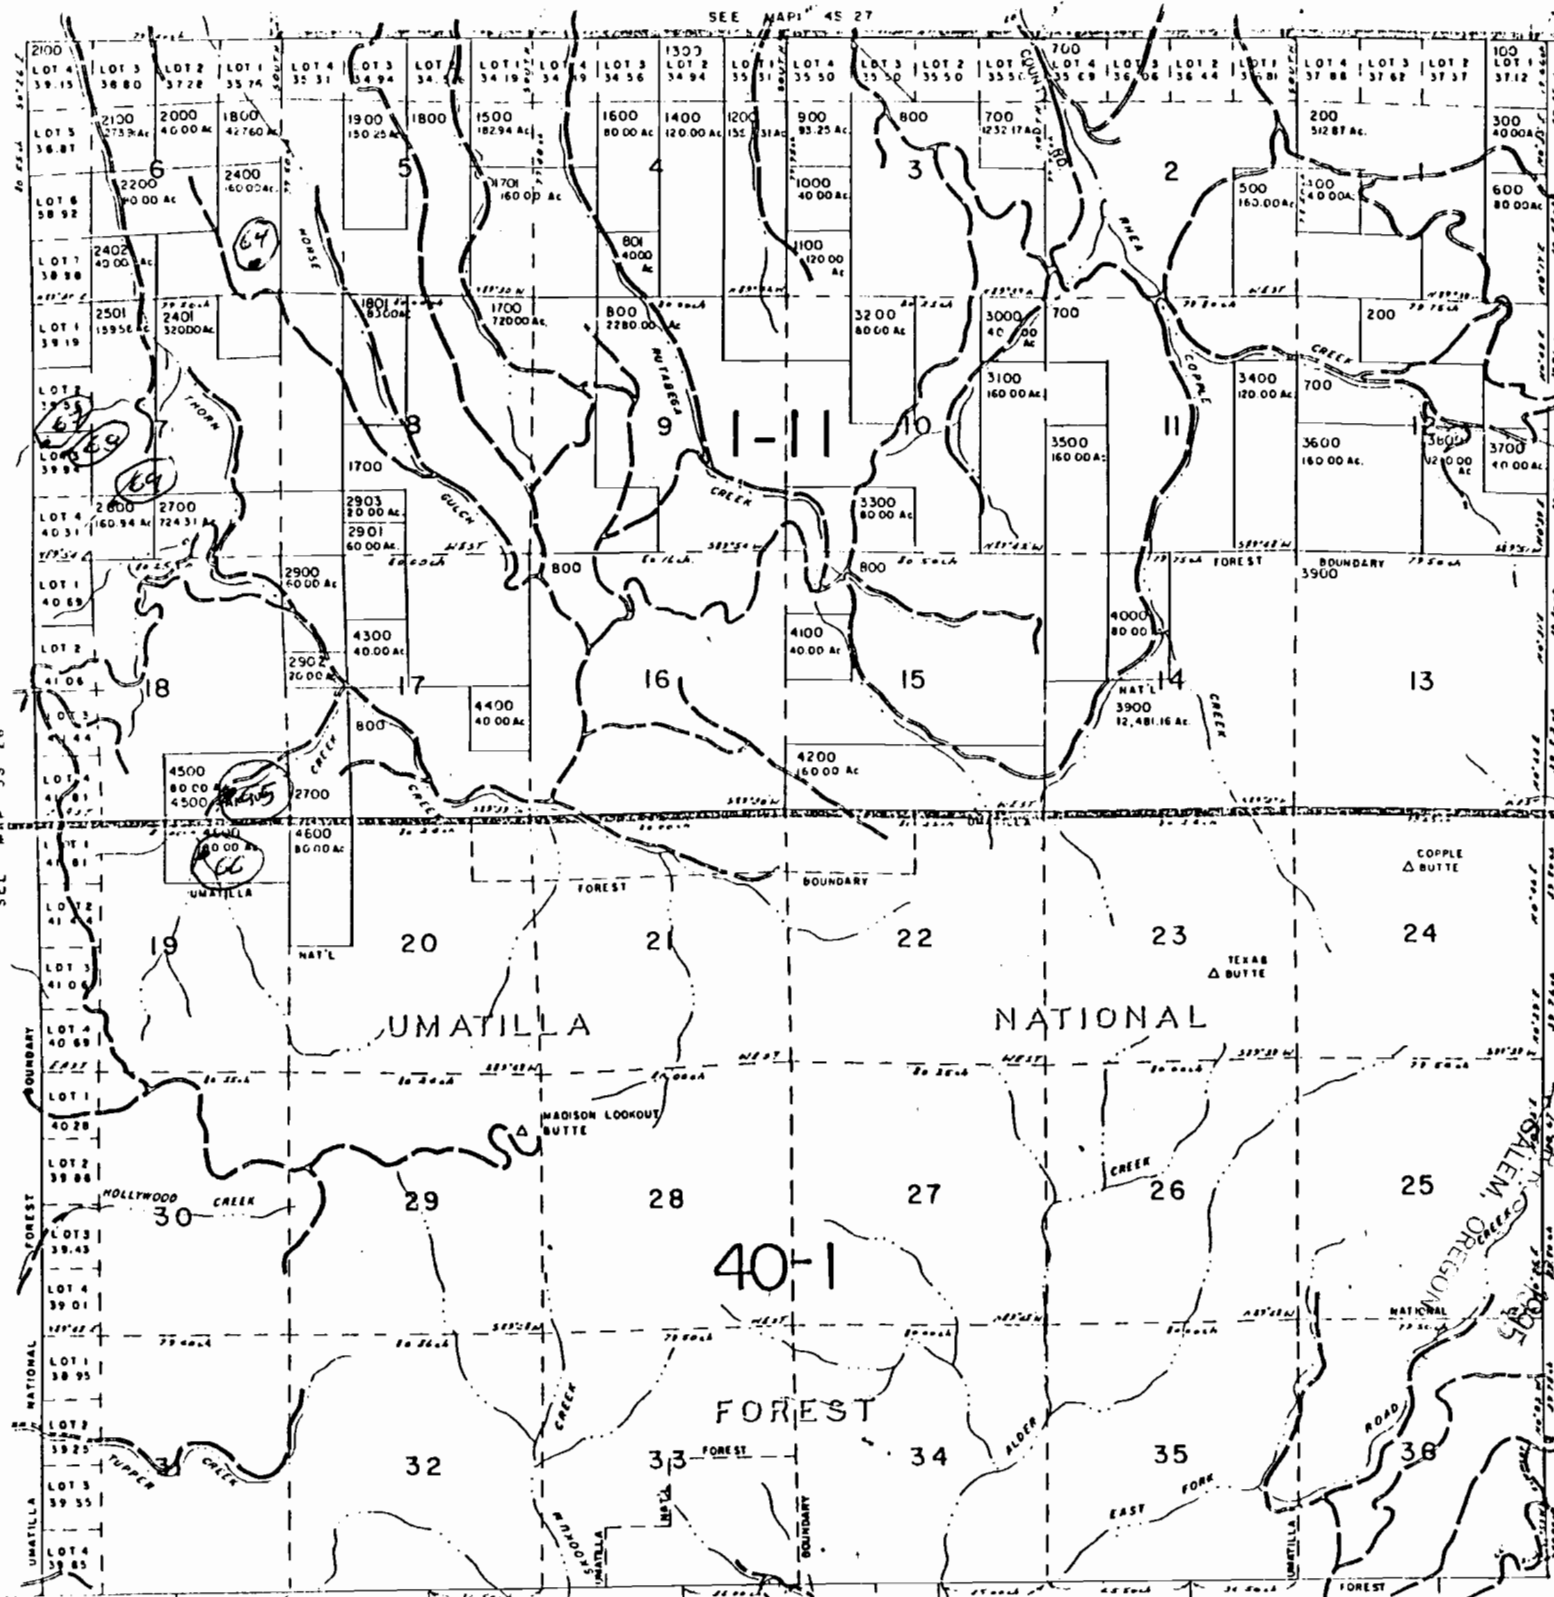

SCALE 1:48000



RECEIVED  
SEP 09 1993


MORROW CO. ASSESSOR'S OFFICE

RECEIVED  
SEP 07 1993  
DEPT. OF REVENUE STATE OF OREGON  
ASSESSMENT & APPRAISAL DIV.

SCALE 1"=8000'

71673

RECEIVED  
JAN 13 1993  
OFFICE OF PERMITS AND INSPECTION  
STATE OF OREGON

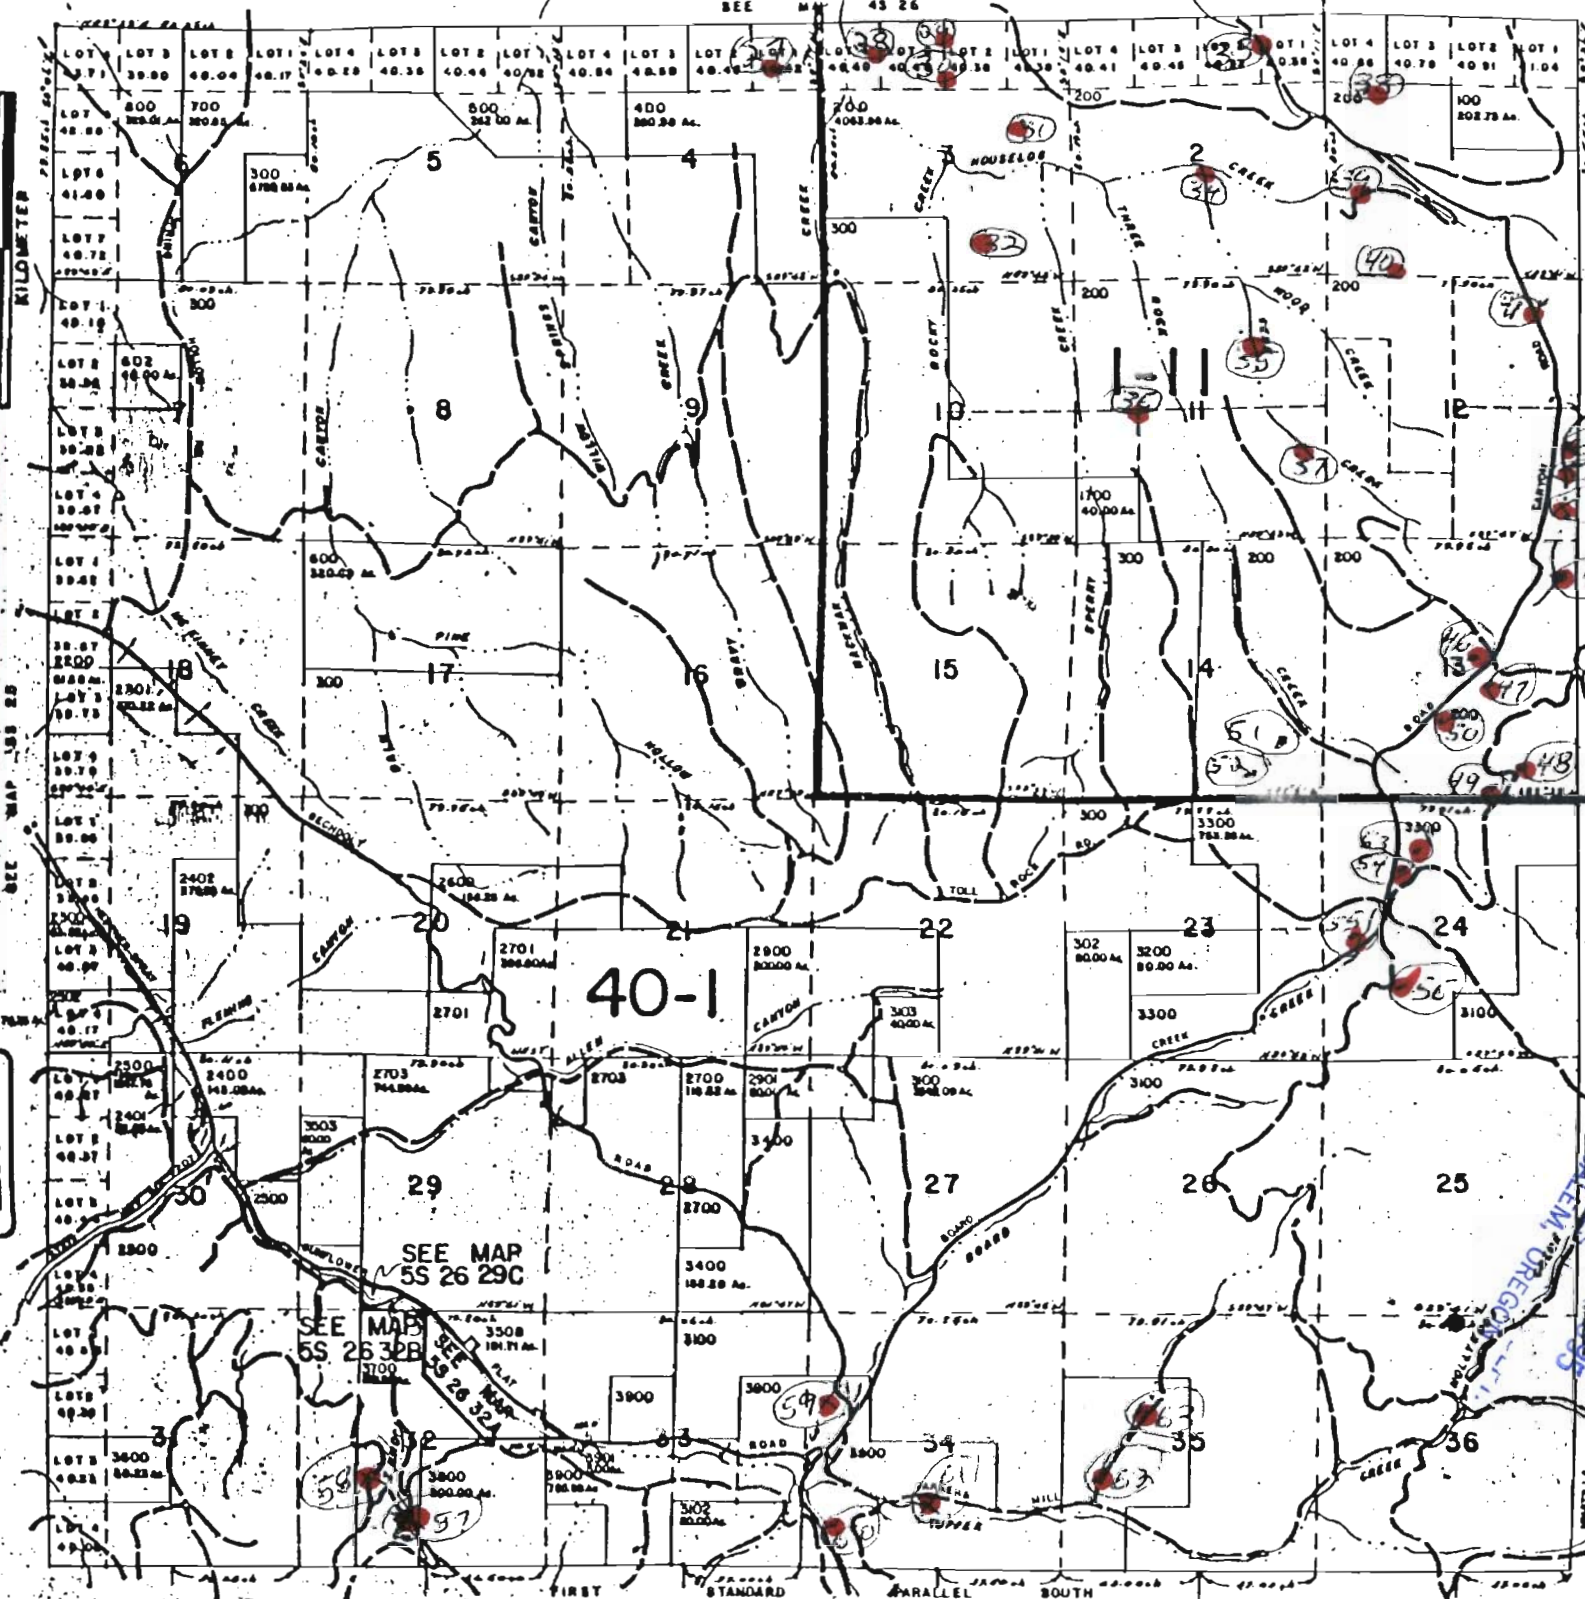

CANCELLED NOS

T.L.	601
	800 thru 900
	1400
	1800 thru 2100
	2702 MORROW
	2800
	3000
	3500 thru 3503
	3505 thru 3507
	3701 thru 3703
	3504A1
	3504A2
	3504A3
	3504A4
	3504A5
	3504A6
	3704
	1600
	1801
	3504
	2501
	501
	801
	1500
	3101
	3301
	400B
	250B

Application No. 12-19903  
 Permit No.

RECEIVED  
 JAN - 4 1993  
 WATER DIVISION  
 STATE OF OREGON

55 26 & INDEX



CANCELLED NO.  
TL 2800  
2403  
2300  
2500  
4700  
4900  
5000  
5100


MORROW

Application No. *K-79903*  
Permit No.

SEE MAP 55 2A

RECEIVED  
JAN 11 1995  
WATER DIVISION  
SALEM, OREGON

SEE MAP 45 27

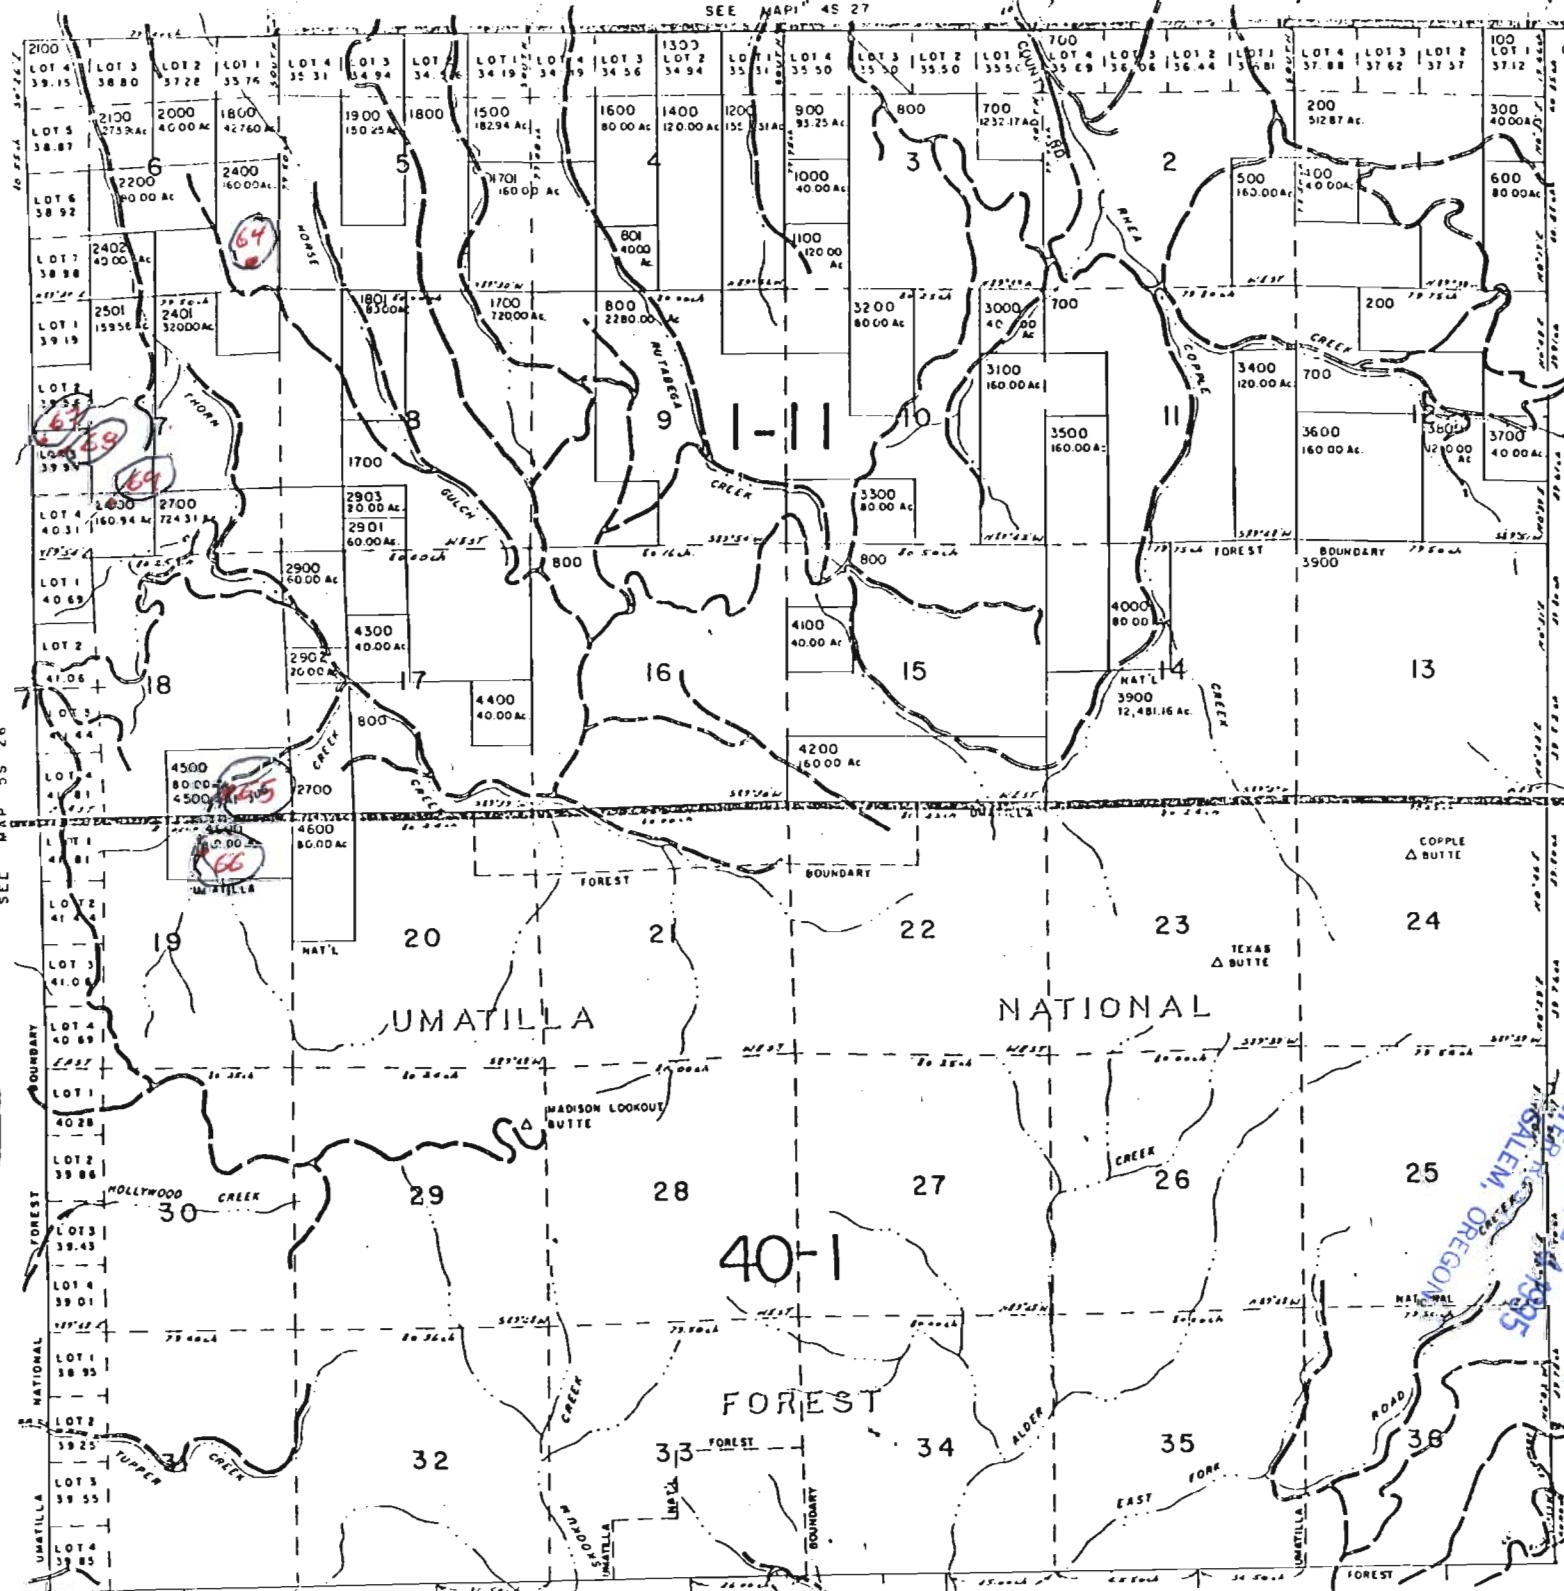

SCALE 1" = 4800'



RECEIVED  
SEP 09 1993

MORROW CO. ASSESSOR'S OFFICE

RECEIVED  
SEP 07 1993  
OFFICE OF REVENUE STATE OF OREGON  
ASSESSMENT & APPRAISAL DIV.