



- 1200 INL
- 2100 MDR
- 2800
- 3000
- 3500
- 3505 PWR
- 3507 WTR
- 3703
- 3504A1
- 3504A2
- 3504A3
- 3504A4
- 3504A5
- 3704
- 1800
- 1800A
- 2500
- 50
- 201
- 1500
- 3101
- 2301
- 4008
- 2308

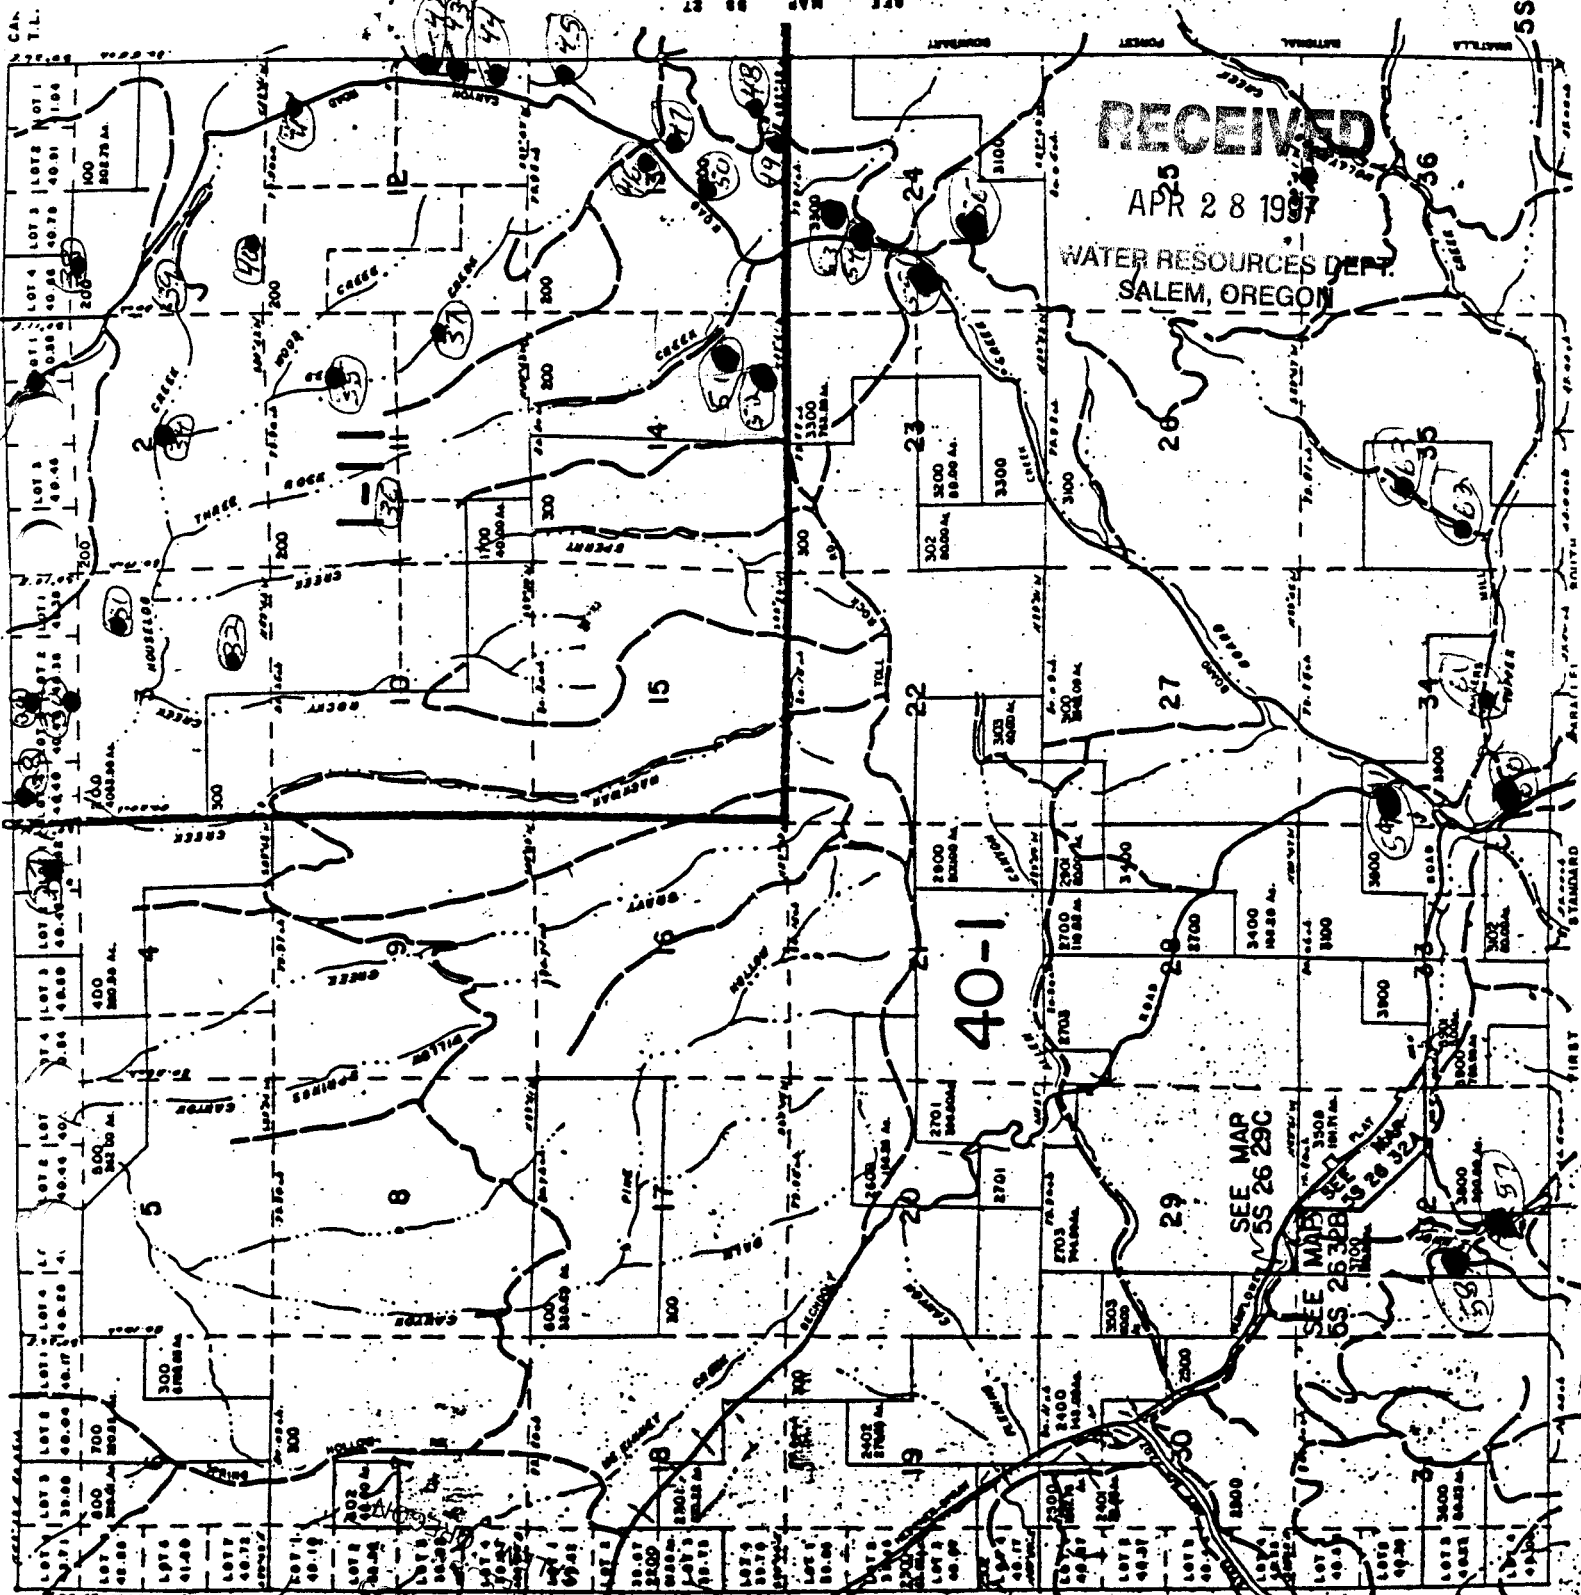

RECEIVED

APR 28 1997

WATER RESOURCES DEPT.
SALEM, OREGON

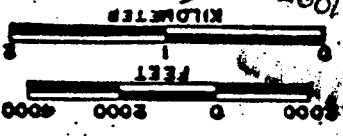

REC'D JAN 14 1997

RECEIVED
JUN 15 1997

SEE MAP
55 26 29C

SEE MAP
55 26 30B

SEE MAP
55 26 31A

SEE MAP
55 26 32A

