


SCALE 1:48000

RECEIVED
JUN 16 1993
U.S. DEPARTMENT OF AGRICULTURE
NATIONAL SERVICE CENTER

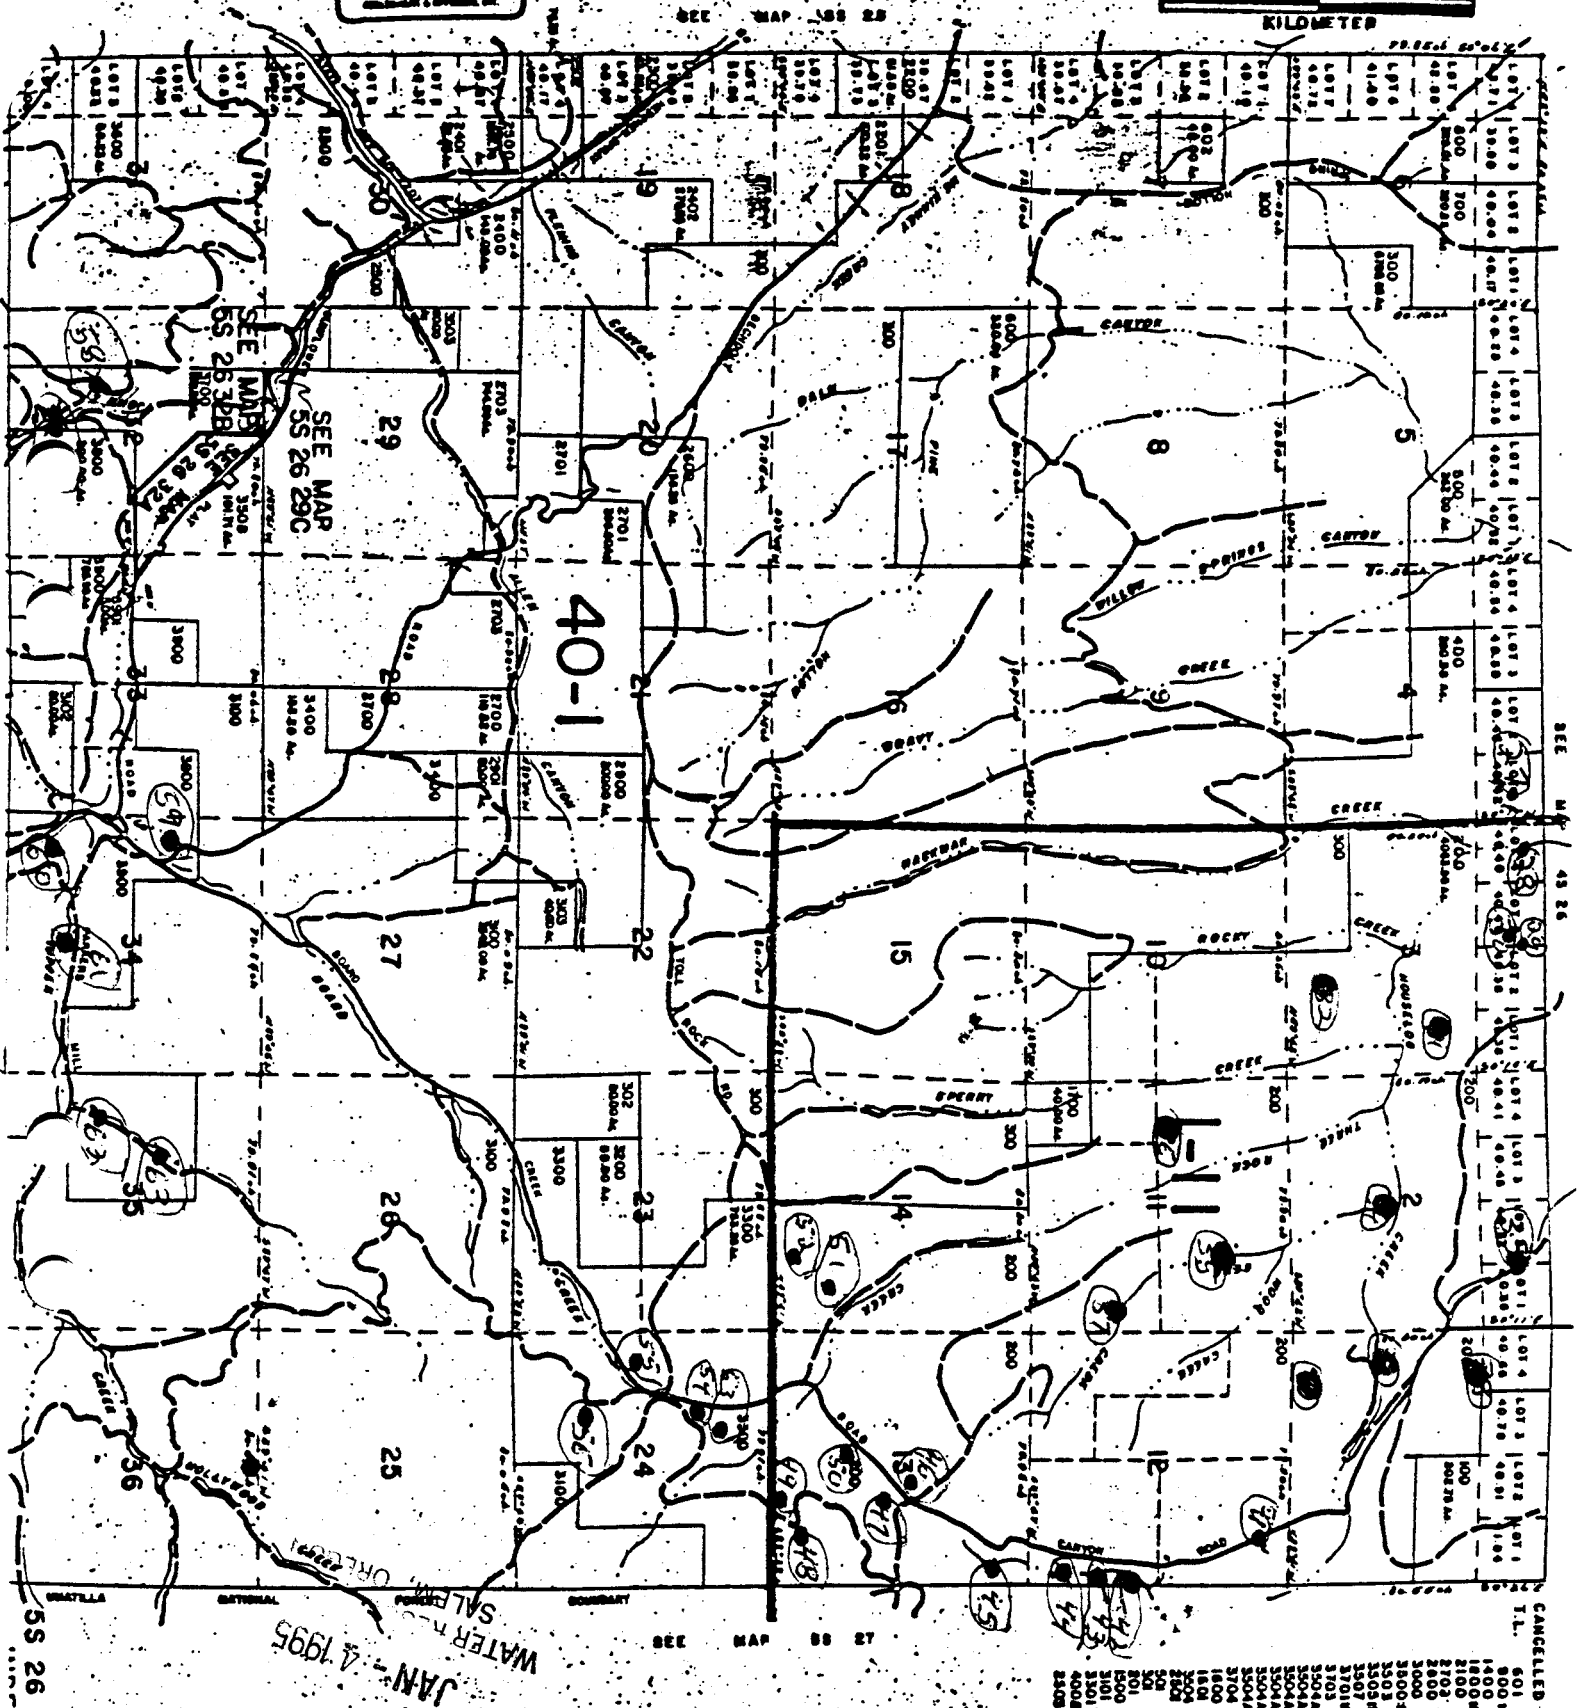

JAN 4 1995
WATER

Application No 79905
Permit No.

CANCELLED NOS.
55 26
MORROW